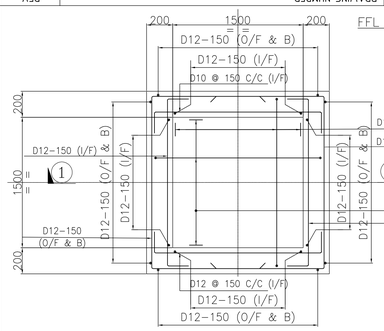
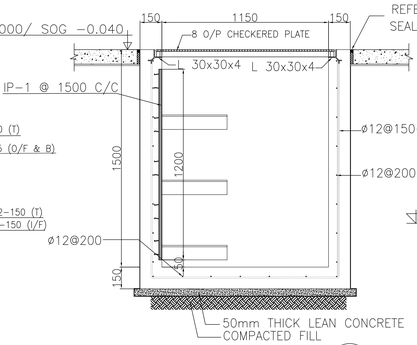
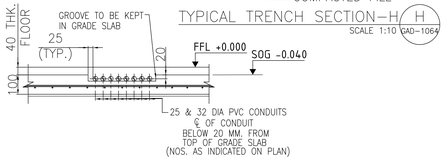
DRAWING NUMBER
MD-216-498L-EG-CV-GAD-1064
REV D01



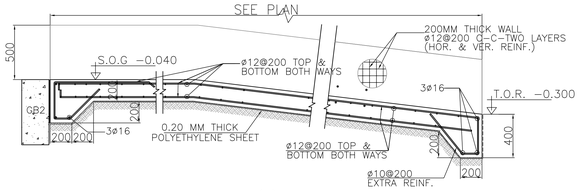

R.C. PLAN FOR PULLPIT
SCALE 1:20








TYPICAL TRENCH SECTION-H / H
SCALE 1:10 GAD-1064

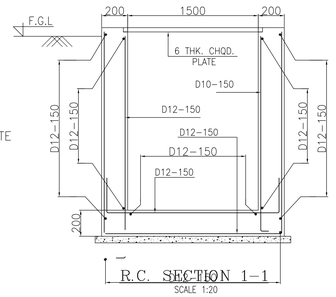
TYP. GROOVE DETAILS OF GRADE SLAB FOR CONDUITS
SCALE 1:10





TYPICAL SECTION (T) FOR RAMP
SCALE NTS



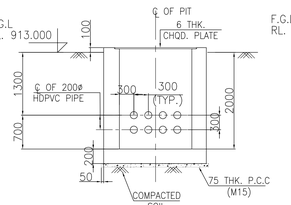

R.C. SECTION 1-1
SCALE 1:20





SECTION A1-A1
SCALE 1:30

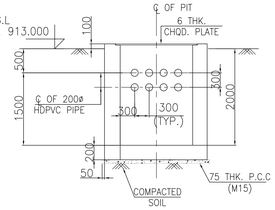


SECTION A2-A2
SCALE 1:30

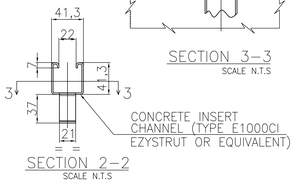



SECTION 2-2
SCALE N.T.S

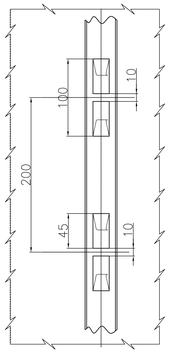


SECTION 3-3
SCALE N.T.S

TYP. DET. OF INSERT MKD. IP-1 CHANNEL TYPE E1000CI OR EQUIVALENT
SCALE N.T.S

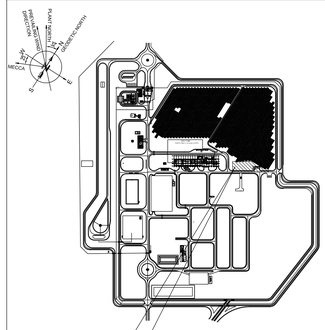
MASTER KEY PLAN



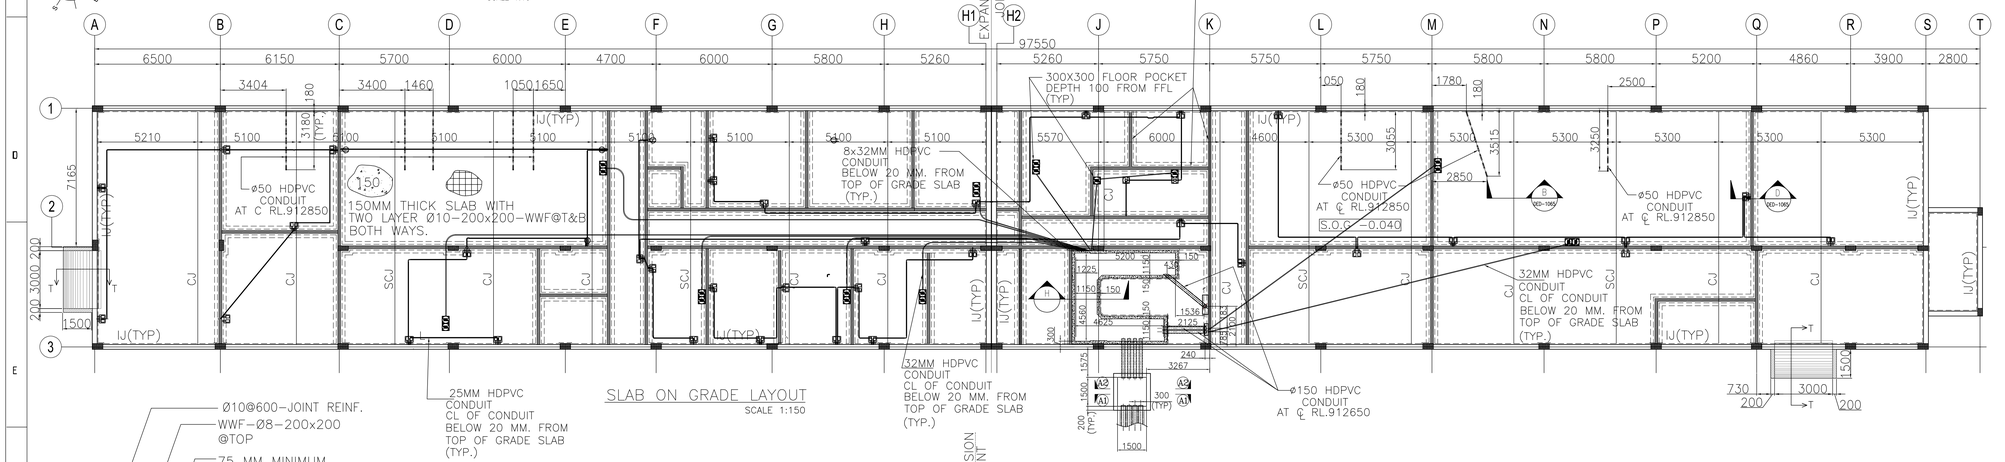
ALL WALL SHALL BE SOLID GROUTED AS PER D.W.G NO. MD-216-6000-EG-CV-STD-1001.




SLAB ON GRADE LAYOUT
SCALE 1:150

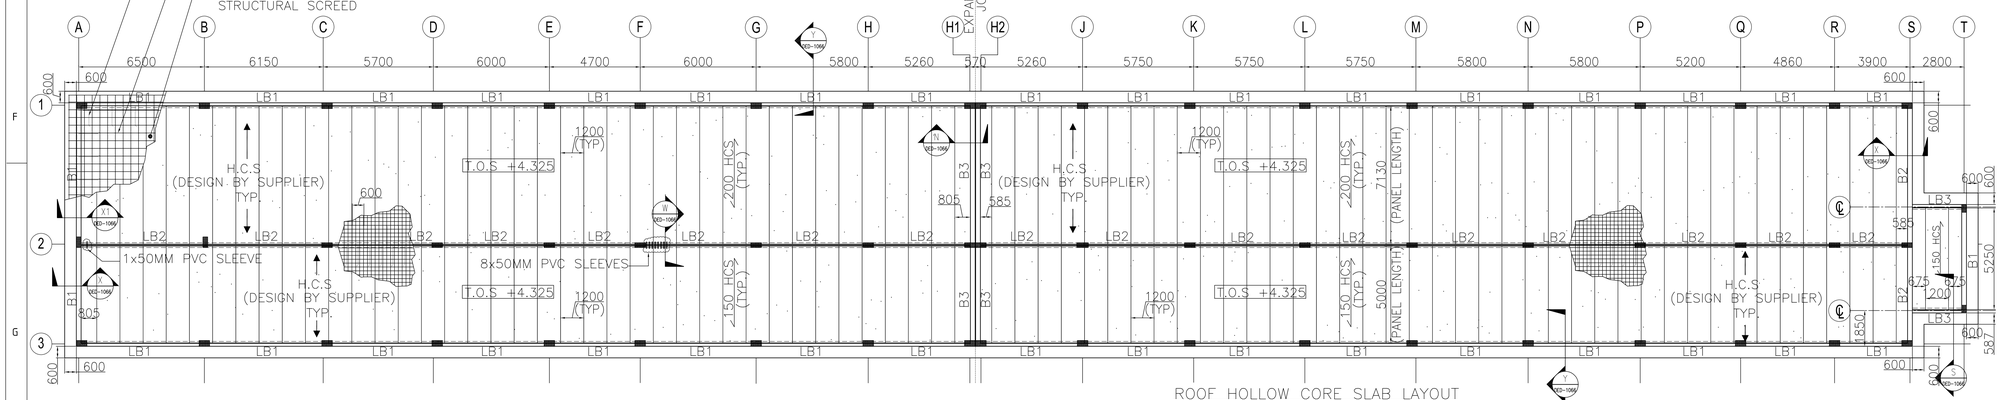


ROOF HOLLOW CORE SLAB LAYOUT
SCALE 1:150

## NOTES

1. ALL DIMENSIONS ARE GIVEN IN MILLIMETRES AND ELEVATIONS ARE IN METRES UNLESS OTHERWISE NOTED.
2. MINIMUM REINFORCED CONCRETE GRADE TO BE USED FOR SUPERSTRUCTURE & SUBSTRUCTURES IS C35(5000 PSI).
3. MINIMUM LEAN CONCRETE GRADE TO BE USED FOR THE SUB-STRUCTURES IS C15(2175 PSI).
4. ALL REINFORCING STEEL SHALL BE DEFORMED BILLET STEEL BARS CONFORMING TO ASTM-A615, WITH MINIMUM YIELD STRENGTH OF FY420 MPA
5. THE NET SOIL BEARING CAPACITY CONSIDERED IN FOUNDATION DESIGN IS 570 KPA(REFER DOC 216-3000-EG-CV-RPT-1008)
6. WATER PROOFING INSULATION SHALL BE AS PER PROJECT SPECIFICATIONS & ITS MATERIAL TO BE APPROVED BY SITE ENGINEER.
7. MINIMUM CONCRETE COVER AS PER SBC-304-2018(TABLE 20.6.1.3.1) MEASURED FROM REBAR SHALL BE
   a. CONCRETE CAST AGAINST & PERMANENTLY EXPOSED TO EARTH (INCLUDING FOUNDATIONS OVER SUB-SLAB) FORMED CONCRETE EXPOSED TO EARTH OR WEATHER.....50MM
   b. CONCRETE NOT EXPOSED TO WEATHER NOR IN CONTACT WITH GROUND
      BEAMS, COLUMNS.....40MM
      SLABS, WALLS, JOISTS.....20MM
   c. CONCRETE SLAB OVER 50MM SUB-SLAB.....20MM
8. ALL DRAWINGS MUST BE READ IN CONJUNCTION WITH RELEVANT ARCHITECTURAL AND ENGINEERING DRAWINGS RELATED TO THE SAME SHEET AND ANY ITEM ON IT.
9. F.F.L +0.00 MENTIONED IS EQUIVALENT TO RL 913.500

LEGENDS
F/FDN.-FOUNDATION
CR-COLUMN NECK
C/COL.-COLUMN
FFL-FINISH FLOOR LEVEL
FGL-FINISH GROUND LEVEL
TOS-TOP OF SCREED
WWF-WELDED WIRE FABRIC
HCS-HOLLOW CORE SLAB
GB-GRADE BEAM
IJ-ISOLATION JOINT
CJ-CONTROL JOINT
BW's-BOTH WAYS
S.O.G-SLAB ON GRADE
SCJ-SLAB CONSTRUCTION JOINT
HOR.-HORIZONTAL
REINF.-REINFORCEMENT
LVL.-LEVEL
RL.-REDUCED LEVEL
P.-PEDESTAL
℄-CENTRE LINE OF ROOF BEAM
HDPVC-HIGH DENSITY PLYVINYL PHLORIDE

SX SX 300X300 FLOOR POCKET

| DOCUMENT NUMBER | REFERENCE DOCUMENTS | REV | DATE | REVISION DESCRIPTION | DRN | CHK | ENG | APP | EMP |
|---|---|---|---|---|---|---|---|---|---|
| | | D01 | 08/09/2023 | AS-BUILT | -- | AVG | -- | SJM | |
| | | C04 | 25/06/2021 | ISSUED FOR CONSTRUCTION & REVISED AS MARKED C04 | -- | AVG | -- | SJM | |
| MD-216-6000-EG-CV-STD-1002 | HOLLOW CORE SLAB STANDARD | C03 | 19/05/2021 | ISSUED FOR CONSTRUCTION & REVISED AS MARKED C03 | -- | AVG | -- | SJM | |
| MD-216-6000-EG-CV-STD-1001 | REINFORCEMENT STANDARD | C02 | 13/01/2021 | ISSUED FOR CONSTRUCTION & REVISED AS MARKED C02 | -- | AVG | -- | SJM | |
| MD-216-498L-EG-AR-GAD-3012 | BUILDING ELEVATIONS & SECTIONS | C01 | 30/06/2020 | ISSUED FOR CONSTRUCTION | -- | AVG | -- | SJM | |
| MD-216-498L-EG-AR-GAD-3011 | BUILDING PLANS | A01 | 31/05/2020 | ISSUED FOR APPROVAL | -- | AVG | -- | SJM | |

DESIGNER:
معكب الخليج للاستشارات الهندسية
GULF CONSULT
ARCHITECTS AND ENGINEERS

| | | | | | | | | | |
|---|---|---|---|---|---|---|---|---|---|
| DRAWING NUMBER | LABORATORY BUILDING-ST-001 | | | | | | | REVISION | 0 |
| DATE | 27/05/2020 | DATE | 28/05/2020 | DATE | 29/05/2020 | | | | |
| DRAWN | MAH | CHECKED | MF | APPROVED | FK | | | | |

LARSEN & TOUBRO DRAWING NUMBER: 019045_300_C_G_24026_002 — REVISION 3
OUTOTEC DRAWING NUMBER: 900707__GAU01__AL01__MTL01__69008 — DOCUMENT ID: OU100684629 — REVISION 3

LARSEN & TOUBRO

This drawing is the property of LARSEN & TOUBRO and must not be passed on to any person or body not authorized by us to receive it nor be copied or otherwise made use either in full or in part by such person or body without our prior permission in writing.

Outotec

The content of these documents are the sole property of Outotec Oyj. Any rights not expressly granted herein are reserved. Reproduction, transfer or distribution of part or all of the contents in any form without prior written permission of Outotec is prohibited.

MA'ADEN معادن
Saudi Arabian Mining Company شركة معادن العربية السعودية

This document and the information contained herein is Ma'aden proprietary know-how. This document or any part thereof should not be reproduced, stored in a retrieval system or transmitted by any means, electronic or otherwise, or divulged without prior written permission of Ma'aden.

| | | |
|---|---|---|
| DRAWN | -- | -- |
| CHECKED | AVG | 30/05/2020 |
| ENGINEER | -- | -- |
| APPROVED | SJM | 31/05/2020 |
| EMPLOYER | | |
| SCALE | 1:150 | A1 |

MANSOURAH - MASSARAH GOLD PROJECT
GENERAL ARRANGEMENT DRAWING
PROCESS PLANT : LABORATORY BUILDING
LAYOUT OF ROOF & GRADE SLAB

DRAWING NUMBER: MD-216-49BL-EG-CV-GAD-1064 — REV D01