

DRAWING NUMBER MD-216-49BL-EG-CV-GAD-1065 REV D01

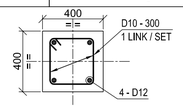


R.C DET. OF P1

SCALE 1:20

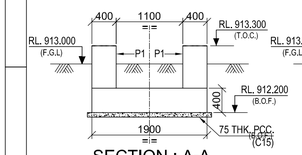


SECTION : A-A

SCALE 1:50

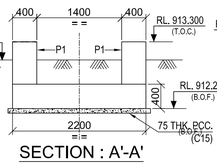


SECTION : A'-A'

SCALE 1:50

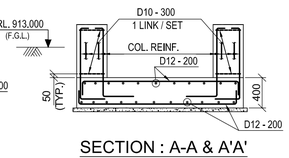


SECTION : A-A & A'A'

SCALE 1:40

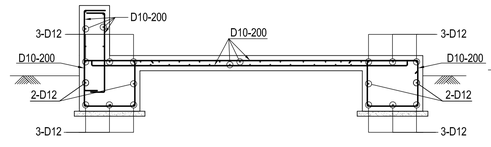


TYP. R.C DETAIL OF FDN. MKD. F1 & F1A

SCALE 1:30

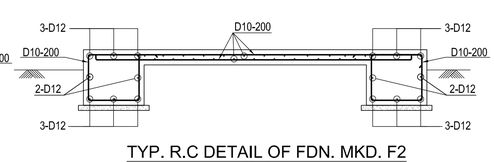


TYP. R.C DETAIL OF FDN. MKD. F2

SCALE 1:30

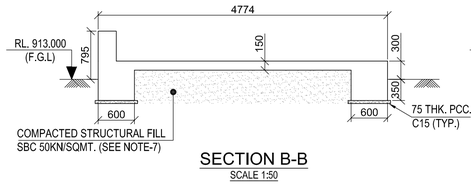


SECTION B-B

SCALE 1:50

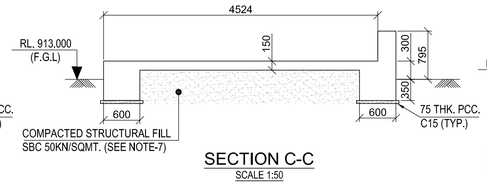


SECTION C-C

SCALE 1:50

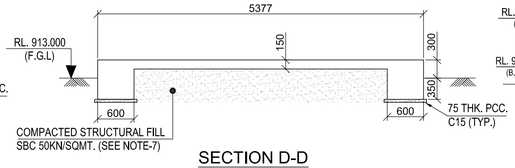


SECTION D-D

SCALE 1:50

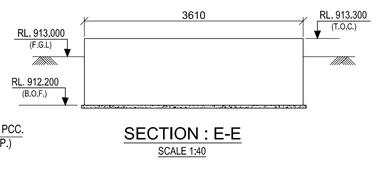


SECTION : E-E

SCALE 1:40

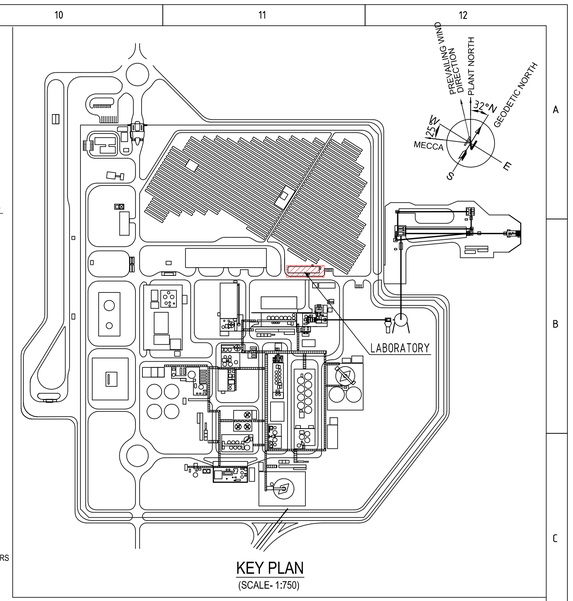


KEY PLAN

(SCALE- 1:750)

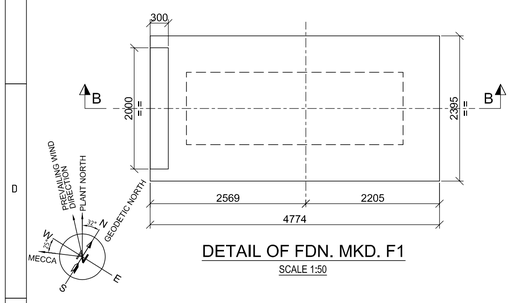


DETAIL OF FDN. MKD. F1

SCALE 1:50

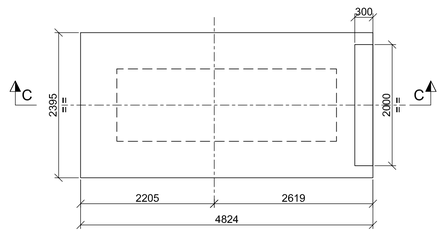


DETAIL OF FDN. MKD. F1A

SCALE 1:50

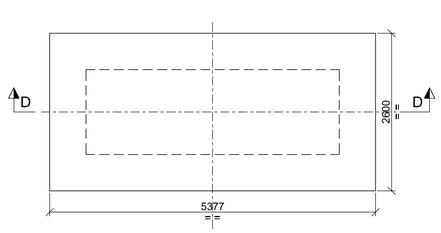


DETAIL OF FDN. MKD. F2

SCALE 1:50

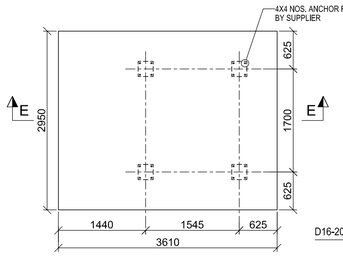

DETAIL OF FDN. MKD. F3

SCALE 1:50

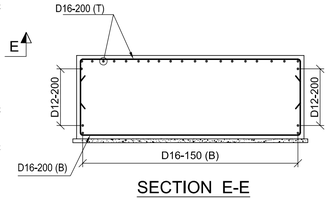


SECTION E-E

(R.C DETAILS)

SCALE 1:40

LEGEND :-

R.L. - REDUCED LEVEL
℄ - CENTRE LINE
T.O.C. - TOP OF CONCRETE
F.G.L. - FINISHED GROUND LEVEL
R.C - REINFORCED CONCRETE
B.O.F. - BOTTOM OF FOUNDATION
MKD. - MARKED
GA - GENERAL ARRANGEMENT
COL. - COLUMN
REINF. - REINFORCEMENT
TYP. - TYPICAL
P.C.C - PLAIN CEMENT CONCRETE
THK. - THICK
T.O.G. - TOP OF GROUT
DET. - DETAIL
DRG. - DRAWING
FDN. - FOUNDATION
R.C.C - REINFORCED CEMENT CONCRETE
BOTTOM REINFORCEMENT (B) - – – –
TOP REINFORCEMENT (T) - ———
CJ - CONSTRUCTION JOINT

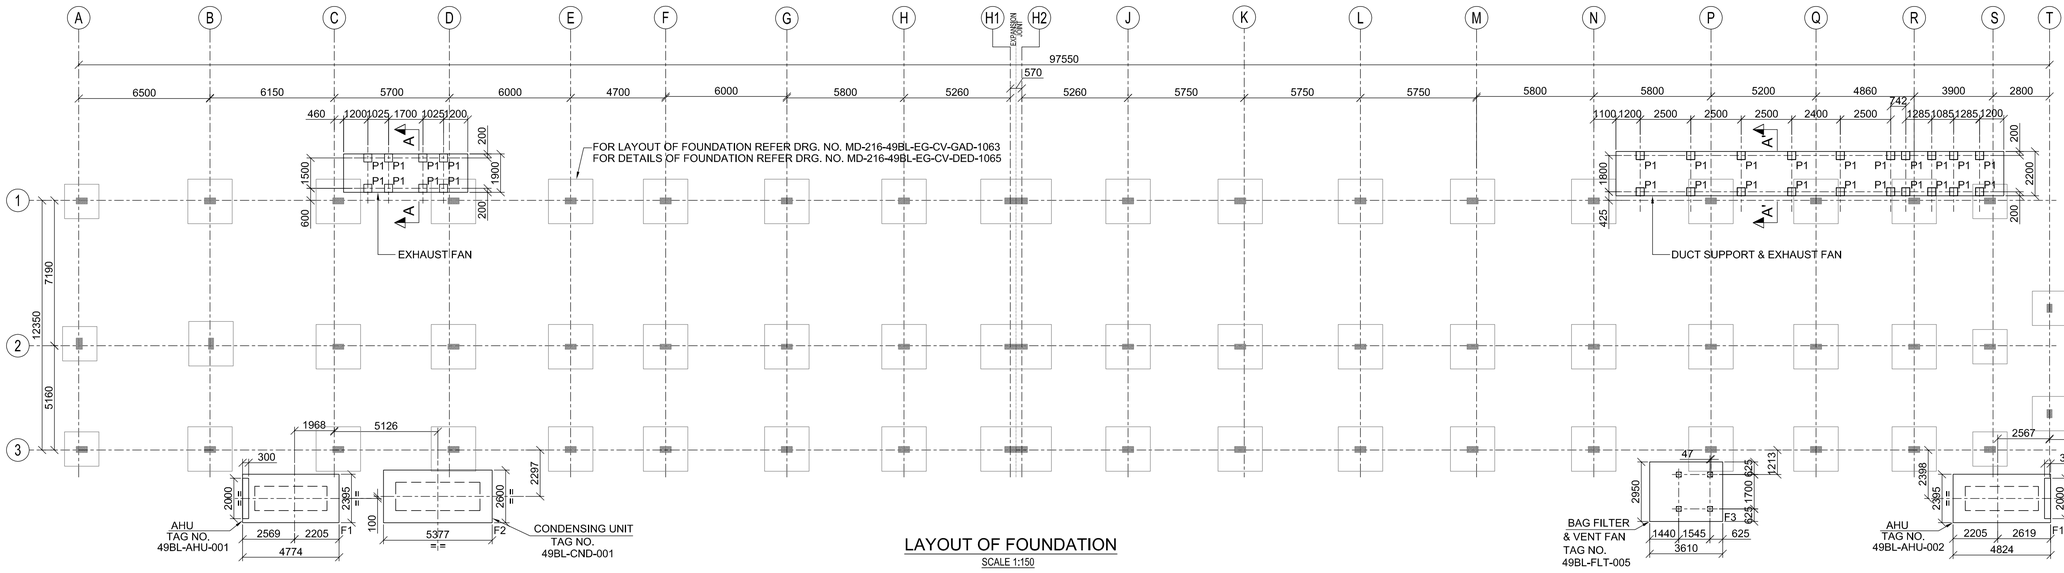

LAYOUT OF FOUNDATION

SCALE 1:150

NOTES:-

1. ALL DIMENSIONS ARE IN MILLIMETRES AND LEVELS AND CO-ORDINATES ARE IN METRES UNLESS OTHERWISE STATED.
2. NET SAFE BEARING CAPACITY OF SOIL AT BOTTOM OF FOUNDATION IS CONSIDERED AS 350KN/ SQ. M.
3. GRADE OF CONCRETE SHALL BE C35 (35Mpa) FOR FOUNDATION, C30 (30Mpa) FOR GRADE SLAB & C15 (15Mpa) FOR BLINDING CONCRETE.
4. GRADE OF REINFORCEMENT SHALL BE DEFORMED BAR 420 MPa (GRADE 60) - ASTM A615/A615M.
5. CLEAR COVER TO REINFORCEMENT SHALL BE AS FOLLOWS
   a) FOUNDATION = 50 mm
   b) COLUMN = 50mm
6. IF ANY PART OF FOUNDATION COMES ON BACKFILL ZONE OF ADJACENT FOUNDATION OR ANY LOOSE SOIL ARE ENCOUNTERED BELOW FOUNDATION LEVEL THE SAME SHALL BE REMOVED AND FILLED WITH PCC.
7. FOR STANDARD REINFORCEMENT DETAIL & GENERAL NOTES FOR CIVIL WORKS REFER DRAWING NO. MD-216-1000-EG-CV-DED-1005 & 1001.

DOCUMENT NUMBER	REFERENCE DOCUMENTS			REVISION DESCRIPTION	DRN	CHK	ENG	APP	EMP
MD-216-49BL-EG-CV-DED-1066	DETAIL OF ROOF & GRADE SLAB								
MD-216-49BL-EG-CV-DED-1065	DETAIL OF FDN. COL. & GRADE BEAM	D01	08/09/2023	AS-BUILT	SYA	SJM	AVG	AG	
MD-216-49BL-EG-HV-LAD-V567-1002	HVAC SYSTEM FOR LABORATORY BUILDING	C01	09/08/2021	ISSUED FOR CONSTRUCTION	SYA	SJM	AVG	AG	
MD-216-49BL-EG-HV-LAD-V567-1001	HVAC SYSTEM FOR LABORATORY BUILDING	A02	09/07/2021	REVISED AS PER EMPLOYER COMMENTS DATED 03/07/2021	SYA	SJM	AVG	AG	
MD-216-49BL-EG-ME-GAD-1001	LABORATORY PLAN & ELEVATION VIEW	A01	05/06/2021	ISSUED FOR APPROVAL	SYA	SJM	AVG	AG	

RESERVED FOR VENDOR LOGO AND DRAWING NUMBER

LARSEN & TOUBRO

This drawing is the property of *LARSEN & TOUBRO* and must not be passed on to any person or body not authorized by us to receive it nor be copied or otherwise made use either in full or in part by such person or body without our prior permission in writing.

Outotec

The content of these documents are the sole property of Outotec Oyj. Any rights not expressly granted herein are reserved. Reproduction, transfer or distribution of part or all of the contents in any form without prior written permission of Outotec is prohibited.

MA'ADEN معادن
Saudi Arabian Mining Company شركة التعدين العربية السعودية

This document and the information contained herein is Ma'aden proprietary know-how. This document or any part thereof should not be reproduced, stored in a retrieval system or transmitted by any means, electronic or otherwise, or divulged without prior written permission of Ma'aden.

LARSEN & TOUBRO DRAWING NUMBER		REVISION
019045_300_C_G_24654_001		3
OUTOTEC DRAWING NUMBER	DOCUMENT ID	REVISION
900707 _GAU01 _AL01_MTL01 _69021	OU100723932	3

DRAWN	SYA	03/06/2021
CHECKED	SJM	04/06/2021
ENGINEER	AVG	03/06/2021
APPROVED	AG	05/06/2021
EMPLOYER		
SCALE	1:150, 50, 40, 30	A1

MANSOURAH - MASSARAH GOLD PROJECT
GENERAL ARRANGEMENT DRAWING
PROCESS PLANT : LABORATORY BUILDING
LAYOUT AND DETAILS OF MISCELLANEOUS FDN.

DRAWING NUMBER: MD-216-49BL-EG-CV-GAD-1065 REV: D01

MA'ADEN معادن
Saudi Arabian Mining Company شركة التعدين العربية السعودية

BECHTEL

Mansourah Massarah Gold Project
Comment Resolution Log Sheet / Compliance Report

Outotec
LARSEN & TOUBRO

PROJECT: MANSOURAH MASSARAH GOLD PROJECT — **PROJECT NO.: 216**

STAGE: 4 - PROJECT EXECUTION. — **REVIEW LOG DOC. NO. & REV.:**

ACONEX REF. NO. & DATE: BECHTEL-WTRAN-011994, 08 August 2021

STATUS CODE: A - APPROVED, C - APPROVED WITH COMMENTS, R - REVISE & RESUBMIT & O - OTHERS (INFORMATION, REFERENCE, REVIEWED)

DOCUMENT NUMBER	Area / Title	Comment No.	PMC/PMT COMMENT DATE: 03 August 2021	Comment by	EPC Response DATE: 09 August 2021	Status	Remarks
			General Comments (cc)				
MD-216-49BL-EG-CV-GAD-1065-RA02	49BL	1	Please indicate full lines	Bechtel Mr. Doron Golan	The lines are not required. These are all pedestals not continuous wall.	Closed	

MA'ADEN معادن
Saudi Arabian Mining Company شركة التعدين العربية السعودية

Mansourah Massarah Gold Project
Comment Resolution Log Sheet / Compliance Report

Outotec
LARSEN & TOUBRO

PROJECT: MANSOURAH MASSARAH GOLD PROJECT — **PROJECT NO.: 216**

STAGE: 4 - PROJECT EXECUTION. — **REVIEW LOG DOC. NO. & REV.:**

ACONEX REF. NO. & DATE: BECHTEL-WTRAN-011362, 03 July 2021

STATUS CODE: A - APPROVED, C - APPROVED WITH COMMENTS, R - REVISE & RESUBMIT & O - OTHERS (INFORMATION, REFERENCE, REVIEWED)

DOCUMENT NUMBER	Area / Title	Comment No.	PMC/PMT COMMENT DATE: 03 July 2021	Comment by	EPC Response DATE: 09 July 2021	Status	Remarks
			General Comments (cc)				
MD-216-49BL-EG-CV-GAD-1065-RA01	49BL	1	Please include lab foundation detail drawing here	Bechtel Mr. Doron Golan	Indicated	Closed	
MD-216-49BL-EG-CV-GAD-1065-RA01	49BL	2	Please show slab falls	Bechtel Mr. Doron Golan	Top of FGL has been indicated for backfilling.	Closed	
MD-216-49BL-EG-CV-GAD-1065-RA01	49BL	3	Please shown equipment tag/name for these miscellaneous foundations	Bechtel Mr. Doron Golan	indicated	Closed	
MD-216-49BL-EG-CV-GAD-1065-RA01	49BL	4	Please refer drawing number xxxx for lab foundation details	Bechtel Mr. Doron Golan	Indicated	Closed	
MD-216-49BL-EG-CV-GAD-1065-RA01	49BL	5	Please shown equipment tag/name for these miscellaneous foundations	Bechtel Mr. Doron Golan	Indicated	Closed	
MD-216-49BL-EG-CV-GAD-1065-RA01	49BL	6	Miscellaneous concrete foundation shown here is different from the latest NavisWork Model, please clarify this	Bechtel Mr. Doron Golan	Navisworks was not properly generated from E3D model. Now it has been rectified and uploaded again.	Closed	
MD-216-49BL-EG-CV-GAD-1065-RA01	49BL	7	Please show full line for upstand	Bechtel Mr. Doron Golan	Indicated	Closed	
MD-216-49BL-EG-CV-GAD-1065-RA01	49BL	8	Please show slab falls	Bechtel Mr. Doron Golan	Top of FGL has been indicated for backfilling.	Closed	