


DRAWING NUMBER: MD-216-49BL-EG-CV-GAD-1066 | REV: D01

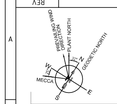


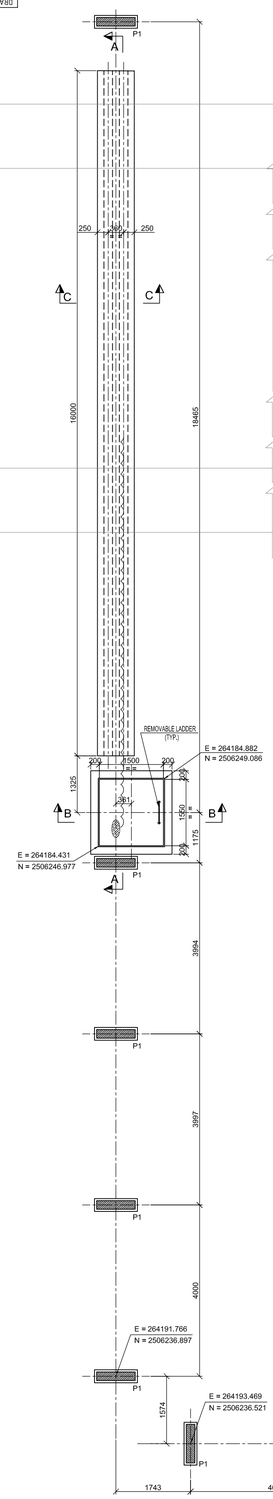




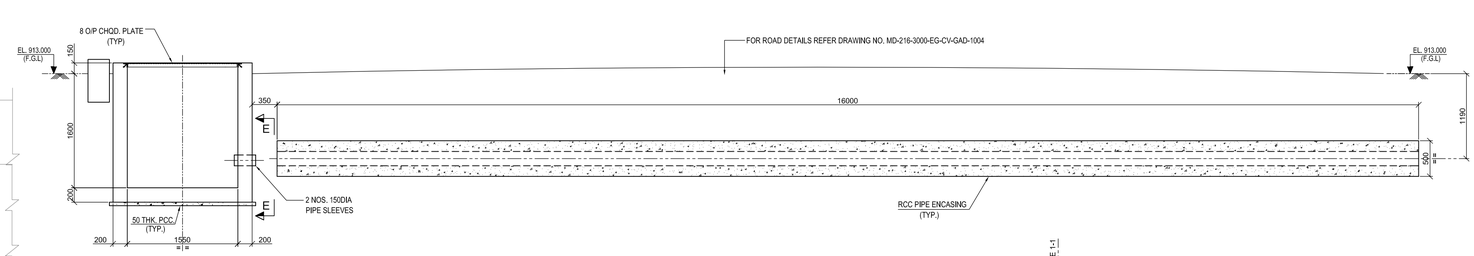


SECTION A - A
(SCALE 1:30)

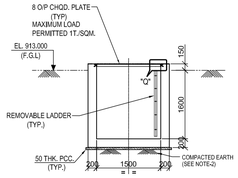


SECTION B - B
(SCALE 1:50)

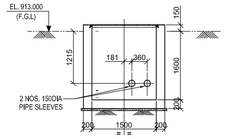


SECTION E - E
(SCALE 1:50)

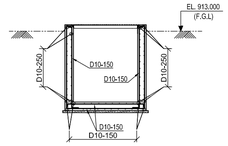



SECTION B - B
(SHOWING RC DETAIL)
(SCALE 1:50)

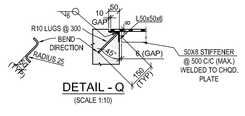


DETAIL - Q
(SCALE 1:10)

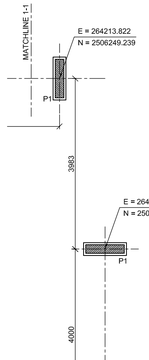

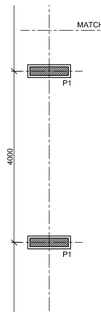


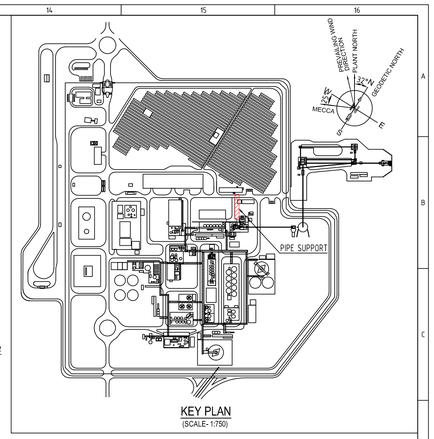


KEY PLAN
(SCALE- 1:750)

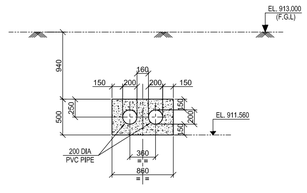


SECTION C - C
(SCALE 1:30)

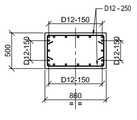


SECTION C - C
(SHOWING RC DETAIL)
(SCALE 1:30)

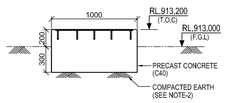


SECTION D-D
(SCALE - 1:25)

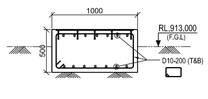


SECTION D-D
(R.C DETAILS)
(SCALE - 1:25)

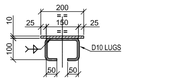

SECTION S1 - S1
(SCALE 1:10)

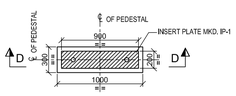

TYP. PLAN OF
PEDESTAL MKD. P1
(SCALE 1:25)

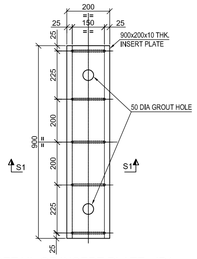

DETAIL OF INSERT PLATE - IP1
(SCALE 1:10)

LEGEND :-

R.L. - REDUCED LEVEL
℄ - CENTRE LINE
T.O.C. - TOP OF CONCRETE
F.G.L. - FINISHED GROUND LEVEL
R.C - REINFORCED CONCRETE
B.O.F. - BOTTOM OF FOUNDATION
MKD. - MARKED
GA - GENERAL ARRANGEMENT
COL. - COLUMN
REINF. - REINFORCEMENT
TYP. - TYPICAL
P.C.C. - PLAIN CEMENT CONCRETE
THK. - THICK
T.O.G. - TOP OF GROUT
DET. - DETAIL
DRG. - DRAWING
FDN. - FOUNDATION
R.C.C - REINFORCED CEMENT CONCRETE
SUPPT. - SUPPORT
CHQD. - CHEQUERED
DIA - DIAMETER
MAX. - MAXIMUM

NOTES:-

1. ALL DIMENSIONS ARE IN MILLIMETRES AND LEVELS AND CO-ORDINATES ARE IN METRES UNLESS OTHERWISE STATED.
2. NET SAFE BEARING CAPACITY OF SOIL AT BOTTOM OF FOUNDATION IS CONSIDERED AS 100KN/ SQ. M.
3. GRADE OF CONCRETE SHALL BE C35 (35Mpa).
4. GRADE OF REINFORCEMENT SHALL BE DEFORMED BAR 420 MPa (GRADE 60) - ASTM A615/A615M.
5. IF ANY PART OF FOUNDATION COMES ON BACKFILL ZONE OF ADJACENT FOUNDATION OR ANY LOOSE SOIL ARE ENCOUNTERED BELOW FOUNDATION LEVEL THE SAME SHALL BE REMOVED AND FILLED WITH PCC.
6. FOR STANDARD REINFORCEMENT DETAIL & GENERAL NOTES FOR CIVIL WORKS REFER DRAWING NO. MD-216-1000-EG-CV-DED-1005 & 1001.

DOCUMENT NUMBER	REFERENCE DOCUMENTS	REV	DATE	REVISION DESCRIPTION	DRN	CHK	ENG	APP	EMP
		D01	21/7/2023	AS BUILT	S.Y.A	A.V.G	S.J.M	A.G	
		C01	28/01/2022	ISSUED FOR CONSTRUCTION & REVISED AS PER EMPLOYER COMMENTS DATED 26/01/2022	S.Y.A	A.V.G	S.J.M	A.G	
		A01	30/12/2021	ISSUED FOR APPROVAL	S.Y.A	A.V.G	S.J.M	A.G	

RESERVED FOR VENDOR LOGO AND DRAWING NUMBER

LARSEN & TOUBRO

This drawing is the property of LARSEN & TOUBRO and must not be passed on to any person or body not authorized by us to receive it nor be copied or otherwise made use either in full or in part by such person or body without our prior permission in writing.

Outotec

The content of these documents are the sole property of Outotec Oyj. Any rights not expressly granted herein are reserved. Reproduction, transfer or distribution of part or all of the contents in any form without prior written permission of Outotec is prohibited.

MA'ADEN معادن
Saudi Arabian Mining Company شركة معادن العربية السعودية

This document and the information contained herein is Ma'aden proprietary know-how. This document or any part thereof should not be reproduced, stored in a retrieval system or transmitted by any means, electronic or otherwise, or divulged without prior written permission of Ma'aden.

LARSEN & TOUBRO DRAWING NUMBER			REVISION
01904.5_300_C_G_24668_001			2
OUTOTEC DRAWING NUMBER		DOCUMENT ID	REVISION
900707__GAU01__AN03_MTL01__49031		OU100740078	2
DRAWN	S.Y.A	27/12/2021	MANSOURAH - MASSARAH GOLD PROJECT
CHECKED	A.V.G	28/12/2021	GENERAL ARRANGEMENT DRAWING
ENGINEER	S.J.M	27/12/2021	PROCESS PLANT : LABORATORY AREA
APPROVED	A.G	30/12/2021	LAYOUT & DET. OF PIPE SUPPT.,ENCASING & PIT
EMPLOYER			
SCALE	1:50,25,10	A0	DRAWING NUMBER: MD-216-49BL-EG-CV-GAD-1066
			REV: D01

MA'ADEN معادن
Saudi Arabian Mining Company شركة التعدين العربية السعودية

BECHTEL

Mansourah Massarah Gold Project
Comment Resolution Log Sheet / Compliance Report

Outotec
LARSEN & TOUBRO

PROJECT: MANSOURAH MASSARAH GOLD PROJECT **PROJECT NO.: 216**

STAGE: 4 - PROJECT EXECUTION. **REVIEW LOG DOC. NO. & REV.:**

ACONEX REF. NO. & DATE: BECHTEL-WTRAN-014094, 26 January 2022

STATUS CODE: A - APPROVED, C - APPROVED WITH COMMENTS, R - REVISE & RESUBMIT & O - OTHERS (INFORMATION, REFERENCE, REVIEWED)

DOCUMENT NUMBER	Area / Title	Comment No.	PMC/PMT COMMENT DATE: 26 January 2022	Comment by	EPC Response DATE: 27 January 2022	Status	Remarks
			General Comments (cc)				
MD-216-49BL-EG-CV-GAD-1066-A01	49BL	1	Please show road curb	Bechtel Mr. Hong Su	Indicated	Closed	
MD-216-49BL-EG-CV-GAD-1066-A01	49BL	2	For road work details, refer drawing number xxxx	Bechtel Mr. Hong Su	Indicated	Closed	
MD-216-49BL-EG-CV-GAD-1066-A01	49BL	3	Grade of steel for checker plate and connection	Bechtel Mr. Hong Su	As per standared	Closed	
MD-216-49BL-EG-CV-GAD-1066-A01	49BL	4	Earthworks for road crossings shall be constructed per 5.15 of MD-101-SMEM-EG-CV-SPC-0003	Bechtel Mr. Hong Su	Not relivent for this drawing.	Closed	