DRAWING NUMBER MD - 216 - 4000 - EG - CV - GAD - 1084
REV D01

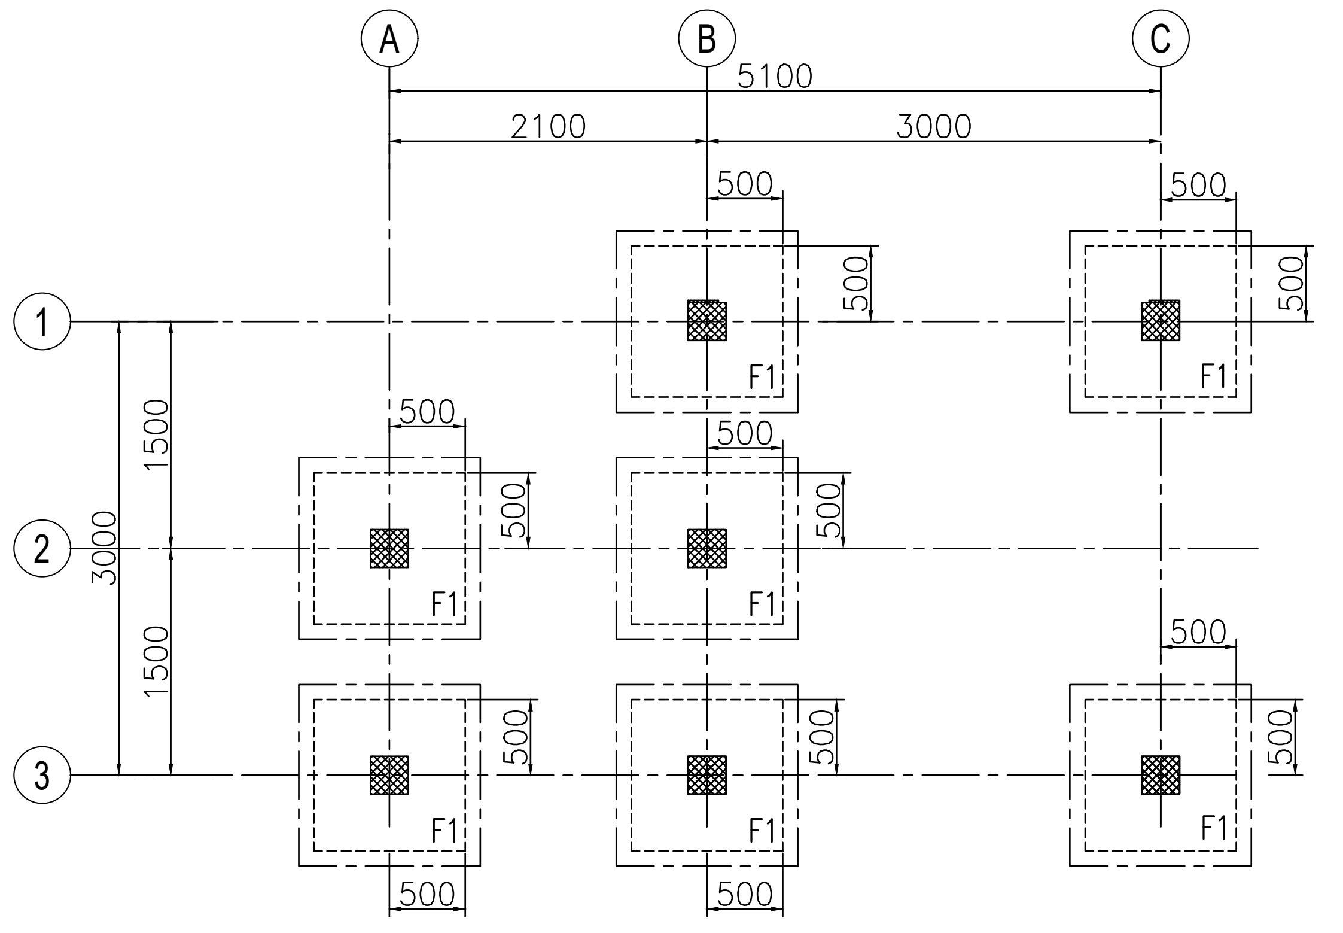

FOUNDATION LAYOUT

SCALE 1:50

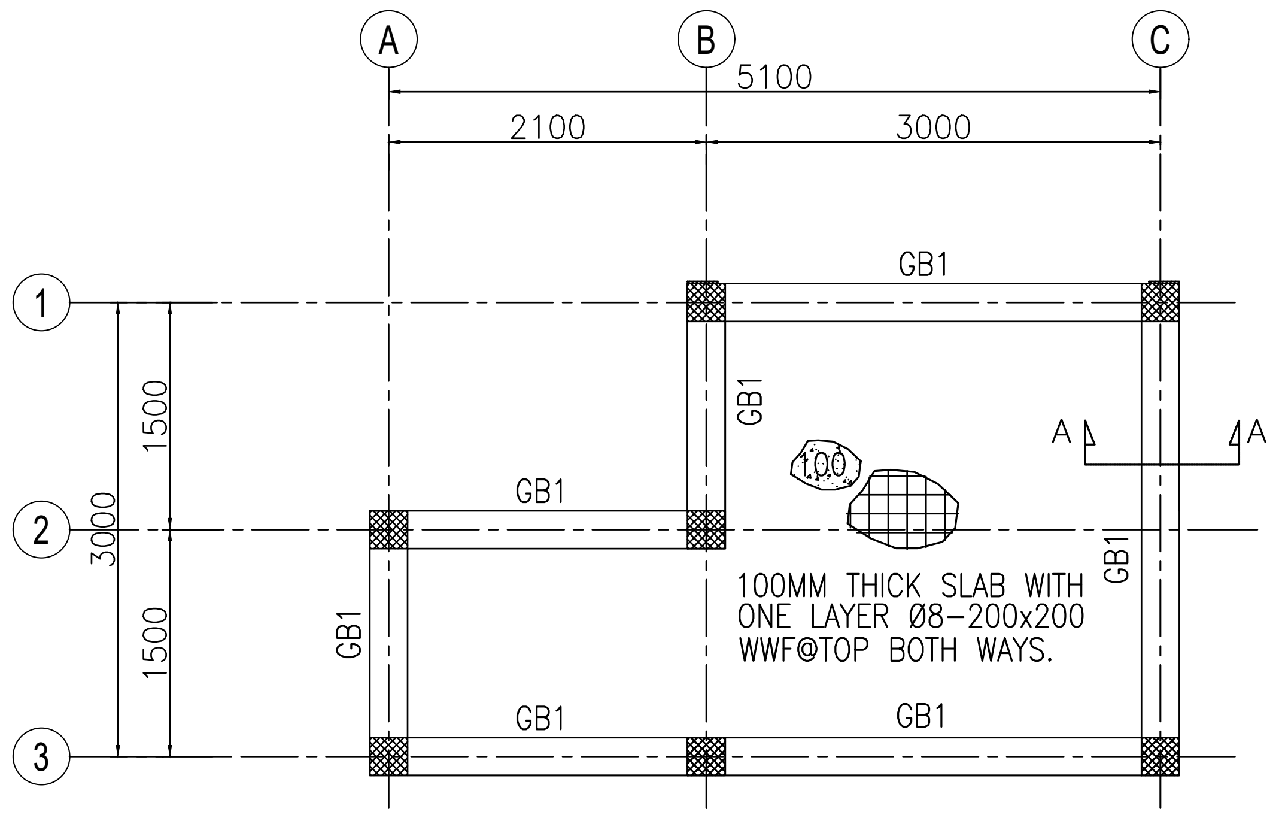
A
B
C
5100
2100
3000
1
2
3
1500
3000
GB1
A
A
100
100MM THICK SLAB WITH ONE LAYER Ø8-200x200 WWF@TOP BOTH WAYS.

GRADE BEAM LAYOUT

SCALE 1:50

KEY PLAN

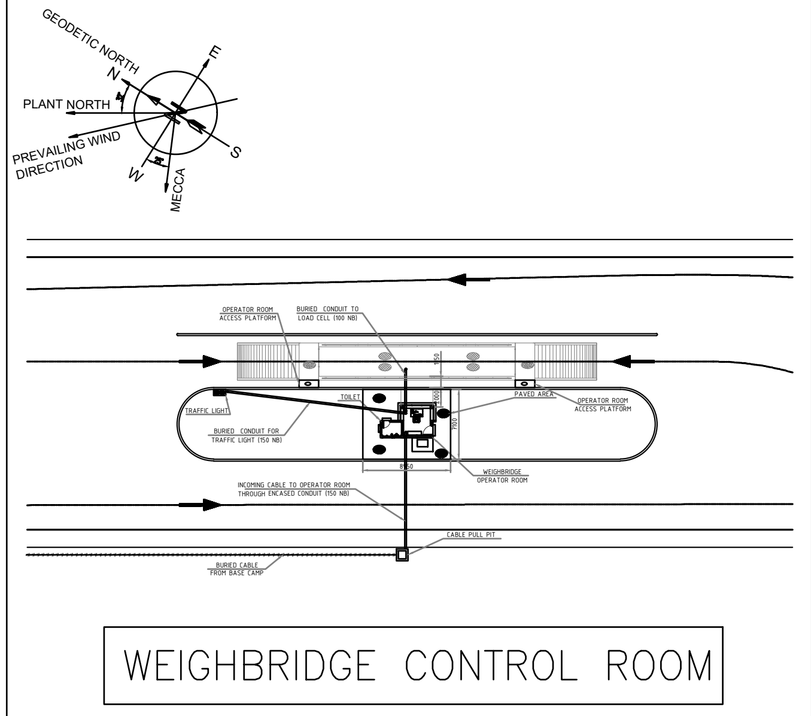

ENLARGED KEYPLAN

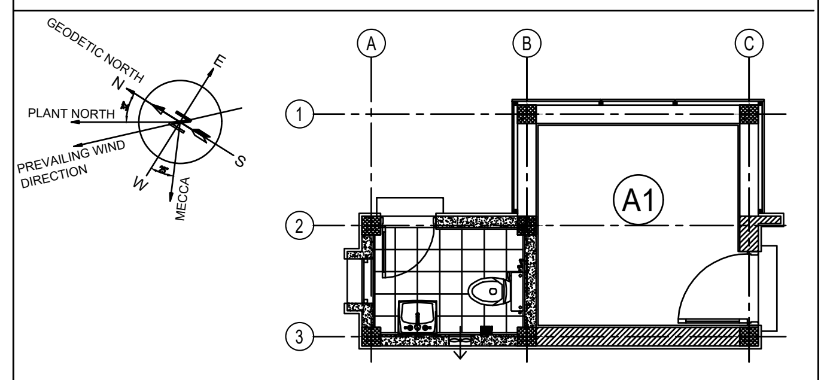

WEIGHBRIDGE CONTROL ROOM			
BLDG. NO.	CORNER NO.	EASTING	NORTHING
A1	A3	E=262288.799	N=2508598.969
	C1	E=262293.996	N=2508596.140

SCHEDULE OF FOOTINGS

FOOTING MARK	PLAIN CONCRETE			REINFORCED CONCRETE			BOTTOM REINFORCEMENT		TOP REINFORCEMENT		Ha	REMARKS
	L	W	T	L	W	T	SHORT BARS	LONG BARS	SHORT BARS	LONG BARS		
F1	1200	1200	50	1000	1000	300	ø12@200	ø12@200	–	–	1200	

SCHEDULE OF GRADE BEAMS

BEAM MARK	DIMENSIONS		STEEL REINFORCEMENT				SIDE BAR EACH FACE	STIRRUPS
			BOTTOM		TOP			
	WIDTH	DEPTH	STRAIGHT	ADD.	STRAIGHT	ADD.		
GB1	250	700	3ø20	–	3ø20	–	1ø12	PROVIDE ø10@150 AT END SPAN@DISTANCE OF L/3 FROM THE SUPPORT & ø10@200 AT MIDSPAN

NOTES

1. ALL DIMENSIONS ARE GIVEN IN MILLIMETRES AND ELEVATIONS ARE IN METRES UNLESS OTHERWISE NOTED.
2. MINIMUM REINFORCED CONCRETE GRADE TO BE USED FOR SUPERSTRUCTURE & SUBSTRUCTURES IS C35(5000 PSI).
3. MINIMUM LEAN CONCRETE GRADE TO BE USED FOR THE SUB-STRUCTURES IS C15(2175 PSI).
4. ALL REINFORCING STEEL SHALL BE DEFORMED BILLET STEEL BARS CONFORMING TO ASTM-A615, WITH MINIMUM YIELD STRENGTH OF FY420 MPA .
5. THE NET SOIL BEARING CAPACITY CONSIDERED IN FOUNDATION DESIGN IS 570 KPA(REFER DOC 216-3000-EG-CV-RPT-1008)
6. WATER PROOFING INSULATION SHALL BE AS PER PROJECT SPECIFICATIONS & ITS MATERIAL TO BE APPROVED BY SITE ENGINEER.
7. MINIMUM CONCRETE COVER AS PER SBC-304-2018(TABLE 20.6.1.3.1) MEASURED FROM REBAR SHALL BE
   a. CONCRETE CAST AGAINST & PERMANENTLY EXPOSED TO EARTH (INCLUDING FOUNDATIONS OVER SUB-SLAB)
      FORMED CONCRETE EXPOSED TO EARTH OR WEATHER..........50MM
   b. CONCRETE NOT EXPOSED TO WEATHER NOR IN CONTACT WITH GROUND
      BEAMS, COLUMNS..........40MM
      SLABS, WALLS, JOISTS..........20MM
   c. CONCRETE SLAB OVER 50MM SUB-SLAB..........20MM
8. ALL DRAWINGS MUST BE READ IN CONJUNCTION WITH RELEVANT ARCHITECTURAL AND ENGINEERING DRAWINGS RELATED TO THE SAME SHEET AND ANY ITEM ON IT.
9. F.F.L +0.300 MENTIONED IS EQUIVALENT TO RL 922.65

LEGENDS

F/FDN.-FOUNDATION
CR-COLUMN NECK
C/COL.-COLUMN
FFL-FINISH FLOOR LEVEL
FGL-FINISH GROUND LEVEL
VER-VERTICAL
WWF-WELDED WIRE FABRIC
HCS-HOLLOW CORE SLAB
GB-GRADE BEAM
IJ-ISOLATION JOINT
CJ-CONTROL JOINT
BW's-BOTH WAYS
S.O.G-SLAB ON GRADE
TYP-TYPICAL
HOR.-HORIZONTAL
REINF.-REINFORCEMENT
LVL.-LEVEL
RL.-REDUCED LEVEL
P.-PEDESTAL
℄ - CENTRE LINE OF COLUMN
EF. - EACH FACE
DIA-DIAMETER

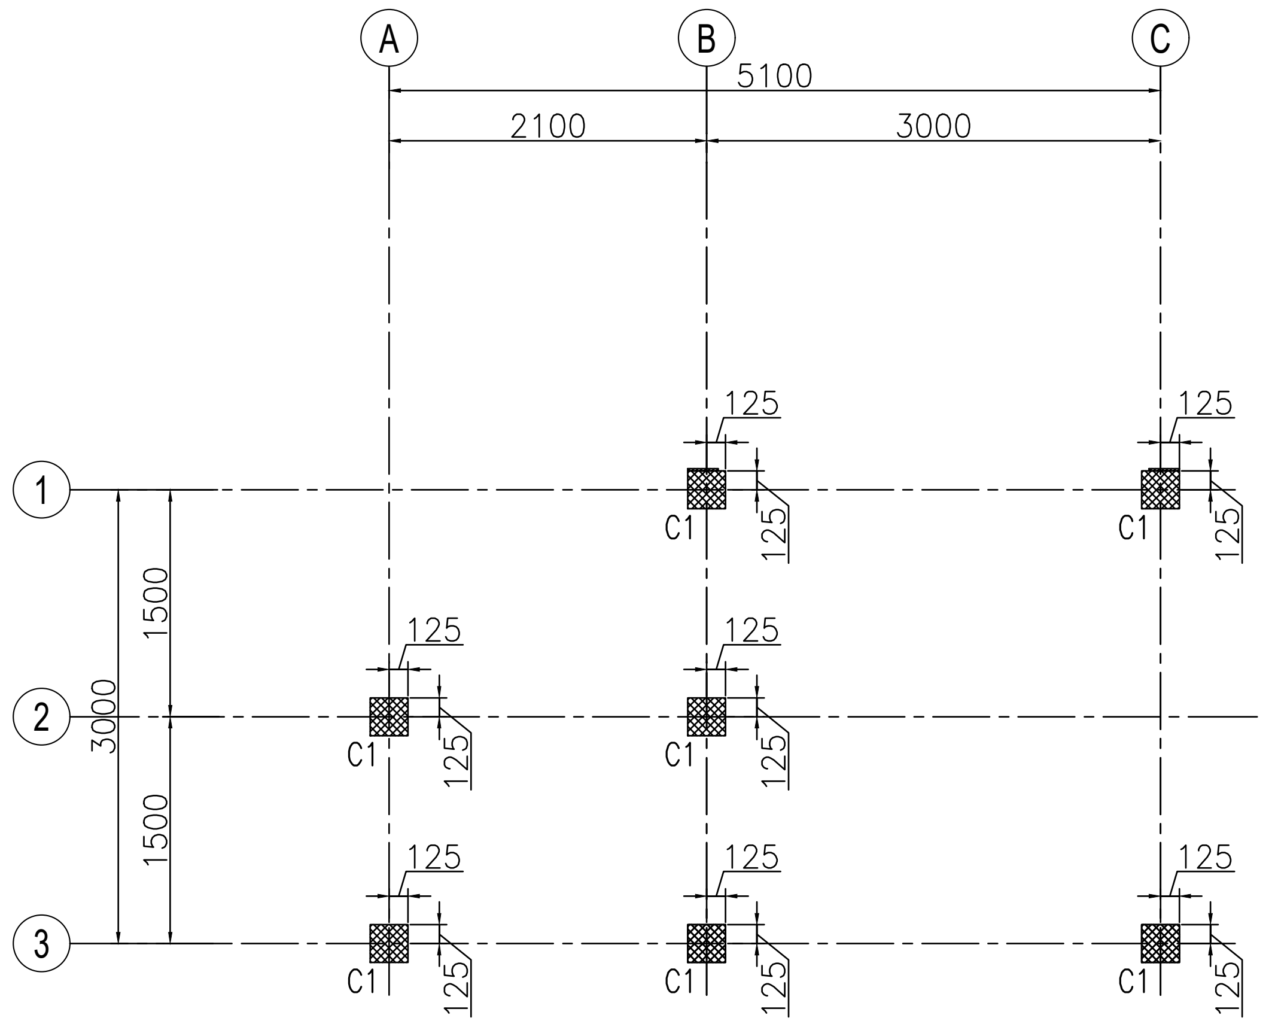

COLUMN LAYOUT

SCALE 1:50

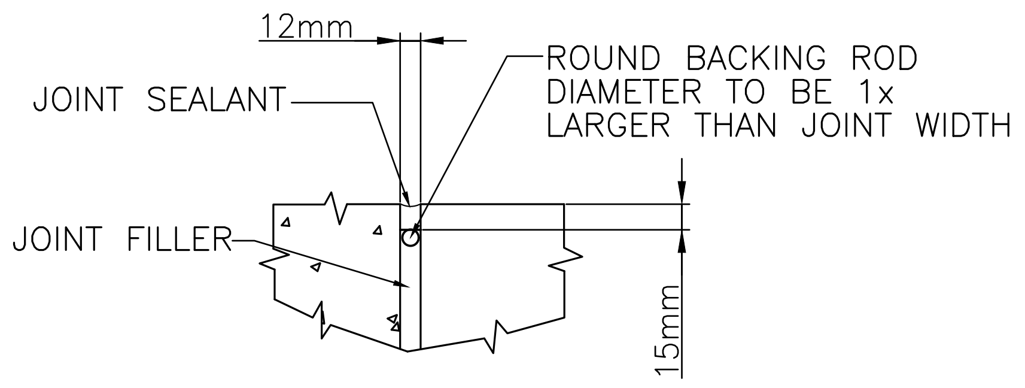

TYP JOINT SEAL DETAIL-C

SCALE 1:10

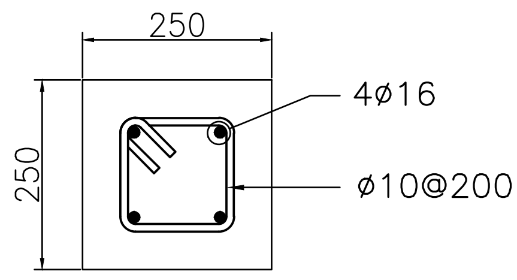

COLUMN DETAIL (C1)

SCALE 1:10

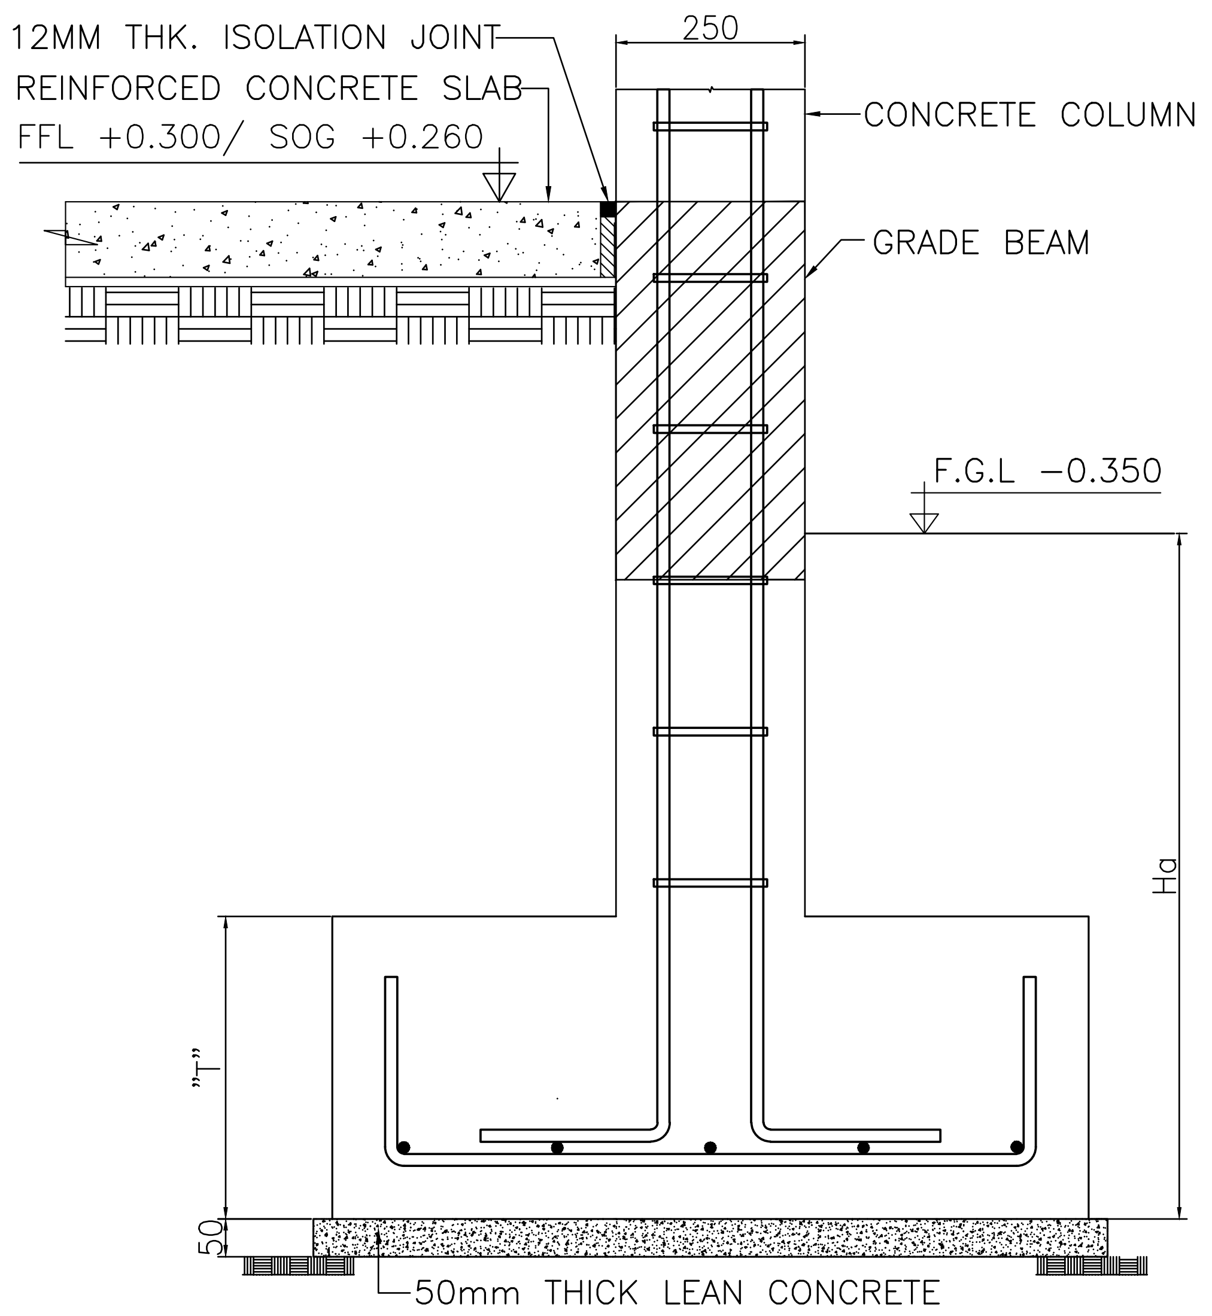

FOUNDATION SECTION

SCALE 1:10

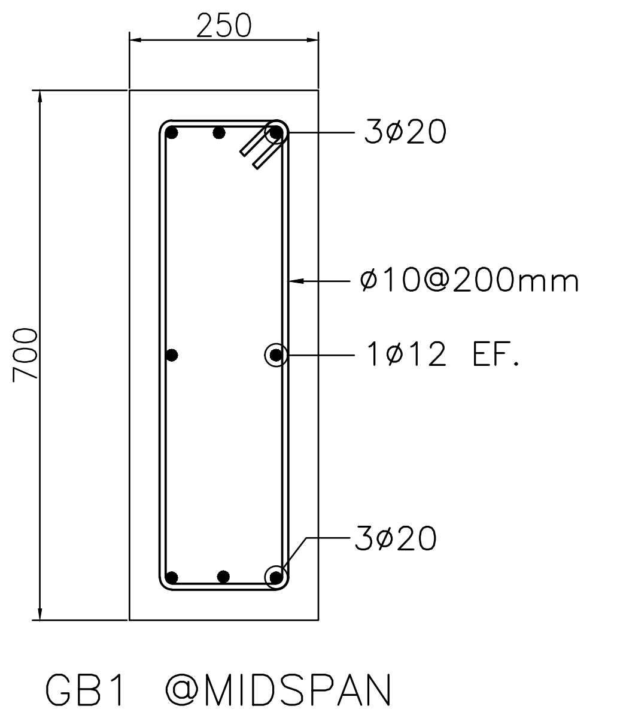

GB1 @MIDSPAN

SCALE 1:10

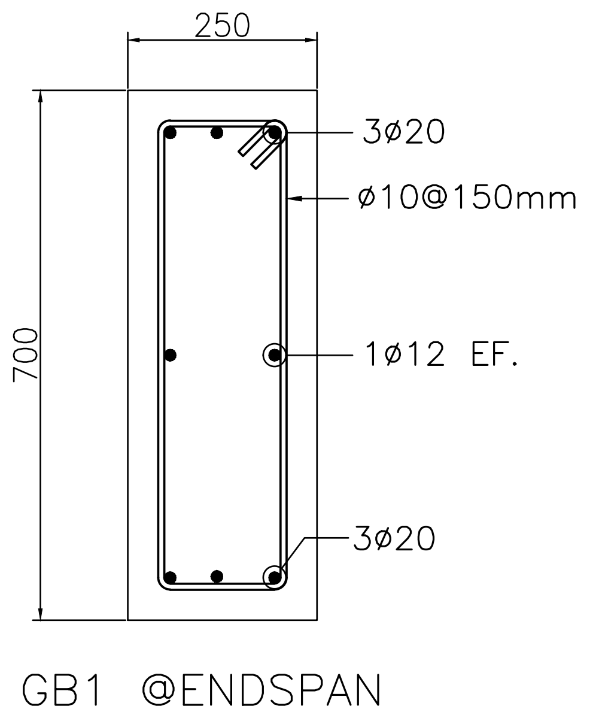

GB1 @ENDSPAN

SCALE 1:10

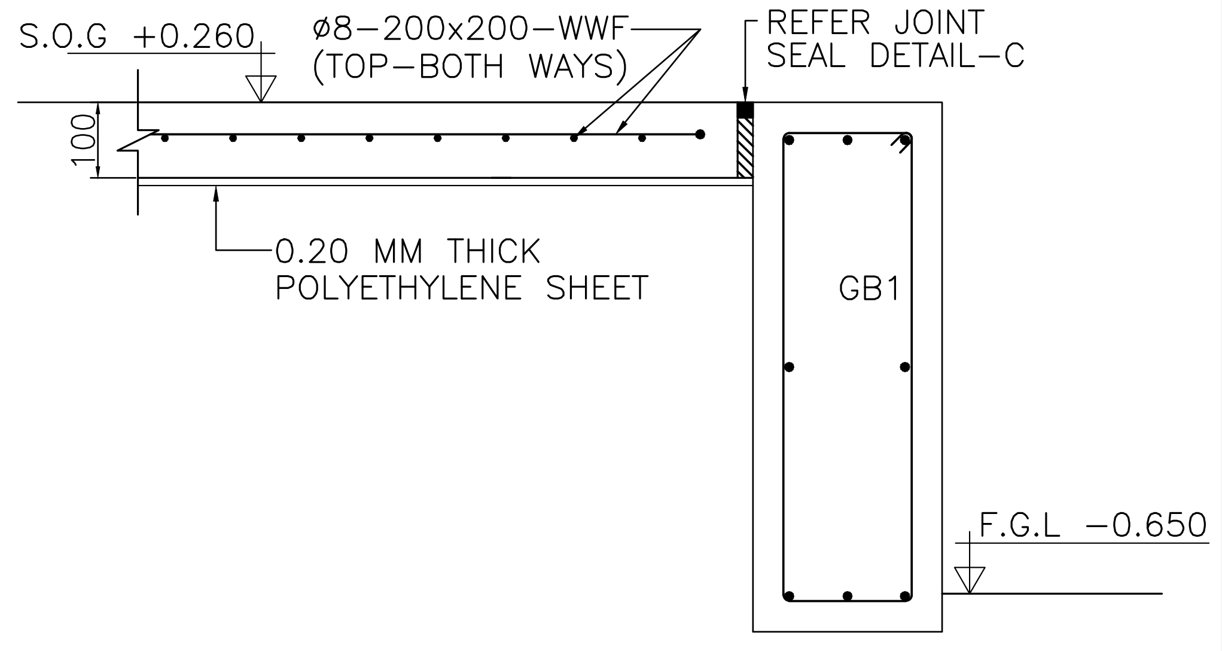
S.O.G +0.260
ø8-200x200-WWF (TOP-BOTH WAYS)
REFER JOINT SEAL DETAIL-C
100
0.20 MM THICK POLYETHYLENE SHEET
GB1
F.G.L -0.650

TYP SECTION (A) FOR GRADE SLAB

SCALE 1:10

DOCUMENT NUMBER	REFERENCE DOCUMENTS	REV	DATE	REVISION DESCRIPTION	DRN	CHK	ENG	APP	EMP
MD-216-4000-EG-CV-DED-1085	RC DETAILS BUILDING STRUCTURE								
MD-216-6000-EG-CV-STD-1002	HOLLOW CORE SLAB STANDARD	D01	22/02/2023	AS-BUILT	--	AVG	--	SJM	
MD-216-6000-EG-CV-STD-1001	REINFORCEMENT STANDARD	C02	02/04/2021	ISSUED FOR CONSTRUCTION & REVISED AS MARKED C2	--	AVG	--	SJM	
MD-216-3000-EG-ME-GAD-1002	BUILDING PLANS	C01	28/07/2020	ISSUED FOR CONSTRUCTION	--	AVG	--	SJM	
MD-216-6000-EG-CV-GAD-1535	OVERALL LAYOUT PLAN	A01	29/06/2020	ISSUED FOR APPROVAL	--	AVG	--	SJM	

DESIGNER:
مكتب الخليج للاستشارات الهندسية
الخبر، المملكة العربية السعودية
GULF CONSULT
ARCHITECTS AND ENGINEERS

DRAWING NUMBER						REVISION
WEIG.-CONTROL-ROOM-ST-001						0
DATE	25/06/2020	DATE	26/06/2020	DATE	27/06/2020	
DRAWN	MAH	CHECKED	MF	APPROVED	FK	

LARSEN & TOUBRO DRAWING NUMBER		REVISION
019045_910_C_G_24044_001		3
OUTOTEC DRAWING NUMBER	DOCUMENT ID	REVISION
900707 _GAU01 _AN03_MTL01 _40080	0U100688276	3

LARSEN & TOUBRO

This drawing is the property of LARSEN & TOUBRO and must not be passed on to any person or body not authorized by us to receive it nor be copied or otherwise made use either in full or in part by such person or body without our prior permission in writing.

Outotec

The content of these documents are the sole property of Outotec Oyj. Any rights not expressly granted herein are reserved. Reproduction, transfer or distribution of part or all of the contents in any form without prior written permission of Outotec is prohibited.

MA'ADEN معادن
Saudi Arabian Mining Company شركة التعدين العربية السعودية

This document and the information contained herein is Ma'aden proprietary know-how. This document or any part thereof should not be reproduced, stored in a retrieval system or transmitted by any means, electronic or otherwise, or divulged without prior written permission of Ma'aden.

DRAWN	--	--
CHECKED	AVG	28/06/2020
ENGINEER	--	--
APPROVED	SJM	29/06/2020
EMPLOYER		
SCALE	1:50	A1

MANSOURAH - MASSARAH GOLD PROJECT
GENERAL ARRANGEMENT DRAWING
PROCESS PLANT-WEIGHBRIDGE CONTROL ROOM
LAYOUT AND DETAIL OF FDN.,COL. & GRADE BEAM

DRAWING NUMBER
MD - 216 - 4000 - EG - CV - GAD - 1084
REV
D01