


DRAWING NUMBER: MD-216-4000-EG-CV-GAD-1101 | REV: D01

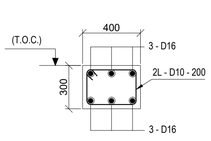


RC. DET. OF B1
SCALE 1:20

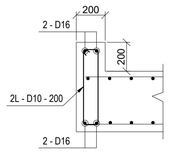


SECTION : B-B
SCALE 1:20

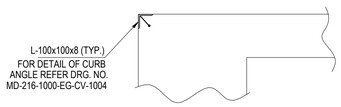


DETAIL - '1'
DETAIL - '1A' (OPPOSITE HAND)
SCALE 1:20

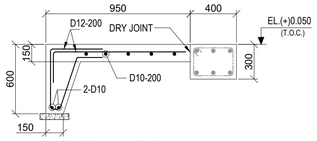


SECTION : D-D
SECTION : D1-D1 (OPPOSITE HAND)
SCALE 1:25

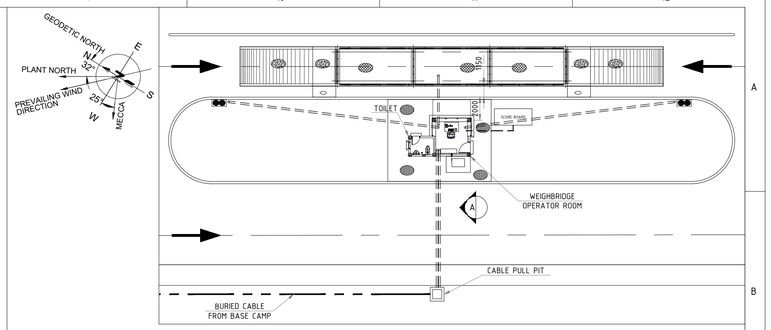


KEY PLAN
(SCALE - 1:250)

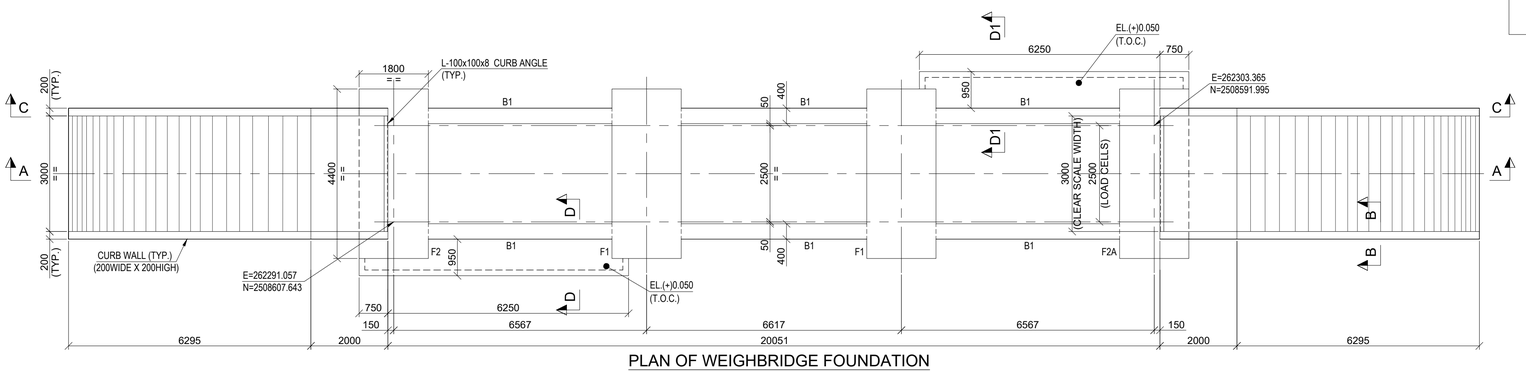


PLAN OF WEIGHBRIDGE FOUNDATION
SCALE 1:75

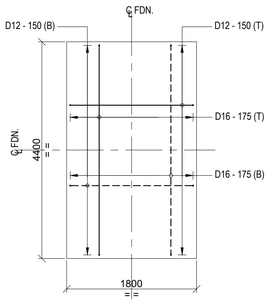


RCC. DET. OF FOUNDATION
MKD. F1
SCALE 1:40

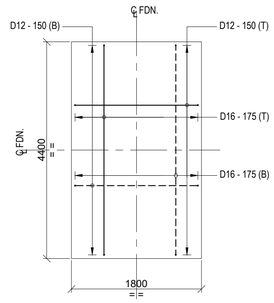


RCC. DET. OF FOUNDATION
MKD. F2 & F2A
SCALE 1:40

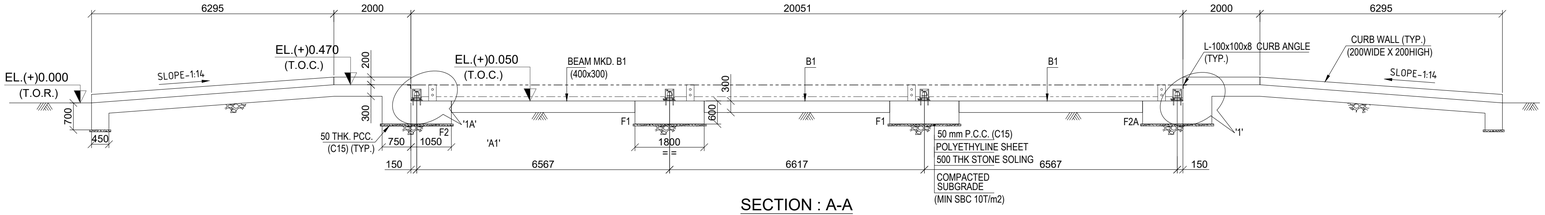

SECTION : A-A
SCALE 1:75

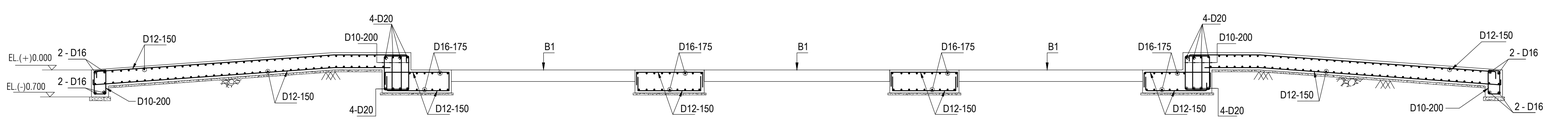

SECTION : A-A
RC. DETAIL
SCALE 1:75

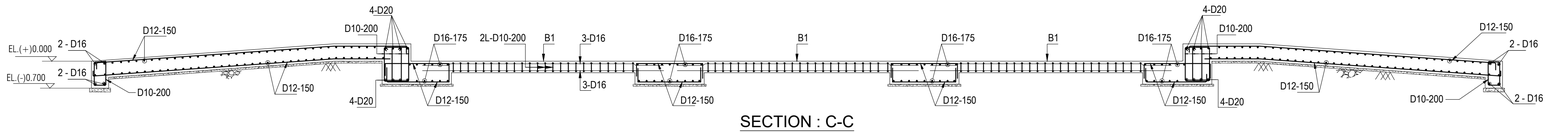

SECTION : C-C
RC. DETAIL
SCALE 1:75

LEGEND :-

E.L. - ELEVATION LEVEL
℄ - CENTRE LINE
T.O.C. - TOP OF CONCRETE
F.G.L. - FINISHED GROUND LEVEL
F.F.L. - FINISHED FLOOR LEVEL
B.O.F. - BOTTOM OF FOUNDATION
TYP. - TYPICAL
R.C.C - REINFORCED CEMENT CONCRETE
P.C.C - PLAIN CEMENT CONCRETE
MKD. - MARKED
THK. - THICK
T.O.R. - TOP OF ROAD
EQV. - EQUIVALENT
BOTTOM REINFORCEMENT (B) - – – – – – –
TOP REINFORCEMENT (T) - ————
DET. - DETAIL
COL. - COLUMN
FDN. - FOUNDATION

NOTES:-

1. ALL DIMENSIONS ARE IN MILLIMETRES AND LEVELS AND CO-ORDINATES ARE IN METRES UNLESS OTHERWISE STATED.
2. GRADE OF CONCRETE SHALL BE C35 (35MPa) FOR FOUNDATION, C30 (30MPa) FOR GRADE SLAB & C15 (15MPa) FOR BLINDING CONCRETE.
3. GRADE OF REINFORCEMENT SHALL BE DEFORMED BAR 420 MPa (GRADE 60) - ASTM A615/A615M.
4. GRADE OF WELDED WIRE MESH SHALL BE GRADE 60 (fy = 420 MPa) ACCORDING TO A1064.
5. NET SAFE BEARING CAPACITY OF SOIL AT BOTTOM OF FOUNDATION IS CONSIDERED AS 100KN/ SQ. M.
6. CLEAR COVER TO REINFORCEMENT SHALL BE AS FOLLOWS
   a) FOUNDATION = 50 mm
   b) WALLS = 50mm
7. FOR STANDARD REINFORCEMENT DETAIL & GENERAL NOTES FOR CIVIL WORKS REFER DRAWING NO. MD-216-1000-EG-CV-DED-1005 & 1001.

DOCUMENT NUMBER	REFERENCE DOCUMENTS	REV	DATE	REVISION DESCRIPTION	DRN	CHK	ENG	APP	EMP
		D01	26/05/2023	AS-BUILT	ABS	SJM	AVG	AG	
		C02	02/04/2021	ISSUED FOR CONSTRUCTION AND REVISED AS MKD. C02	ABS	SJM	AVG	AG	
MD-216-1000-EG-ST-CRT-1001	CIVIL, STRUCTURAL & ARCHITECTURAL - DESIGN CRITERIA	C01	20/02/2021	ISSUED FOR CONSTRUCTION AND REVISED AS MKD. C01	ABS	SJM	AVG	AG	
MD-216-39RD-EG-ME-GAD-V559-2001	WEIGH BRIDGE PLAN & ELEVATION VIEW	A01	24/12/2020	ISSUED FOR APPROVAL	ABS	SJM	AVG	AG	

RESERVED FOR VENDOR LOGO AND DRAWING NUMBER

LARSEN & TOUBRO
This drawing is the property of LARSEN & TOUBRO and must not be passed on to any person or body not authorized by us to receive it nor be copied or otherwise made use either in full or in part by such person or body without our prior permission in writing.

Outotec
The content of these documents are the sole property of Outotec Oyj. Any rights not expressly granted herein are reserved. Reproduction, transfer or distribution of part or all of the contents in any form without prior written permission of Outotec is prohibited.

MA'ADEN معادن
Saudi Arabian Mining Company شركة معادن العربية السعودية
This document and the information contained herein is Ma'aden proprietary know-how. This document or any part thereof should not be reproduced, stored in a retrieval system or transmitted by any means, electronic or otherwise, or divulged without prior written permission of Ma'aden.

LARSEN & TOUBRO DRAWING NUMBER	019045_910_C_G_24085_001		REVISION 3
OUTOTEC DRAWING NUMBER	900707 __GAU01 __AN03__MTL01 __40098	DOCUMENT ID OU100710513	REVISION 3

DRAWN	ABS	18/12/2020
CHECKED	SJM	21/12/2020
ENGINEER	AVG	19/12/2020
APPROVED	AG	24/12/2020
EMPLOYER		
SCALE	1:20, 1:40, 1:75	A1

MANSOURAH - MASSARAH GOLD PROJECT
GENERAL ARRANGEMENT DRAWING
WEIGH BRIDGE
LAYOUT AND DETAILS OF FOUNDATION

DRAWING NUMBER: MD-216-4000-EG-CV-GAD-1101 | REV: D01