


DRAWING NUMBER: MD-216-4000-EG-CV-GAD-1102 | REV: D01

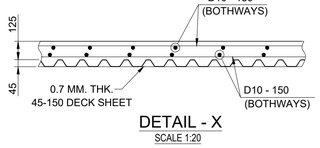


DETAIL - X
SCALE 1:20

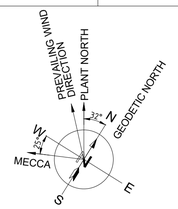


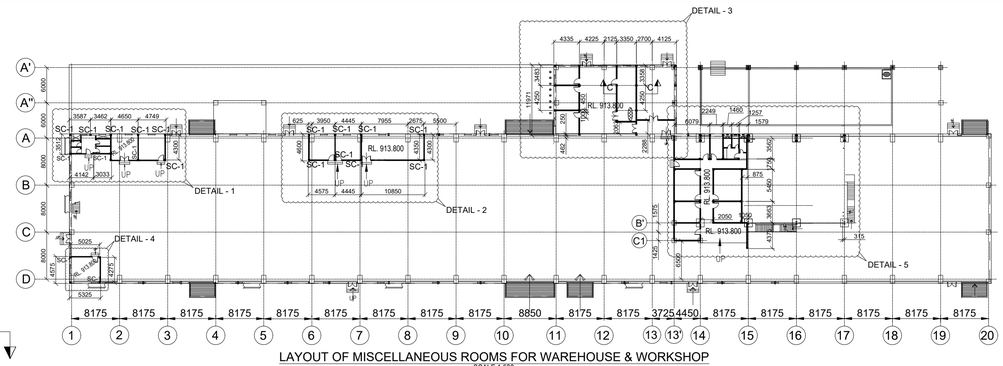


LAYOUT OF MISCELLANEOUS ROOMS FOR WAREHOUSE & WORKSHOP
SCALE 1:500

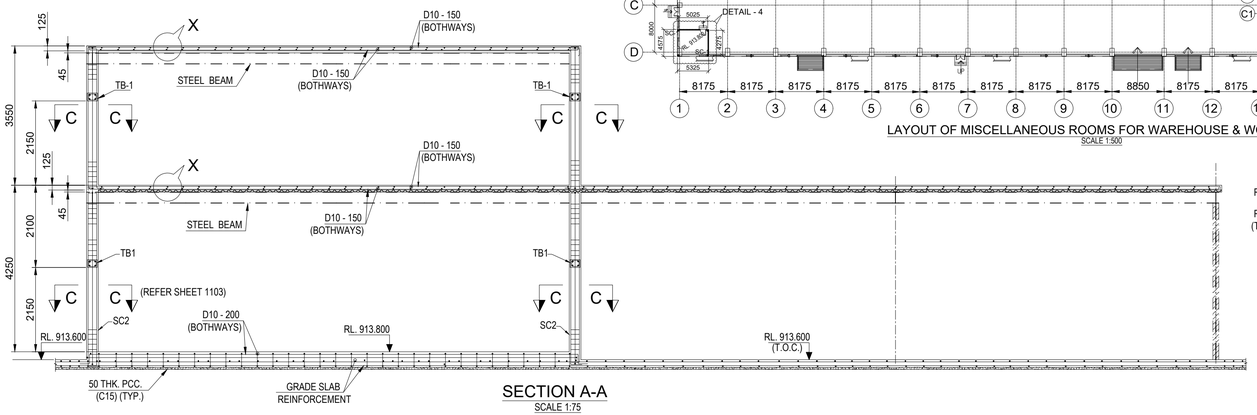


SECTION A-A
SCALE 1:75

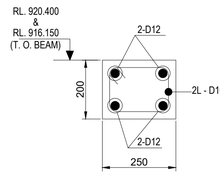


RC. DET. OF TB1
SCALE 1:10

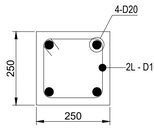


SECTION C-C
RC DETAIL OF COL. MKD. SC-2
SCALE 1:10

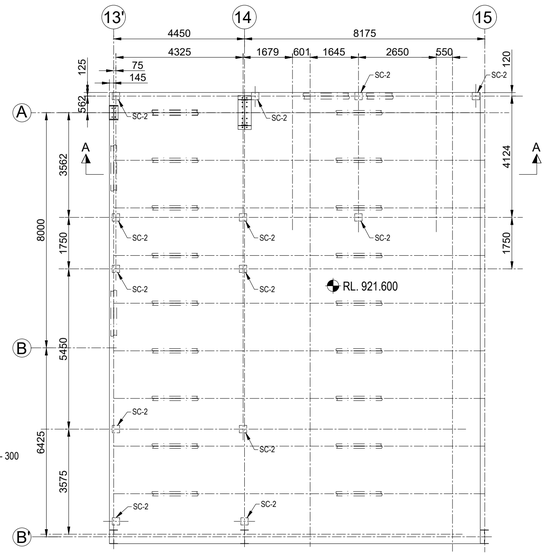

DETAIL -5
PLAN AT ROOF LEVEL AT RL 921.600
SCALE 1:100

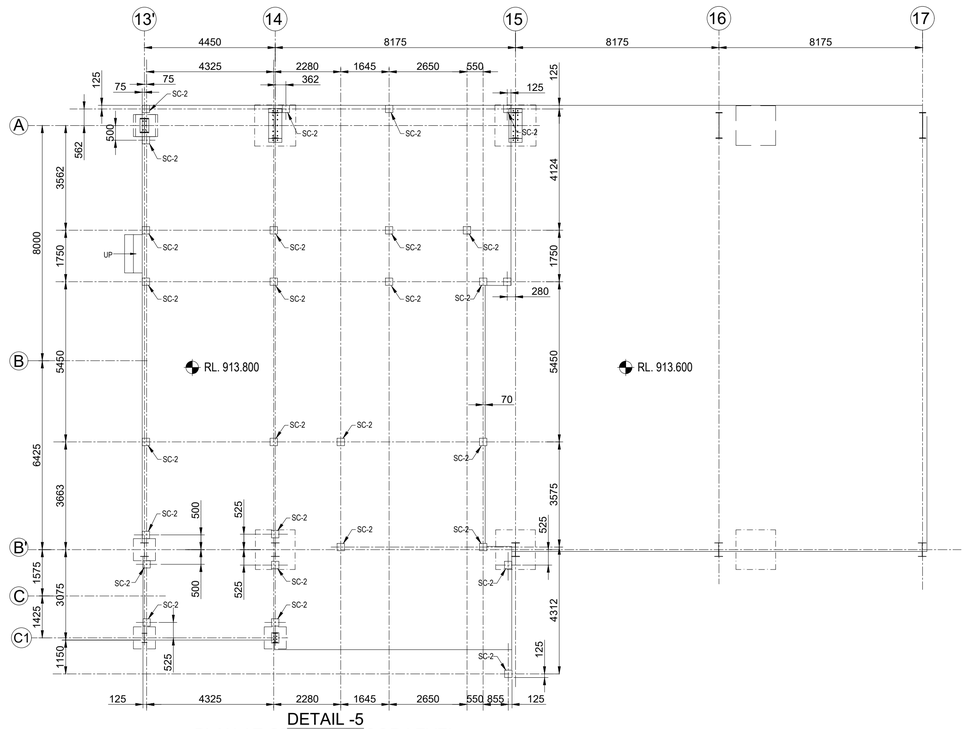

DETAIL -5
PLAN AT GROUND FLOOR LEVEL
SCALE 1:100

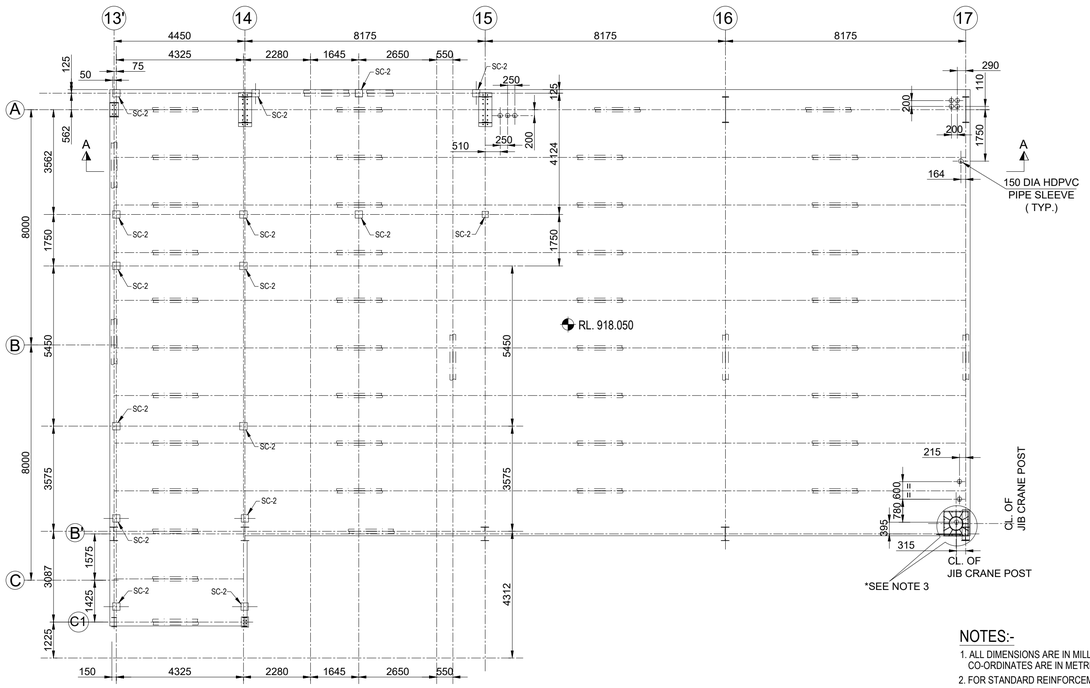

DETAIL -5
PLAN AT ROOF LEVEL AT RL. 918.050
SCALE 1:100

LEGENDS :-

R.L. - REDUCED LEVEL
℄ - CENTRE LINE
T.O.C. - TOP OF CONCRETE
TYP. - TYPICAL
P.C.C - PLAIN CEMENT CONCRETE
R.C. - REINFORCED CONCRETE
MKD. - MARKED
SC - STUB COLUMN
DET - DETAIL

NOTES:-

1. ALL DIMENSIONS ARE IN MILLIMETRES AND LEVELS AND CO-ORDINATES ARE IN METRES UNLESS OTHERWISE STATED.
2. FOR STANDARD REINFORCEMENT DETAIL & GENERAL NOTES FOR CIVIL WORKS REFER DRAWING NO. MD-216-1000-EG-CV-DED-1005 & 1001.

*3. THIS PORTION OF CONCRETE CASTING WILL BE DONE AFTER PLACING OF JIB CRANE

DOCUMENT NUMBER	REFERENCE DOCUMENTS	REV	DATE	REVISION DESCRIPTION	DRN	CHK	ENG	APP	EMP
		D01	22/02/2023	AS-BUILT	SR	SJM	BJB	AG	
MD-216-4000-EG-CV-DED-1061	WAREHOUSE & WORKSHOP GROUND FLOOR PLAN & DETAILS	C02	07/04/2021	ISSUED FOR CONSTRUCTION & REVISED AS MARKED /C02	SR	SJM	BJB	AG	
MD-216-4000-EG-CV-GAD-1103	LAYOUT & DETAIL OF MISCELLANEOUS ROOMS-2	C01	09/03/2021	ISSUED FOR CONSTRUCTION & REVISED AS MARKED /C01	SR	SJM	BJB	AG	
MD-216-4000-EG-ST-GAD-2052 TO 2065 & 2072	WARE HOUSE & WORKSHOP STRUCTURAL DRAWING	A01	27/01/2021	ISSUED FOR REVIEW	SR	SJM	BJB	AG	

RESERVED FOR VENDOR LOGO AND DRAWING NUMBER

LARSEN & TOUBRO

This drawing is the property of *LARSEN & TOUBRO* and must not be passed on to any person or body not authorized by us to receive it nor be copied or otherwise made use either in full or in part by such person or body without our prior permission in writing.

Outotec

The content of these documents are the sole property of Outotec Oyj. Any rights not expressly granted herein are reserved. Reproduction, transfer or distribution of part or all of the contents in any form without prior written permission of Outotec is prohibited.

MA'ADEN معادن
Saudi Arabian Mining Company شركة المعادن العربية السعودية

This document and the information contained herein is Ma'aden proprietary know-how. This document or any part thereof should not be reproduced, stored in a retrieval system or transmitted by any means, electronic or otherwise, or divulged without prior written permission of Ma'aden.

LARSEN & TOUBRO DRAWING NUMBER	019045_501_C_G_24552_001	REVISION 3
OUTOTEC DRAWING NUMBER	900707__GAU01__AN03__MTL01__40099	DOCUMENT ID 0U100711129 / REVISION 3

DRAWN	SR	22/01/2021
CHECKED	SJM	25/01/2021
ENGINEER	BJB	19/01/2021
APPROVED	AG	27/01/2021
EMPLOYER		
SCALE	1:100, 1:10, 1:75	A1

MANSOURAH - MASSARAH GOLD PROJECT
GENERAL ARRANGEMENT DRAWING
PROCESS PLANT- WAREHOUSE & WORKSHOP
LAYOUT & DETAIL OF MISCELLANEOUS ROOMS-1

DRAWING NUMBER: MD-216-4000-EG-CV-GAD-1102 | REV: D01