


DRAWING NUMBER MD-216-4000-EG-CV-GAD-1103 REV D01

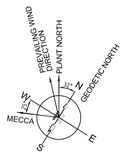


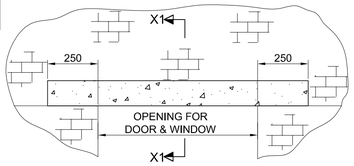


TYPICAL DET. OF PIECE LINTEL
SCALE 1:15

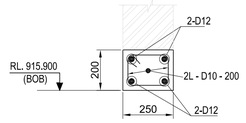


X1-X1
(RC DETAIL OF PIECE LINTEL)
SCALE 1:15

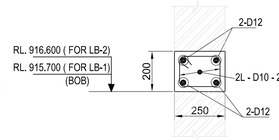


RC. DET. OF BAND LINTEL
SCALE 1:15

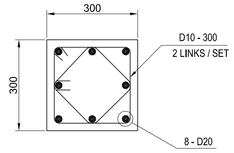


SECTION B-B
RC. DET. OF COLUMN MKD. SC1
SCALE 1:10

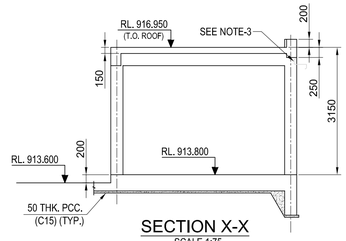


SECTION X-X
SCALE 1:75

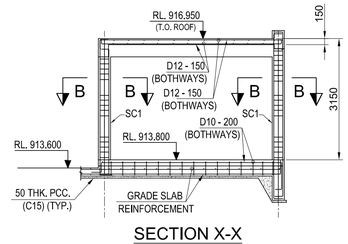


SECTION X-X
(R.C. DETAIL)
SCALE 1:75

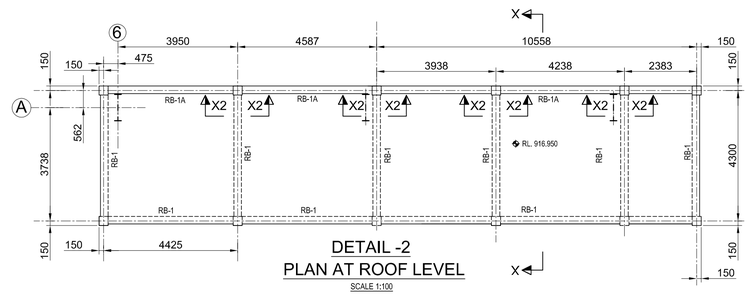


DETAIL -2
PLAN AT ROOF LEVEL
SCALE 1:100

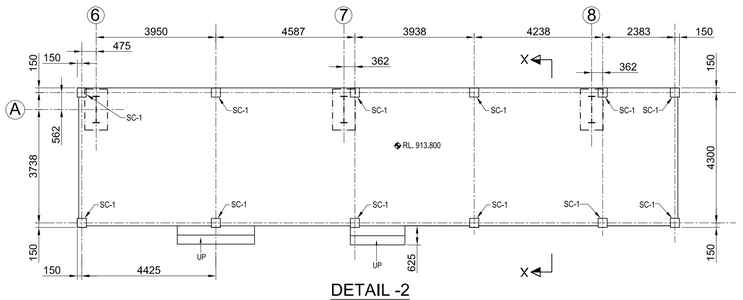


DETAIL -2
PLAN AT GROUND FLOOR LEVEL
SCALE 1:100

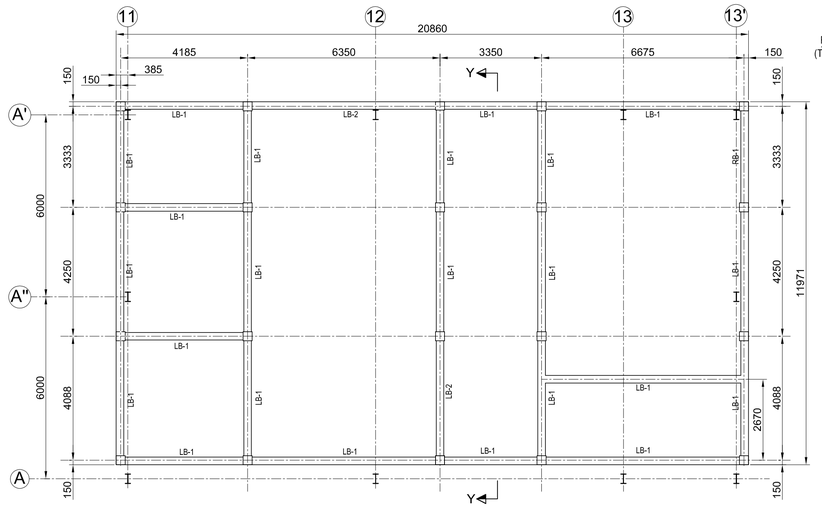


DETAIL -3
PLAN AT LINTEL LEVEL
SCALE 1:100

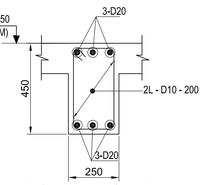


RC. DET. OF RB1
SCALE 1:15

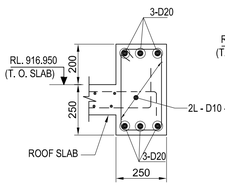


RC. DET. OF RB1A
SCALE 1:15

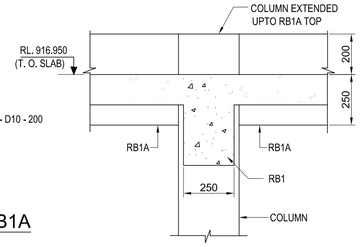


SECTION X2-X2
SCALE 1:15

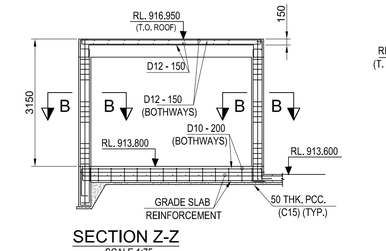


SECTION Z-Z
SCALE 1:75

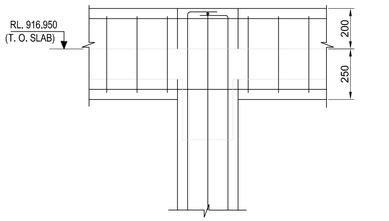


SECTION X2-X2
(R.C DETAILS)
SCALE 1:15

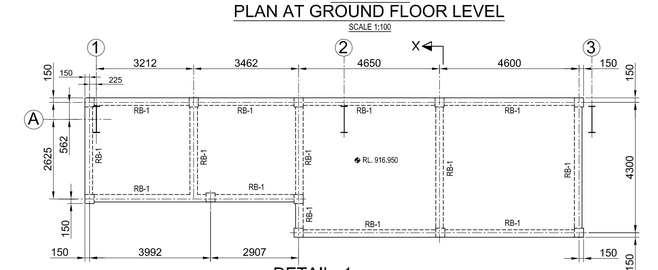


DETAIL -1
PLAN AT ROOF LEVEL
SCALE 1:100

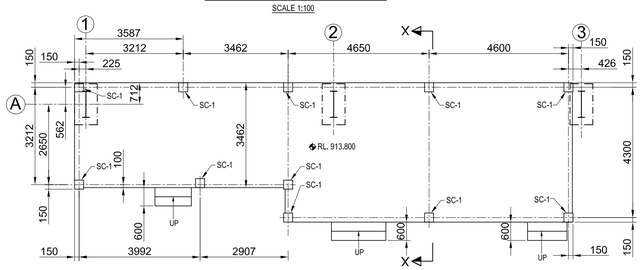


DETAIL -1
PLAN AT GROUND FLOOR LEVEL
SCALE 1:100

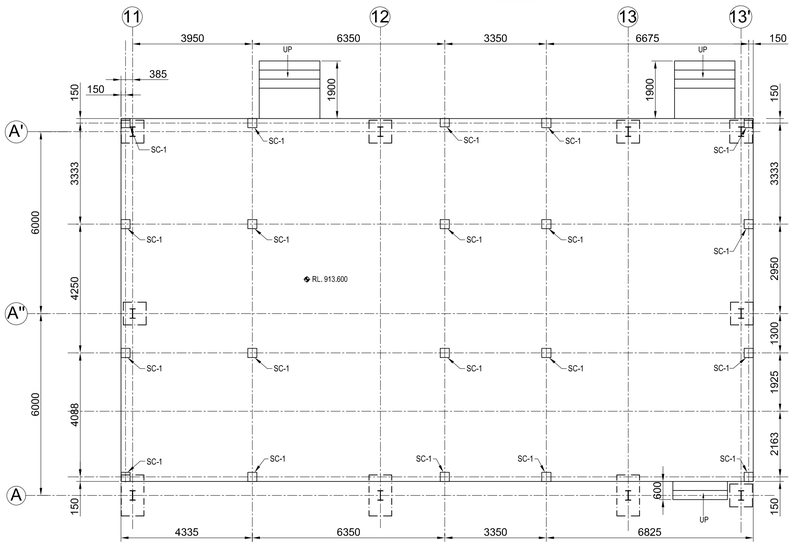


DETAIL -3
PLAN AT GROUND FLOOR LEVEL
SCALE 1:100

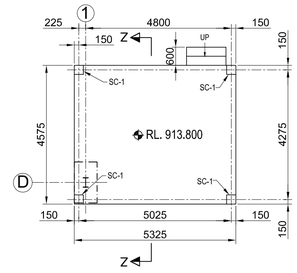


DETAIL -4
PLAN AT GROUND FLOOR LEVEL
SCALE 1:100

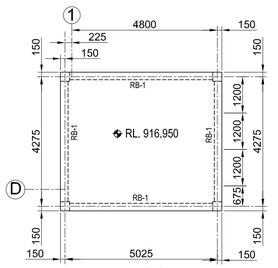

PLAN AT ROOF LEVEL
SCALE 1:100

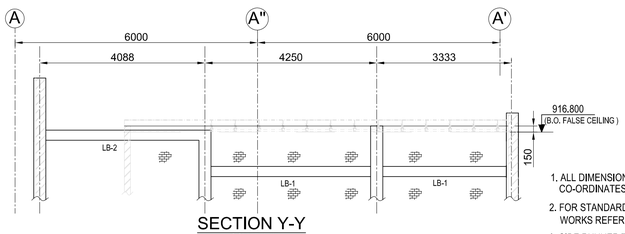

SECTION Y-Y
SCALE 1:75

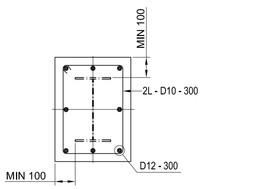

TYP. STEEL COLUMN ENCASING DETAIL
SCALE 1:15

LEGENDS :-

R.L. - REDUCED LEVEL
℄ - CENTRE LINE
T.O.C. - TOP OF CONCRETE
T.O. - TOP OF
MIN - MINIMUM
TYP. - TYPICAL
P.C.C - PLAIN CEMENT CONCRETE
R.C. - REINFORCED CONCRETE
SC - STUB COLUMN
BOB - BOTTOM OF BEAM

NOTES:-

1. ALL DIMENSIONS ARE IN MILLIMETRES AND LEVELS AND CO-ORDINATES ARE IN METRES UNLESS OTHERWISE STATED.
2. FOR STANDARD REINFORCEMENT DETAIL & GENERAL NOTES FOR CIVIL WORKS REFER DRAWING NO. MD-216-1000-EG-CV-DED-1005 & 1001.
3. SIDE RUNNER TO BE LOCALLY CUT, STIFFENED & SCREWED TO RCC COLUMN.

DOCUMENT NUMBER	REFERENCE DOCUMENTS	REV	DATE	REVISION DESCRIPTION	DRN	CHK	ENG	APP	EMP
		D01	26/05/2023	AS-BUILT	SYA	SJM	BJB	AG	
MD-216-4000-EG-CV-DED-1061	WAREHOUSE & WORKSHOP GROUND FLOOR PLAN & DETAILS	C02	17/05/2022	ISSUED FOR CONSTRUCTION & REVISED AS MARKED /C02\	SYA	SJM	BJB	AG	
MD-216-4000-EG-CV-GAD-1102	LAYOUT & DETAIL OF MISCELLANEOUS ROOMS-1	C01	09/03/2021	ISSUED FOR CONSTRUCTION & REVISED AS MARKED /C01\	SR	SJM	BJB	AG	
MD-216-4000-EG-ST-GAD-2052 TO 2065 & 2072	WARE HOUSE & WORKSHOP STRUCTURAL DRAING	A01	27/01/2021	ISSUED FOR REVIEW	SR	SJM	BJB	AG	

RESERVED FOR VENDOR LOGO AND DRAWING NUMBER

LARSEN & TOUBRO

This drawing is the property of LARSEN & TOUBRO and must not be passed on to any person or body not authorized by us to receive it nor be copied or otherwise made use either in full or in part by such person or body without our prior permission in writing.

Outotec

The content of these documents are the sole property of Outotec Oyj. Any rights not expressly granted herein are reserved. Reproduction, transfer or distribution of part or all of the contents in any form without prior written permission of Outotec is prohibited.

MA'ADEN معادن
Saudi Arabian Mining Company شركة التعدين العربية السعودية

This document and the information contained herein is Ma'aden proprietary know-how. This document or any part thereof should not be reproduced, stored in a retrieval system or transmitted by any means, electronic or otherwise, or divulged without prior written permission of Ma'aden.

LARSEN & TOUBRO DRAWING NUMBER: O19045_501_C_G_24552_002 — REVISION: 3
OUTOTEC DRAWING NUMBER: 900707__GAU01__AN03__MTL01__40100 — DOCUMENT ID: OU100711130 — REVISION: 3

DRAWN	SR	22/01/2021
CHECKED	SJM	25/01/2021
ENGINEER	BJB	19/01/2021
APPROVED	AG	27/01/2021
EMPLOYER		
SCALE	1:100, 1:10, 1:75	A1

MANSOURAH - MASSARAH GOLD PROJECT
GENERAL ARRANGEMENT DRAWING
PROCESS PLANT- WAREHOUSE & WORKSHOP
LAYOUT & DETAIL OF MISCELLANEOUS ROOMS-2

DRAWING NUMBER: MD-216-4000-EG-CV-GAD-1103 — REV: D01