


DRAWING NUMBER: MD - 216 - 4000 - EG - CV - GAD - 1104
REV: D01

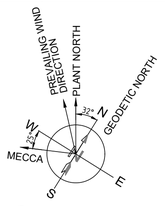


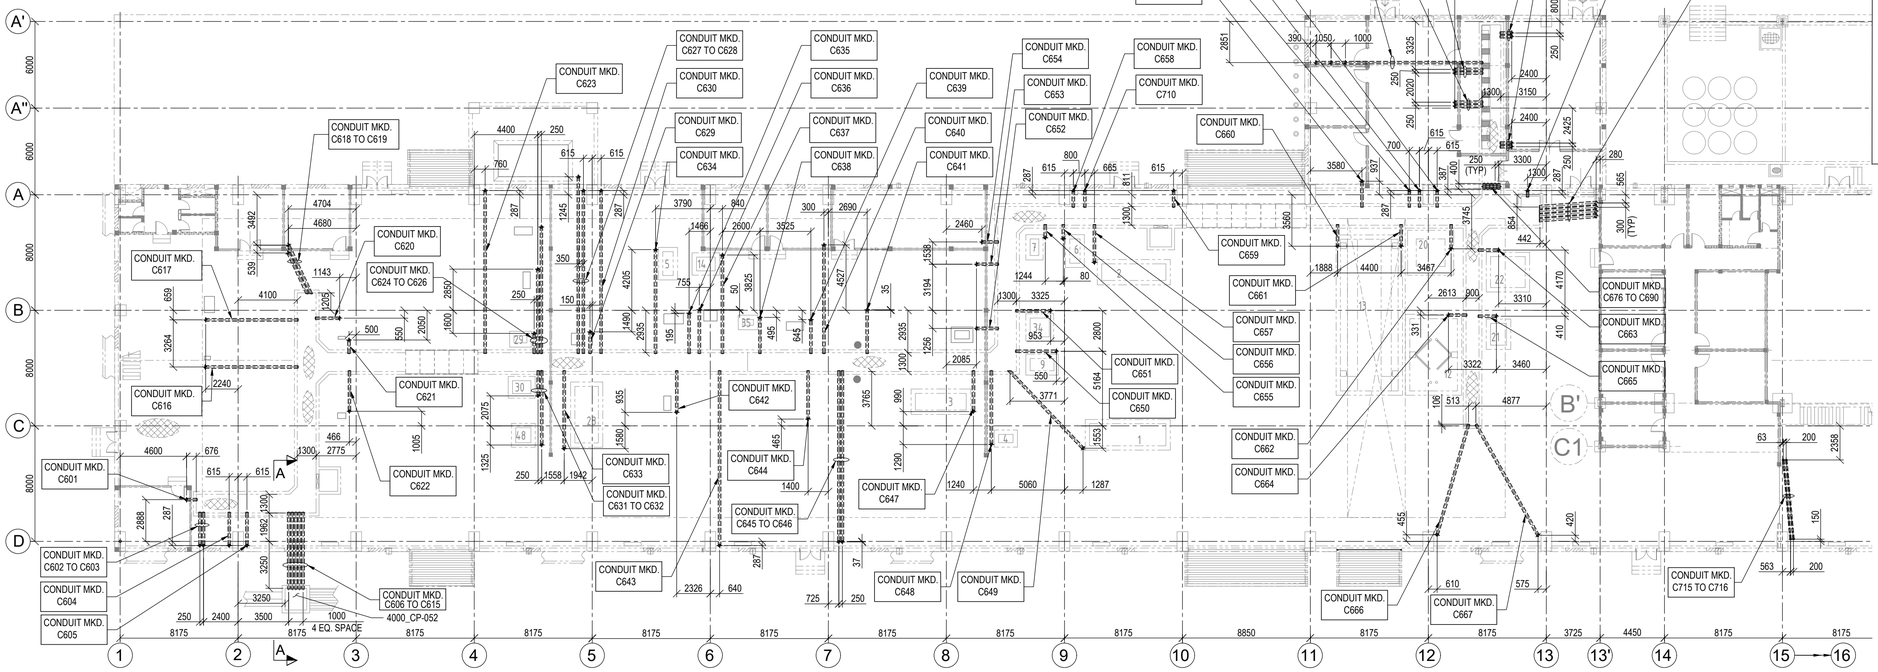

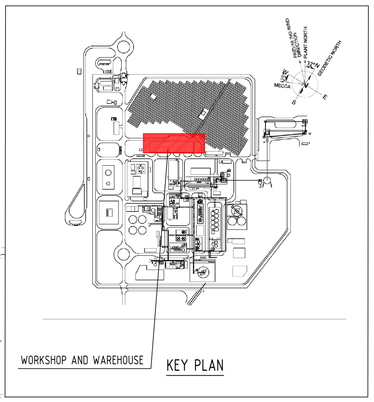


LAYOUT OF EMBEDDED ELECTRICAL CONDUITS

SCALE 1:200

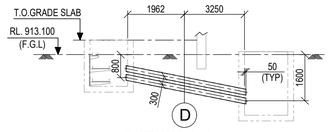

SECTION A-A

SCALE 1:100

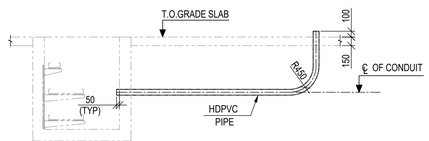

TYPICAL DETAIL OF CONDUIT

SCALE 1:50

SCHEDULE OF CONDUIT :-

CONDUIT MKD.	HDPVC PIPE DIA.	ELEVATION AT ℄ OF CONDUIT
C636	150Ø	RL 912.750
C637	150Ø	RL 912.750
C638	150Ø	RL 912.750
C639	150Ø	RL 912.750
C640	150Ø	RL 912.750
C641	150Ø	RL 912.750
C642	150Ø	RL 912.750
C643	150Ø	RL 912.750
C644	150Ø	RL 912.750
C645	150Ø	RL 912.750
C646	150Ø	RL 912.750
C647	150Ø	RL 912.750
C648	150Ø	RL 912.750
C649	150Ø	RL 912.750
C650	150Ø	RL 912.750
C651	150Ø	RL 912.750
C652	150Ø	RL 912.750
C653	150Ø	RL 912.750
C654	150Ø	RL 912.750
C655	150Ø	RL 912.750

SCHEDULE OF CONDUIT :-

CONDUIT MKD.	HDPVC PIPE DIA.	ELEVATION AT ℄ OF CONDUIT
C656	150Ø	RL 912.750
C657	150Ø	RL 912.750
C658	150Ø	RL 912.750
C659	150Ø	RL 912.750
C660	150Ø	RL 912.750
C661	150Ø	RL 912.750
C662	150Ø	RL 912.750
C663	150Ø	RL 912.750
C664	150Ø	RL 912.750
C665	150Ø	RL 912.750
C666	150Ø	RL 912.750
C667	150Ø	RL 912.750
C668	200Ø	RL 912.750
C669	200Ø	RL 912.750
C670	200Ø	RL 912.750
C671	200Ø	RL 912.750
C672	150Ø	RL 912.750
C673	150Ø	RL 912.750
C674	150Ø	RL 912.750
C675	150Ø	RL 912.750

SCHEDULE OF CONDUIT :-

CONDUIT MKD.	HDPVC PIPE DIA.	ELEVATION AT ℄ OF CONDUIT
C676	150Ø	RL 912.750
C677	150Ø	RL 912.750
C678	150Ø	RL 912.750
C679	150Ø	RL 912.750
C680	150Ø	RL 912.750
C681	150Ø	RL 912.500
C682	150Ø	RL 912.500
C683	150Ø	RL 912.500
C684	150Ø	RL 912.500
C685	150Ø	RL 912.500
C686	150Ø	RL 912.250
C687	150Ø	RL 912.250
C688	150Ø	RL 912.250
C689	150Ø	RL 912.250
C690	150Ø	RL 912.250
C691	150Ø	RL 912.750
C692	150Ø	RL 912.750
C693	150Ø	RL 912.750
C694	150Ø	RL 912.750
C695	150Ø	RL 912.750

SCHEDULE OF CONDUIT :-

CONDUIT MKD.	HDPVC PIPE DIA.	ELEVATION AT ℄ OF CONDUIT
C696	150Ø	RL 912.750
C697	150Ø	RL 912.750
C698	150Ø	RL 912.750
C710	150Ø	RL 912.750
C711	150Ø	RL 912.750
C712	150Ø	RL 913.100
C713	150Ø	RL 912.850
C714	150Ø	RL 912.600
C715	100Ø	RL 912.750
C716	100Ø	RL 912.750

SCHEDULE OF CONDUIT :-

CONDUIT MKD.	HDPVC PIPE DIA.	ELEVATION AT ℄ OF CONDUIT
C601	150Ø	RL 912.750
C602	150Ø	RL 912.750
C603	150Ø	RL 912.750
C604	150Ø	RL 912.750
C605	150Ø	RL 912.750
C606	200Ø	RL 912.300, RL 911.500
C607	200Ø	RL 912.300, RL 911.500
C608	200Ø	RL 912.300, RL 911.500
C609	200Ø	RL 912.300, RL 911.500
C610	200Ø	RL 912.300, RL 911.500
C611	200Ø	RL 912.600, RL 911.800
C612	200Ø	RL 912.600, RL 911.800
C613	200Ø	RL 912.600, RL 911.800
C614	200Ø	RL 912.600, RL 911.800
C615	200Ø	RL 912.600, RL 911.800
C616	150Ø	RL 912.750
C617	150Ø	RL 912.750
C618	150Ø	RL 912.750
C619	150Ø	RL 912.750
C620	150Ø	RL 912.750
C621	150Ø	RL 912.750
C622	150Ø	RL 912.750
C623	150Ø	RL 912.750
C624	150Ø	RL 912.750
C625	150Ø	RL 912.750
C626	150Ø	RL 912.750
C627	150Ø	RL 912.750
C628	150Ø	RL 912.750
C629	150Ø	RL 912.750
C630	150Ø	RL 912.750
C631	150Ø	RL 912.750
C632	150Ø	RL 912.750
C633	150Ø	RL 912.750
C634	150Ø	RL 912.750
C635	150Ø	RL 912.750

LEGEND :-

R.L. - REDUCED LEVEL
I.L - INVERT LEVEL
THK. - THICK
TYP. - TYPICAL.
T.O.C - TOP OF CONCRETE
℄ - CENTRE LINE
P.C.C - PLAIN CEMENT CONCRETE
Ø - DIAMETER
R - RADIUS
MKD. - MARKED
EQ. - EQUAL
F.G.L - FINISHED GROUND LEVEL
DIA - DIAMETER
T.O.GRADE SLAB - TOP OF GRADE SLAB

NOTES:-

1. ALL DIMENSIONS ARE IN MILLIMETRES AND LEVELS AND CO-ORDINATES ARE IN METRES UNLESS OTHERWISE STATED.
2. THIS DRAWING IS TO BE READ IN CONJUNCTION WITH DRAWING NO- MD-216-4000-EG-CV-DED-1061.

DOCUMENT NUMBER	REFERENCE DOCUMENTS	REV	DATE	REVISION DESCRIPTION	DRN	CHK	ENG	APP	EMP
MD-216-4000-EG-CV-DED-1061	PROCESS PLANT- WAREHOUSE & WORKSHOP								
	GROUND FLOOR PLAN & DETAILS	D01	22/02/2023	AS-BUILT	PML	SJM	SOR	AG	
MD-216-4000-EG-EL-LAD-1041	CABLE ROUTE LAYOUT - WORKSHOP	C01	27/04/2021	ISSUED FOR CONSTRUCTION & REVISED AS PER EMPLOYER					
MD-216-4000-EG-EL-LAD-1040	CABLE ROUTE LAYOUT - WORKSHOP			COMMENTS ON 24/04/2021.	PML	SJM	SOR	AG	
MD-216-4000-EG-EL-LAD-1039	CABLE ROUTE LAYOUT - WORKSHOP	A01	22/03/2021	ISSUED FOR REVIEW	PML	SJM	SOR	AG	

RESERVED FOR VENDOR LOGO AND DRAWING NUMBER

LARSEN & TOUBRO
This drawing is the property of LARSEN & TOUBRO and must not be passed on to any person or body not authorized by us to receive it nor be copied or otherwise made use either in full or in part by such person or body without our prior permission in writing.

Outotec
The content of these documents are the sole property of Outotec Oyj. Any rights not expressly granted herein are reserved. Reproduction, transfer or distribution of part or all of the contents in any form without prior written permission of Outotec is prohibited.

MA'ADEN معادن
Saudi Arabian Mining Company شركة معادن العربية السعودية
This document and the information contained herein is Ma'aden proprietary know-how. This document or any part thereof should not be reproduced, stored in a retrieval system or transmitted by any means, electronic or otherwise, or divulged without prior written permission of Ma'aden.

LARSEN & TOUBRO DRAWING NUMBER	019045_501_C_G_24552_003		REVISION 2
OUTOTEC DRAWING NUMBER	900707__GAU01__AN03__MTL01__40101	DOCUMENT ID 0U100711131	REVISION 2
DRAWN	PML	19/03/2021	MANSOURAH - MASSARAH GOLD PROJECT
CHECKED	SJM	20/03/2021	GENERAL ARRANGEMENT DRAWING
ENGINEER	SOR	19/03/2021	PROCESS PLANT- WAREHOUSE & WORKSHOP
APPROVED	AG	22/03/2021	LAYOUT & DETAIL OF EMBEDDED CONDUITS
EMPLOYER			
SCALE	1:300,25	A1	DRAWING NUMBER MD - 216 - 4000 - EG - CV - GAD - 1104 REV D01