


DRAWING NUMBER MD-216-4000-EG-CV-GAD-1110 REV D01

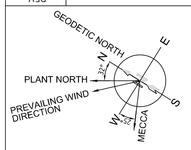


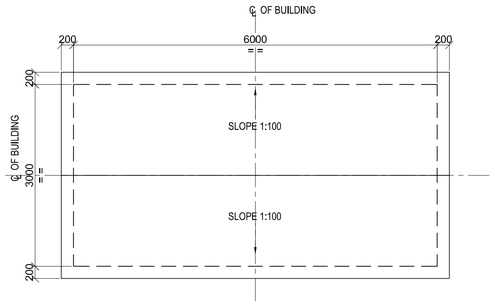


PLAN AT ROOF LEVEL
SCALE 1:50

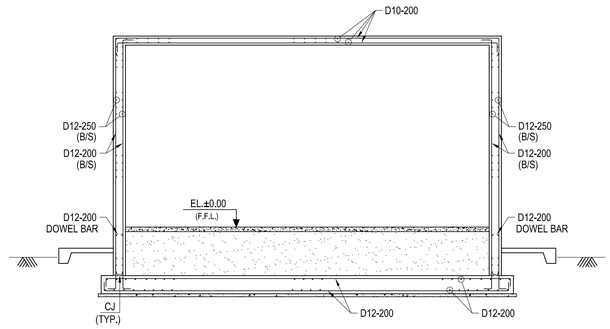


SECTION : 1-1
R.C. DETAIL
SCALE 1:50

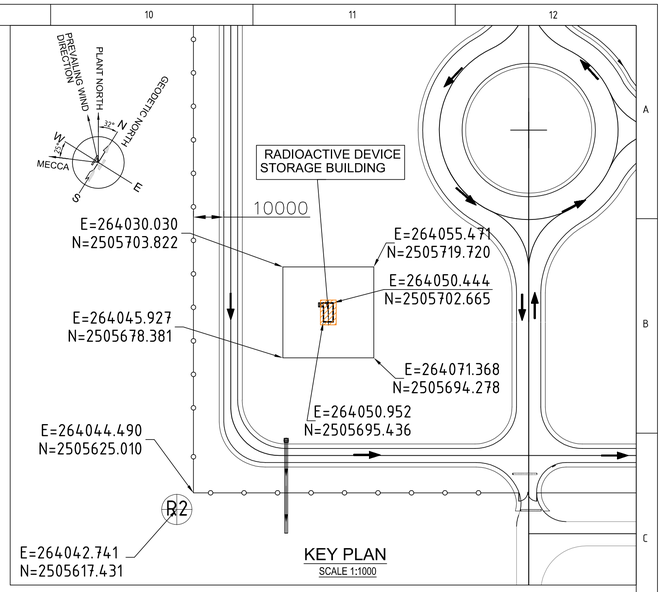


KEY PLAN
SCALE 1:1000

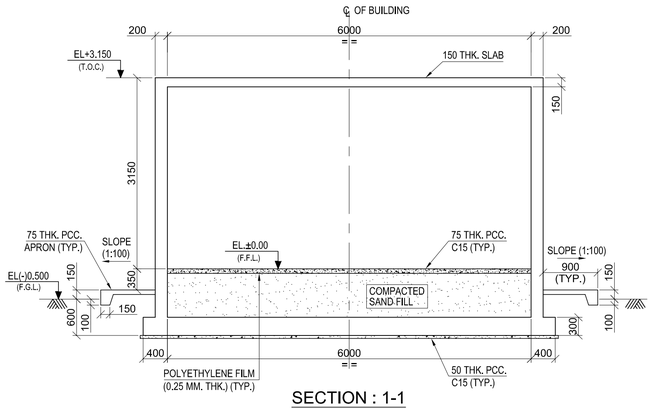


SECTION : 1-1
SCALE 1:50

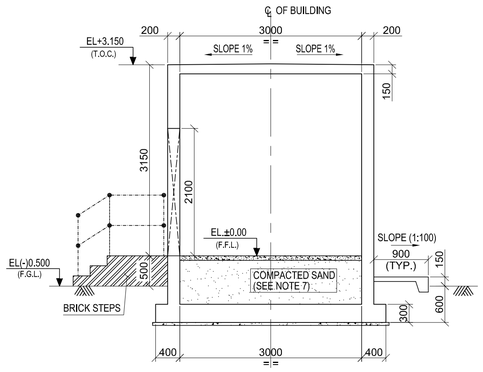


SECTION : 2-2
SCALE 1:50

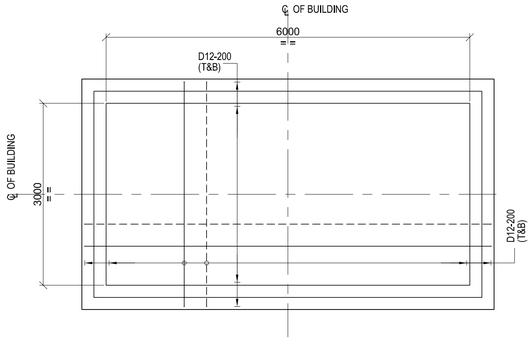

R.C. DETAIL OF FOUNDATION
SCALE 1:50

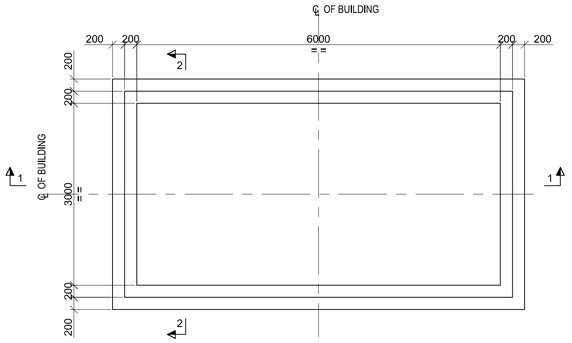

FOUNDATION PLAN
SCALE 1:50

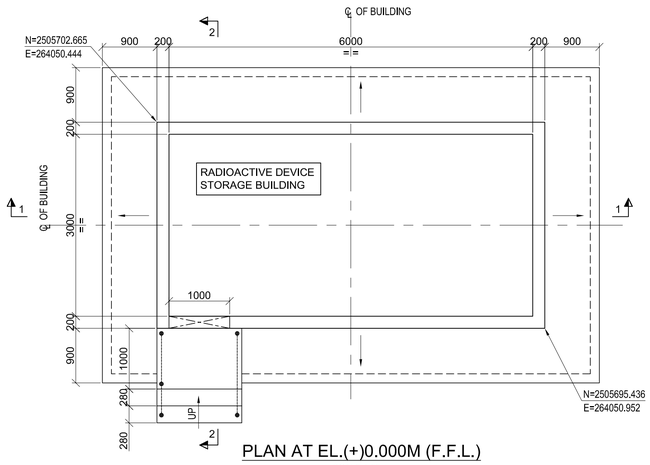

PLAN AT EL.(+)0.000M (F.F.L.)
SCALE 1:50

LEGEND :-

℄ - CENTRE LINE
F.G.L - FINISHED GROUND LEVEL
T.O.C. - TOP OF CONCRETE
B.O.F. - BOTTOM OF FOUNDATION
R.C. - REINFORCED CONCRETE
P.C.C - PLAIN CEMENT CONCRETE
EL. - ELEVATION
R.L. - PLAIN CEMENT CONCRETE
F.F.L - FINISHED FLOOR LEVEL
THK. - THICKNESS
CJ - CONSTRUCTION JOINT

NOTES:-

1. ALL DIMENSIONS ARE IN MILLIMETRES AND LEVELS AND CO-ORDINATES ARE IN METRES UNLESS OTHERWISE STATED.
2. EL(-)0.500 F.G.L. CORRESPONDS TO R.L. 912.600 M.
3. GRADE OF CONCRETE SHALL BE C30 (30MPa) FOR GRADE SLAB & C15 (15MPa) FOR BLINDING CONCRETE.
4. GRADE OF REINFORCEMENT SHALL BE DEFORMED BAR 420 MPa (GRADE 60) - ASTM A615/A615M.
5. CLEAR COVER TO REINFORCEMENT SHALL BE WALL - 40MM., SLAB - 25 MM., RAFT - 50MM.
6. FOR ELECTRICAL CONDUITS REFER RELEVANT ELECTRICAL DRAWING.
7. SAND SHALL BE COMPACTED TO A MAXIMUM DEPTH OF 300MM AND SHALL BE COMPACTED TO 80% RELATIVE DENSITY AS DETERMINED BY ASTM D4253 AND ASTM D4254.
8. FOR STANDARD REINFORCEMENT DETAIL & GENERAL NOTES FOR CIVIL WORKS REFER DRAWING NO. MD-216-1000-EG-CV-DED-1005 & 1001.
9. NET SAFE BEARING CAPACITY OF SOIL AT BOTTOM OF FOUNDATION IS CONSIDERED AS 200KN/ SQ. M.

DOCUMENT NUMBER	REFERENCE DOCUMENTS	REV	DATE	REVISION DESCRIPTION	DRN	CHK	ENG	APP	EMP
		D01	26/05/2023	AS-BUILT	ABS	SJM	AVG	AG	
		C01	03/03/2022	ISSUED FOR CONSTRUCTION & REVISED AS MKD. /C01\	ABS	SJM	AVG	AG	
MD-216-1000-EG-ME-PPD-1002	PROCESS PLANT LAYOUT	A02	20/01/2022	REVISED AS PER EMPLOYER COMMENTS ON 13/01/2022	ABS	SJM	AVG	AG	
MD-216-1000-EG-ST-CRT-1001	CIVIL, STRUCTURAL & ARCHITECTURAL - DESIGN CRITERIA			AND REVISED AS MKD. /A02\					
MD-216-4000-EG-AR-GAD-3060	RADIOACTIVE DEVICE STORAGE BUILDING	A01	24/12/2021	ISSUED FOR APPROVAL	ABS	SJM	AVG	AG	

RESERVED FOR VENDOR LOGO AND DRAWING NUMBER

LARSEN & TOUBRO

This drawing is the property of *LARSEN & TOUBRO* and must not be passed on to any person or body not authorized by us to receive it nor be copied or otherwise made use either in full or in part by such person or body without our prior permission in writing.

Outotec

The content of these documents are the sole property of Outotec Oyj. Any rights not expressly granted herein are reserved. Reproduction, transfer or distribution of part or all of the contents in any form without prior written permission of Outotec is prohibited.

MA'ADEN معادن
Saudi Arabian Mining Company شركة التعدين العربية السعودية

This document and the information contained herein is Ma'aden proprietary know-how. This document or any part thereof should not be reproduced, stored in a retrieval system or transmitted by any means, electronic or otherwise, or divulged without prior written permission of Ma'aden.

LARSEN & TOUBRO DRAWING NUMBER	019045_900_C_G_24765_001		REVISION 3
OUTOTEC DRAWING NUMBER	900707__GAU01__AN03__MTL01__40108	DOCUMENT ID OU100739533	REVISION 3

DRAWN	ABS	16/12/2021
CHECKED	SJM	17/12/2021
ENGINEER	AVG	16/12/2021
APPROVED	AG	24/12/2021
EMPLOYER		
SCALE	1:1000, 1:50	A1

MANSOURAH - MASSARAH GOLD PROJECT
GENERAL ARRANGEMENT DRAWING
RADIOACTIVE DEVICE STORAGE BUILDING
GA & DETAILS

DRAWING NUMBER MD-216-4000-EG-CV-GAD-1110 REV D01