

DRAWING NUMBER: MD - 216 - 3220 - EG - CV - DED - 1151 | REV: D01

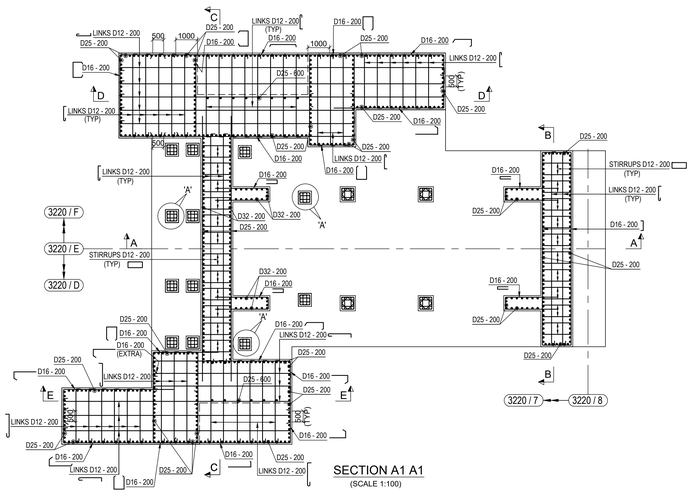


SECTION A1 A1
(SCALE 1:100)

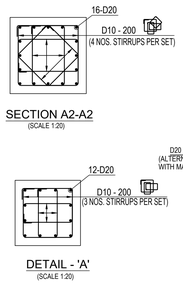


SECTION A2-A2
(SCALE 1:20)


DETAIL - 'A'
(SCALE 1:20)

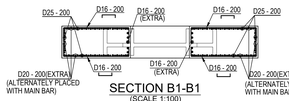


SECTION B1-B1
(SCALE 1:100)

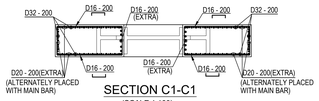


SECTION C1-C1
(SCALE 1:100)

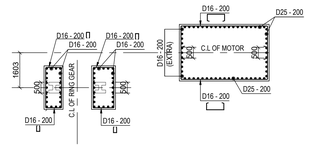


SECTION D1-D1
(SCALE 1:100)

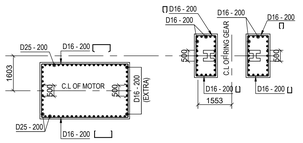


SECTION E1-E1
(SCALE 1:100)

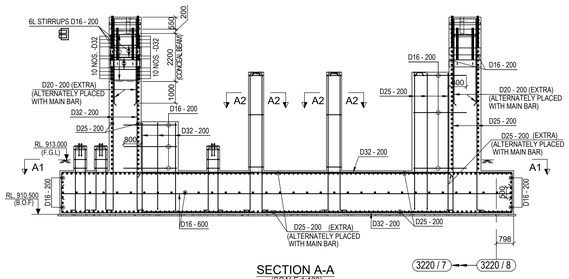


SECTION A-A
(SCALE 1:100)

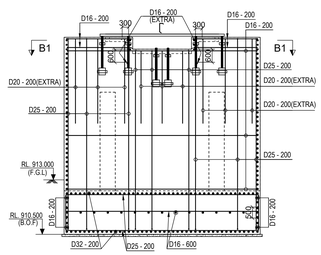


SECTION B-B
(SCALE 1:100)

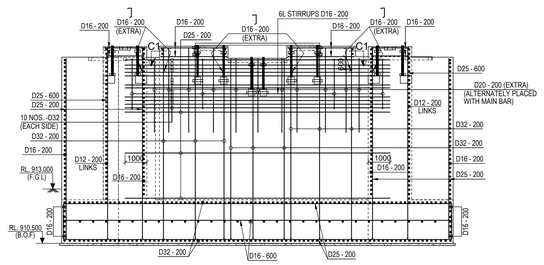


SECTION C-C
(SCALE 1:100)

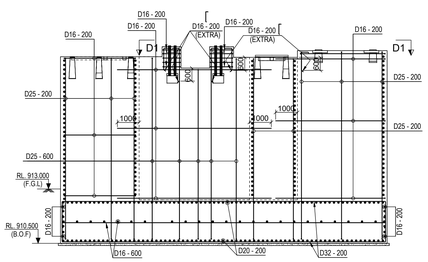


SECTION D-D
(SCALE 1:100)

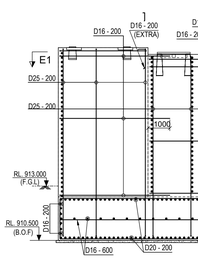


SECTION E-E
(SCALE 1:100)

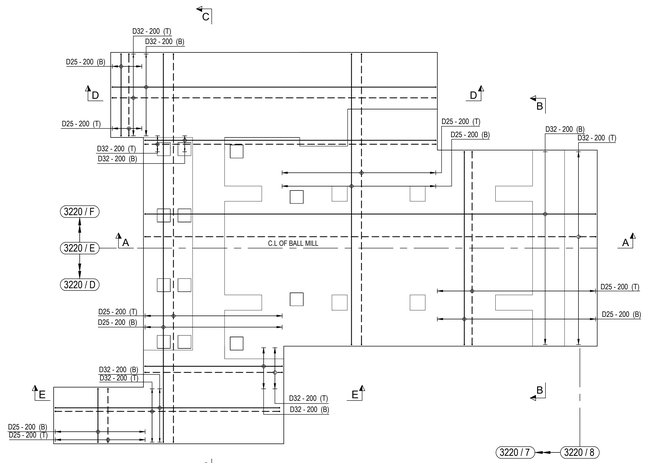


BALL MILL FOUNDATION PLAN
(SHOWING RAFT MAIN BARS)
(SCALE 1:100)

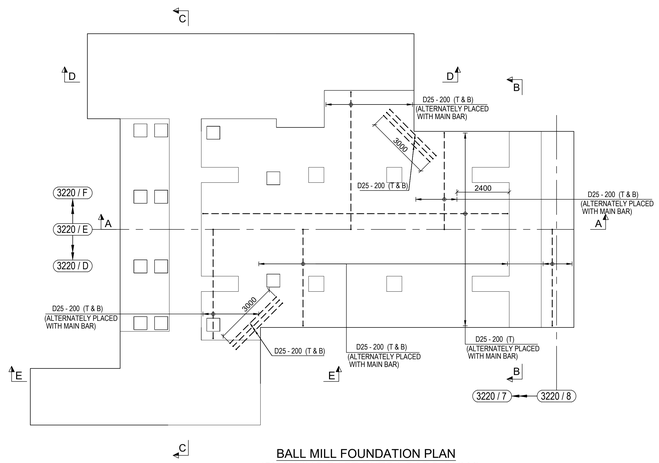

BALL MILL FOUNDATION PLAN
(SHOWING RAFT EXTRA BARS ONLY)
(SCALE 1:100)

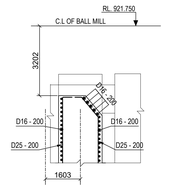

SECTION F-F
(FOR SECTION MARK REFER GA. DRAWING)
(SCALE 1:100)

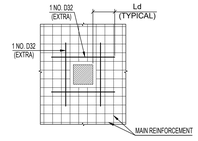

TYPICAL REINFORCEMENT
DETAIL AROUND RECESS BOXES
(SCALE 1:50)

LEGEND.:-

T.O.C - TOP OF CONCRETE
B.O.F - BOTTOM OF FOUNDATION
F.G.L - FINISHED GROUND LEVEL

NOTES:-

1. ALL DIMENSIONS ARE IN MILLIMETERS AND LEVELS ARE IN METERS UNLESS OTHERWISE STATED.
2. GRADE OF CONCRETE SHALL BE C35
3. GRADE OF REINFORCEMENT SHALL BE DEFORMED BAR ASTM A615-GRADE 60 (fy=420 MPa)
4. CLEAR COVER TO MAIN REINFORCEMENT SHALL BE AS FOLLOWS:
   a) RAFT - 75 mm. (BOTTOM & SIDE)
   b) RAFT - 50 mm. (TOP)
   c) WALL - 50 mm.
   d) PEDESTAL & COLUMN - 50 mm.
5. MINIMUM LAP LENGTHS OF REINFORCEMENT SHALL BE 40XBAR DIAMETER.
6. REINFORCEMENT MAY BE SLIGHTLY ADJUSTED AT SITE TO ACCOMMODATES EMBEDDED PARTS .
7. REQUIRED LAP SPLICE LENGTH OF DEFORMED BARS :
   A. FOR BEAM & SLAB - BOTTOM REINFORCEMENT ONLY
      (I). ALL DIA. OF BAR - 40 X NOMINAL DIA. OF BAR
   B. FOR BEAM & SLAB - TOP REINFORCEMENT & FOR OTHER PARTS OF THE STRUCTURE.
      (I). 20 DIA. & SMALLER SIZE OF BARS - 40 X NOMINAL DIA. OF BAR
      (II). 22 DIA. & GREATER SIZE OF BARS - 55 X NOMINAL DIA. OF BAR
8. FOR GENERAL NOTES OF CIVIL WORKS REF. DRG. NO. MD - 216 - 1000 - EG - CV - DED - 1001.
9. FOR STANDARD REINFORCEMENT DETAILS REF. DRG. NO. MD-216-1000-EG-CV-DED-1005.

DOCUMENT NUMBER	REFERENCE DOCUMENTS	REV	DATE	REVISION DESCRIPTION	DRN	CHK	ENG	APP	EMP
MD-216-3220-EG-ME-GAD-1001	GRINDING AND CLASSIFICATION - BALL MILL								
MD-216-3220-EG-ME-GAD-1002	3220-MILL-001, BALL MILL FOUNDATION LOADS	A02	17/01/2020	DRAWING REVISED BASED ON LATEST DESIGN CALCULATION AS PER EMPLOYER'S COMMENTS AND REVISED AS MARKED - A02	APM	BDA	SUE	AG	
MD-216-3220-EG-ME-GAD-1013	3220-MILL-001, BALL MILL FOUNDATION SIDE VIEW								
MD-216-3220-EG-ME-GAD-1003	3220-MILL-001, BALL MILL FOUNDATION PLAN VIEW	A01	07/12/2019	ISSUED FOR REFERENCE	APM	BDA	SUE	AG	
		D01	16/02/2023	AS-BUILT	APM	BDA	SUE	AG	
		C02	20/03/2020	ISSUED FOR CONSTRUCTION	APM	BDA	SUE	AG	
		C01	24/02/2020	ISSUED FOR CONSTRUCTION	APM	BDA	SUE	AG	
		A03	17/02/2020	DRAWING REVISED BASED ON LATEST DESIGN CALCULATION AS PER EMPLOYER'S COMMENTS AND REVISED AS MARKED - A03	SBH	BDA	SUE	AG	

RESERVED FOR VENDOR LOGO AND DRAWING NUMBER

LARSEN & TOUBRO DRAWING NUMBER: 019045_450_C_D_24078_001 | REVISION: 5
OUTOTEC DRAWING NUMBER: 900707__GAU01__ZG01__CTB17__32201 | DOCUMENT ID: OU100665553 | REVISION: 5

DRAWN	APM	05/12/2019	MANSOURAH - MASSARAH GOLD PROJECT
CHECKED	BDA	07/12/2019	DETAIL DRAWING
ENGINEER	SUE	05/12/2019	GRINDING AND CLASSIFICATION- BALL MILL
APPROVED	AG	07/12/2019	RC DETAIL OF BALL MILL FOUNDATION
EMPLOYER			
SCALE	1:100	A0	DRAWING NUMBER: MD - 216 - 3220 - EG - CV - DED - 1151	REV: D01

LARSEN & TOUBRO
This drawing is the property of LARSEN & TOUBRO and must not be passed on to any person or body not authorized by us to receive it nor be copied or otherwise made use either in full or in part by such person or body without our prior permission in writing.

Outotec
The content of these documents are the sole property of Outotec Oy. Any rights not expressly granted herein are reserved. Reproduction, transfer or distribution of part or all of the contents in any form without prior written permission of Outotec is prohibited.

MA'ADEN معادن
Saudi Arabian Mining Company شركة المعادن العربية السعودية
This document and the information contained herein is Ma'aden proprietary know-how. This document or any part thereof should not be reproduced, stored in a retrieval system or transmitted by any means, electronic or otherwise, or divulged without prior written permission of Ma'aden.