


DRAWING NUMBER MD-216-3220-EG-CV-DED-1152 REV D01

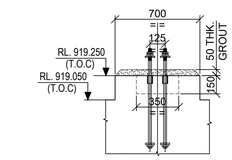


SECTION 5-5
(SCALE-1:25)

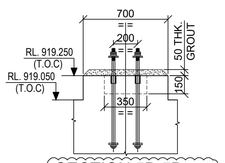


SECTION 5B-5B C03
(SCALE-1:25)

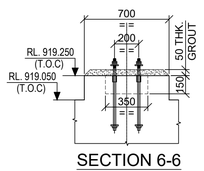


SECTION 6-6
(SCALE-1:25)

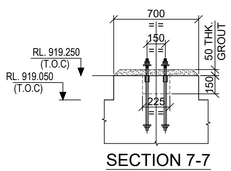


SECTION 7-7
(SCALE-1:25)

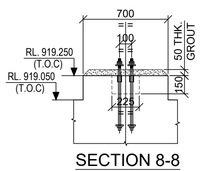


SECTION 8-8
(SCALE-1:25)

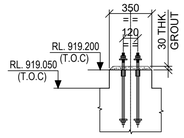


SECTION 9-9
(SCALE-1:25)

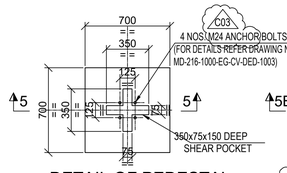


DETAIL OF PEDESTAL FOR PEDESTAL MKD. - P1
(SCALE-1:25)

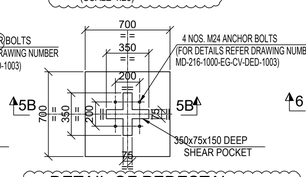


DETAIL OF PEDESTAL FOR PEDESTAL MKD. - P1A C03
(SCALE-1:25)

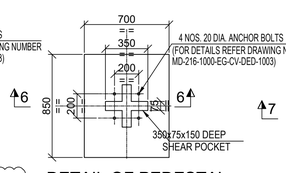


DETAIL OF PEDESTAL FOR PEDESTAL MKD. - P2
(SCALE-1:25)

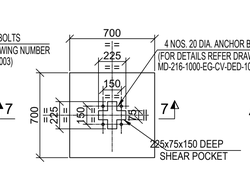


DETAIL OF PEDESTAL FOR PEDESTAL MKD. - P3
(SCALE-1:25)

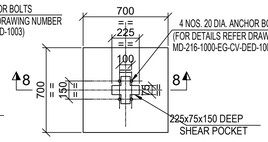


DETAIL OF PEDESTAL FOR PEDESTAL MKD. - P4
(SCALE-1:25)

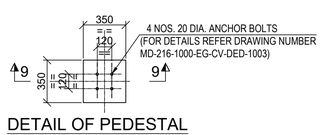


DETAIL OF PEDESTAL FOR PEDESTAL MKD. - P5
(SCALE-1:25)

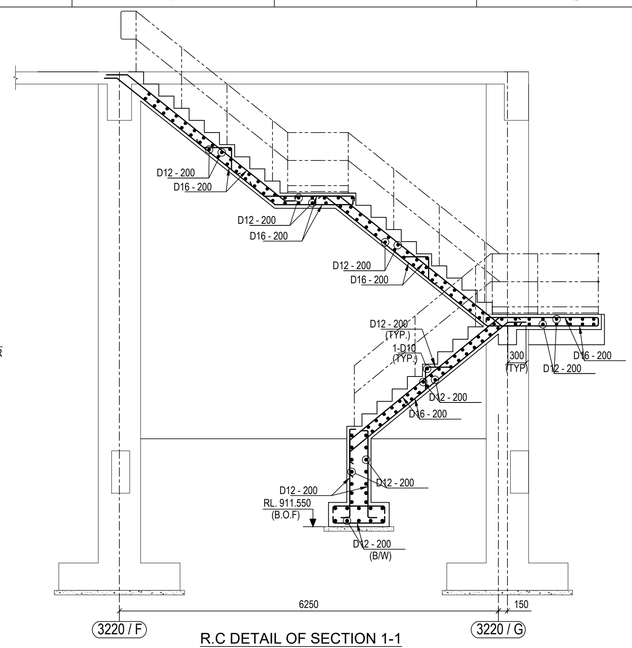


R.C DETAIL OF SECTION 1-1
(FOR SECTION MARK REFER DRAWING NO. MD-216-3220-EG-CV-GAD-1146)
(SCALE 1:50)

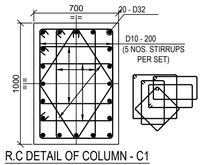


R.C DETAIL OF COLUMN - C1
(SCALE 1:20)

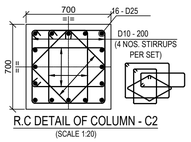


R.C DETAIL OF COLUMN - C2
(SCALE 1:20)

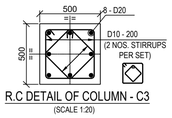

R.C DETAIL OF COLUMN - C3
(SCALE 1:20)

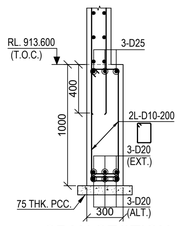


SPAN SECTION

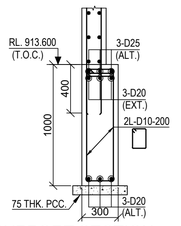


SUPPORT SECTION


TYP. CROSS SECTION OF TIE BEAM MKD. TB1
(SCALE- 1:25)

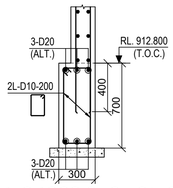


TYP. CROSS SECTION OF BEAM MKD. TB2
(SCALE- 1:25)

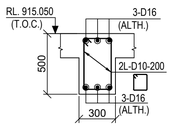


R.C DETAIL OF BEAM - B1
(SCALE- 1:25)

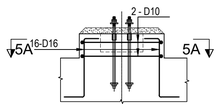


R.C DETAIL OF SECTION 5-5
(SCALE-1:25)

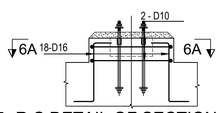


R.C DETAIL OF SECTION 6-6
(SCALE-1:25)

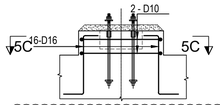


R.C DETAIL OF SECTION 5B-5B
(SCALE-1:25) C03

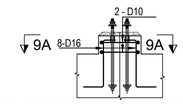


R.C DETAIL OF SECTION 9-9
(SCALE-1:25)

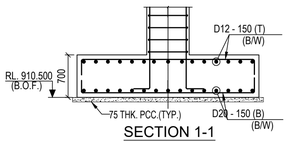


SECTION 1-1
(SCALE-1:50)

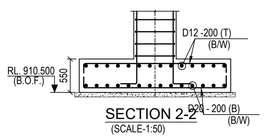


SECTION 2-2
(SCALE-1:50)

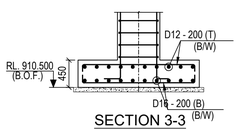


SECTION 3-3
(SCALE-1:50)

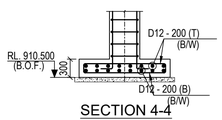


SECTION 4-4
(SCALE-1:50)

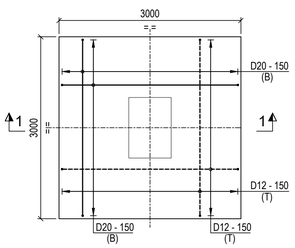


R.C DETAIL OF FOUNDATION - F1
(SCALE 1:50)

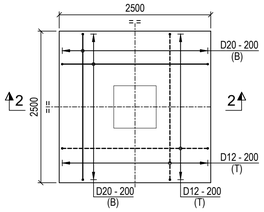


R.C DETAIL OF FOUNDATION - F2
(SCALE 1:50)

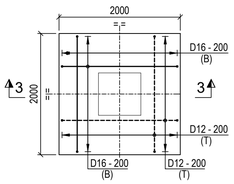


R.C DETAIL OF FOUNDATION - F3
(SCALE 1:50)

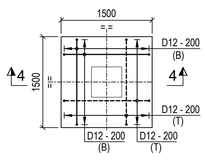


R.C DETAIL OF FOUNDATION - F4
(SCALE 1:50)

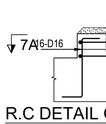


R.C DETAIL OF SECTION 7-7
(SCALE-1:25)

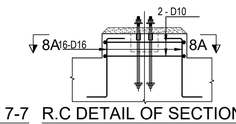


R.C DETAIL OF SECTION 8-8
(SCALE-1:25)

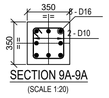


SECTION 9A-9A
(SCALE 1:20)

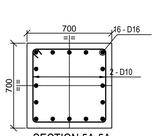


SECTION 5A-5A
(SCALE 1:20)

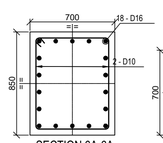


SECTION 6A-6A
(SCALE 1:20)

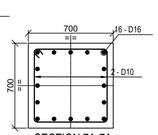


SECTION 7A-7A
(SCALE 1:20)

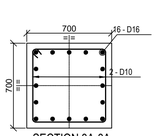


SECTION 8A-8A
(SCALE 1:20)

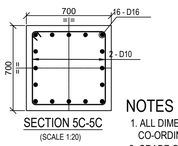

SECTION 5C-5C
(SCALE 1:20)

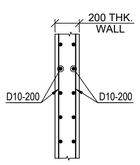

TYPICAL R.C DETAIL OF 200 THK. WALL
(SCALE- 1:25)

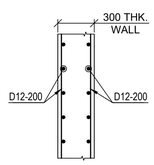

TYPICAL R.C DETAIL OF 300 THK. WALL
(SCALE- 1:25)

LEGEND :-

R.L. - REDUCED LEVEL
T.O.C. - TOP OF CONCRETE.
F.G.L. - FINISHED GROUND LEVEL.
F.F.L. - FINISHED FLOOR LEVEL.
B.O.F. - BOTTOM OF FOUNDATION
TYP. - TYPICAL.
R.C. - REINFORCED CONCRETE
P.C.C - PLAIN CEMENT CONCRETE
MKD. - MARKED.
THK. - THICK
DIA. - DIAMETER
B/W - BOTH WAYS
DRG. - DRAWING
BOTTOM REINFORCEMENT (B) -
TOP REINFORCEMENT (T) -

NOTES :-

1. ALL DIMENSIONS ARE IN MILLIMETRES AND LEVELS AND CO-ORDINATES ARE IN METRES. UNLESS OTHERWISE STATED.
2. GRADE OF CONCRETE SHALL BE C35 FOR FOUNDATION.
3. GRADE OF REINFORCEMENT SHALL BE DEFORMED BAR ASTM A615 - GRADE 60 (fy = 420 MPa).
4. NET SAFE BEARING CAPACITY OF SOIL AT BOTTOM OF FOUNDATION CONSIDERED 600KN/SQ. M.
5. CLEAR COVER TO MAIN REINFORCEMENT SHALL BE AS
   a) FOUNDATION = 75 mm (BOTTOM & SIDE) 50 mm. (TOP)
   b) COLUMN & PEDESTAL = 50mm
   c) BEAM = 50mm
   d) SLAB = 40mm
6. FOR LAP LENGTHS REFER DWG. NO. MD-216-1000-EG-CV-DED-1001.
7. FOR DETAIL OF HANDRAIL FIXING REFER STANDARD DRAWING.
8. READ THIS DRAWING IN CONJUNCTION WITH DRG: MD-216-3220-EG-CV-GAD-1146, MD-216-3220-EG-CV-GAD-1148, MD-216-3220-EG-CV-GAD-1149, MD-216-3220-EG-CV-GAD-1154 & MD-216-3220-EG-CV-GAD-1155.

DOCUMENT NUMBER	REFERENCE DOCUMENTS	REV	DATE	REVISION DESCRIPTION	DRN	CHK	ENG	APP	EMP
		D01	16/02/2023	AS-BUILT	APM	BDA	STY	AG	
MD-216-3220-EG-ST-GAD-2142	CONVEYOR & CYCLONE SUPP. STR. PLAN & ELEVATION	C03	04/01/2021	ISSUED FOR CONSTRUCTION & REVISED AS MARKED	APM	BDA	STY	AG	
MD-216-3220-EG-CV-GAD-1005	CIVIL WORK - GUIDE DRAWING	C02	11/11/2020	ISSUED FOR CONSTRUCTION & REVISED AS MARKED	APM	BDA	STY	AG	
MD-216-3220-EG-CV-GAD-1004	CIVIL WORK - GUIDE DRAWING	C01	09/04/2020	ISSUED FOR CONSTRUCTION	APM	BDA	STY	AG	
MD-216-3220-EG-CV-GAD-1003	CIVIL WORK - GUIDE DRAWING	A01	28/02/2020	ISSUED FOR REFERENCE	APM	BDA	STY	AG	

RESERVED FOR VENDOR LOGO AND DRAWING NUMBER

LARSEN & TOUBRO DRAWING NUMBER: 019045_450_C_D_24078__002 — REVISION: 4
OUTOTEC DRAWING NUMBER: 900707__GAU01__ZG01__CTB17__32202 — DOCUMENT ID: OU100671077 — REVISION: 4

LARSEN & TOUBRO
This drawing is the property of LARSEN & TOUBRO and must not be passed on to any person or body not authorized by us to receive it nor be copied or otherwise made use either in full or in part by such person or body without our prior permission in writing.

Outotec
The content of these documents are the sole property of Outotec Oyj. Any rights not expressly granted herein are reserved. Reproduction, transfer or distribution of part or all of the contents in any form without prior written permission of Outotec is prohibited.

MA'ADEN معادن
Saudi Arabian Mining Company شركة التعدين العربية السعودية
This document and the information contained herein is Ma'aden proprietary know-how. This document or any part thereof should not be reproduced, stored in a retrieval system or transmitted by any means, electronic or otherwise, or divulged without prior written permission of Ma'aden.

DRAWN	APM	26/02/2020	MANSOURAH - MASSARAH GOLD PROJECT
CHECKED	BDA	27/02/2020	DETAIL DRAWING
ENGINEER	STY	25/02/2020	GRINDING AND CLASSIFICATION-BALL MILL
APPROVED	AG	28/02/2020	RC DETAIL OF FOUNDAIONS AND TIE BEAMS
EMPLOYER			
SCALE	1:100, 1:50	A1	DRAWING NUMBER: MD-216-3220-EG-CV-DED-1152 — REV: D01