

DRAWING NUMBER MD-216-3220-EG-CV-DED-1157 REV D01

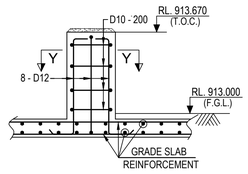


DETAIL OF PEDESTAL MKD. P110
(REF. DWG. NO. : MD-216-3220-EG-CV-GAD-1153)
(SCALE 1:25)

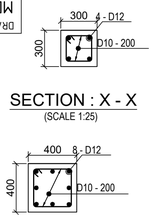


SECTION : X - X
(SCALE 1:25)

SECTION : Y - Y
(SCALE 1:25)

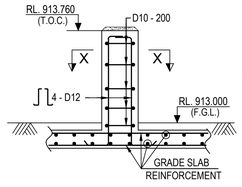


DETAIL OF PEDESTAL MKD. P109
(REF. DWG. NO. : MD-216-3220-EG-CV-GAD-1153)
(SCALE 1:25)

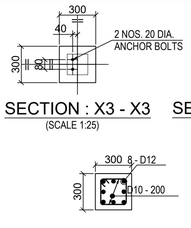


SECTION : X3 - X3
(SCALE 1:25)

SECTION : X2 - X2
(SCALE 1:25)

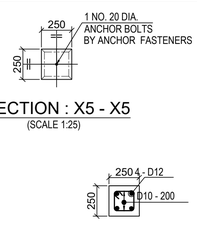


SECTION : X5 - X5
(SCALE 1:25)


SECTION : X4 - X4
(SCALE 1:25)

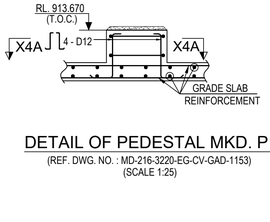


DETAIL OF PEDESTAL MKD. P112
(REF. DWG. NO. : MD-216-3220-EG-CV-GAD-1153)
(SCALE 1:25)

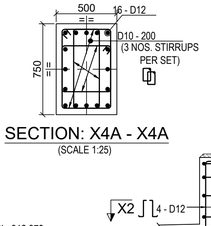


SECTION: X4A - X4A
(SCALE 1:25)

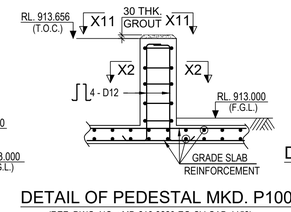


DETAIL OF PEDESTAL MKD. P1005
(REF. DWG. NO. : MD-216-3220-EG-CV-GAD-1153)
(SCALE 1:25)

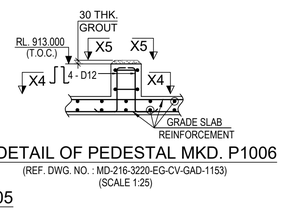


DETAIL OF PEDESTAL MKD. P1006
(REF. DWG. NO. : MD-216-3220-EG-CV-GAD-1153)
(SCALE 1:25)

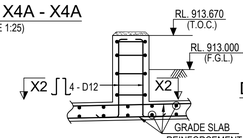


DETAIL OF PEDESTAL MKD. P1113
(REF. DWG. NO. : MD-216-3220-EG-CV-GAD-1153)
(SCALE 1:25)

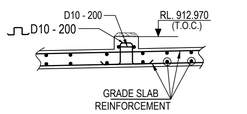


DETAIL OF PEDESTAL MKD. P111
(REF. DWG. NO. : MD-216-3220-EG-CV-GAD-1153)
(SCALE 1:25)

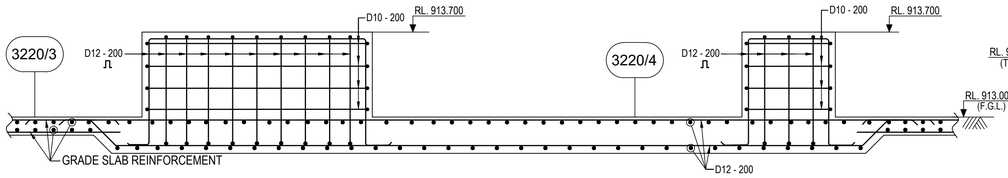


DETAIL OF PEDESTAL MKD. P-9.1, P-9.2, P-9.3 & P-9.4
(REF. DWG. NO. : MD-216-3220-EG-CV-GAD-1151)
(SCALE 1:25)

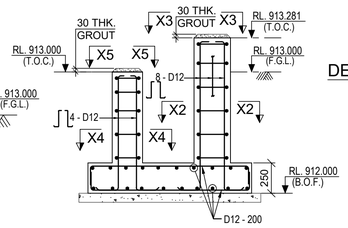


SECTION X1-X1
(SCALE-1:25)

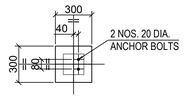


SECTION : X7 - X7
(SCALE 1:25)

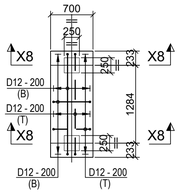


R.C. DETAIL OF FOUNDATION - F4
(REF. DRG. NO : MD-216-3220-EG-CV-GAD-1150)
(SCALE 1:50)

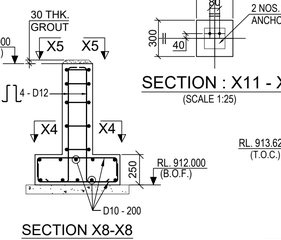


DETAIL OF PEDESTAL MKD. P1004
(REF. DWG. NO. : MD-216-3220-EG-CV-GAD-1153)
(SCALE 1:25)

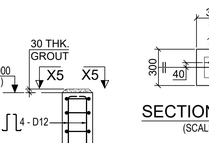


SECTION : X11 - X11
(SCALE 1:25)

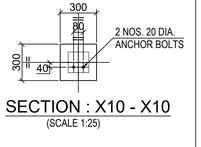


SECTION : X10 - X10
(SCALE 1:25)

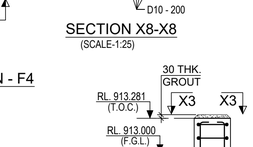


SECTION X8-X8
(SCALE-1:25)

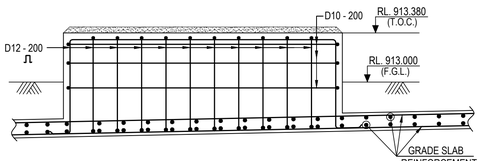


DETAIL OF PEDESTAL MKD. P2 & P3
(REF. DWG. NO. : MD-216-3220-EG-CV-GAD-1151)
(SCALE 1:25)

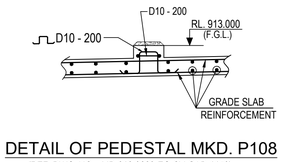


DETAIL OF PEDESTAL MKD. P108
(REF. DWG. NO. : MD-216-3220-EG-CV-GAD-1153)
(SCALE 1:25)

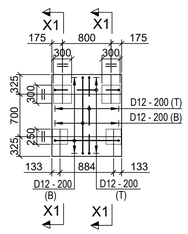


R.C. DETAIL OF FOUNDATION - F1
:. DRG. NO : MD-216-3220-EG-CV-GAD-1150)
(SCALE 1:50)

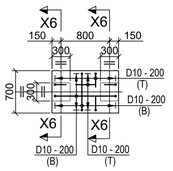


R.C. DETAIL OF FOUNDATION - F2
(REF. DRG. NO : MD-216-3220-EG-CV-GAD-1150)
(SCALE 1:50)

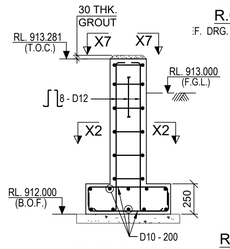


SECTION X6-X6
(SCALE-1:25)

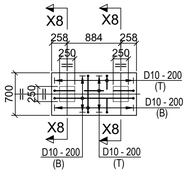


R.C. DETAIL OF FOUNDATION - F3
:F. DRG. NO : MD-216-3220-EG-CV-GAD-1150)
(SCALE 1:50)

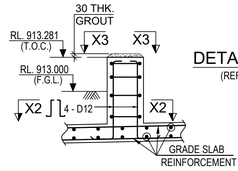


DETAIL OF PEDESTAL MKD. P1003
(REF. DWG. NO. : MD-216-3220-EG-CV-GAD-1153)
(SCALE 1:25)

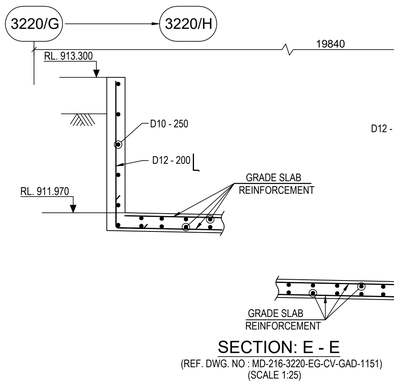


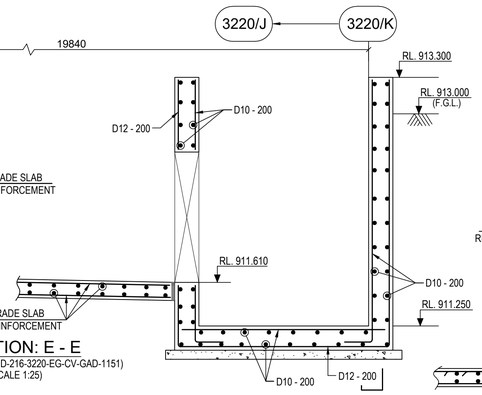


SECTION: E - E
(REF. DWG. NO : MD-216-3220-EG-CV-GAD-1151)
(SCALE 1:25)

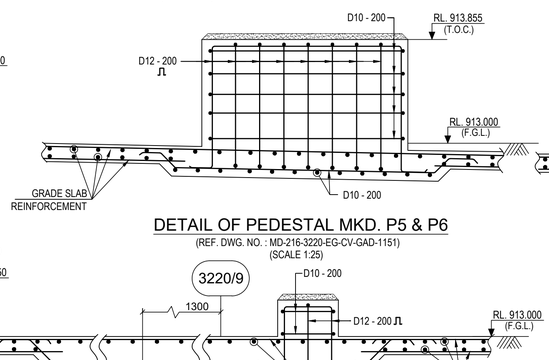


DETAIL OF PEDESTAL MKD. P5 & P6
(REF. DWG. NO. : MD-216-3220-EG-CV-GAD-1151)
(SCALE 1:25)

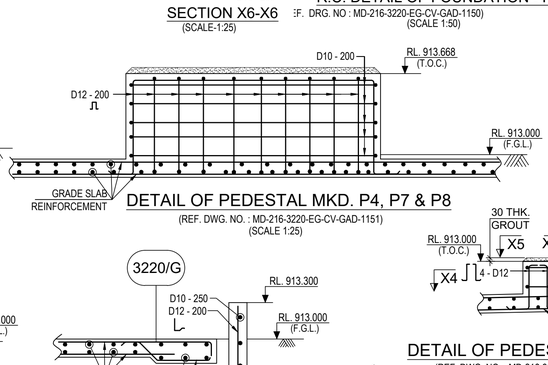

DETAIL OF PEDESTAL MKD. P4, P7 & P8
(REF. DWG. NO. : MD-216-3220-EG-CV-GAD-1151)
(SCALE 1:25)

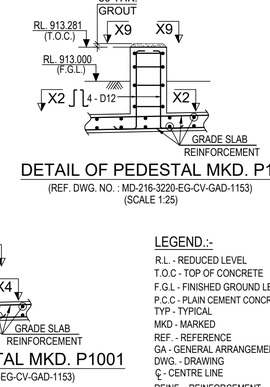


DETAIL OF PEDESTAL MKD. P1002
(REF. DWG. NO. : MD-216-3220-EG-CV-GAD-1153)
(SCALE 1:25)

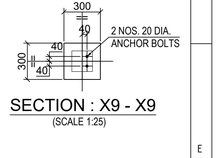


SECTION : X9 - X9
(SCALE 1:25)


SECTION: E1 - E1
(REF. DWG. NO. : MD-216-3220-EG-CV-GAD-1151)
(SCALE 1:25)

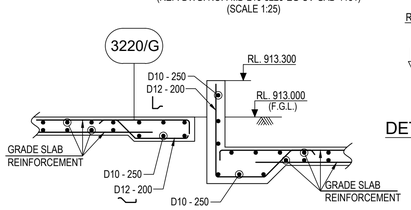


SECTION: D2 - D2
(REF. DWG. NO : MD-216-3220-EG-CV-GAD-1153)
(SCALE 1:25)

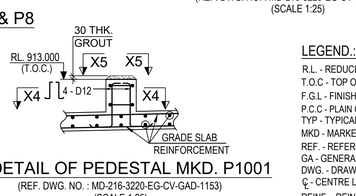


DETAIL OF PEDESTAL MKD. P1001
(REF. DWG. NO. : MD-216-3220-EG-CV-GAD-1153)
(SCALE 1:25)

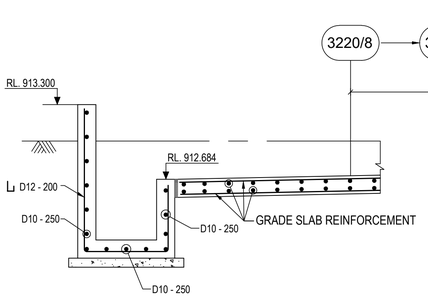


SECTION: D - D
(REF. DWG. NO : MD-216-3220-EG-CV-GAD-1151)
(SCALE 1:25)

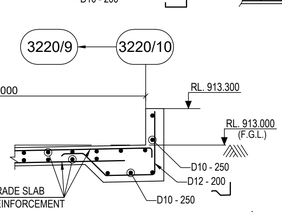

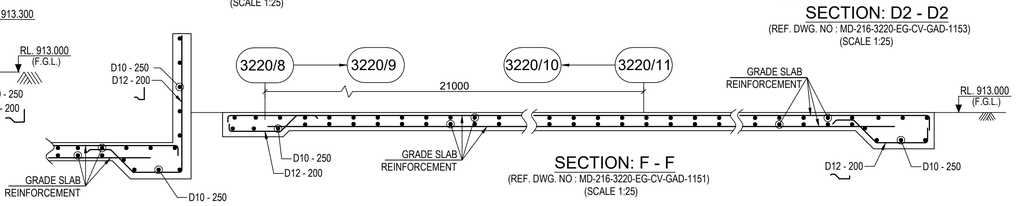

SECTION: F - F
(REF. DWG. NO : MD-216-3220-EG-CV-GAD-1151)
(SCALE 1:25)

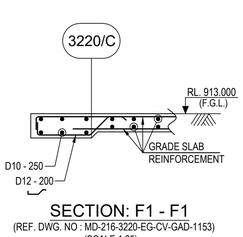

SECTION: F1 - F1
(REF. DWG. NO : MD-216-3220-EG-CV-GAD-1153)
(SCALE 1:25)

LEGEND :-

R.L. - REDUCED LEVEL
T.O.C - TOP OF CONCRETE
F.G.L - FINISHED GROUND LEVEL
P.C.C - PLAIN CEMENT CONCRETE
TYP - TYPICAL
MKD - MARKED
REF. - REFERENCE
GA - GENERAL ARRANGEMENT
DWG. - DRAWING
℄ - CENTRE LINE
REINF. - REINFORCEMENT

NOTES :-

1. ALL DIMENSIONS ARE IN MILLIMETRES AND LEVELS ARE IN METRES UNLESS OTHERWISE STATED.
2. GRADE OF CONCRETE SHALL BE C35 UNLESS OTHERWISE NOTED.
3. GRADE OF REINFORCEMENT SHALL BE DEFORMED BAR ASTM A615 - GRADE 60 (fy=420 MPa)
4. CLEAR COVER OF REINFORCEMENT SHALL BE AS FOLLOWS:
   a) WALL : 50 mm. (FOR DOUBLE LAYER REINF.) VERTICAL REINF. PLACED AT CENTRE (FOR SINGLE LAYER REINF.)
   b) SLAB : 20 mm.
   c) PEDESTAL : 50 mm.
5. FOR GA DRAWING REF. DRG. NO. MD-216-3220-EG-CV-GAD-1150. MD-216-3220-EG-CV-GAD-1151. MD-216-3220-EG-CV-GAD-1153.
6. FOR GENERAL NOTE FOR CIVIL WORK REF. DRG. NO : MD-216-1000-EG-CV-DED-1001.
7. FOR STANDARD REINF. DETAIL REF. DRG. NO : MD-216-1000-EG-CV-DED-1005.
8. REINFORCEMENT MAY BE SLIGHTLY ADJUSTED AT SITE TO ACCOMMODATE EMBEDDED PART.

DOCUMENT NUMBER	REFERENCE DOCUMENTS	REV	DATE	REVISION DESCRIPTION	DRN	CHK	ENG	APP	EMP
		D01	16/02/2023	AS-BUILT	SBH	BDA	SUE	AG	
		C05	22/01/2021	ISSUED FOR CONSTRUCTION & REVISED AS MKD.	SBH	BDA	SUE	AG	
		C04	11/12/2020	ISSUED FOR CONSTRUCTION & REVISED AS MKD.	SBH	BDA	SUE	AG	
		C03	21/09/2020	ISSUED FOR CONSTRUCTION	SBH	BDA	SUE	AG	
		C02	29/08/2020	ISSUED FOR APPROVAL & REVISED AS MKD.	SBH	BDA	SUE	AG	
		C01	08/05/2020	ISSUED FOR CONSTRUCTION	SBH	BDA	SUE	AG	
		A01	08/04/2020	ISSUED FOR REFERENCE	SBH	BDA	SUE	AG	

RESERVED FOR VENDOR LOGO AND DRAWING NUMBER

LARSEN & TOUBRO DRAWING NUMBER 019045_450_C_D_24078_007 — REVISION 6
OUTOTEC DRAWING NUMBER 900707__GAU01__ZG01__CTB17__32207 — DOCUMENT ID OU100676722 — REVISION 6

LARSEN & TOUBRO
This drawing is the property of LARSEN & TOUBRO and must not be passed on to any person or body not authorized by us to receive it nor be copied or otherwise made use either in full or in part by such person or body without our prior permission in writing.

Outotec
The content of these documents are the sole property of Outotec Oyj. Any rights not expressly granted herein are reserved. Reproduction, transfer or distribution of part or all of the contents in any form without prior written permission of Outotec is prohibited.

MA'ADEN معادن
Saudi Arabian Mining Company شركة التعدين العربية السعودية
This document and the information contained herein is Ma'aden proprietary know-how. This document or any part thereof should not be reproduced, stored in a retrieval system or transmitted by any means, electronic or otherwise, or divulged without prior written permission of Ma'aden.

DRAWN	SBH	06/04/2020
CHECKED	BDA	07/04/2020
ENGINEER	SUE	06/04/2020
APPROVED	AG	08/04/2020
EMPLOYER		
SCALE	1:30	A1

MANSOURAH - MASSARAH GOLD PROJECT
DETAIL DRAWING
GRINDING AND CLASSIFICATION-BALL MILL
GRADE SLAB RCC DETAILS

DRAWING NUMBER MD-216-3220-EG-CV-DED-1157 — REV D01