


DRAWING NUMBER: MD-216-3220-EG-CV-GAD-1145 | REV: D01

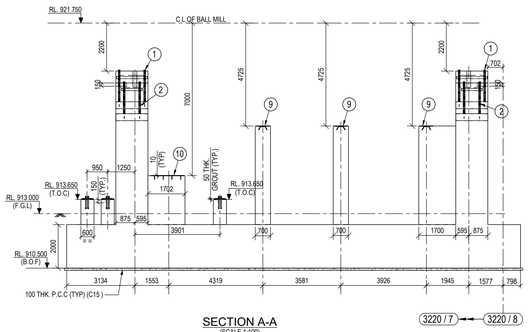


SECTION A-A
(SCALE 1:100)

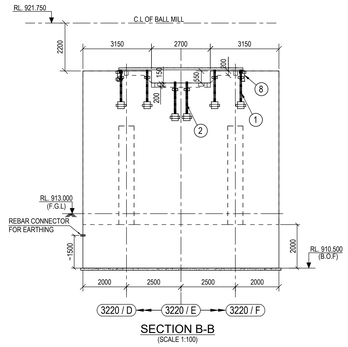


SECTION B-B
(SCALE 1:100)

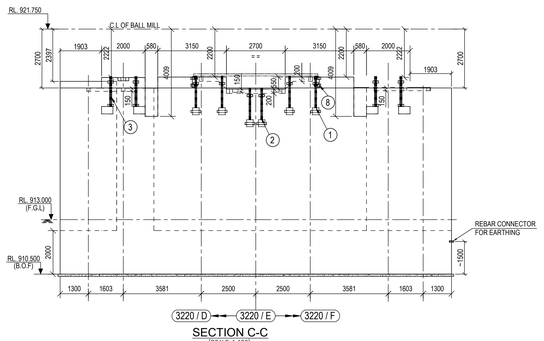


SECTION C-C
(SCALE 1:100)

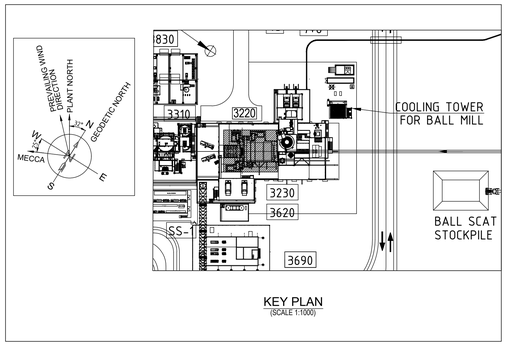


KEY PLAN
(SCALE 1:1000)

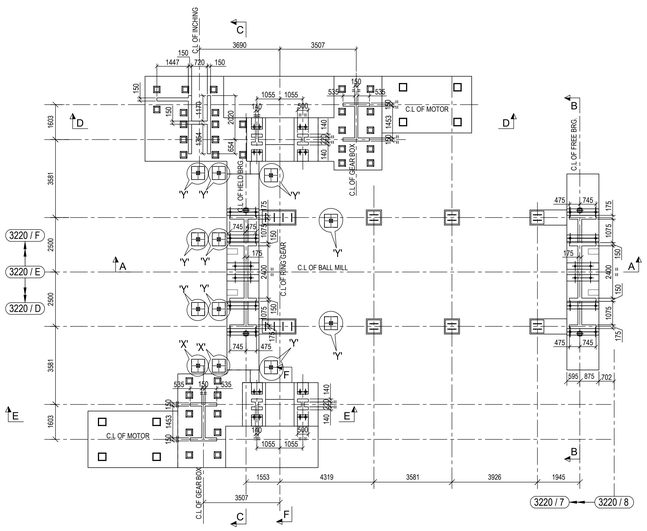


BALL MILL FOUNDATION TOP VIEW
(SHOWING SHEAR KEY DIMENSION ONLY)
(SCALE 1:100)

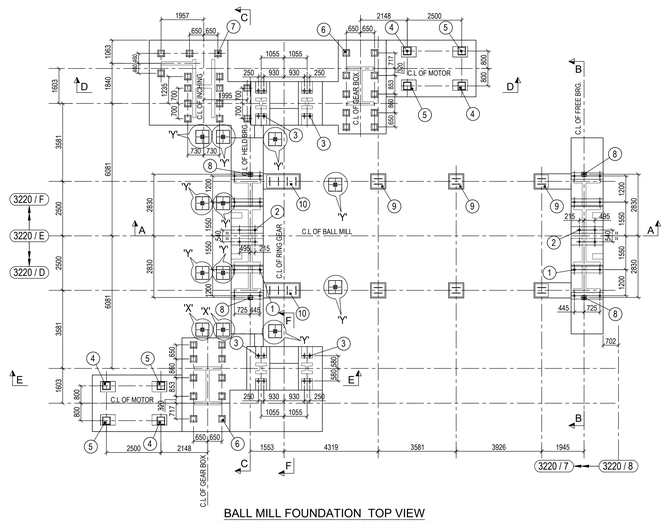


BALL MILL FOUNDATION TOP VIEW
(SHOWING EMBEDDED PARTS LOCATION ONLY)
(SCALE 1:100)

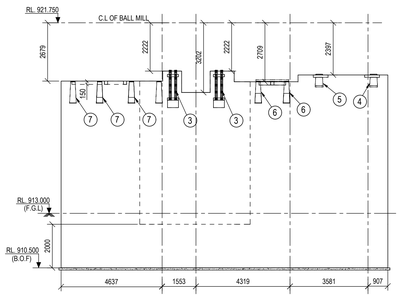


SECTION D-D
(SCALE 1:100)

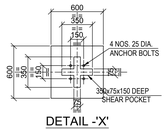


DETAIL -'X'
(SCALE-1:25)

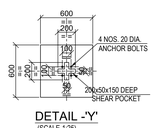


DETAIL -'Y'
(SCALE-1:25)

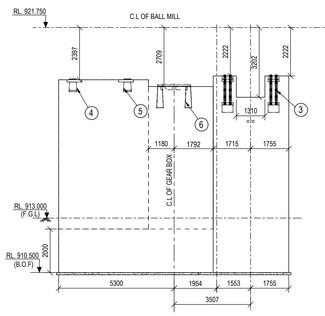


SECTION E-E
(SCALE 1:100)

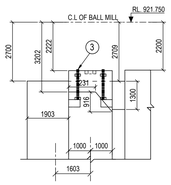

SECTION F-F
(SCALE 1:100)

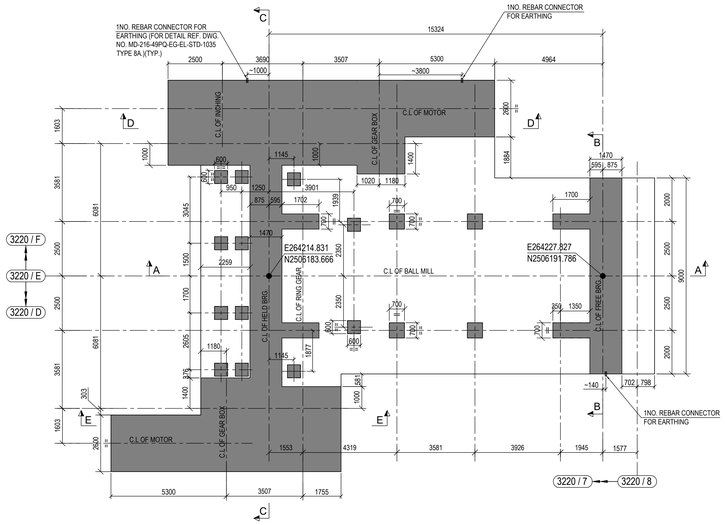

BALL MILL FOUNDATION PLAN AT TOP OF RAFT LEVEL
(SCALE 1:100)

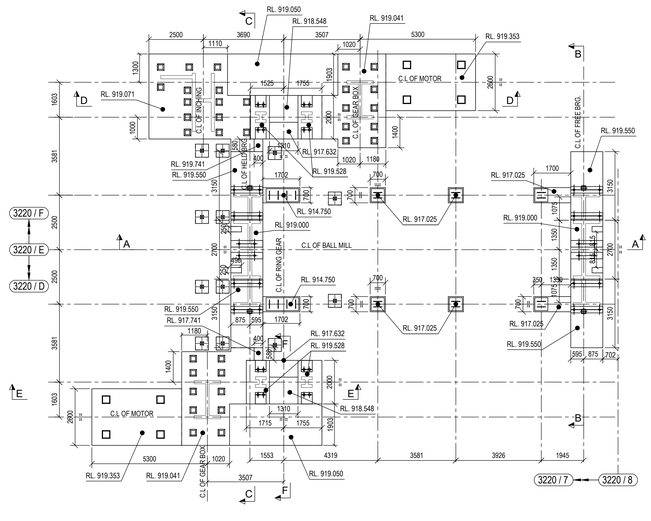

BALL MILL FOUNDATION TOP VIEW
(WITHOUT SHEAR KEY & BOLT DIMENSION)
(SCALE 1:100)

FOR DETAIL OF EMBEDDED PART REFER DWG. NO. MD_216_3220_EG_ME_GAD_1013 WHERE ALL THE DETAIL DRAWING ARE MENTIONED

LEGEND.:-

T.O.C	TOP OF CONCRETE
B.O.F	BOTTOM OF FOUNDATION
F.G.L	FINISHED GROUND LEVEL
TYP	TYPICAL
THK	THICKNESS
C.L	CENTRE LINE

NOTES:-

1. ALL DIMENSIONS ARE IN MILLIMETRES AND LEVELS ARE IN METRES UNLESS OTHERWISE STATED.
2. GRADE OF CONCRETE SHALL BE C35.
3. GRADE OF REINFORCEMENT SHALL BE DEFORMED BAR ASTM A615-GRADE 60 (fy=420MPa).
4. NET SAFE BEARING CAPACITY CONSIDERED AT THE FOUNDING LEVEL IS 670 KN/SQ. M
5. IF ANY PART OF FOUNDATION COMES ON BACKFILL ZONE OF ADJACENT FOUNDATION OR ANY LOOSE PACKETS ARE ENCOUNTERED BELOW FOUNDATION LEVEL THE SAME SHALL BE REMOVED AND FILLED WITH PCC.
6. FOR FOUNDATION BOLTS OF DETAIL 'X' & 'Y' REFER DWG. NO. : MD-216-1000-EG-CV-DED-1003 .
7. FOR GENERAL NOTE FOR CIVIL WORK REF. DRG. NO : MD-216-1000-EG-CV-DED-1001.

DOCUMENT NUMBER	REFERENCE DOCUMENTS	REV	DATE	REVISION DESCRIPTION	DRN	CHK	ENG	APP	EMP
		D01	16/02/2023	AS-BUILT	APM	BDA	SUE	AG	
		C03	21/07/2020	ISSUED FOR CONSTRUCTION	APM	BDA	SUE	AG	
		C02	16/05/2020	ISSUED FOR CONSTRUCTION	APM	BDA	SUE	AG	
		C01	24/02/2020	ISSUED FOR CONSTRUCTION	APM	BDA	SUE	AG	
		A03	17/02/2020	DRAWING REVISED BASED ON LATEST DESIGN CALCULATION AS PER EMPLOYER'S COMMENTS AND REVISED AS MARKED A03	APM	BDA	SUE	AG	
MD-216-3220-EG-ME-GAD-1001	GRINDING AND CLASSIFICATION - BALL MILL								
MD-216-3220-EG-ME-GAD-1002	3220-MILL-001, BALL MILL FOUNDATION LOADS	A02	17/01/2020	DRAWING REVISED BASED ON LATEST DESIGN CALCULATION AS PER EMPLOYER'S COMMENTS AND REVISED AS MARKED A02	APM	BDA	SUE	AG	
MD-216-3220-EG-ME-GAD-1013	3220-MILL-001, BALL MILL FOUNDATION SIDE VIEW								
MD-216-3220-EG-ME-GAD-1003	3220-MILL-001, BALL MILL FOUNDATION PLAN VIEW	A01	07/12/2019	ISSUED FOR REFERENCE	APM	BDA	SUE	AG	

RESERVED FOR VENDOR LOGO AND DRAWING NUMBER

LARSEN & TOUBRO
This drawing is the property of LARSEN & TOUBRO and must not be passed on to any person or body not authorized by us to receive it not be copied or otherwise made use either in full or in part by such person or body without our prior permission in writing.
Outotec
The content of these documents are the sole property of Outotec Oyj. Any rights not expressly granted herein are reserved. Reproduction, transfer or distribution of part or all of the contents in any form without prior written permission of Outotec is prohibited.
MA'ADEN معادن
Saudi Arabian Mining Company
This document and the information contained herein is Ma'aden proprietary know-how. This document or any part thereof should not be reproduced, stored in a retrieval system or transmitted by any means, electronic or otherwise, or divulged without prior written permission of Ma'aden.

LARSEN & TOUBRO DRAWING NUMBER	O19045_450_C_G_24077_001	REVISION 6
OUTOTEC DRAWING NUMBER	900707__GAU01__ZG01_MTL01__32211	DOCUMENT ID OU100664451 REVISION 6
DRAWN	APM	05/12/2019
CHECKED	BDA	07/12/2019
ENGINEER	SUE	05/12/2019
APPROVED	AG	07/12/2019
EMPLOYER		
SCALE	1:100	A0

MANSOURAH - MASSARAH GOLD PROJECT
GENERAL ARRANGEMENT
GRINDING AND CLASSIFICATION- BALL MILL
FOUNDATION PLAN & SECTION

DRAWING NUMBER: MD - 216 - 3220 - EG - CV - GAD - 1145 | REV: D01