


DRAWING NUMBER MD-216-3220-EG-CV-GAD-1147 REV D01

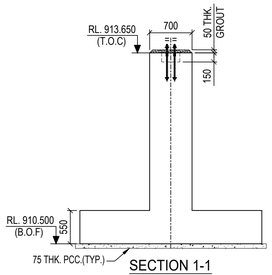


SECTION 1-1
(SCALE 1:50)

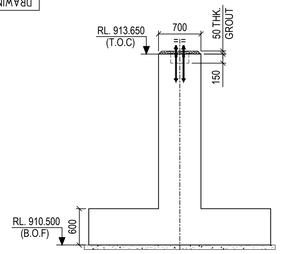


SECTION 1A-1A
(SCALE 1:50)

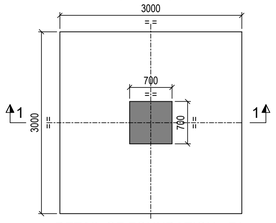


DETAIL OF FOUNDATION - F1
(SCALE 1:50)

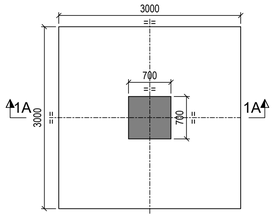


DETAIL OF FOUNDATION - F2
(SCALE 1:50)

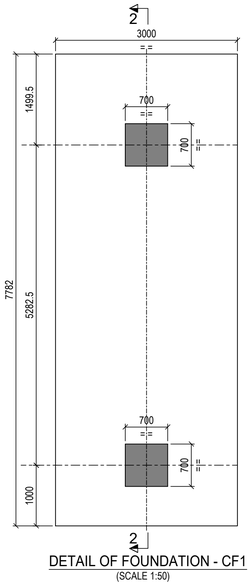


DETAIL OF FOUNDATION - CF1
(SCALE 1:50)

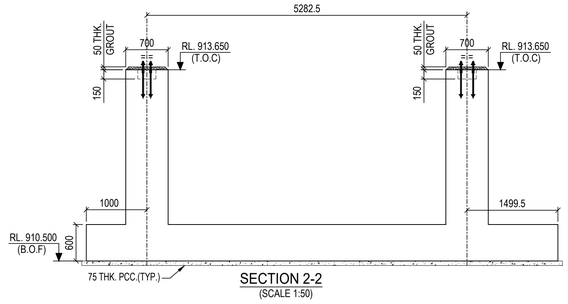


SECTION 2-2
(SCALE 1:50)

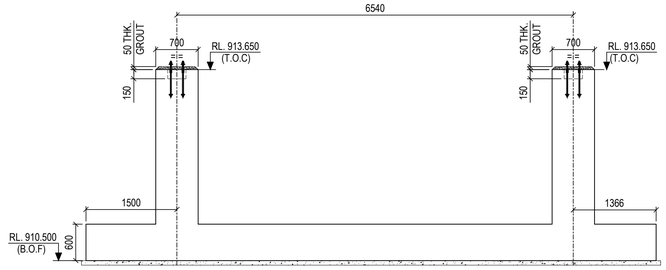


SECTION 3-3
(SCALE 1:50)

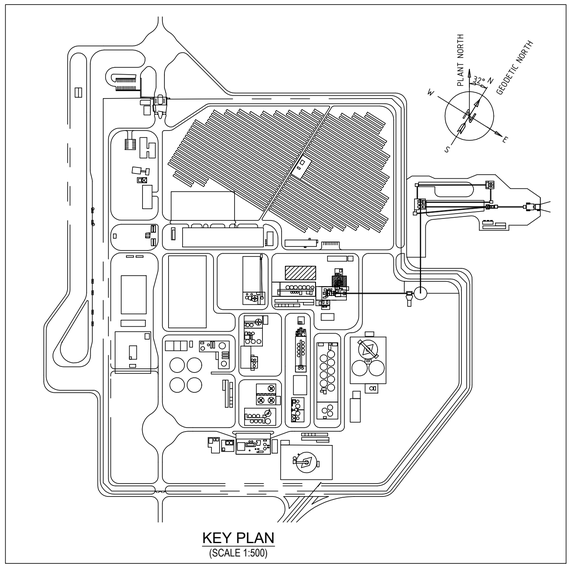


KEY PLAN
(SCALE 1:500)

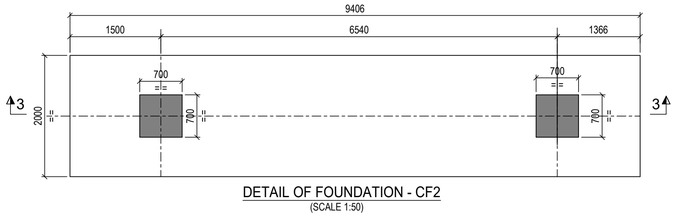


DETAIL OF FOUNDATION - CF2
(SCALE 1:50)

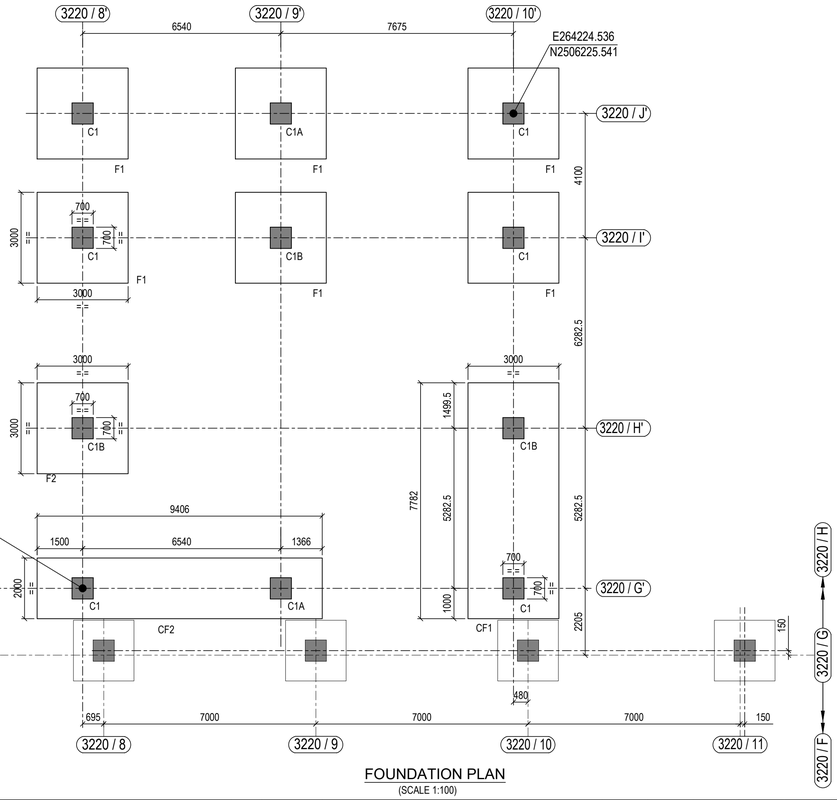


FOUNDATION PLAN
(SCALE 1:100)

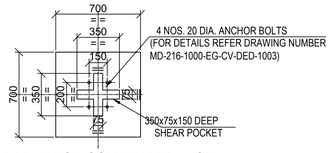

BOLT PLAN FOR COLUMN MKD. - C1B
(SCALE-1:25)

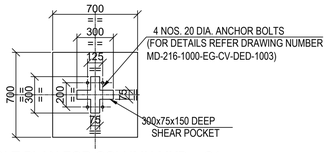

BOLT PLAN FOR COLUMN MKD. - C1
(SCALE-1:25)

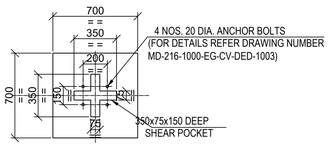

BOLT PLAN FOR COLUMN MKD. - C1A
(SCALE-1:25)

LEGEND :-

R.L. - REDUCED LEVEL
T.O.C. - TOP OF CONCRETE.
F.G.L. - FINISHED GROUND LEVEL.
F.F.L. - FINISHED FLOOR LEVEL.
B.O.F. - BOTTOM OF FOUNDATION
TYP. - TYPICAL.
R.C. - REINFORCED CONCRETE
P.C.C - PLAIN CEMENT CONCRETE
MKD. - MARKED.
THK. - THICK
DRG. - DRAWING
DIA. - DIAMETER
SUPP. - SUPPORT
STR. - STRUCTURE

NOTES :-

1. ALL DIMENSIONS ARE IN MILLIMETRES AND LEVELS AND CO-ORDINATES ARE IN METRES. UNLESS OTHERWISE STATED.
2. GRADE OF CONCRETE SHALL BE C35 FOR FOUNDATION.
3. GRADE OF REINFORCEMENT SHALL BE DEFORMED BAR ASTM A615 - GRADE 60 (fy = 420 MPa).
4. NET SAFE BEARING CAPACITY OF SOIL AT BOTTOM OF FOUNDATION CONSIDERED 600KN/SQ. M.
5. CLEAR COVER TO MAIN REINFORCEMENT SHALL BE AS
   a) FOUNDATION = 75 mm (BOTTOM & SIDE) 50 mm. (TOP)
   b) COLUMN & PEDESTAL = 50mm
   c) BEAM = 50mm
   d) SLAB = 40mm
6. MINIMUM LAP LENGTH OF REINFORCEMENT SHALL BE 40 x DIA. OF BAR.
7. READ THIS DRAWING IN CONJUNCTION WITH DRG: MD-216-3220-EG-CV-DED-1153. MD-216-3220-EG-ST-GAD-2145.

DOCUMENT NUMBER	REFERENCE DOCUMENTS	REV	DATE	REVISION DESCRIPTION	DRN	CHK	ENG	APP	EMP
		D01	16/02/2023	AS-BUILT	APM	BDA	STY	AG	
		C04	30/09/2020	ISSUED FOR CONSTRUCTION	APM	BDA	STY	AG	
		C03	26/08/2020	ISSUED FOR APPROVAL AND REVISED AS MARKED	APM	BDA	STY	AG	
		C02	29/07/2020	ISSUED FOR APPROVAL AND REVISED AS MARKED	APM	BDA	STY	AG	
MD-216-3220-EG-ST-GAD-2145	DB BOX & SCREEN SUPP. STR. PLAN & ELEVATION	C01	30/03/2020	ISSUED FOR CONSTRUCTION	APM	BDA	STY	AG	
MD-216-3220-EG-CV-GAD-1005	CIVIL WORK - GUIDE DRAWING	A01	03/03/2020	ISSUED FOR REFERENCE	APM	BDA	STY	AG	

RESERVED FOR VENDOR LOGO AND DRAWING NUMBER

LARSEN & TOUBRO

This drawing is the property of LARSEN & TOUBRO and must not be passed on to any person or body not authorized by us to receive it nor be copied or otherwise made use either in full or in part by such person or body without our prior permission in writing.

Outotec

The content of these documents are the sole property of Outotec Oyj. Any rights not expressly granted herein are reserved. Reproduction, transfer or distribution of part or all of the contents in any form without prior written permission of Outotec is prohibited.

MA'ADEN معادن
Saudi Arabian Mining Company شركة معادن العربية السعودية

This document and the information contained herein is Ma'aden proprietary know-how. This document or any part thereof should not be reproduced, stored in a retrieval system or transmitted by any means, electronic or otherwise, or divulged without prior written permission of Ma'aden.

LARSEN & TOUBRO DRAWING NUMBER: 019045_450_C_G_24077_003 — REVISION: 5
OUTOTEC DRAWING NUMBER: 900707__GAU01__ZG01__MTL01__32221 — DOCUMENT ID: 0U100671072 — REVISION: 5

DRAWN	APM	29/02/2020
CHECKED	BDA	02/03/2020
ENGINEER	STY	25/02/2020
APPROVED	AG	03/03/2020
EMPLOYER		
SCALE	1:100, 1:50	A1

MANSOURAH - MASSARAH GOLD PROJECT
GENERAL ARRANGEMENT
GRINDING AND CLASSIFICATION-BALL MILL
DB BOX & SCREEN SUPP. STR. FOUNDATION

DRAWING NUMBER: MD - 216 - 3220 - EG - CV - GAD - 1147 — REV: D01