


DRAWING NUMBER MD-216-3220-EG-CV-GAD-1148 REV D01

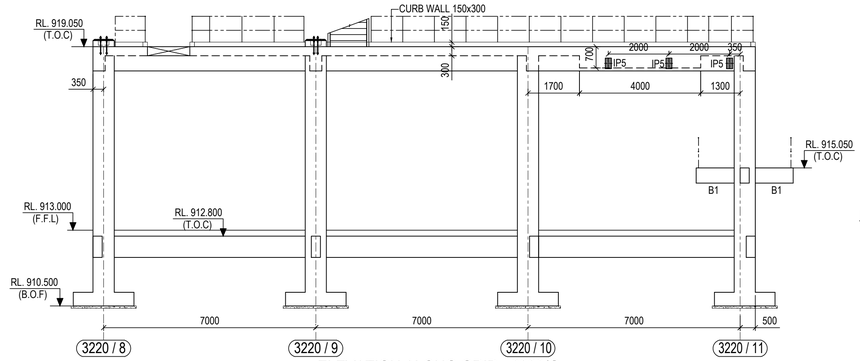


ELEVATION ALONG GRID - 3220/G
(SCALE 1:100)

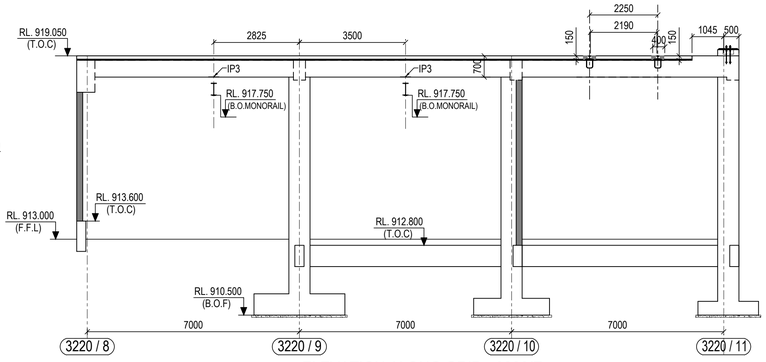


ELEVATION ALONG GRID - 3220/E
(SCALE 1:100)

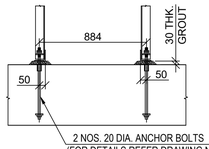


SECTION 3-3
(SCALE- 1:25)

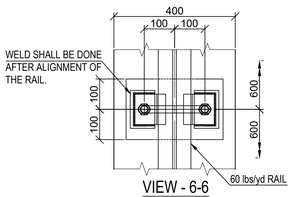


VIEW - 6-6
(SCALE 1:10)

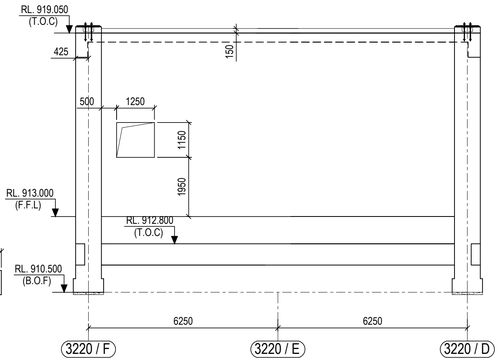


ELEVATION ALONG GRID - 3220/8
(SCALE 1:100)

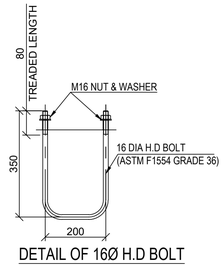


DETAIL OF 16Ø H.D BOLT
(SCALE 1:10)

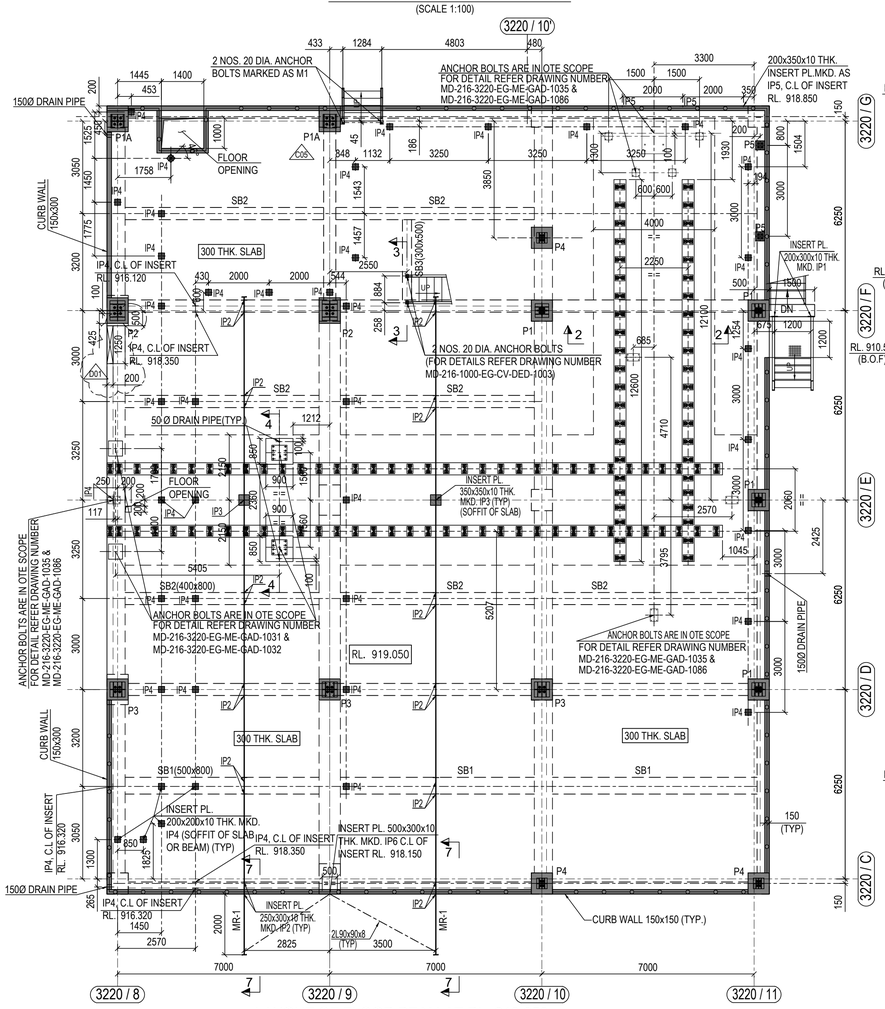

LAYOUT OF FLOOR BEAM AT RL. 919.050
(SCALE 1:100)

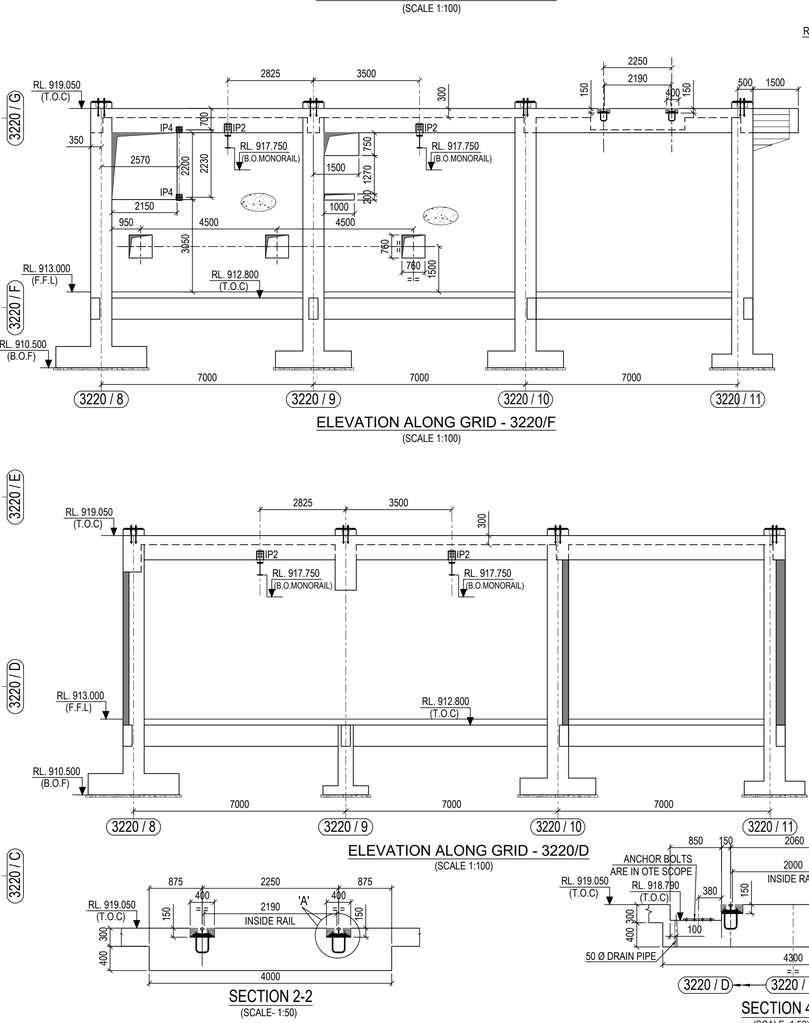


ELEVATION ALONG GRID - 3220/F
(SCALE 1:100)

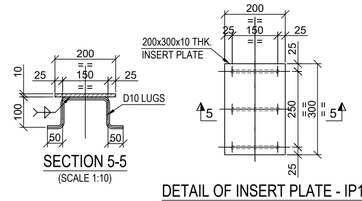


SECTION 5-5
(SCALE 1:10)

DETAIL OF INSERT PLATE - IP1
(SCALE 1:10)

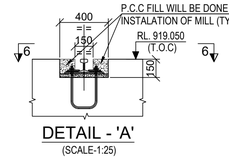

DETAIL - 'A'
(SCALE-1:25)

ELEVATION ALONG GRID - 3220/D
(SCALE 1:100)

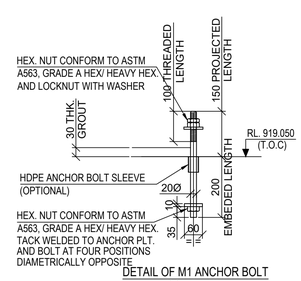

DETAIL OF M1 ANCHOR BOLT
(SCALE-1:10)


LEGEND :-

R.L. - REDUCED LEVEL
T.O.C. - TOP OF CONCRETE.
F.G.L. - FINISHED GROUND LEVEL.
F.F.L. - FINISHED FLOOR LEVEL.
B.O.F. - BOTTOM OF FOUNDATION
TYP. - TYPICAL.
R.C. - REINFORCED CONCRETE
P.C.C - PLAIN CEMENT CONCRETE
C.L - CENTRE LINE
B.O - BOTTOM OF
MKD. - MARKED.
THK. - THICK
B/W - BOTH WAYS
Ø - DIAMETER
DIA. - DIAMETER

NOTES :-

1. ALL DIMENSIONS ARE IN MILLIMETRES AND LEVELS AND CO-ORDINATES ARE IN METRES. UNLESS OTHERWISE STATED.
2. GRADE OF CONCRETE SHALL BE C35 FOR FOUNDATION.
3. GRADE OF REINFORCEMENT SHALL BE DEFORMED BAR ASTM A615 - GRADE 60 (fy = 420 MPa).
4. NET SAFE BEARING CAPACITY OF SOIL AT BOTTOM OF FOUNDATION CONSIDERED 600KN/SQ. M.
5. CLEAR COVER TO MAIN REINFORCEMENT SHALL BE AS
   a) FOUNDATION = 75 mm (BOTTOM & SIDE) 50 mm. (TOP)
   b) COLUMN & PEDESTAL = 50mm
   c) BEAM = 50mm
   d) SLAB = 40mm
6. FOR LAP LENGTHS REFER DWG. NO. MD-216-1000-EG-CV-DED-1001.
7. FOR DETAIL OF HANDRAIL FIXING REFER STANDARD DRAWING.
8. READ THIS DRAWING IN CONJUNCTION WITH DRG: MD-216-3220-EG-CV-GAD-1146, MD-216-3220-EG-CV-GAD-1149, MD-216-3220-EG-CV-GAD-1152, MD-216-3220-EG-CV-GAD-1154 & MD-216-3220-EG-CV-GAD-1155.
9. FOR PROTECTIVE COATING REFER DRAWING NO. MD-216-1000-EG-CV-DED-1001.
10. FOR MONORAIL CONNECTION & INSERT PL. DETAIL REFER DRAWING NO. MD-216-3220-EG-CV-GAD-1149.

SECTION 2-2
(SCALE- 1:50)

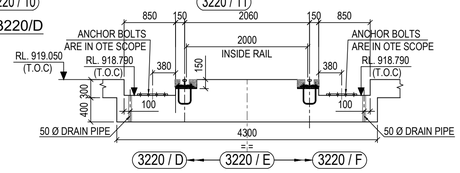

SECTION 4-4
(SCALE- 1:50)

DOCUMENT NUMBER	REFERENCE DOCUMENTS	REV	DATE	REVISION DESCRIPTION	DRN	CHK	ENG	APP	EMP
		D01	20-02-2023	AS-BUILT	NAEW/SN	BDA	STY	AG	
		C05	04/01/2021	ISSUED FOR CONSTRUCTION & REVISED AS MARKED /C05	APM	BDA	STY	AG	
		C04	10/12/2020	ISSUED FOR CONSTRUCTION & REVISED AS MARKED /C04	APM	BDA	STY	AG	
		C03	11/11/2020	ISSUED FOR CONSTRUCTION & REVISED AS MARKED /C03	APM	BDA	STY	AG	
		C02	03/09/2020	ISSUED FOR CONSTRUCTION & REVISED AS MARKED /C02	APM	BDA	STY	AG	
MD-216-3220-EG-ST-GAD-2142	CONVEYOR & CYCLONE SUPP. STR. PLAN & ELEVATION	C01	16/05/2020	ISSUED FOR CONSTRUCTION	APM	BDA	STY	AG	
MD-216-3220-EG-CV-GAD-1005	CIVIL WORK - GUIDE DRAWING	A02	18/04/2020	REVISED AS PER EMPLOYER'S COMMENTS	APM	BDA	STY	AG	
MD-216-3220-EG-CV-GAD-1004	CIVIL WORK - GUIDE DRAWING			ON 06/04/2020 AND REVISED AS MARKED /A02					
MD-216-3220-EG-CV-GAD-1003	CIVIL WORK - GUIDE DRAWING	A01	28/02/2020	ISSUED FOR REFERENCE	APM	BDA	STY	AG	

RESERVED FOR VENDOR LOGO AND DRAWING NUMBER

LARSEN & TOUBRO
This drawing is the property of LARSEN & TOUBRO and must not be passed on to any person or body not authorized by us to receive it nor be copied or otherwise made use either in full or in part by such person or body without our prior permission in writing.

Outotec
The content of these documents are the sole property of Outotec Oyj. Any rights not expressly granted herein are reserved. Reproduction, transfer or distribution of part or all of the contents in any form without prior written permission of Outotec is prohibited.

MA'ADEN معادن
Saudi Arabian Mining Company شركة معادن العربية السعودية
This document and the information contained herein is Ma'aden proprietary know-how. This document or any part thereof should not be reproduced, stored in a retrieval system or transmitted by any means, electronic or otherwise, or divulged without prior written permission of Ma'aden.

DRAWN	APM	26/02/2020	
CHECKED	BDA	27/02/2020	
ENGINEER	STY	25/02/2020	
APPROVED	AG	28/02/2020	
EMPLOYER			
SCALE	1:100, 1:50	A1	

LARSEN & TOUBRO DRAWING NUMBER: 019045_450_C_G_24077_004 — REVISION: 7
OUTOTEC DRAWING NUMBER: 900707 __GAU01 __ZG01__MTL01 __32222 — DOCUMENT ID: 0U100671073 — REVISION: 7

MANSOURAH - MASSARAH GOLD PROJECT
GENERAL ARRANGEMENT
GRINDING AND CLASSIFICATION-BALL MILL
RELINING AREA - FLOOR PLAN AND ELEVATION

DRAWING NUMBER: MD - 216 - 3220 - EG - CV - GAD - 1148 — REV: D01