


DRAWING NUMBER: MD - 216 - 3220 - EG - CV - GAD - 1150 | REV: D01

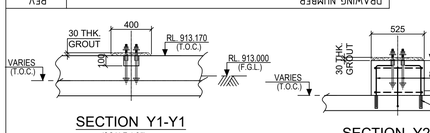


SECTION Y1-Y1
(SCALE 1:25) C09

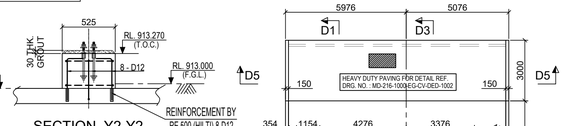


SECTION Y2-Y2
(SHOWING RC)
(SCALE 1:25) C09

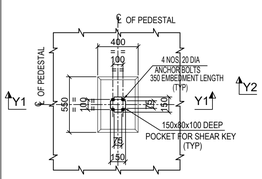


DETAIL -`Z1'
(SCALE-1:25)

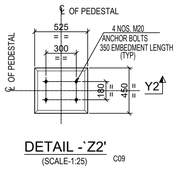


DETAIL -`Z2'
(SCALE-1:25) C09

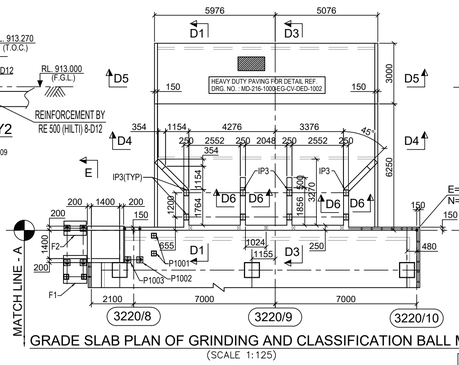


GRADE SLAB PLAN OF GRINDING AND CLASSIFICATION BALL MILL
(SCALE 1:125)

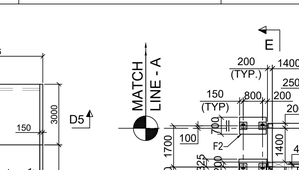


DETAIL -`A1'
(SCALE-1:25)

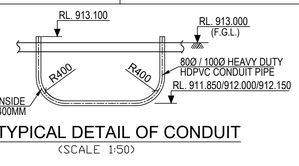


TYPICAL DETAIL OF CONDUIT
(SCALE 1:50)

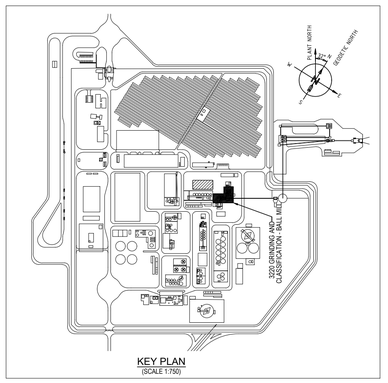


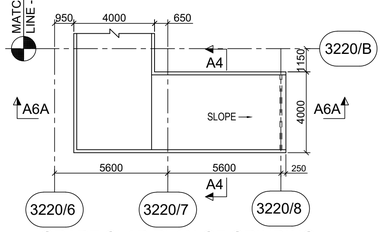


GRADE SLAB PLAN OF GRINDING AND CLASSIFICATION BALL MILL
(SCALE 1:125)

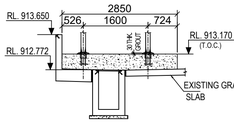

SECTION X1-X1
(R.C DETAIL)
SCALE 1:50

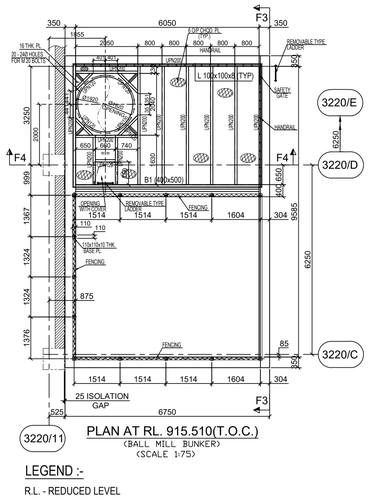

PLAN AT RL. 915.510(T.O.C.)
(BALL MILL BUNKER)
(SCALE 1:75)

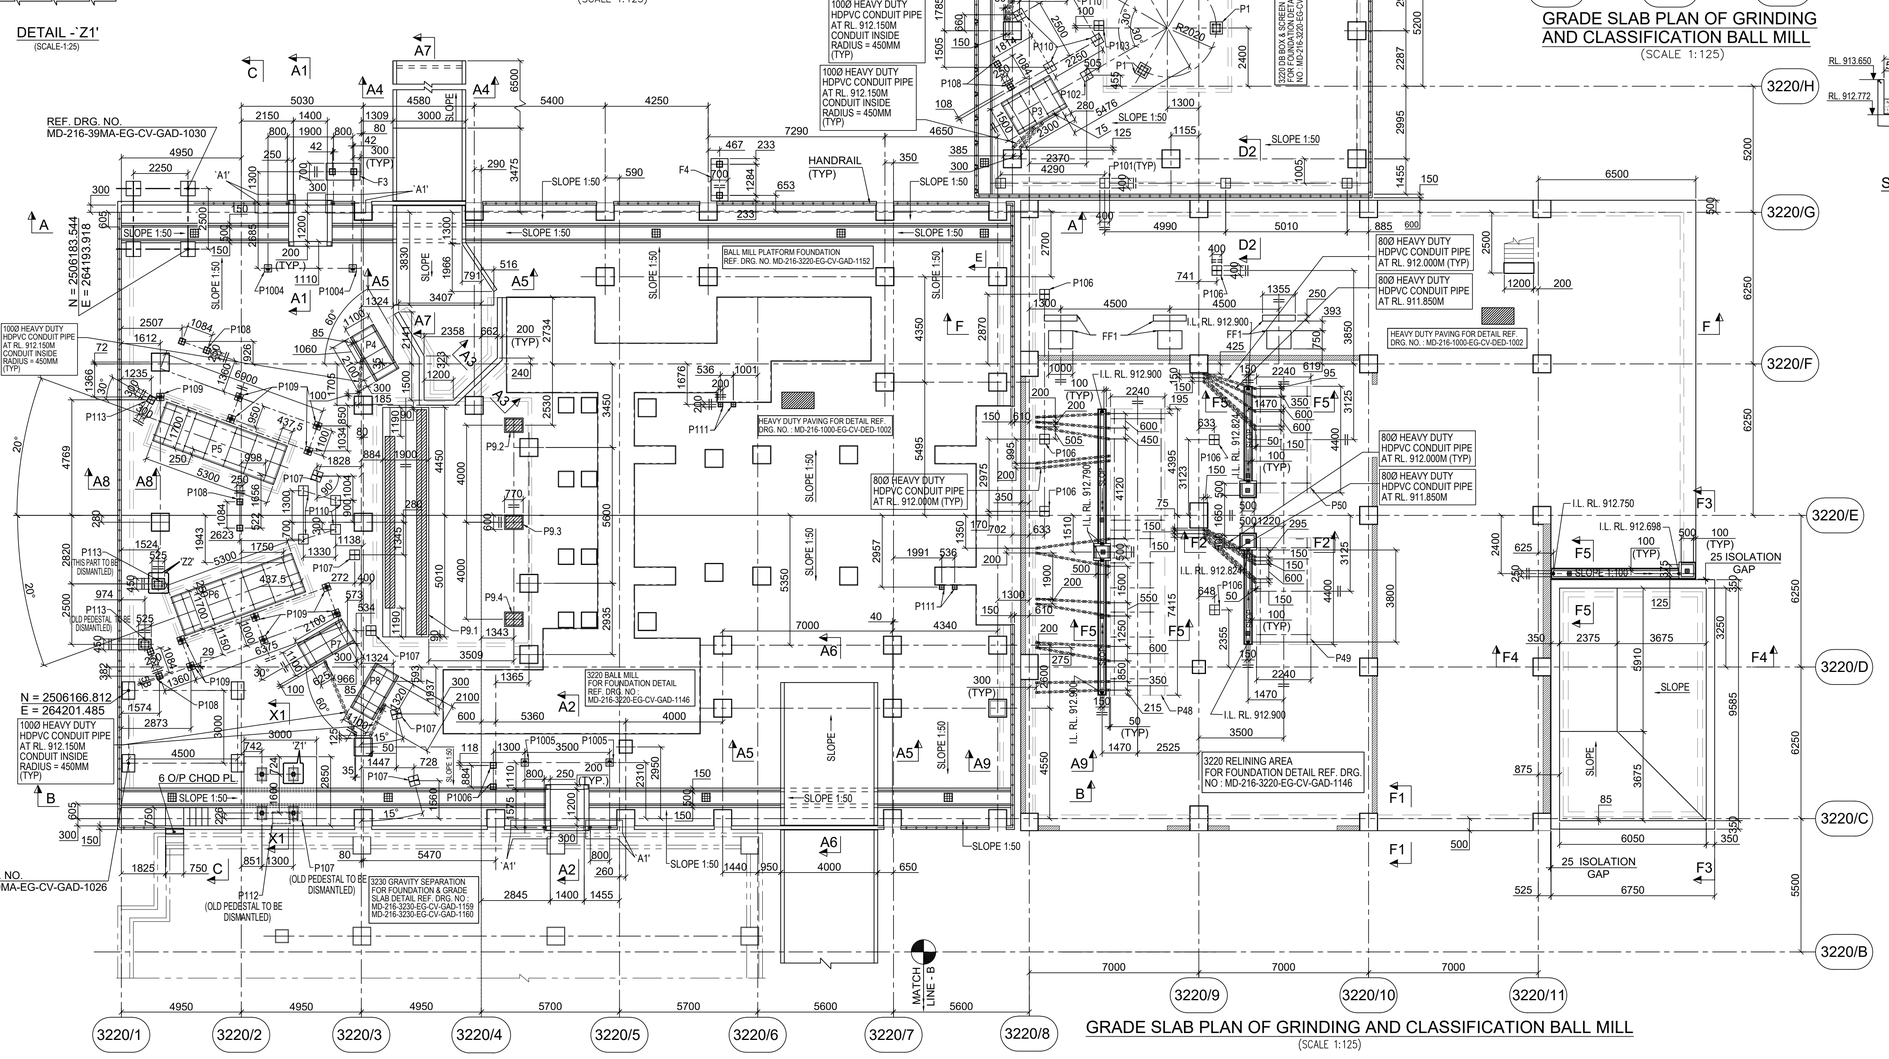

GRADE SLAB PLAN OF GRINDING AND CLASSIFICATION BALL MILL
(SCALE 1:125)

LEGEND :-

R.L. - REDUCED LEVEL
T.O.C. - TOP OF CONCRETE.
F.G.L. - FINISHED GROUND LAVAL.
TYP. - TYPICAL
P.C.C - PLAIN CEMENT CONCRETE
MKD. - MARKED.
THK. - THICK
C - CENTRE LINE

NOTES:-

1. ALL DIMENSIONS ARE IN MILLIMETRES AND LEVELS ARE IN METRES UNLESS OTHERWISE STATED.
2. GRADE OF CONCRETE SHALL BE C35 UNLESS NOTED OTHERWISE.
3. GRADE OF REINFORCEMENT SHALL BE DEFORMED BAR ASTM A615-GRADE 60 (fy=420 MPa)
4. IF ANY PART OF FOUNDATION COMES ON BACKFILL ZONE OF ADJACENT FOUNDATION OR ANY LOOSE POCKETS ARE ENCOUNTERED BELOW FOUNDATION LEVEL THE SAME SHALL BE REMOVED AND FILLED WITH PCC.
5. FOR SECTION AND DETAIL GA REF. DRG.NO. MD - 216 - 3220 - EG - CV - GAD -1151. MD - 216 - 3220 - EG - CV - GAD -1153.
6. FOR REINFORCEMENTS DETAIL REF. DRG. NO. MD - 216 - 3220 - EG - CV - DED - 1156. MD - 216 - 3220 - EG - CV - DED - 1157. MD - 216 - 3220 - EG - CV - DED - 1159.
7. FOR STANDARD DETAILS FOR PAVING REF. DRG. NO : MD-216-1000-EG-CV-DED-1002.
8. FOR FOUNDATION BOLT DETAILS REF. DRG. NO : MD-216-1000-EG-CV-DED-1003.
9. FOR GENERAL NOTE FOR CIVIL WORK REF. DRG. NO : MD-216-1000-EG-CV-DED-1001.
10. FOR ELECTRICAL CONDUIT DETAIL REF. DRG. NO : MD-216-3200-EG-EL-LAD-1001.

DOCUMENT NUMBER	REFERENCE DOCUMENTS	REV	DATE	REVISION DESCRIPTION	DRN	CHK	ENG	APP	EMP
		D01	13-02-2023	AS-BUILT	NAEW SS	BDA	STY	AG	
MD-216-3220-EG-ST-GAD-2141	BALL MILL PLATFORM PLAN AND SECTION	C09	25/10/2021	ISSUED FOR CONSTRUCTION & REVISED AS MKD. C09	AMJ	AVG	SUE	AG	
MD-216-3220-EG-ST-GAD-2140	BALL MILL PLATFORM PLAN AND SECTION	C08	04/10/2021	ISSUED FOR CONSTRUCTION & REVISED AS MKD. C08	APM	BDA	SUE	AG	
MD-216-3220-EG-ME-GAD-1031	19-32-MRM	C07	24/02/2021	ISSUED FOR CONSTRUCTION & REVISED AS MKD. C07	SBH	BDA	SUE	AG	
MD-216-3220-EG-GE-GAD-1076	3220-TANK-002 CYCLONE OVERFLOW PUMP SUMP	C06	05/02/2021	ISSUED FOR CONSTRUCTION & REVISED AS MKD. C06	SBH	BDA	SUE	AG	
MD-216-3220-EG-GE-GAD-1048	3220-TANK-001 BALL MILL DISCHARGE SUMP	C05	22/01/2021	ISSUED FOR CONSTRUCTION & REVISED AS MKD. C05	SBH	BDA	SUE	AG	
MD-216-3220-EG-ME-GAD-1085	PLAN AT EL.(+)913.000	C04	11/12/2020	ISSUED FOR CONSTRUCTION & REVISED AS MKD. C04	SBH	BDA	SUE	AG	
MD-216-3220-EG-CV-GAD-1005	PLAN AT EL.(+)913.000 - GRID G-J/7-10	C03	21/09/2020	ISSUED FOR CONSTRUCTION	SBH	BDA	SUE	AG	
MD-216-3220-EG-CV-GAD-1003	PLAN AT EL.(+)913.000 - GRID C-G/8-11	C02	29/08/2020	ISSUED FOR APPROVAL & REVISED AS MKD. C02	SBH	BDA	SUE	AG	
MD-216-3220-EG-CV-GAD-1002	SECTION A-A TO H-H & EQUIP. FOUNDATION	C01	08/05/2020	ISSUED FOR CONSTRUCTION	SBH	BDA	SUE	AG	
MD-216-3220-EG-CV-GAD-1001	PLAN AT EL.(+)913.000 - GRID C-G/1-8	A01	08/04/2020	ISSUED FOR REFERENCE	SBH	BDA	SUE	AG	

RESERVED FOR VENDOR LOGO AND DRAWING NUMBER

LARSEN & TOUBRO

This drawing is the property of LARSEN & TOUBRO and must not be passed on to any person or body not authorized by us to receive it nor be copied or otherwise made use either in full or in part by such person or body without our prior permission in writing.

Outotec

The content of these documents are the sole property of Outotec Oyj. Any rights not expressly granted herein are reserved. Reproduction, transfer or distribution of part or all of the contents in any form without prior written permission of Outotec is prohibited.

MA'ADEN معادن
Saudi Arabian Mining Company شركة التعدين العربية السعودية

This document and the information contained herein is Ma'aden proprietary know-how. This document or any part thereof should not be reproduced, stored in a retrieval system or transmitted by any means, electronic or otherwise, or divulged without prior written permission of Ma'aden.

LARSEN & TOUBRO DRAWING NUMBER			REVISION
019045_450_C_G_24077_006			10
OUTOTEC DRAWING NUMBER		DOCUMENT ID	REVISION
900707__GAU01__ZG01__MTL01__32224		0U100671075	10
DRAWN	SBH	06/04/2020	MANSOURAH - MASSARAH GOLD PROJECT
CHECKED	BDA	07/04/2020	GENERAL ARRANGEMENT
ENGINEER	SUE	06/04/2020	GRINDING AND CLASSIFICATION-BALL MILL
APPROVED	AG	08/04/2020	GRADE SLAB DETAILS
EMPLOYER			
SCALE 1:30		A1	DRAWING NUMBER: MD - 216 - 3220 - EG - CV - GAD - 1150 REV: D01