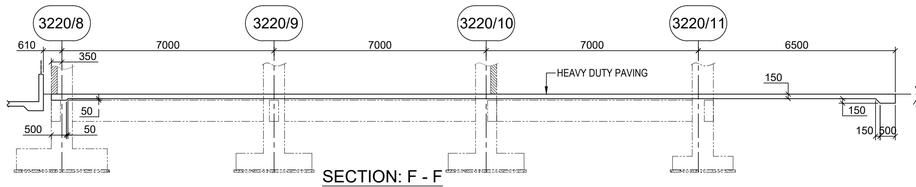
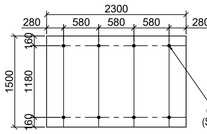
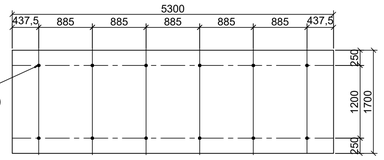
DRAWING NUMBER: MD-216-3220-EG-CV-GAD-1151
REV: D01



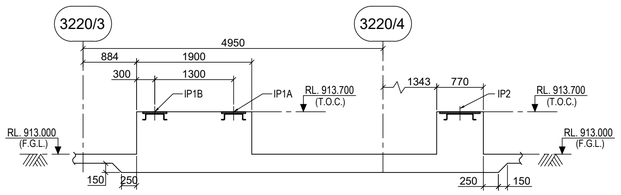

SECTION: F - F
(SCALE 1:100)



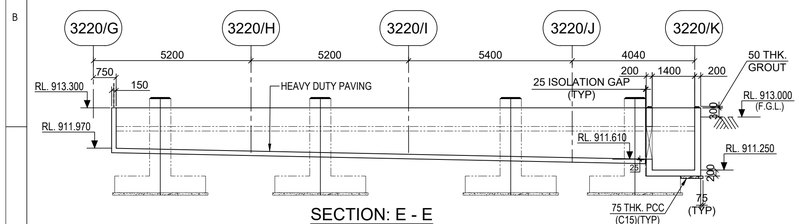

TOP VIEW OF PEDESTAL MKD. P2 & P3
(SCALE 1:50)



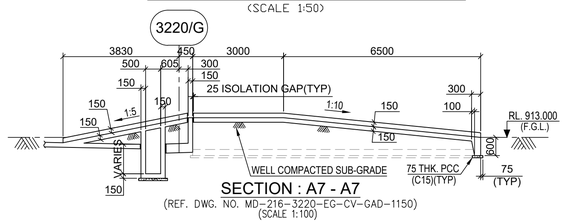

TOP VIEW OF PEDESTAL MKD. P5 & P6
(SCALE 1:50)



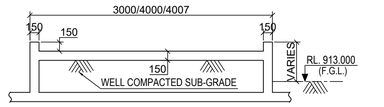

DETAIL OF PEDESTAL MKD. P-9.1, P-9.2, P-9.3 & P-9.4
(SCALE 1:50)



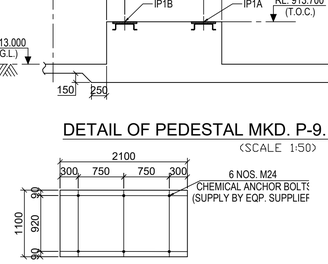

SECTION: E - E
(SCALE 1:100)



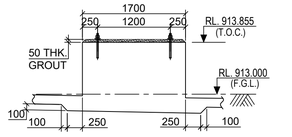

SECTION : A7 - A7
(REF. DWG. NO. MD-216-3220-EG-CV-GAD-1150)
(SCALE 1:100)



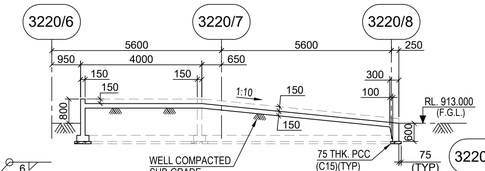

SECTION : A5 - A5
(REF. DWG. NO. MD-216-3220-EG-CV-GAD-1150)
(SCALE 1:50)



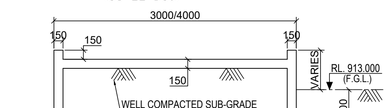

TOP VIEW OF PEDESTAL MKD. P4, P7 & P8
(SCALE 1:50)



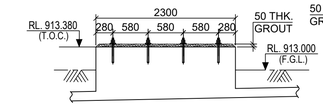

DETAIL OF PEDESTAL MKD. P5 & P6
(SCALE 1:50)



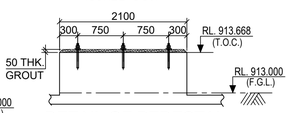

SECTION : A6A - A6A
(REF. DWG. NO. MD-216-3220-EG-CV-GAD-1150)
(SCALE 1:100)



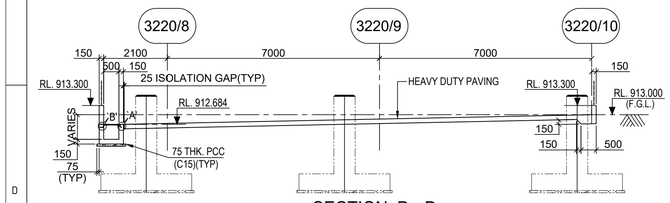

SECTION : A4 - A4
(REF. DWG. NO. MD-216-3220-EG-CV-GAD-1150)
(SCALE 1:50)



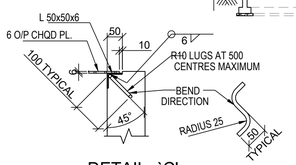

DETAIL OF PEDESTAL MKD. P2 & P3
(SCALE 1:50)



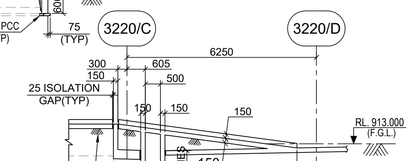

DETAIL OF PEDESTAL MKD. P4, P7 & P8
(SCALE 1:50)



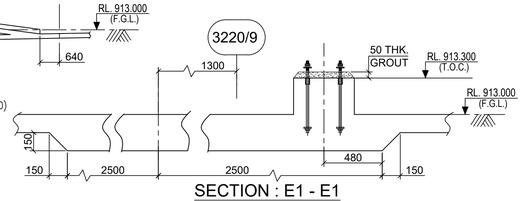

SECTION: D - D
(SCALE 1:100)



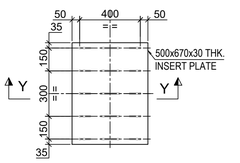

DETAIL -`C'
(SCALE 1:10)



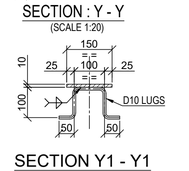

SECTION : A6 - A6
(REF. DWG. NO. MD-216-3220-EG-CV-GAD-1150)
(SCALE 1:100)



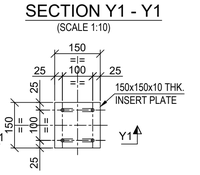

SECTION : E1 - E1
(SCALE-1:25)



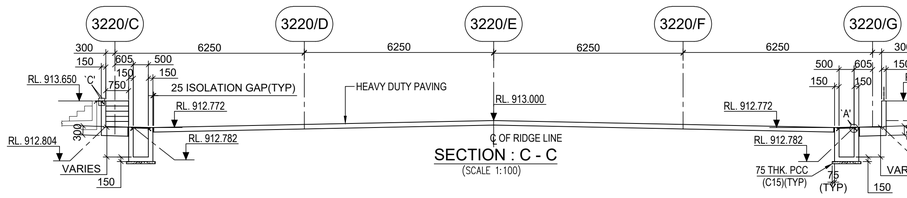

DETAIL OF INSERT PLATE - IP2
(SCALE 1:20)



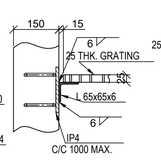

SECTION : Y - Y
(SCALE 1:20)



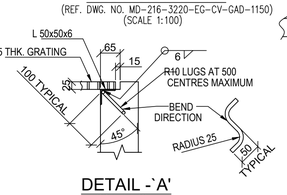

SECTION Y1 - Y1
(SCALE 1:10)



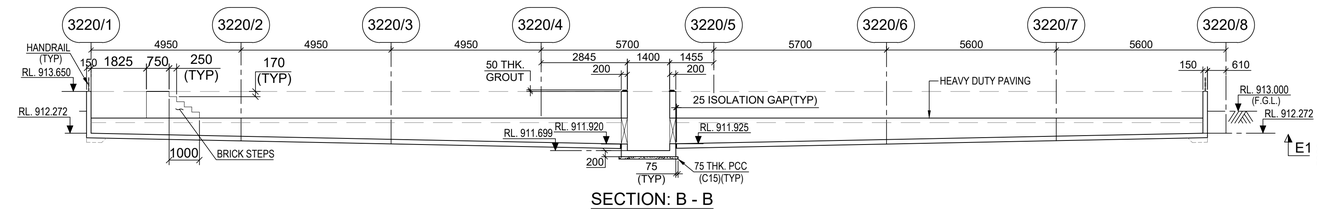

SECTION : C - C
(SCALE 1:100)



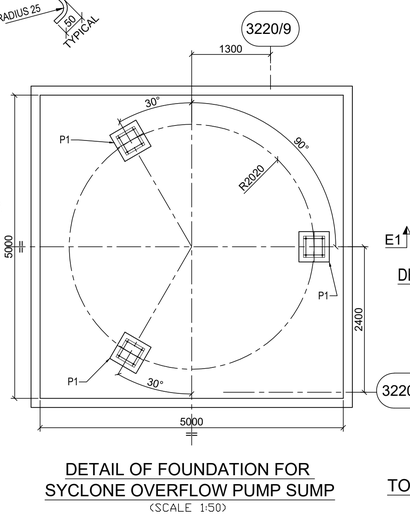

DETAIL -`B'
(SCALE 1:10)



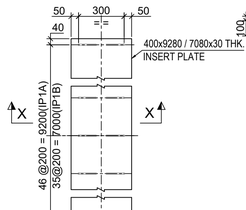

DETAIL -`A'
(SCALE 1:10)



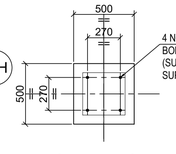

SECTION: B - B
(SCALE 1:100)



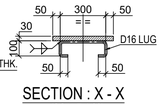

DETAIL OF FOUNDATION FOR SYCLONE OVERFLOW PUMP SUMP
(SCALE 1:50)




DETAIL OF INSERT PLATE - IP1A / IP1B
(SCALE 1:20)




TOP VIEW OF PEDESTAL MKD. P1
(SCALE-1:25)




SECTION : X - X
(SCALE 1:20)




DETAIL OF INSERT PLATE - IP4
(SCALE 1:10)

LEGEND :-
R.L. - REDUCED LEVEL
T.O.C. - TOP OF CONCRETE.
F.G.L. - FINISHED GROUND LAVAL.
TYP. - TYPICAL.
P.C.C - PLAIN CEMENT CONCRETE
MKD. - MARKED.
THK. - THICK
℄ - CENTRE LINE

NOTES:-
1. ALL DIMENSIONS ARE IN MILLIMETRES AND LEVELS ARE IN METRES UNLESS OTHERWISE STATED.
2. GRADE OF CONCRETE SHALL BE C35 UNLESS NOTED OTHERWISE.
3. GRADE OF REINFORCEMENT SHALL BE DEFORMED BAR ASTM A615-GRADE 60 (fy=420 MPa)
4. IF ANY PART OF FOUNDATION COMES ON BACKFILL ZONE OF ADJACENT FOUNDATION OR ANY LOOSE POCKETS ARE ENCOUNTERED BELOW FOUNDATION LEVEL THE SAME SHALL BE REMOVED AND FILLED WITH PCC.
5. FOR GA LAYOUT AND DETAIL GA REF. DRG. NO.MD - 216 - 3220 - EG - CV - GAD -1150. MD - 216 - 3220 - EG - CV - GAD -1153.
6. FOR REINFORCEMENTS DETAIL REF. DRG. NO. MD - 216 - 3220 - EG - CV - DED - 1156. MD - 216 - 3220 - EG - CV - DED - 1157. MD - 216 - 3220 - EG - CV - DED - 1159.
7. FOR STANDARD DETAILS FOR PAVING REF. DRG. NO : MD-216-1000-EG-CV-DED-1002.
8. FOR FOUNDATION BOLT DETAILS REF. DRG. NO : MD-216-1000-EG-CV-DED-1003.
9. FOR GENERAL NOTE FOR CIVIL WORK REF. DRG. NO : MD-216-1000-EG-CV-DED-1001.

| DOCUMENT NUMBER | REFERENCE DOCUMENTS | REV | DATE | REVISION DESCRIPTION | DRN | CHK | ENG | APP | EMP |
|---|---|---|---|---|---|---|---|---|---|
| MD-216-3220-EG-ST-GAD-2141 | BALL MILL PLATFORM PLAN AND SECTION | | | | | | | | |
| MD-216-3220-EG-ST-GAD-2140 | BALL MILL PLATFORM PLAN AND SECTION | | | | | | | | |
| MD-216-3220-EG-ME-GAD-1031 | 19-32-MRM | | | | | | | | |
| MD-216-3220-EG-GE-GAD-1076 | 3220-TANK-002 CYCLONE OVERFLOW PUMP SUMP | D01 | 16/02/2023 | AS-BUILT | SBH | BDA | SUE | AG | |
| MD-216-3220-EG-GE-GAD-1048 | 3220-TANK-001 BALL MILL DISCHARGE SUMP | C05 | 22/01/2021 | ISSUED FOR CONSTRUCTION & REVISED AS MKD. | SBH | BDA | SUE | AG | |
| MD-216-3220-EG-ME-GAD-1085 | PLAN AT EL.(+)913.000 | C04 | 11/12/2020 | ISSUED FOR CONSTRUCTION & REVISED AS MKD. | SBH | BDA | SUE | AG | |
| MD-216-3220-EG-CV-GAD-1005 | PLAN AT EL.(+)913.000 - GRID G-J/7-10 | C03 | 21/09/2020 | ISSUED FOR CONSTRUCTION | SBH | BDA | SUE | AG | |
| MD-216-3220-EG-CV-GAD-1003 | PLAN AT EL.(+)913.000 - GRID C-G/8-11 | C02 | 29/08/2020 | ISSUED FOR APPROVAL & REVISED AS MKD. | SBH | BDA | SUE | AG | |
| MD-216-3220-EG-CV-GAD-1002 | SECTION A-A TO H-H & EQUIP. FOUNDATION | C01 | 08/05/2020 | ISSUED FOR CONSTRUCTION | SBH | BDA | SUE | AG | |
| MD-216-3220-EG-CV-GAD-1001 | PLAN AT EL.(+)913.000 - GRID C-G/1-8 | A01 | 08/04/2020 | ISSUED FOR REFERENCE | SBH | BDA | SUE | AG | |

RESERVED FOR VENDOR LOGO AND DRAWING NUMBER

LARSEN & TOUBRO DRAWING NUMBER: 019045_450_C_G_24077_007 — REVISION: 6
OUTOTEC DRAWING NUMBER: 900707__GAU01__ZG01__MTL01__32245 — DOCUMENT ID: OU100676721 — REVISION: 6

LARSEN & TOUBRO
This drawing is the property of LARSEN & TOUBRO and must not be passed on to any person or body not authorized by us to receive it nor be copied or otherwise made use either in full or in part by such person or body without our prior permission in writing.

Outotec
The content of these documents are the sole property of Outotec Oyj. Any rights not expressly granted herein are reserved. Reproduction, transfer or distribution of part or all of the contents in any form without prior written permission of Outotec is prohibited.

MA'ADEN معادن
Saudi Arabian Mining Company شركة معادن العربية السعودية
This document and the information contained herein is Ma'aden proprietary know-how. This document or any part thereof should not be reproduced, stored in a retrieval system or transmitted by any means, electronic or otherwise, or divulged without prior written permission of Ma'aden.

| | | | |
|---|---|---|---|
| DRAWN | SBH | 06/04/2020 | MANSOURAH - MASSARAH GOLD PROJECT |
| CHECKED | BDA | 07/04/2020 | GENERAL ARRANGEMENT |
| ENGINEER | SUE | 06/04/2020 | GRINDING AND CLASSIFICATION-BALL MILL |
| APPROVED | AG | 08/04/2020 | GRADE SLAB DETAILS |
| EMPLOYER | | | |
| SCALE 1:30 | | A1 | DRAWING NUMBER: MD - 216 - 3220 - EG - CV - GAD - 1151 — REV: D01 |