


DRAWING NUMBER: MD - 216 - 3220 - EG - CV - GAD - 1152
REV: D01

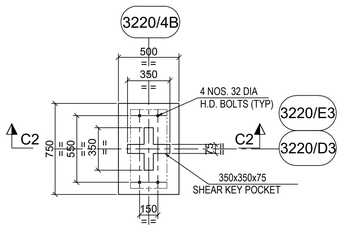


DETAIL OF COLUMN
MKD. - C7
(SCALE-1:25)

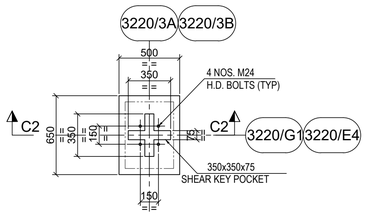


DETAIL OF COLUMN
MKD. - C4
(SCALE-1:25)

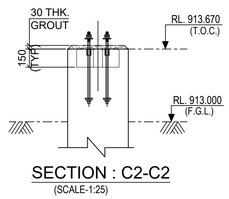


SECTION : C2-C2
(SCALE-1:25)

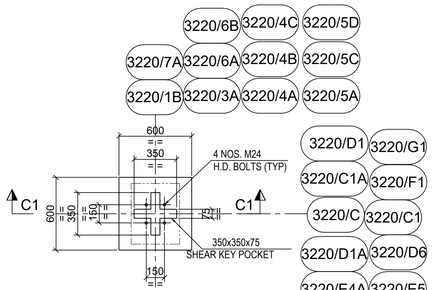


DETAIL OF COLUMN
MKD. - C6
(SCALE-1:25)

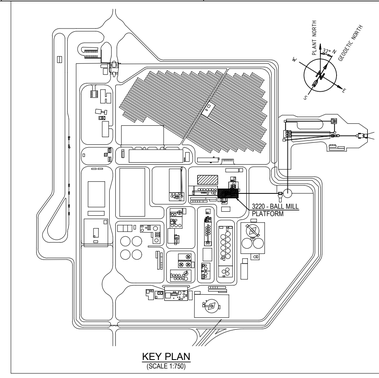


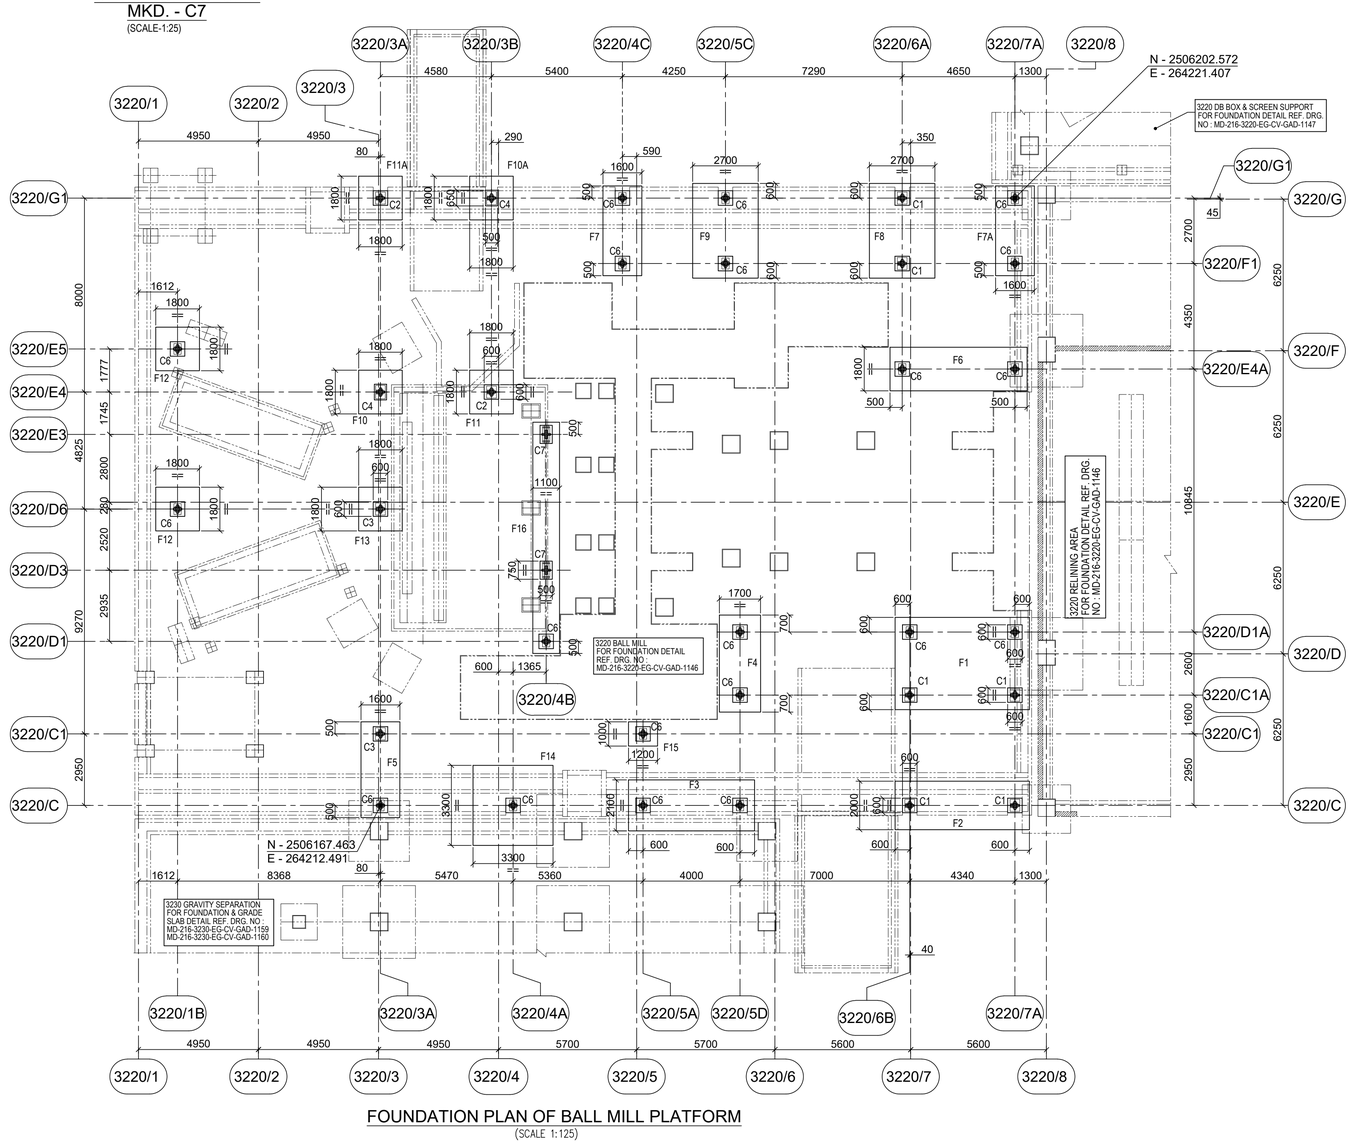


FOUNDATION PLAN OF BALL MILL PLATFORM
(SCALE 1:125)

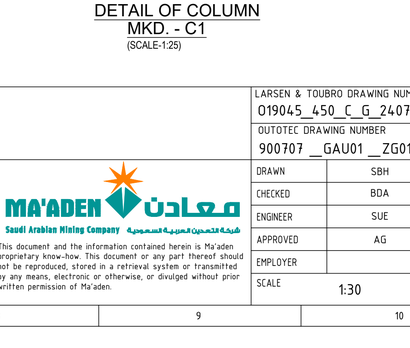


DETAIL OF COLUMN
MKD. - C2
(SCALE-1:25)

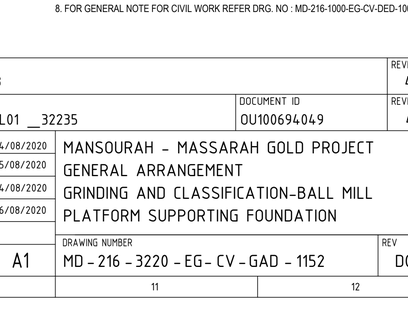

DETAIL OF COLUMN
MKD. - C3
(SCALE-1:25)

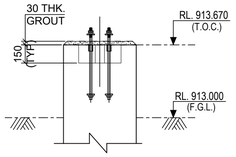

SECTION : C1-C1
(SCALE-1:25)

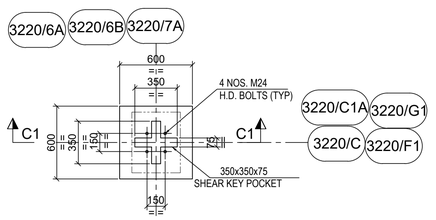

DETAIL OF COLUMN
MKD. - C1
(SCALE-1:25)

LEGEND :-

R.L. - REDUCED LEVEL
T.O.C. - TOP OF CONCRETE.
F.G.L. - FINISHED GROUND LEVEL.
TYP. - TYPICAL.
P.C.C - PLAIN CEMENT CONCRETE
MKD. - MARKED.
THK. - THICK
℄ - CENTRE LINE

NOTES:-

1. ALL DIMENSIONS ARE IN MILLIMETRES AND LEVELS ARE IN METRES UNLESS OTHERWISE STATED.
2. GRADE OF CONCRETE SHALL BE C35 UNLESS NOTED OTHERWISE.
3. GRADE OF REINFORCEMENT SHALL BE DEFORMED BAR ASTM A615-GRADE 60 (fy=420 MPa)
4. NET SAFE BEARING CAPACITY OF SOIL AT BOTTOM OF FOUNDATION CONSIDERED 670KN/SQ.M.
5. IF ANY PART OF FOUNDATION COMES ON BACKFILL ZONE OF ADJACENT FOUNDATION OR ANY LOOSE POCKETS ARE ENCOUNTERED BELOW FOUNDATION LEVEL THE SAME SHALL BE REMOVED AND FILLED WITH PCC.
6. FOR REINFORCEMENTS DETAIL REFER DRG. NO. MD - 216 - 3220 - EG - CV - DED - 1158.
7. FOR FOUNDATION BOLT DETAILS REFER DRG. NO : MD-216-1000-EG-CV-DED-1003.
8. FOR GENERAL NOTE FOR CIVIL WORK REFER DRG. NO : MD-216-1000-EG-CV-DED-1001.

DOCUMENT NUMBER	REFERENCE DOCUMENTS	REV	DATE	REVISION DESCRIPTION	DRN	CHK	ENG	APP	EMP
		D01	16/02/2023	AS-BUILT	APM	BDA	SUE	AG	
		C03	04/01/2021	ISSUED FOR CONSTRUCTION & REVISED AS MKD.	SBH	BDA	SUE	AG	
		C02	23/11/2020	ISSUED FOR CONSTRUCTION & REVISED AS MKD.	SBH	BDA	SUE	AG	
MD-216-3220-EG-ST-GAD-2141	BALL MILL PLATFORM PLAN & SECTIONS	C01	02/09/2020	ISSUED FOR CONSTRUCTION	SBH	BDA	SUE	AG	
MD-216-3220-EG-ST-GAD-2140	BALL MILL PLATFORM PLAN & SECTIONS	A01	06/08/2020	ISSUED FOR REFERENCE	SBH	BDA	SUE	AG	

RESERVED FOR VENDOR LOGO AND DRAWING NUMBER

LARSEN & TOUBRO

This drawing is the property of LARSEN & TOUBRO and must not be passed on to any person or body not authorized by us to receive it nor be copied or otherwise made use either in full or in part by such person or body without our prior permission in writing.

Outotec

The content of these documents are the sole property of Outotec Oyj. Any rights not expressly granted herein are reserved. Reproduction, transfer or distribution of part or all of the contents in any form without prior written permission of Outotec is prohibited.

MA'ADEN معادن
Saudi Arabian Mining Company شركة معادن العربية السعودية

This document and the information contained herein is Ma'aden proprietary know-how. This document or any part thereof should not be reproduced, stored in a retrieval system or transmitted by any means, electronic or otherwise, or divulged without prior written permission of Ma'aden.

LARSEN & TOUBRO DRAWING NUMBER	019045_450_C_G_24077_008		REVISION 4
OUTOTEC DRAWING NUMBER	900707__GAU01__ZG01__MTL01__32235	DOCUMENT ID OU100694049	REVISION 4

DRAWN	SBH	04/08/2020
CHECKED	BDA	05/08/2020
ENGINEER	SUE	04/08/2020
APPROVED	AG	06/08/2020
EMPLOYER		
SCALE	1:30	A1

MANSOURAH - MASSARAH GOLD PROJECT
GENERAL ARRANGEMENT
GRINDING AND CLASSIFICATION-BALL MILL
PLATFORM SUPPORTING FOUNDATION

DRAWING NUMBER: MD - 216 - 3220 - EG - CV - GAD - 1152
REV: D01