


DRAWING NUMBER MD - 216 - 3220 - EG - CV - GAD - 1153 REV D01

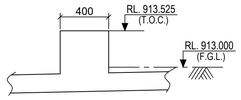


DETAIL OF PEDESTAL MKD. P101
(SCALE 1:25)

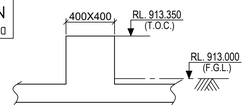


DETAIL OF PEDESTAL MKD. P104
(SCALE 1:25)

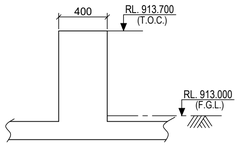


DETAIL OF PEDESTAL MKD. P107
(SCALE 1:25)

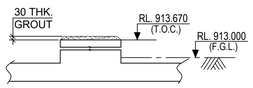


DETAIL OF PEDESTAL MKD. P112
(SCALE 1:25)

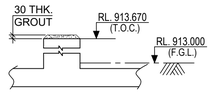

DETAIL OF PEDESTAL MKD. P113
(SCALE 1:25)

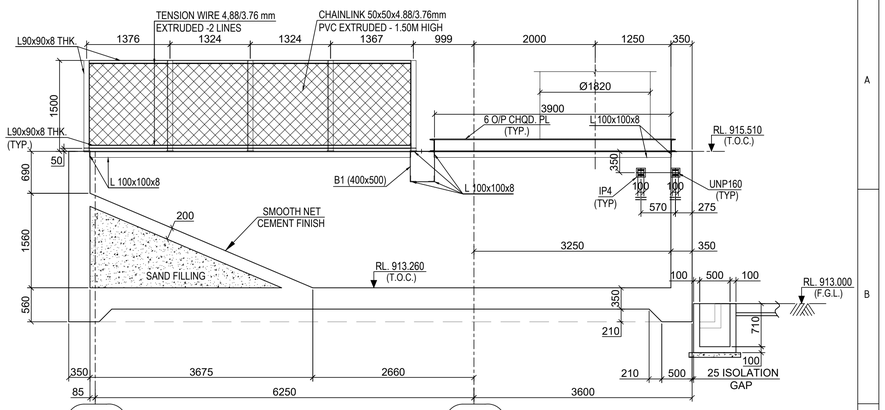


SECTION : F3 - F3
(REF. DWG. NO. MD-216-3220-EG-CV-GAD-1150)
(SCALE 1:50)

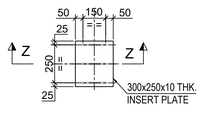


SECTION : Z - Z
(SCALE 1:20)


DETAIL OF INSERT PLATE - IP3
(SCALE 1:20)

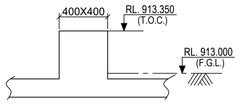


DETAIL OF PEDESTAL MKD. P103
(SCALE 1:25)

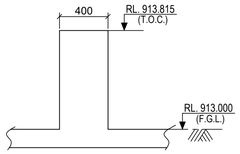

DETAIL OF PEDESTAL MKD. P106
(SCALE 1:25)

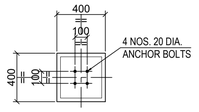


TOP VIEW OF PEDESTAL MKD. P110
(SCALE-1:25)

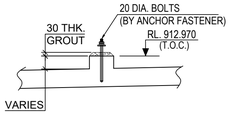


DETAIL OF PEDESTAL MKD. P111
(SCALE 1:25)


DETAIL OF PEDESTAL MKD. P102
(SCALE 1:25)

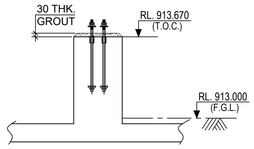


DETAIL OF PEDESTAL MKD. P110
(SCALE 1:25)

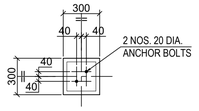


TOP VIEW OF PEDESTAL MKD. P109
(SCALE-1:25)

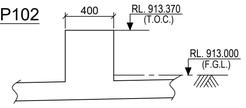


DETAIL OF PEDESTAL MKD. P105
(SCALE 1:25)

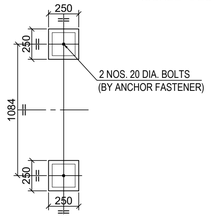


TOP VIEW OF PEDESTAL MKD. P108
(SCALE-1:25)

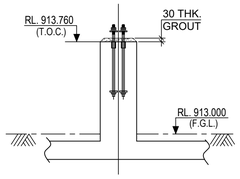


DETAIL OF PEDESTAL MKD. P109
(SCALE 1:25)

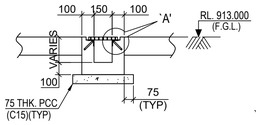

TYPICAL SECTION : F5 - F5
(REF. DWG. NO. MD-216-3220-EG-CV-GAD-1150)
(SCALE 1:25)

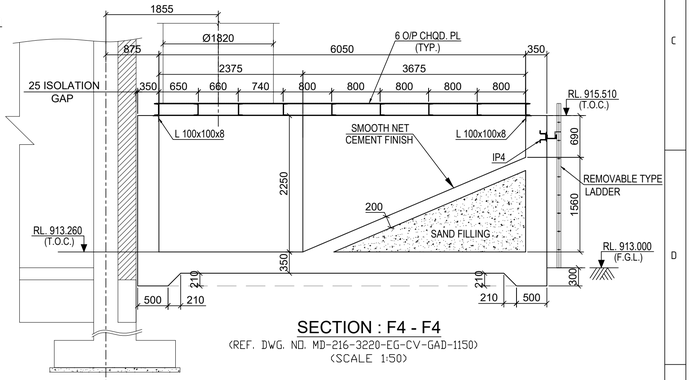


SECTION : F4 - F4
(REF. DWG. NO. MD-216-3220-EG-CV-GAD-1150)
(SCALE 1:50)

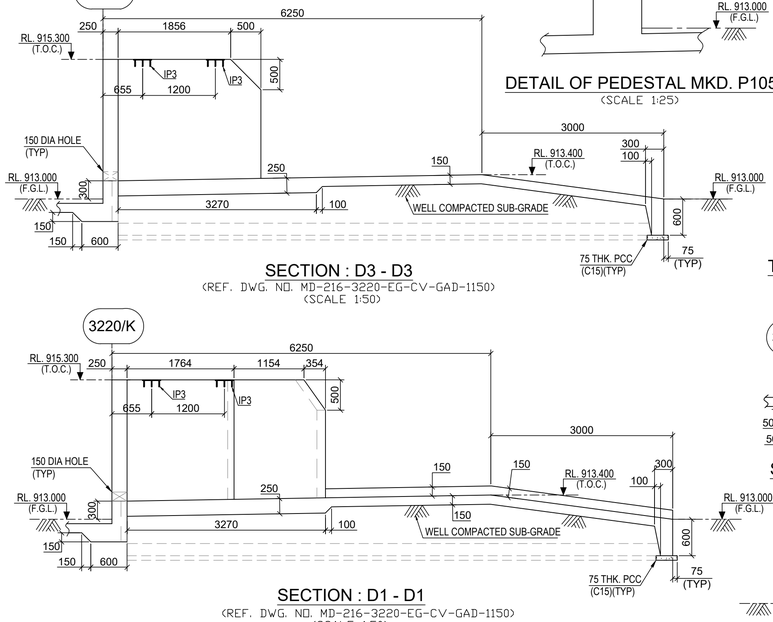


SECTION : D3 - D3
(REF. DWG. NO. MD-216-3220-EG-CV-GAD-1150)
(SCALE 1:50)


SECTION : D1 - D1
(REF. DWG. NO. MD-216-3220-EG-CV-GAD-1150)
(SCALE 1:50)

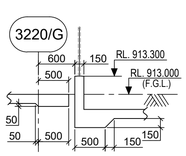


SECTION : D2 - D2
(SCALE 1:50)

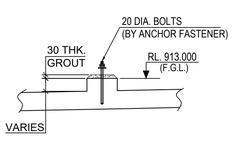


DETAIL OF PEDESTAL MKD. P108
(SCALE 1:25)

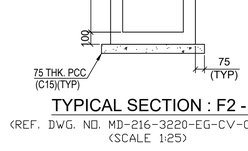


TYPICAL SECTION : F2 - F2
(REF. DWG. NO. MD-216-3220-EG-CV-GAD-1150)
(SCALE 1:25)

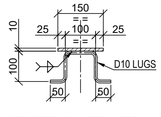


SECTION F6 - F6
(SCALE 1:10)

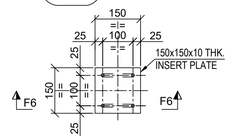


DETAIL OF INSERT PLATE - IP4
(SCALE 1:10)

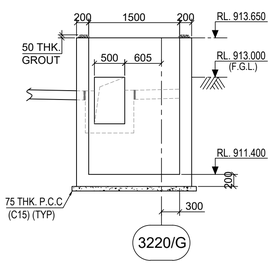


SECTION : A1 - A1
(SCALE 1:50)

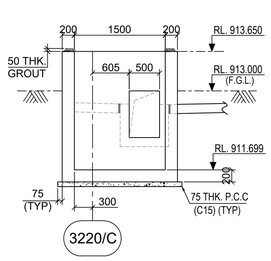


SECTION : A2 - A2
(SCALE 1:50)

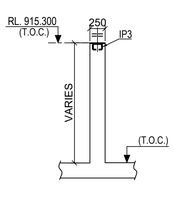


SECTION : D6 - D6
(SCALE 1:50)

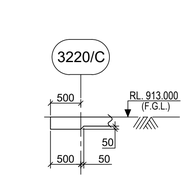


SECTION : F1 - F1
(SCALE 1:50)

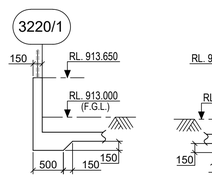


SECTION : A8 - A8
(SCALE 1:50)

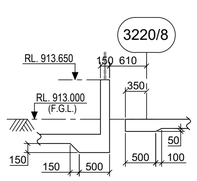


SECTION : A9 - A9
(SCALE 1:50)

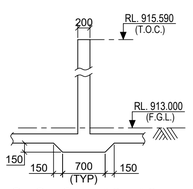

SECTION : A3 - A3
(SCALE 1:50)

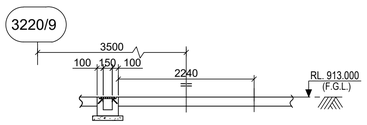

DETAIL OF PEDESTAL MKD. P49 & P50
(SCALE 1:50)

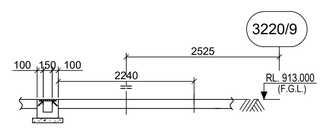

DETAIL OF PEDESTAL MKD. P48
(SCALE 1:50)

LEGEND :-

R.L. - REDUCED LEVEL
T.O.C. - TOP OF CONCRETE.
F.G.L. - FINISHED GROUND LAVAL.
TYP. - TYPICAL.
P.C.C - PLAIN CEMENT CONCRETE
MKD. - MARKED.
THK. - THICK
℄ - CENTRE LINE

NOTES:-

1. ALL DIMENSIONS ARE IN MILLIMETRES AND LEVELS ARE IN METRES UNLESS OTHERWISE STATED.
2. GRADE OF CONCRETE SHALL BE C35 UNLESS NOTED OTHERWISE.
3. GRADE OF REINFORCEMENT SHALL BE DEFORMED BAR ASTM A615-GRADE 60 (fy=420 MPa)
4. IF ANY PART OF FOUNDATION COMES ON BACKFILL ZONE OF ADJACENT FOUNDATION OR ANY LOOSE POCKETS ARE ENCOUNTERED BELOW FOUNDATION LEVEL THE SAME SHALL BE REMOVED AND FILLED WITH PCC.
5. FOR GA LAYOUT AND DETAIL GA REF. DRG. NO.MD - 216 - 3220 - EG - CV - GAD -1150. MD - 216 - 3220 - EG - CV - GAD -1151.
6. FOR REINFORCEMENTS DETAIL REF. DRG. NO. MD - 216 - 3220 - EG - CV - DED - 1156. MD - 216 - 3220 - EG - CV - DED - 1157. MD - 216 - 3220 - EG - CV - DED - 1159.
7. FOR STANDARD DETAILS FOR PAVING REF. DRG. NO : MD-216-1000-EG-CV-DED-1002.
8. FOR FOUNDATION BOLT DETAILS REF. DRG. NO : MD-216-1000-EG-CV-DED-1003.
9. FOR GENERAL NOTE FOR CIVIL WORK REF. DRG. NO : MD-216-1000-EG-CV-DED-1001.

DOCUMENT NUMBER	REFERENCE DOCUMENTS	REV	DATE	REVISION DESCRIPTION	DRN	CHK	ENG	APP	EMP
MD-216-3220-EG-ST-GAD-2141	BALL MILL PLATFORM PLAN AND SECTION								
MD-216-3220-EG-ST-GAD-2140	BALL MILL PLATFORM PLAN AND SECTION								
MD-216-3220-EG-ME-GAD-1031	19-32-MRM								
MD-216-3220-EG-GE-GAD-1076	3220-TANK-002 CYCLONE OVERFLOW PUMP SUMP	D01	16/02/2023	AS-BUILT	APM	BDA	SUE	AG	
MD-216-3220-EG-GE-GAD-1048	3220-TANK-001 BALL MILL DISCHARGE SUMP	C05	04/10/2021	ISSUED FOR CONSTRUCTION & REVISED AS MKD.	APM	BDA	SUE	AG	
MD-216-3220-EG-ME-GAD-1085	PLAN AT EL.(+)913.000	C04	24/02/2021	ISSUED FOR CONSTRUCTION & REVISED AS MKD.	SBH	BDA	SUE	AG	
MD-216-3220-EG-CV-GAD-1005	PLAN AT EL.(+)913.000 - GRID G-J/7-10	C03	22/01/2021	ISSUED FOR CONSTRUCTION & REVISED AS MKD.	SBH	BDA	SUE	AG	
MD-216-3220-EG-CV-GAD-1003	PLAN AT EL.(+)913.000 - GRID C-G/8-11	C02	11/12/2020	ISSUED FOR CONSTRUCTION & REVISED AS MKD.	SBH	BDA	SUE	AG	
MD-216-3220-EG-CV-GAD-1002	SECTION A-A TO H-H & EQUIP. FOUNDATION	C01	21/09/2020	ISSUED FOR CONSTRUCTION & REVISED AS MKD.	SBH	BDA	SUE	AG	
MD-216-3220-EG-CV-GAD-1001	PLAN AT EL.(+)913.000 - GRID C-G/1-8	A01	29/08/2020	ISSUED FOR REFERENCE	SBH	BDA	SUE	AG	

RESERVED FOR VENDOR LOGO AND DRAWING NUMBER

LARSEN & TOUBRO DRAWING NUMBER: 019045_450_C_G_24077_009 — REVISION: 6
OUTOTEC DRAWING NUMBER: 900707__GAU01__ZG01__MTL01__32259 — DOCUMENT ID: OU100695245 — REVISION: 6

LARSEN & TOUBRO
This drawing is the property of LARSEN & TOUBRO and must not be passed on to any person or body not authorized by us to receive it nor be copied or otherwise made use either in full or in part by such person or body without our prior permission in writing.

Outotec
The content of these documents are the sole property of Outotec Oyj. Any rights not expressly granted herein are reserved. Reproduction, transfer or distribution of part or all of the contents in any form without prior written permission of Outotec is prohibited.

MA'ADEN معادن
Saudi Arabian Mining Company شركة المعادن العربية السعودية
This document and the information contained herein is Ma'aden proprietary know-how. This document or any part thereof should not be reproduced, stored in a retrieval system or transmitted by any means, electronic or otherwise, or divulged without prior written permission of Ma'aden.

DRAWN	SBH	26/08/2020	MANSOURAH - MASSARAH GOLD PROJECT
CHECKED	BDA	28/08/2020	GENERAL ARRANGEMENT
ENGINEER	SUE	26/08/2020	GRINDING AND CLASSIFICATION-BALL MILL
APPROVED	AG	29/08/2020	GRADE SLAB DETAILS
EMPLOYER			
SCALE	1:30	A1	

DRAWING NUMBER: MD - 216 - 3220 - EG - CV - GAD - 1153 — REV: D01