MD-216-3220-EG-CV-GAD-1154
DRAWING NUMBER
REV
D01

CONCRETE INFORMATION

Concretes used	C35
Concrete cover 1	50±10mm

COOLING WATER FOUNDATIONS
1:50

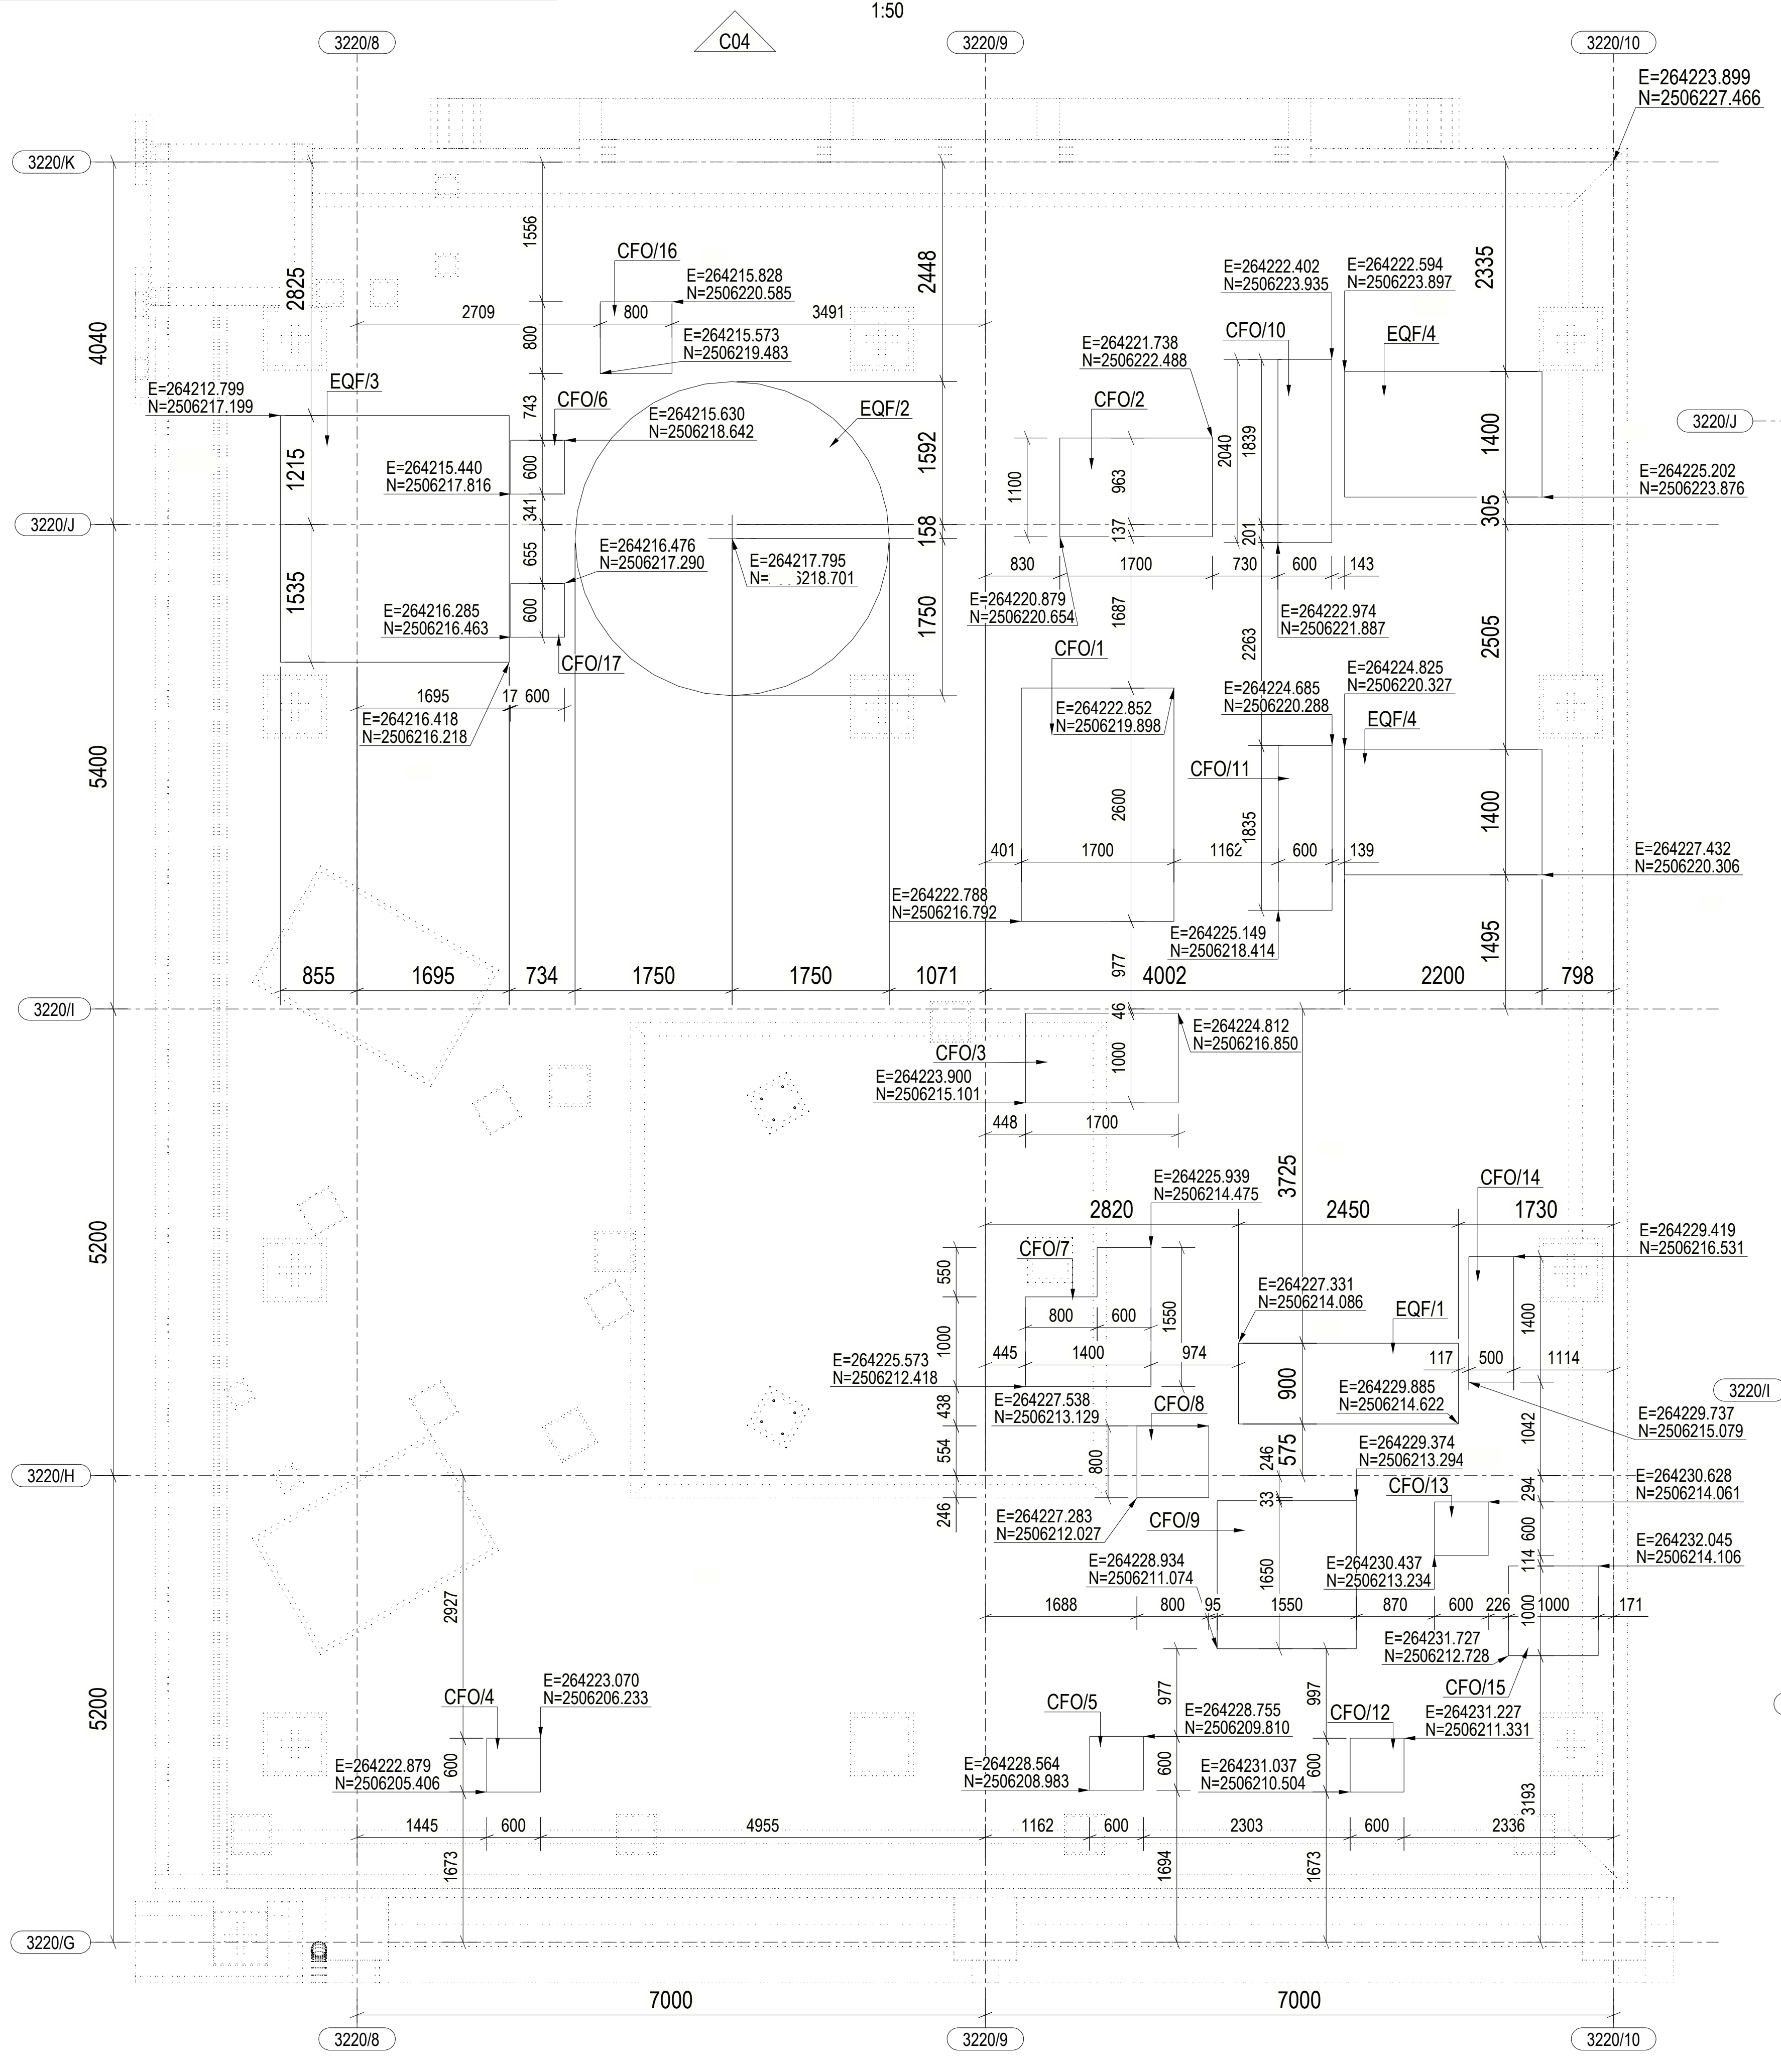

HEAT EXCHANGERS AND PIPELINE SUPPORTS FOUNDATIONS
1:25

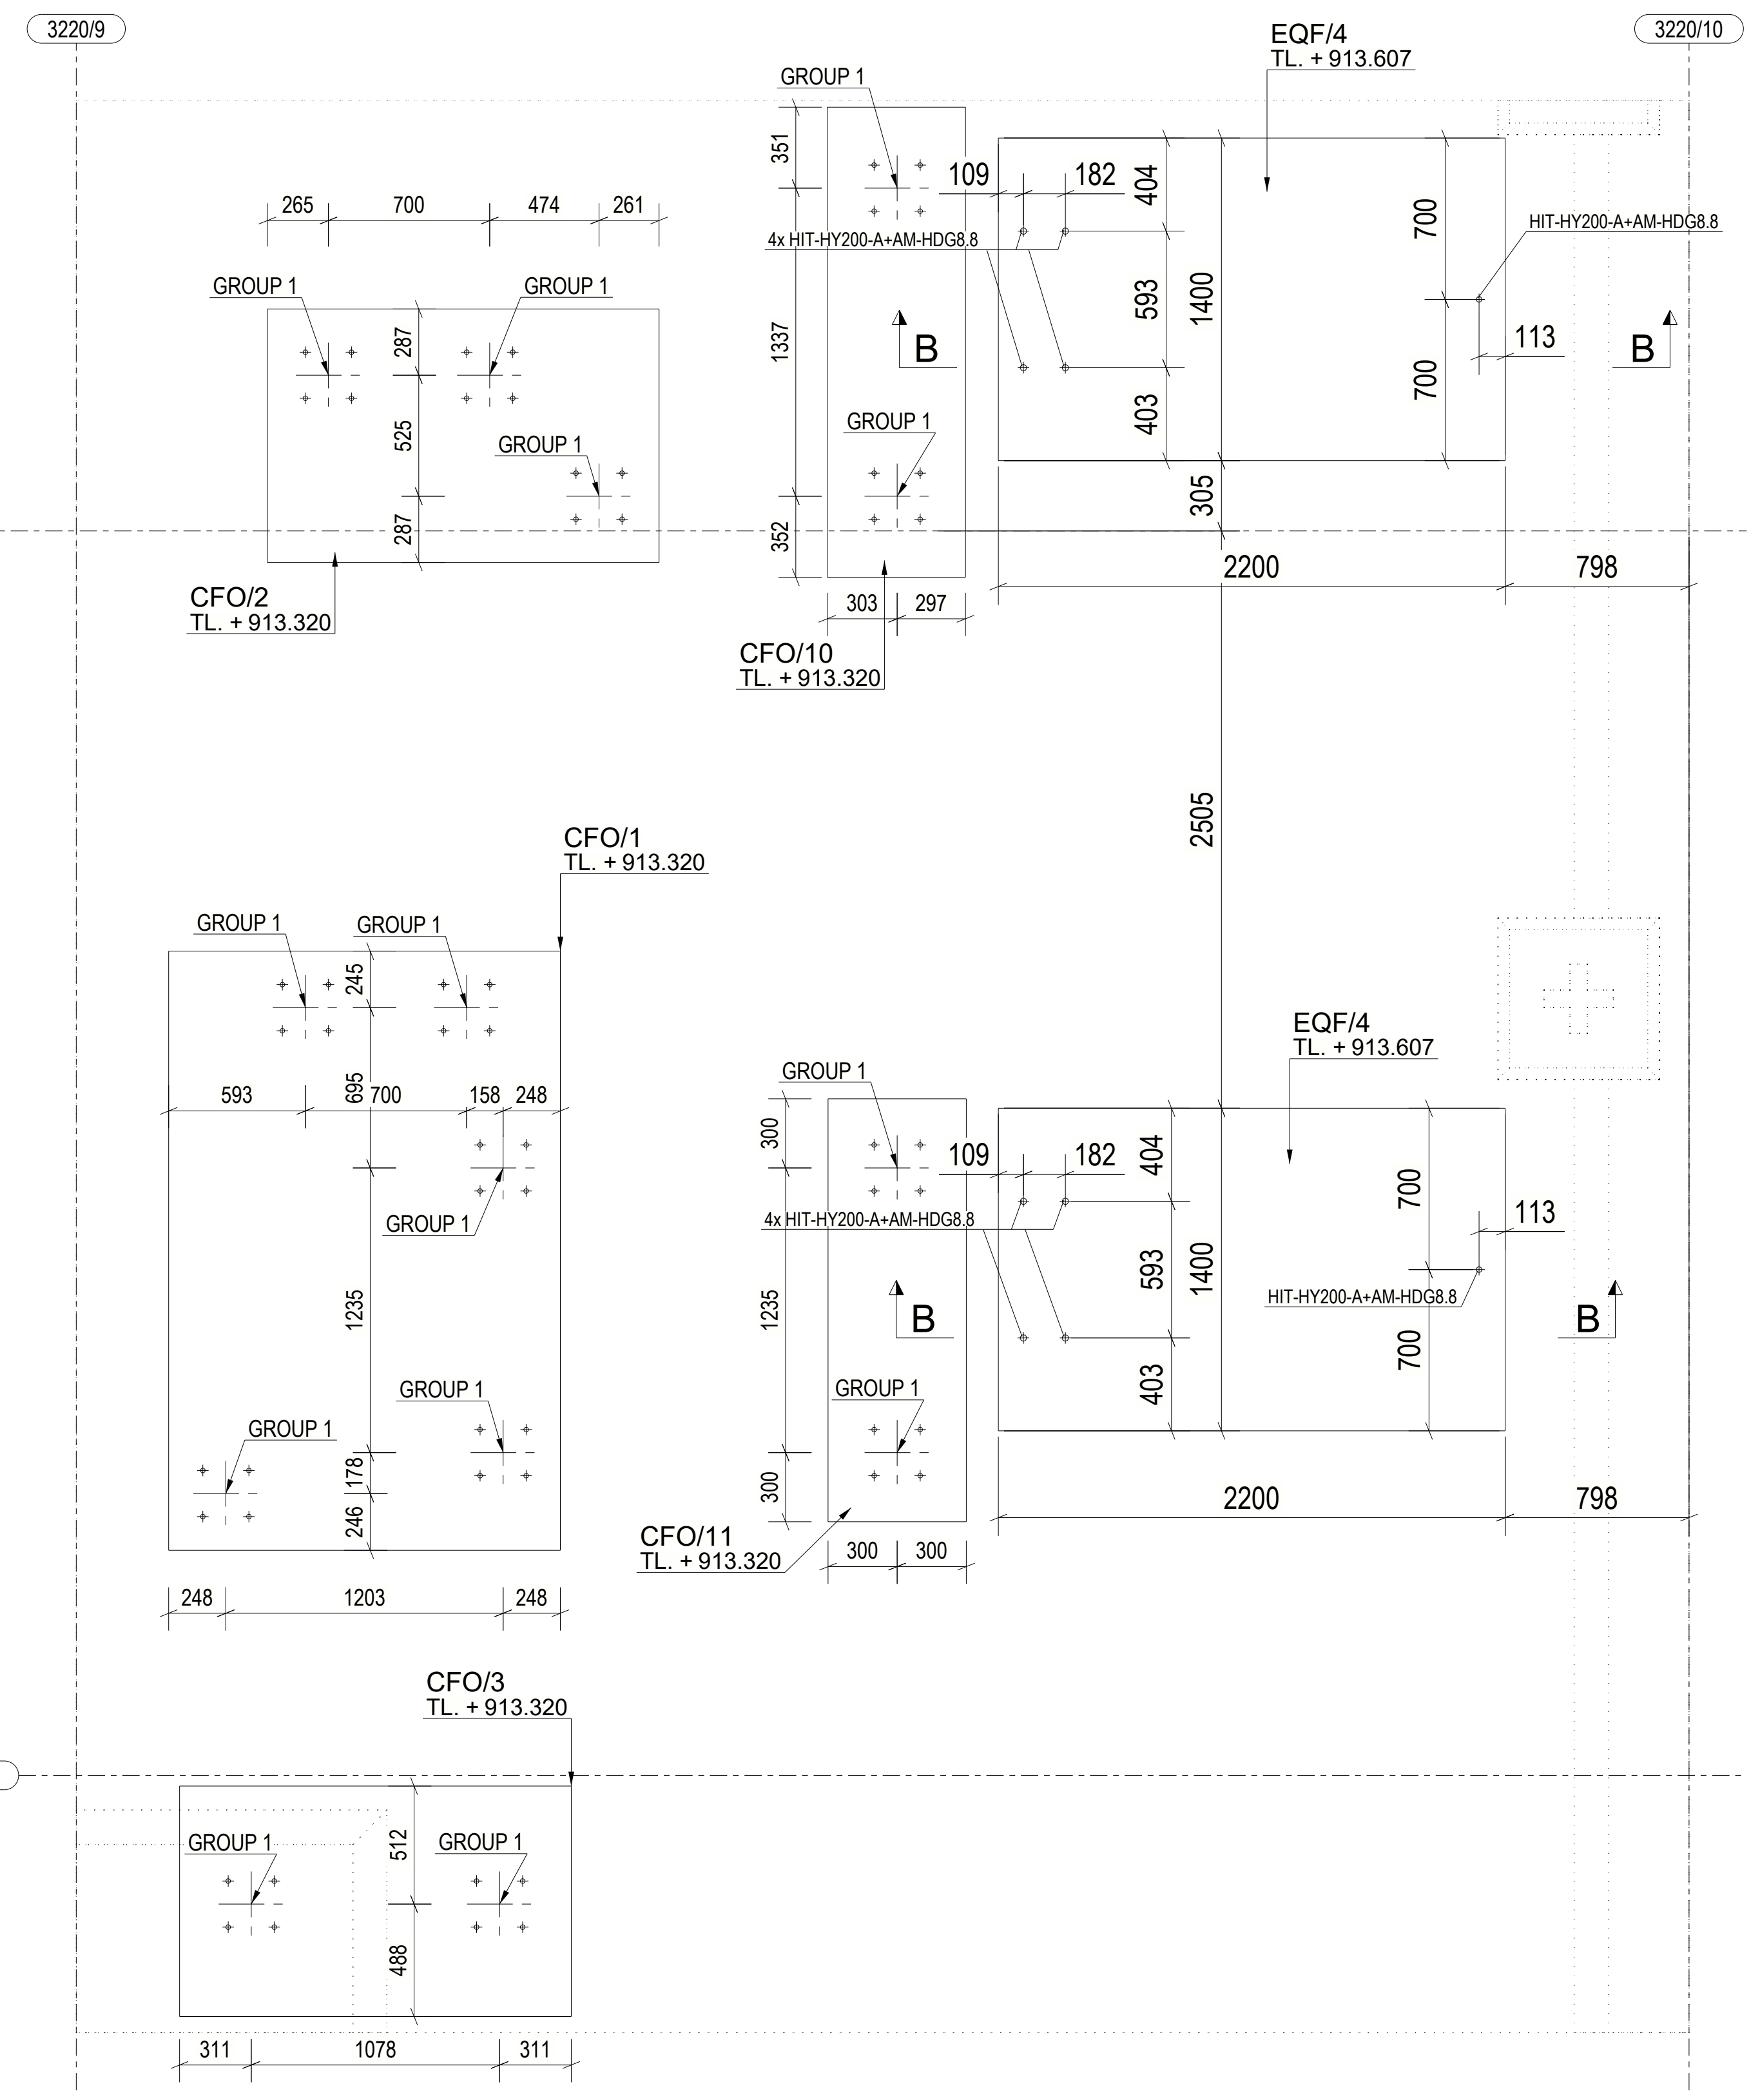

PUMPS, WATER TANK AND PIPELINE SUPPORTS FOUNDATIONS
1:25

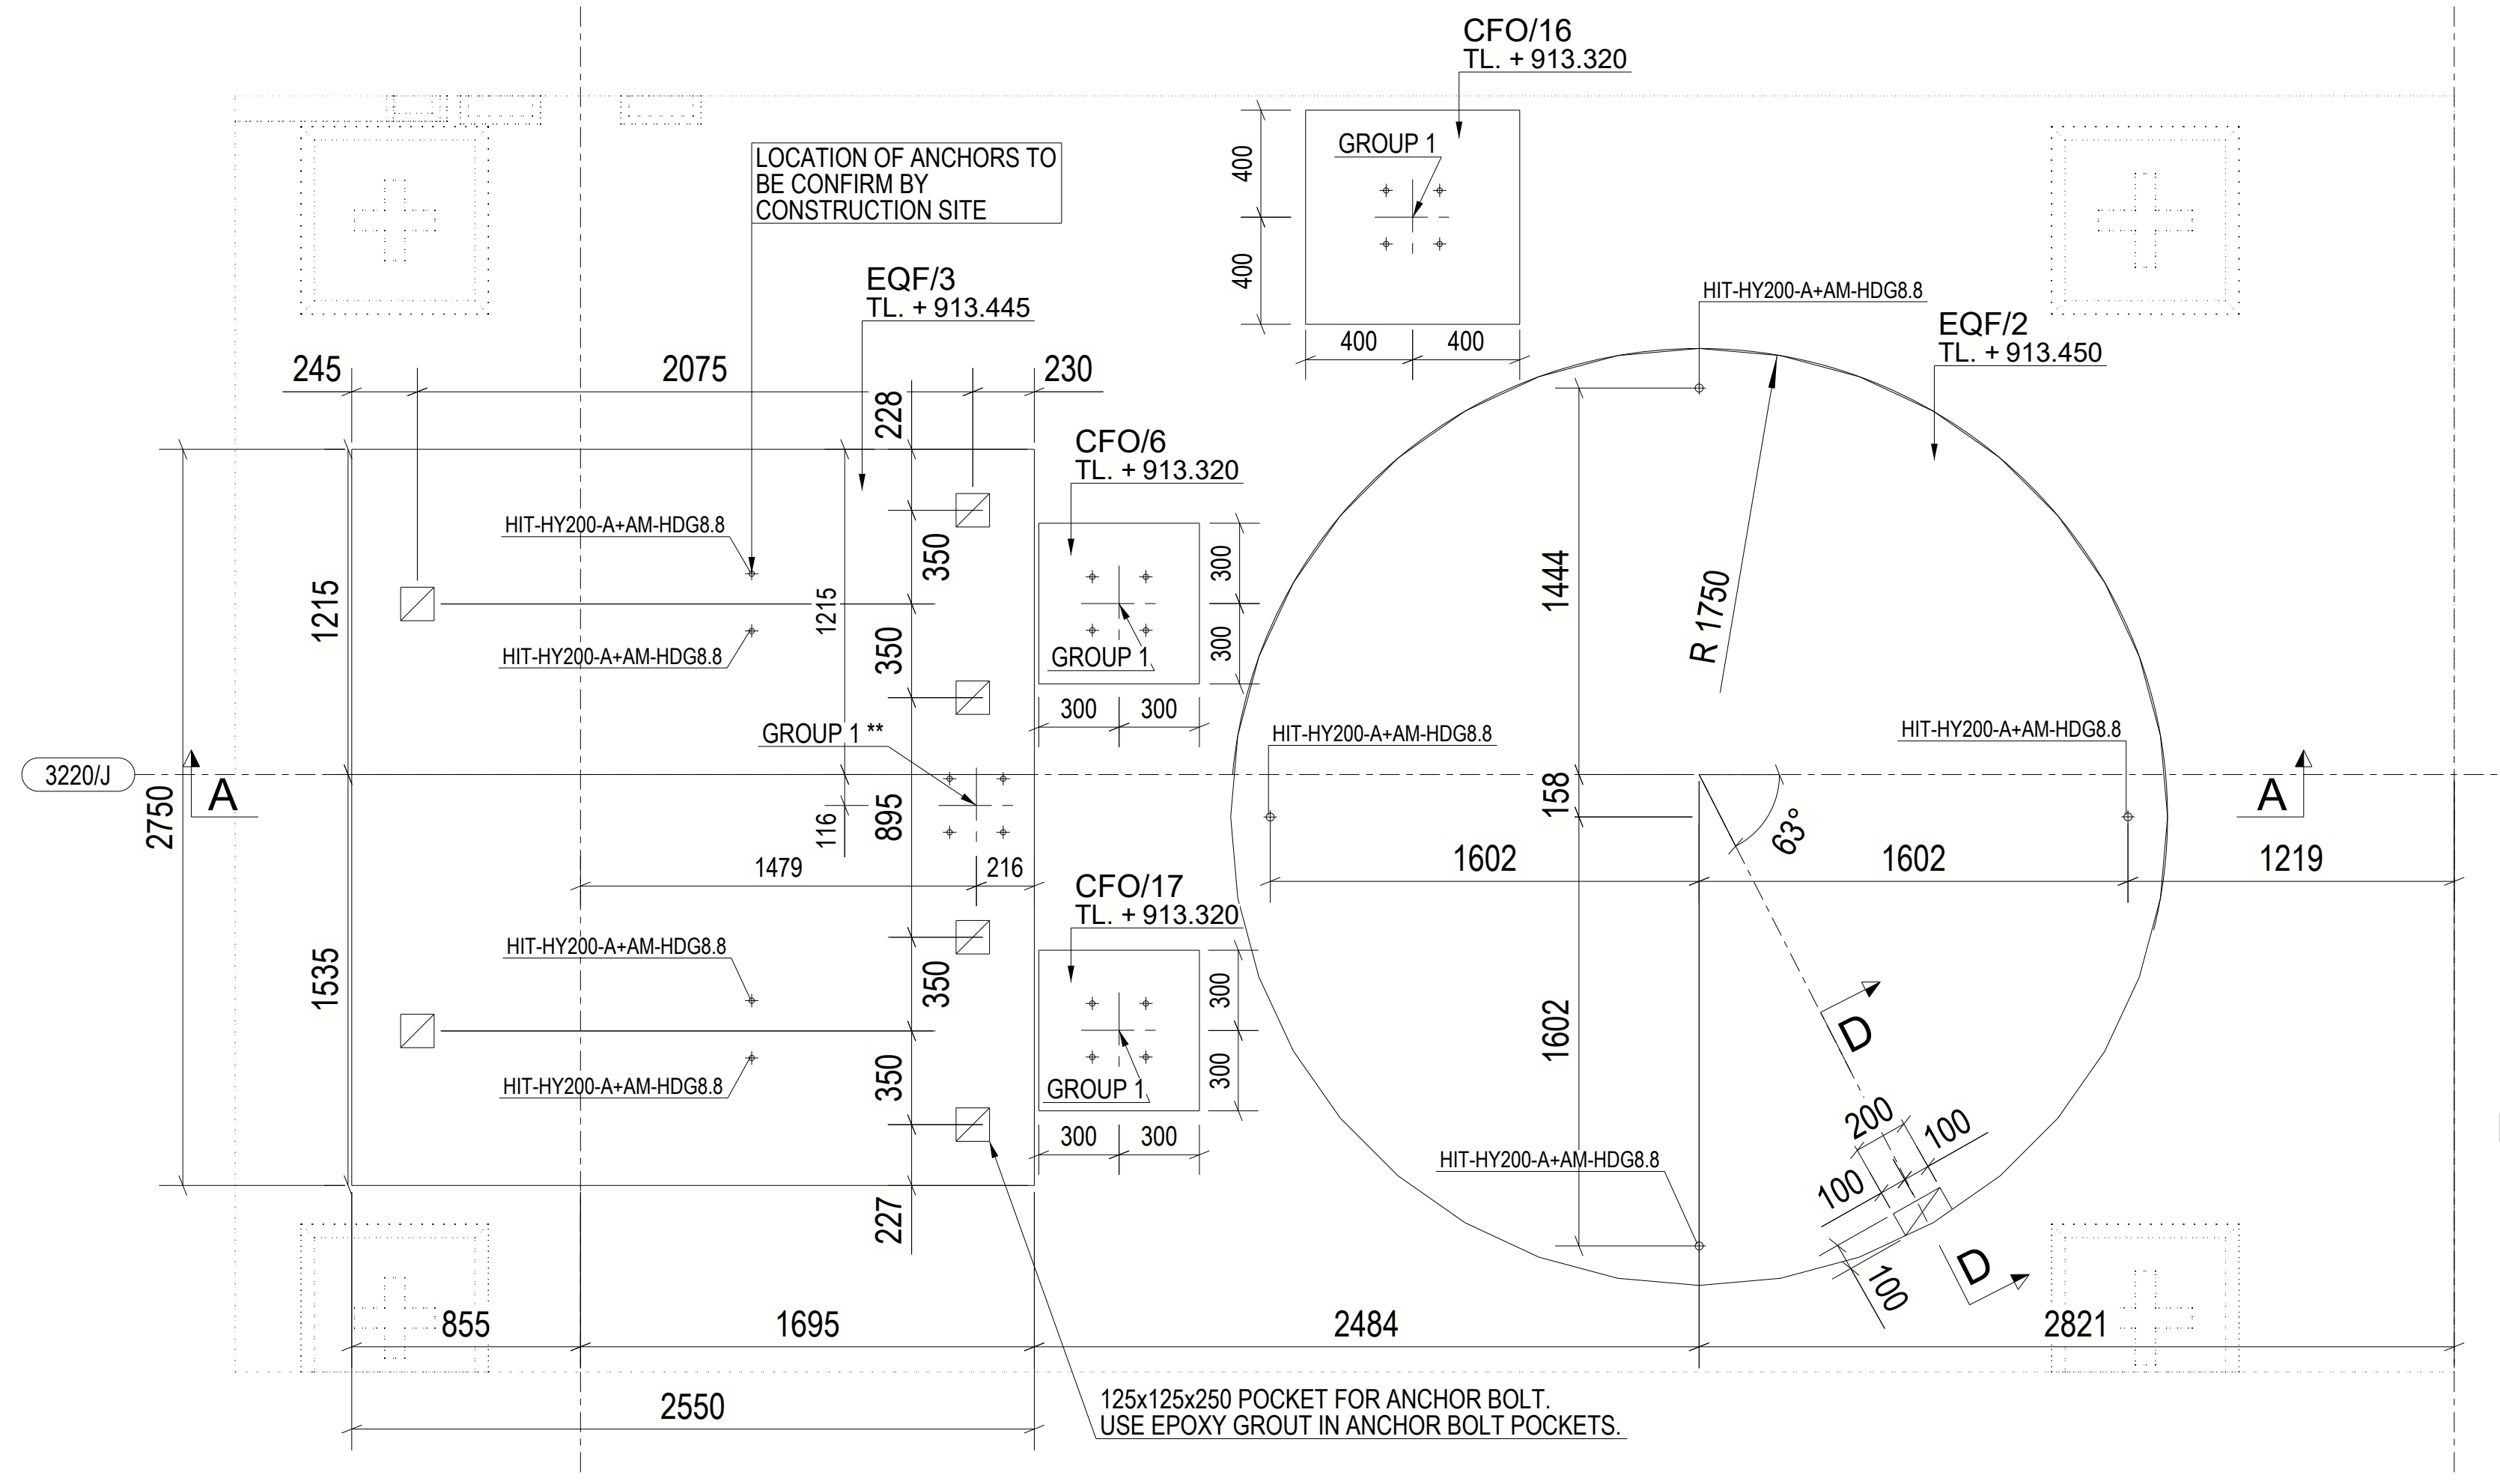

SEPARATORS AND PIPELINE SUPPORTS FOUNDATION
1:25

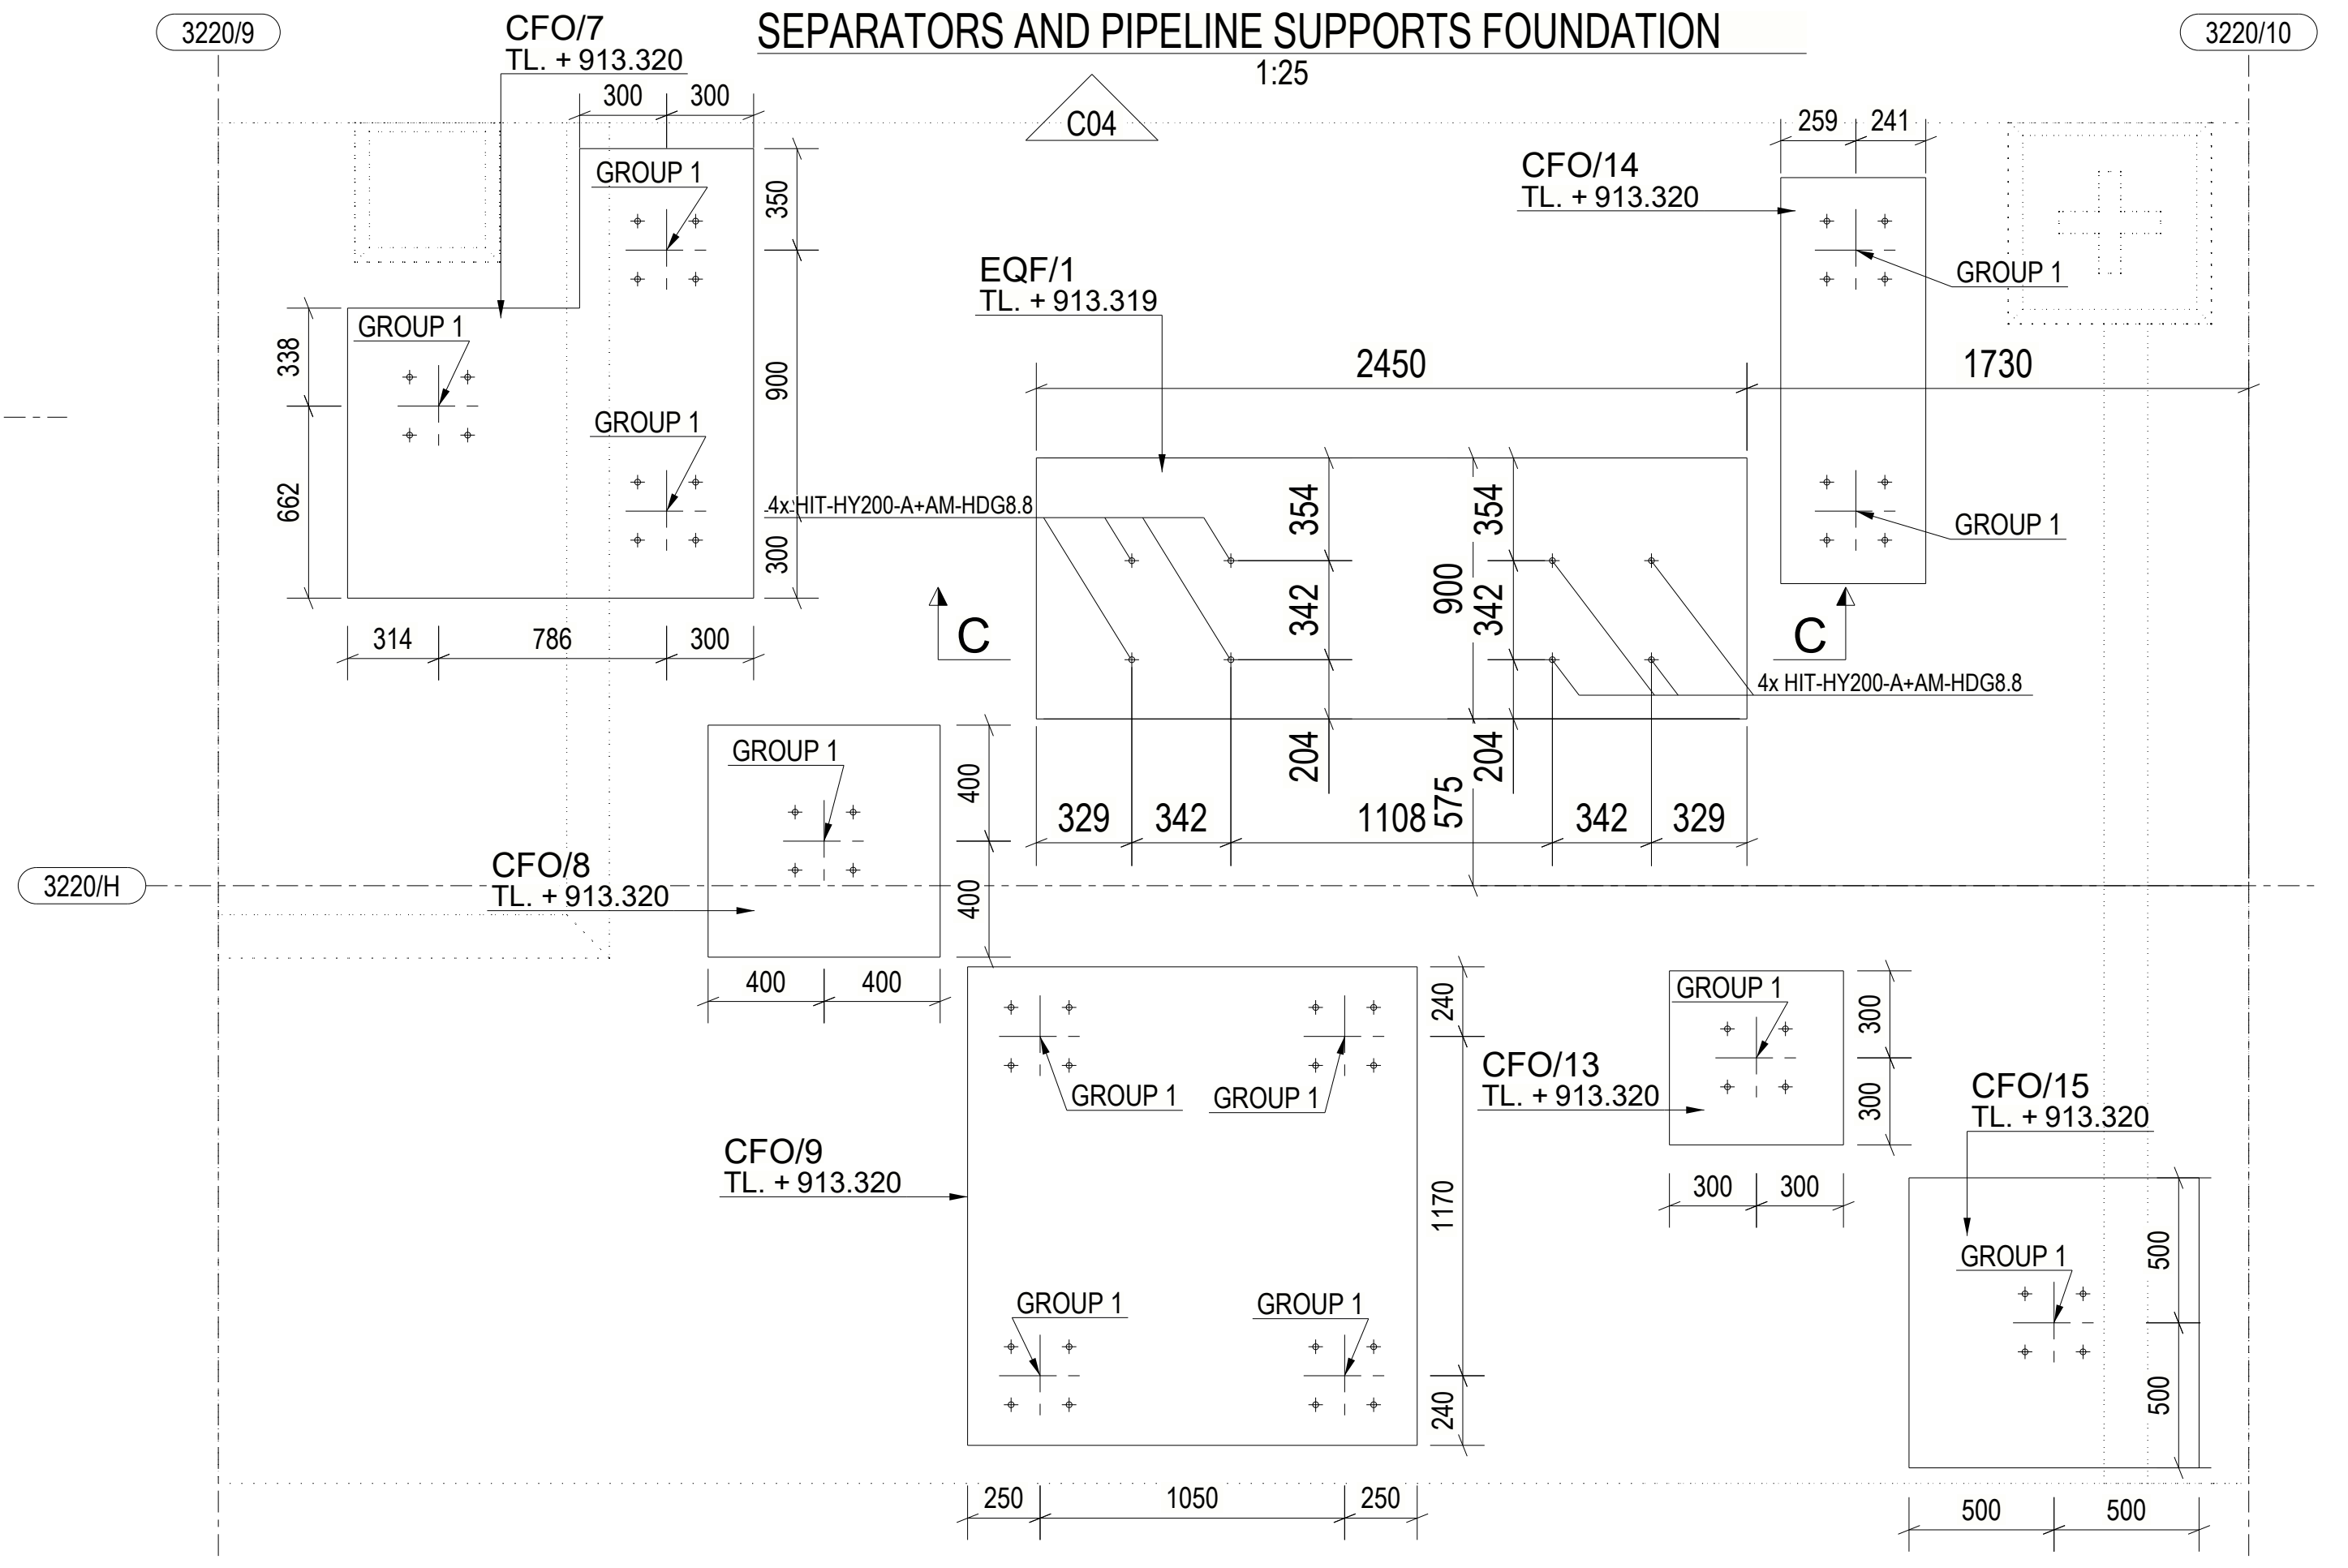

SECTION : A - A
(SCALE 1:25)

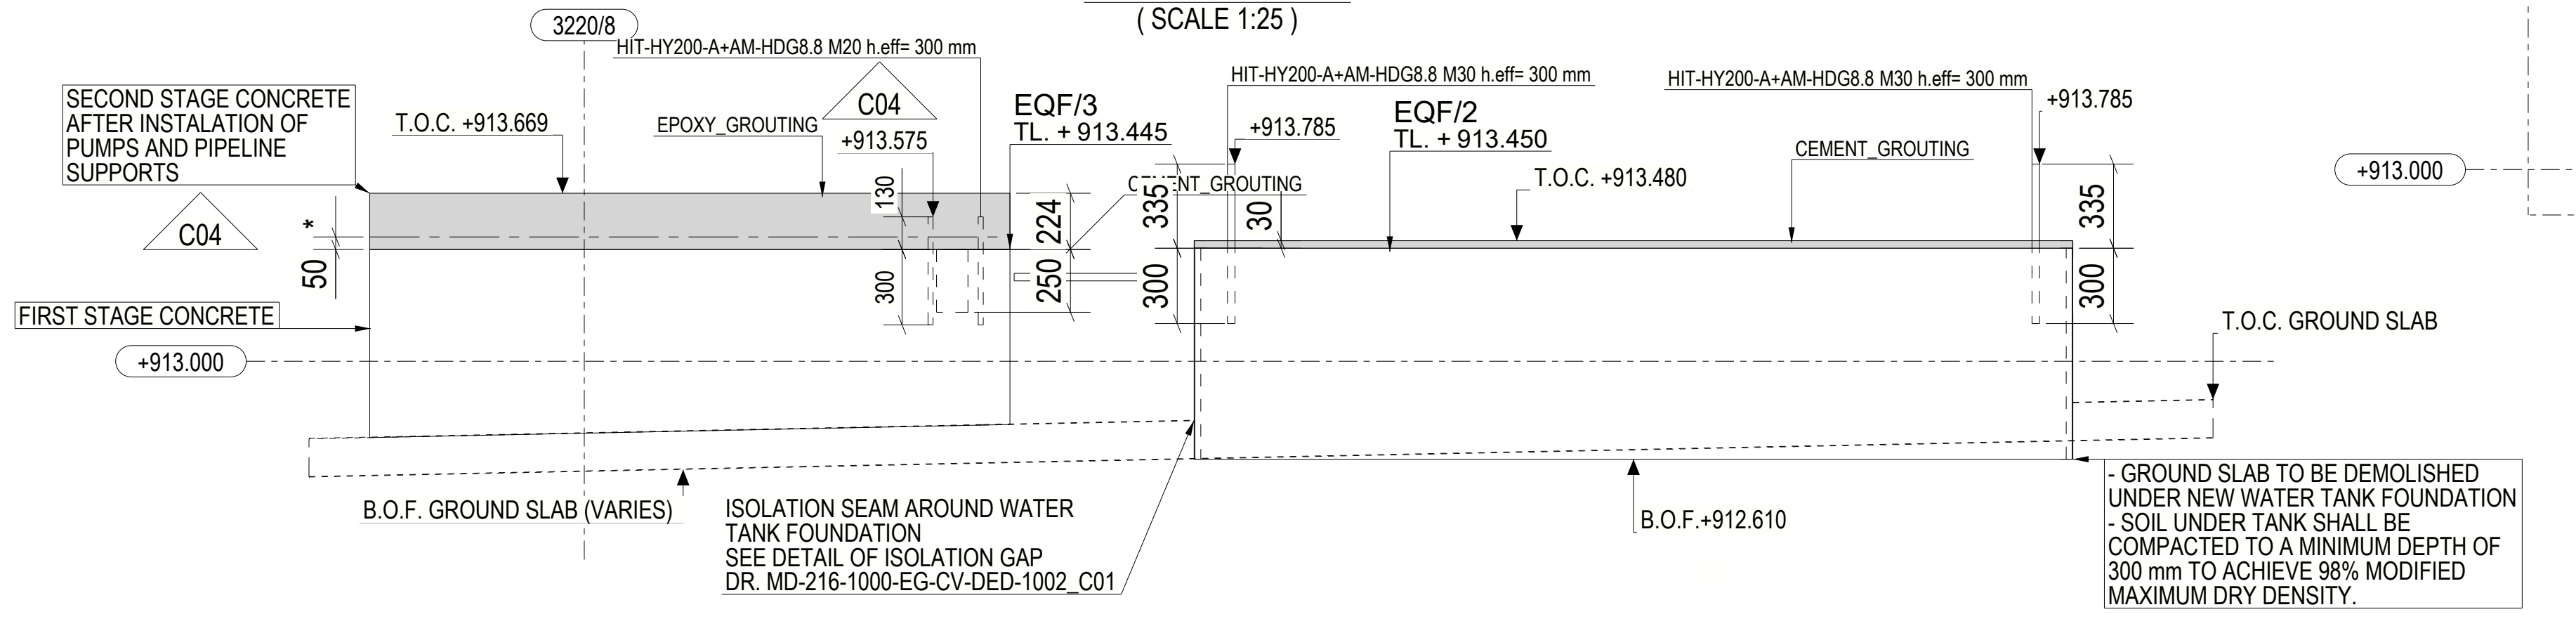
3220/8
SECOND STAGE CONCRETE AFTER INSTALATION OF PUMPS AND PIPELINE SUPPORTS
FIRST STAGE CONCRETE
T.O.C. +913.669
EPOXY_GROUTING
C04
+913.575
EQF/3
TL. + 913.445
EQF/2
TL. + 913.450
HIT-HY200-A+AM-HDG8.8 M20 h.eff= 300 mm
HIT-HY200-A+AM-HDG8.8 M30 h.eff= 300 mm
+913.785
T.O.C. +913.480
CEMENT_GROUTING
T.O.C. GROUND SLAB
+913.000
B.O.F. GROUND SLAB (VARIES)
ISOLATION SEAM AROUND WATER TANK FOUNDATION SEE DETAIL OF ISOLATION GAP DR. MD-216-1000-EG-CV-DED-1002_C01
B.O.F.+912.610
- GROUND SLAB TO BE DEMOLISHED UNDER NEW WATER TANK FOUNDATION - SOIL UNDER TANK SHALL BE COMPACTED TO A MINIMUM DEPTH OF 300 mm TO ACHIEVE 98% MODIFIED MAXIMUM DRY DENSITY.

SECTION : B - B
(SCALE 1:25)

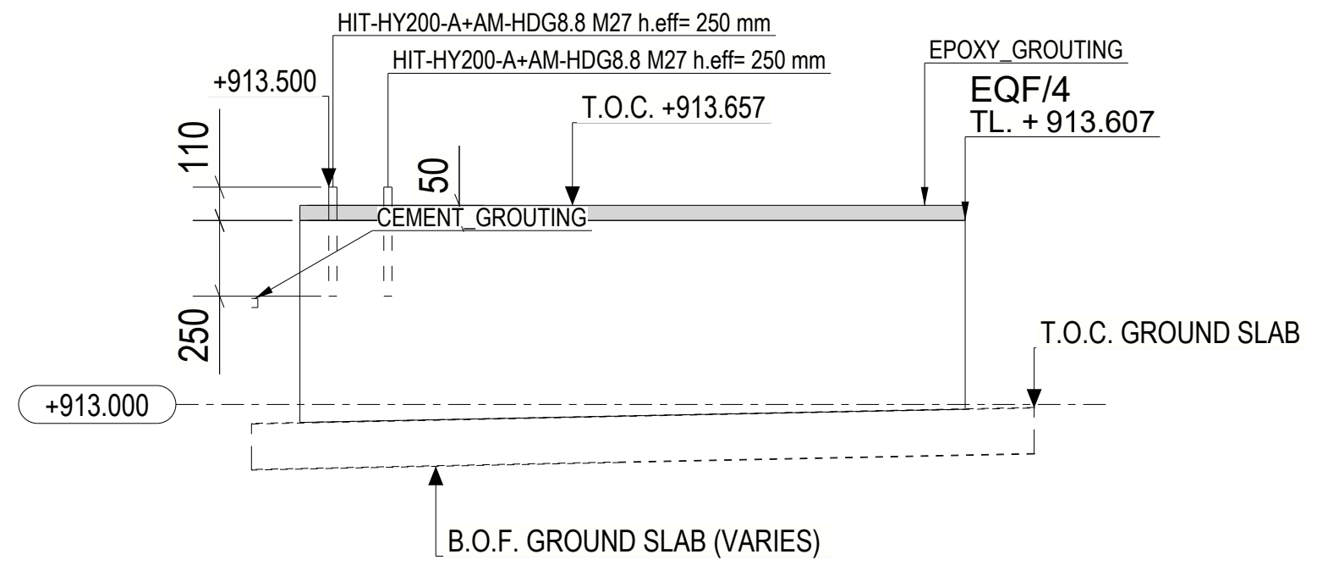

PIPELINE SUPPORTS FOUNDATIONS CF0/4 , CFO/5 , CFO/12
1:25

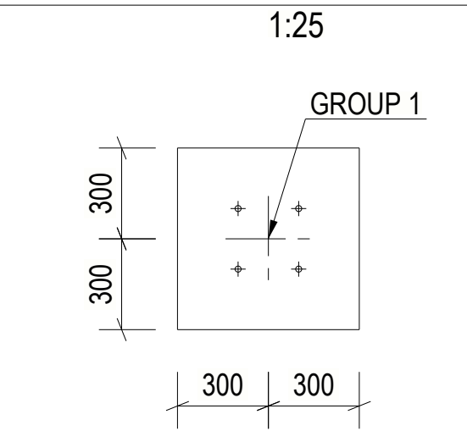

GROUP 1, 33 pcs.
1:10

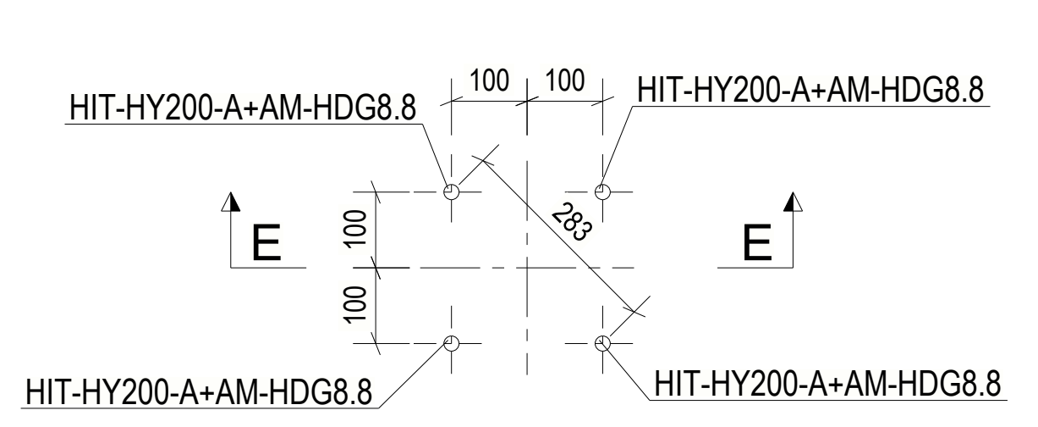

SECTION : E - E (EXCEPT FOR ANCHOR GROUP 1**)
(SCALE 1:10)

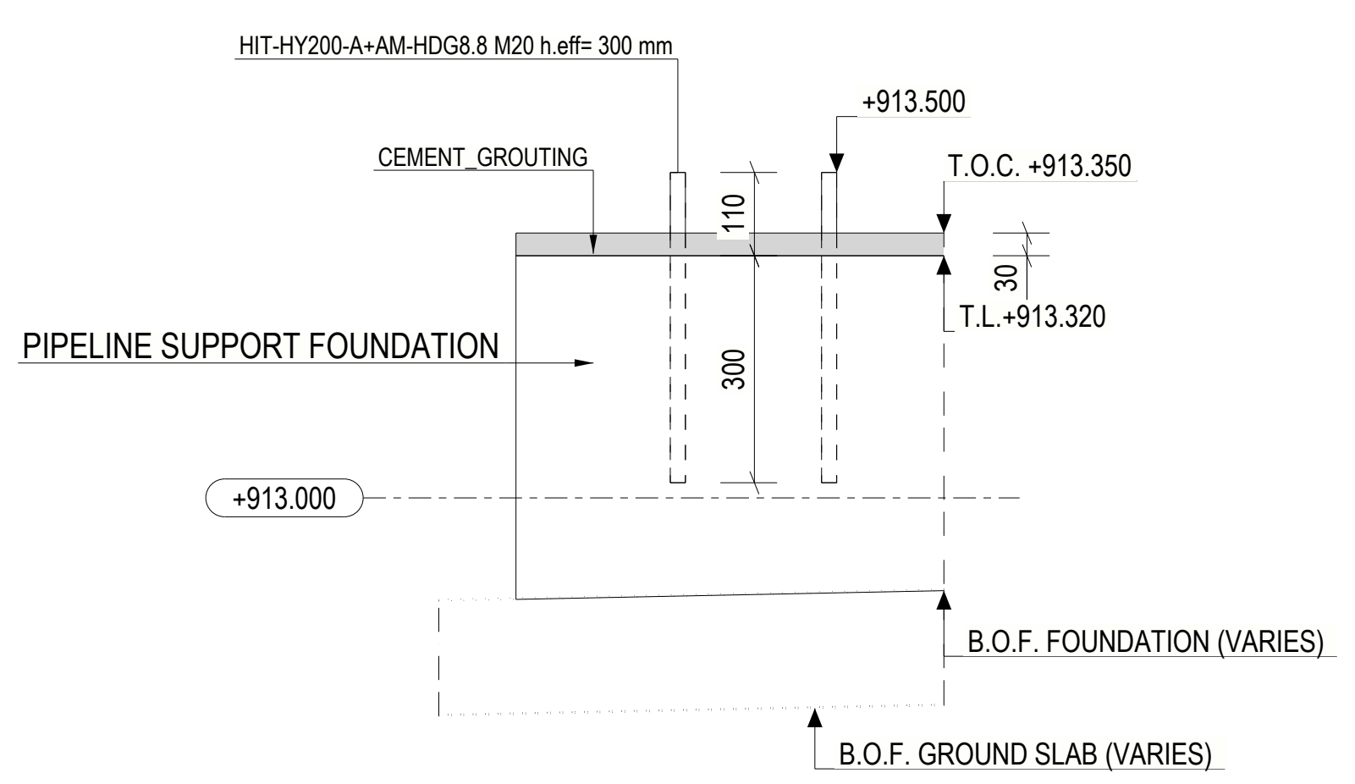
C04
HIT-HY200-A+AM-HDG8.8 M20 h.eff= 300 mm
+913.500
CEMENT_GROUTING
T.O.C. +913.350
T.L.+913.320
PIPELINE SUPPORT FOUNDATION
+913.000
B.O.F. FOUNDATION (VARIES)
B.O.F. GROUND SLAB (VARIES)

SECTION : C - C
(SCALE 1:25)

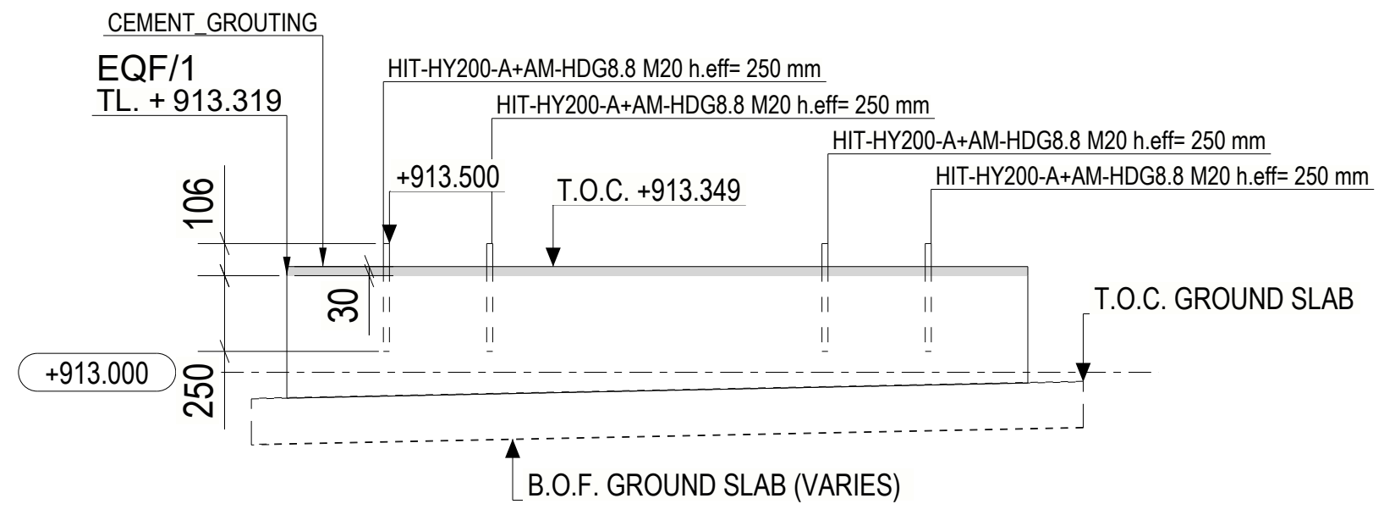
CEMENT_GROUTING
EQF/1
TL. + 913.319
HIT-HY200-A+AM-HDG8.8 M20 h.eff= 250 mm
HIT-HY200-A+AM-HDG8.8 M20 h.eff= 250 mm
+913.500
T.O.C. +913.349
T.O.C. GROUND SLAB
+913.000
B.O.F. GROUND SLAB (VARIES)

SECTION : D - D
(SCALE 1:10)

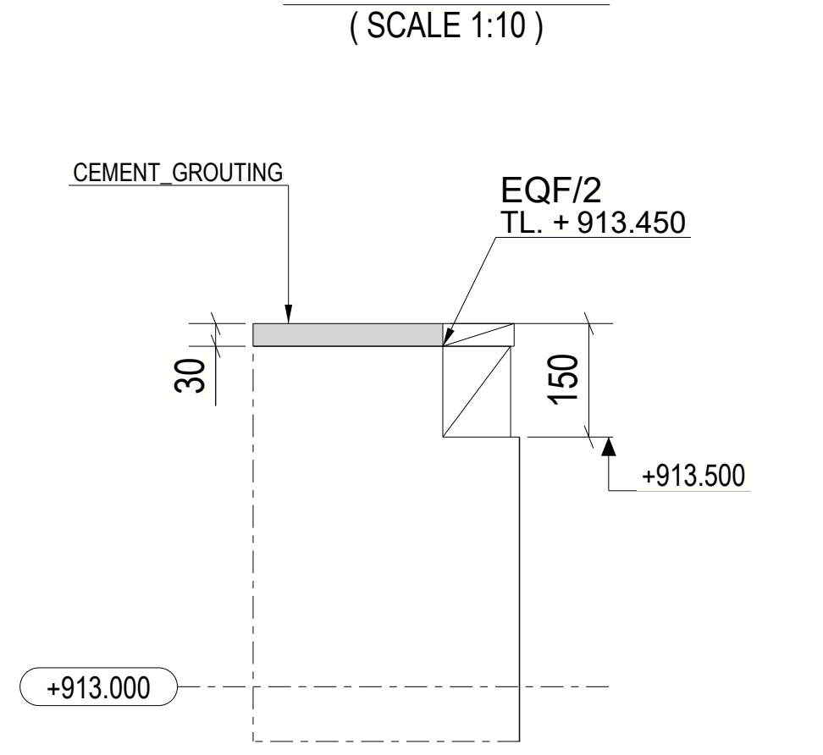

* NOMINAL DISTANCE BETWEEN FIRST STAGE CONCRETE AND BOTTOM OF PUMP 50mm

C04 ** ANCHOR BOLTS TO BE INSTALLED AND GROUTING NOT TO BE FILLED WITH SECOND STAGE CONCRETE UNTIL PIPELINE SUPPORT IS INSTALLED

LEGEND:

R.L. - REDUCED LEVEL
T.O.C. - TOP OF CONCRETE
TL. - TOP LEVEL
B.O.F. - BOTTOM OF FOUNDATION
F.G.L. - FINISHED GROUND LEVEL
P.C.C. - PLAIN CEMENT CONCRETE
TYP - TYPICAL
MKD - MARKED
CL - CENTER LINE
BOTTOM REINF. (B)
TOP REINF. (T)
SBC - SAFE BEARING CAPACITY
MIN. - MINIMUM
REF. - REFERED
GA - GENERAL ARRANGEMENT
DWG. - DRAWING
R.C.C. - REINFORCED CEMENT CONCRETE

NOTES:

1. ALL DIMENSIONS ARE IN MILLIMETRES AND LEVELS ARE IN METRES UNLESS OTHERWISE STATED
2. GRADE OF CONCRETE SHALL BE C35 (35MPa) UNLESS NOTED OTHERWISE & C15 (15MPa) FOR BLINDING CONCRETE.
3. GRADE OF REINFORCEMENT SHALL BE DEFORMED BAR ASTM A615-GRADE 60 (fy=420MPa)
4. CLEAR COVER TO MAIN REINFORCEMENT SHALL BE AS FOLLOWS:
a) FOUNDATION: 75 mm (BOTTOM & SIDE)
b) FOUNDATION: 50 mm (TOP)
c) COLUMN & PEDESTAL: 50 mm
5. MINIMUM LAP LENGTHS OF REINFORCEMENT SHALL BE 40XBAR DIAMETER
6. FOR STANDARD REINFORCEMENT DETAILS & GENERAL NOTES FOR CIVIL WORKS REFER TO DRAWING NUMBER MD-216-1000-EG-CV-DED-1005 & 1001
7. ANCHOR BOLTS AND EMBEDDED STEELWORK SHALL BE HOT DIP GALVANIZED
8. T.O.C. & TOP OF SCREED TOLERANCE SHALL BE WITHIN +/- 10MM OF DESIGN LEVEL
9. NET SAFE BEARING CAPACITY OF SOIL AT BOTTOM OF FOUNDATION IS CONSIDERED AS 375 KN/SQ.M.
10. REBARS CAN BE MOVED LOCALLY BY +/- 25mm TO AVOID INTERFERENCE WITH EMBEDDED PARTS

KEYPLAN

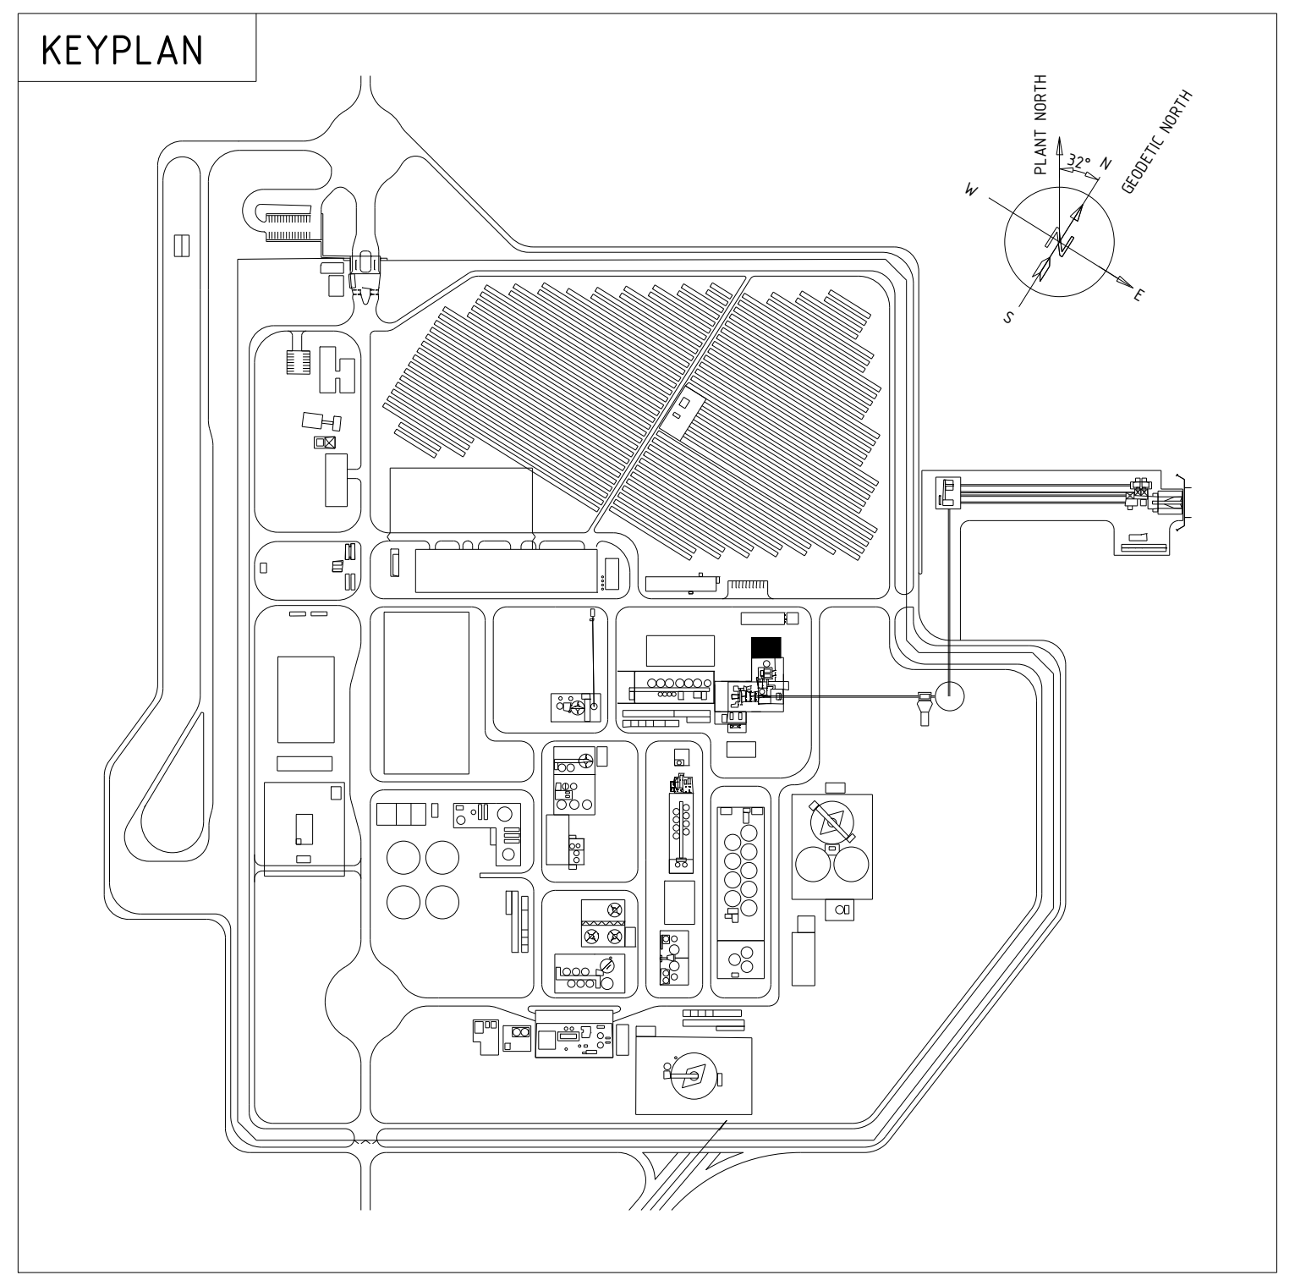

DOCUMENT NUMBER	REFERENCE DOCUMENTS	DOCUMENT NUMBER	REFERENCE DOCUMENTS
MD-216-3220-EG-CV-DED-1161	REINFORCEMENT DRAWING		
MD-216-3220-EG-CV-CAL-1162	CALCULATION REPORT		

REV	DATE	REVISION DESCRIPTION	DRN	CHK	ENG	APP	EMP
D01	19/12/2023	AS-BUILT	NadSal	CemEce	NadSal	LuiPiz	
C04	10.03.2023	ON HOLD AREAS DELETED. SECTIONS AND DETAILS ADDED.	NadSal	CemEce	NadSal	LuiPiz	
C03	27.02.2023	FONDATIONS COORDINATES ADDED.	NadSal	CemEce	NadSal	LuiPiz	
C02	22.02.2023	FONDATIONS COORDINATES ADDED. ON HOLD AREAS ADDED.	NadSal	CemEce	NadSal	LuiPiz	
C01	14.02.2023	ISSUED FOR CONSTRUCTION	NadSal	CemEce	NadSal	LuiPiz	

RESERVED FOR VENDOR LOGO AND DRAWING NUMBER

LARSEN & TOUBRO

This drawing is the property of LARSEN & TOUBRO and must not be passed on to any person or body not authorized by us to receive it nor be copied or otherwise made use either in full or in part by such person or body without our prior permission in writing.

Outotec

The content of these documents are the sole property of Outotec Oyj. Any rights not expressly granted herein are reserved. Reproduction, transfer or distribution of part or all of the contents in any form without prior written permission of Outotec is prohibited.

MA'ADEN معادن
Saudi Arabian Mining Company شركة التعدين العربية السعودية

This document and the information contained herein is Ma'aden proprietary know-how. This document or any part thereof should not be reproduced, stored in a retrieval system or transmitted by any means, electronic or otherwise, or divulged without prior written permission of Ma'aden.

LARSEN & TOUBRO DRAWING NUMBER
REVISION

OUTOTEC DRAWING NUMBER: 900707_GAU01_ZG01_MTL01_32272
DOCUMENT ID: OU100777918
REVISION: R3

DRAWN	NadSal	14.02.2023
CHECKED	CemEce	14.02.2023
ENGINEER	NadSal	14.02.2023
APPROVED	LuiPiz	14.02.2023
EMPLOYER		
SCALE	1:50 1:25 1:10	A0

MANSOURAH - MASSARAH GOLD PROJECT
DIMENSIONAL DRAWING
FOUNDATIONS
GRINDING MILL COOLING WATER

DRAWING NUMBER: MD-216-3220-EG-CV-GAD-1154
REV: D01

Tekla Structures