


DRAWING NUMBER MD-216-1800-EG-CV-GAD-1569 | REV D01

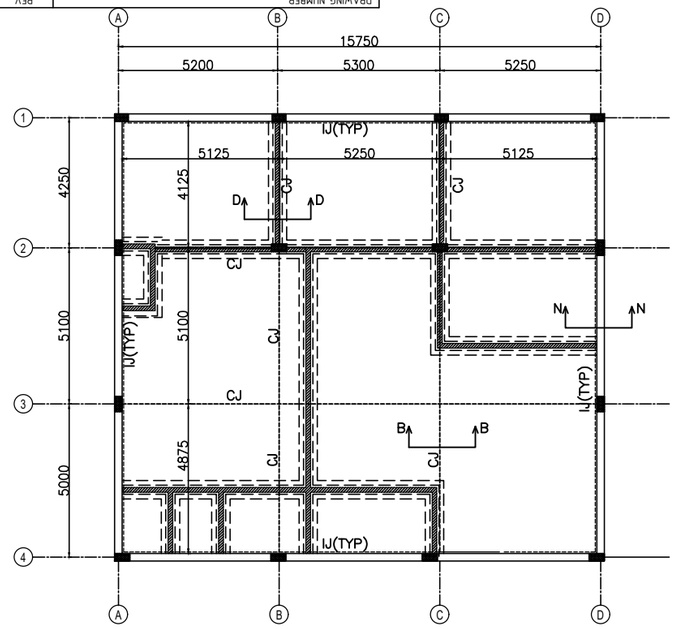

CONCRETE JOINTS LAYOUT
SCALE 1:100

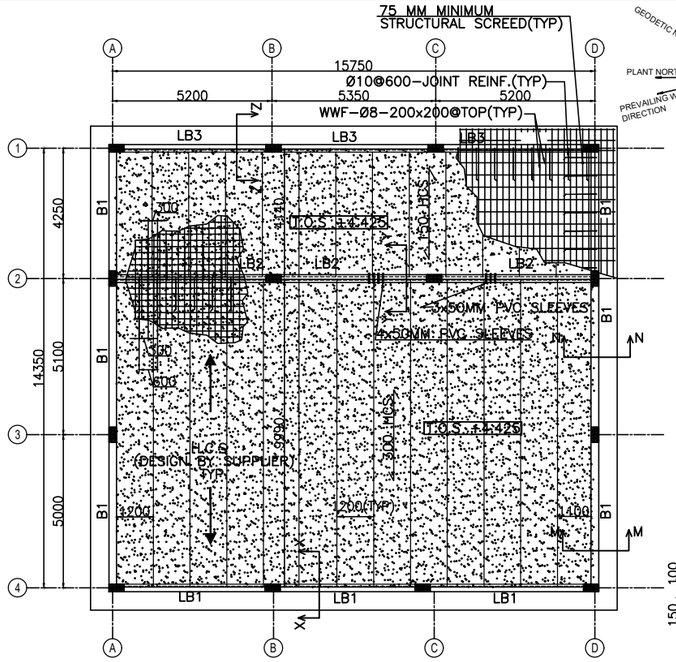


ROOF HOLLOW CORE SLAB LAYOUT
SCALE 1:100

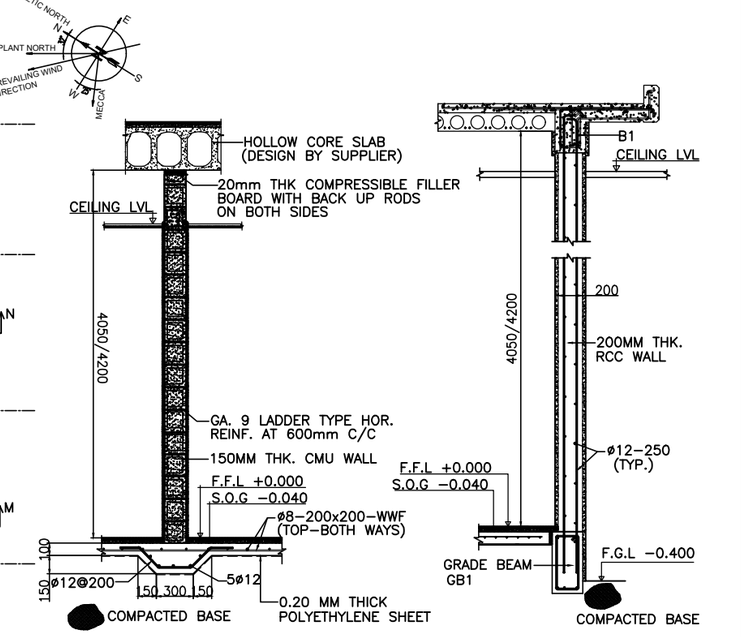


SECTION-D (INTERNAL WALL)
SCALE 1:25

SECTION-N (EXTERNAL WALL)
SCALE 1:25


MASTER KEY PLAN

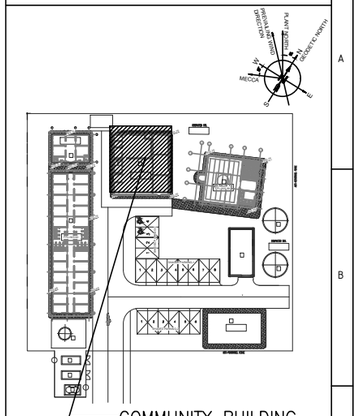


NOTE: CONTROL JOINTS
SHALL BE PROVIDED AT MAXIMUM
SPACING OF 20 FT (6.10 M)
AS PER ACI CODE

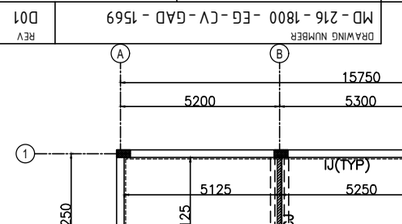


SECTION-B (CJ)
SCALE 1:10

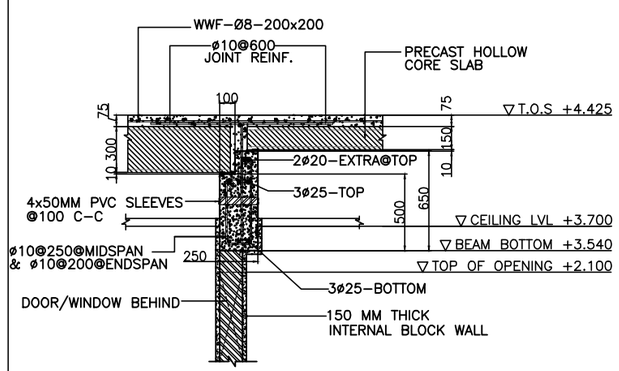


SECTION-Y (LB2)
SCALE 1:20

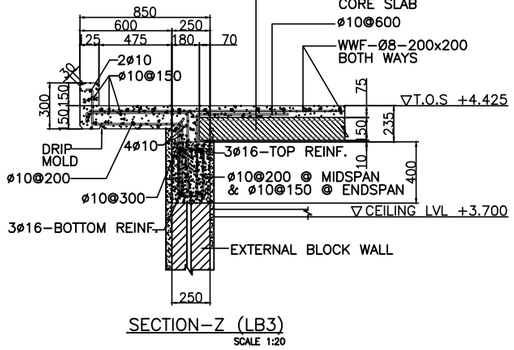


SECTION-Z (LB3)
SCALE 1:20

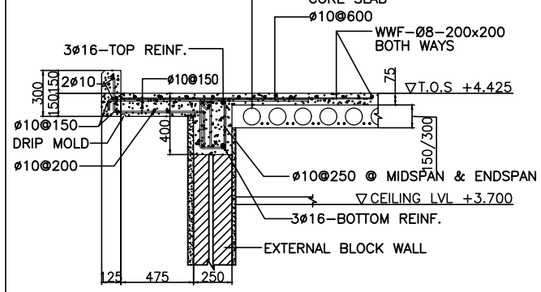

SECTION-M (B1)
SCALE 1:20

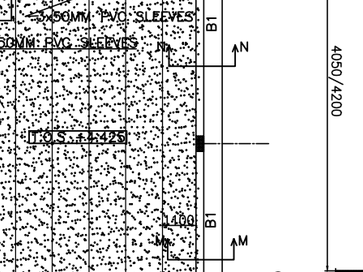

TYP JOINT SEAL DETAIL C
NTS GAD-1546

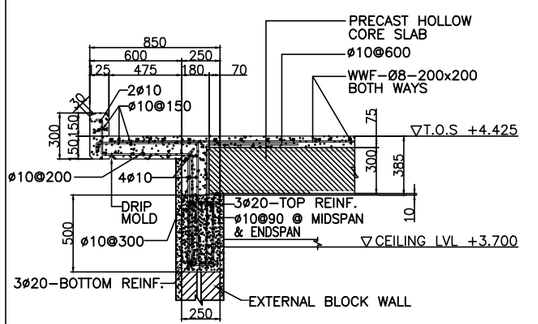

SECTION-X (LB1)
SCALE 1:20

SCHEDULE OF ROOF BEAMS

BEAM MARK	DIMENSIONS		STEEL REINFORCEMENT				STIRRUPS	REMARKS
			BOTTOM		TOP			
	WIDTH	DEPTH	STRAIGHT	ADD.	STRAIGHT	ADD.		
LB1	250	500	3Ø20	–	3Ø20	–	PROVIDE Ø10@90 BOTH @ MIDSPAN & THE END SPAN	REFER DETAIL-X
LB2	250	500	3Ø25	–	3Ø25+2Ø20	–	PROVIDE Ø10@200 AT THE @DISTANCE OF L/3 FROM THE SUPPORT IN END SPAN & Ø10@250 IN THE MID SPAN	REFER DETAIL-Y
LB3	250	400	3Ø16	–	3Ø16	–	PROVIDE Ø10@150 AT THE @DISTANCE OF L/3 FROM THE SUPPORT IN END SPAN & Ø10@200 IN THE MID SPAN	REFER DETAIL-Z
B1	250	400	3Ø16	–	3Ø16	–	PROVIDE Ø10@250 BOTH @ MIDSPAN & THE END SPAN	REFER DETAIL-M

NOTES

1.) ALL DIMENSIONS ARE GIVEN IN MILLIMETRES AND ELEVATIONS ARE IN METRES UNLESS OTHERWISE NOTED.
2.) MINIMUM REINFORCED CONCRETE GRADE TO BE USED FOR SUPERSTRUCTURE & SUBSTRUCTURES IS C35(5000 PSI).
3.) MINIMUM LEAN CONCRETE GRADE TO BE USED FOR THE SUB-STRUCTURES IS C15(2175 PSI).
4.) ALL REINFORCING STEEL SHALL BE DEFORMED BILLET STEEL BARS CONFORMING TO ASTM-A615, WITH MINIMUM YIELD STRENGTH OF FY420 MPA .
5.) THE NET SOIL BEARING CAPACITY CONSIDERED IN FOUNDATION DESIGN IS 350 KPA.(REFER DOC 216-3000-EG-CV-RPT-1008).
6.) WATER PROOFING INSULATION SHALL BE AS PER PROJECT SPECIFICATIONS & ITS MATERIAL TO BE APPROVED BY ENGINEER @SITE.
7.) THE MINIMUM CONCRETE COVER AS PER SBC-304-2018(TABLE 20.6.1.3.1) MEASURED FROM REBAR SHALL BE
a) CONCRETE CAST AGAINST & PERMANENTLY EXPOSED TO EARTH (INCLUDING FOUNDATIONS OVER SUB-SLAB) FORMED CONCRETE EXPOSED TO EARTH OR WEATHER.....50MM
b.) CONCRETE NOT EXPOSED TO WEATHER NOR IN CONTACT WITH GROUND
BEAMS, COLUMNS.....40MM
SLABS, WALLS, JOISTS.....20MM
c.) CONCRETE SLAB OVER 50MM SUB-SLAB.....20MM
8.) ALL DRAWINGS MUST BE READ IN CONJUNCTION WITH RELEVANT ARCHITECTURAL AND ENGINEERING DRAWINGS RELATED TO THE SAME SHEET AND ANY ITEM ON IT.
9.) F.F.L +0.00 MENTIONED IS EQUIVALENT TO RL 923.90 AS PER THE CIVIL DRAWING MD-216-1800-EG-CV-GAD-1565-OVERALL LAYOUT PLAN.

F-FOUNDATION
C-COLUMN
FFL-FINISH FLOOR LVL
FGL-FINISH GROUND LVL
TOS-TOP OF SCREED
WWF-WELDED WIRE FABRIC
HCS-HOLLOW CORE SLAB
GB-GRADE BEAM
IJ-ISOLATION JOINT
CJ-CONTROL JOINT
GA-GALVANIZED
S.O.G-SLAB ON GRADE
NTS-NOT TO SCALE
ARCH-ARCHITECTURAL
HOR.-HORIZONTAL
REINF.-REINFORCEMENT
LVL.-LEVEL
RL-REDUCED LEVEL

DOCUMENT NUMBER	REFERENCE DOCUMENTS	REV	DATE	REVISION DESCRIPTION	DRN	CHK	ENG	APP	EMP
MD-216-6000-EG-CV-STD-1002	HOLLOW CORE SLAB STANDARD	D01	28/02/2023	AS-BUILT	--	AVG	--	SJM	
MD-216-6000-EG-CV-STD-1001	REINFORCEMENT STANDARD	C02	09/06/2021	ISSUED FOR CONSTRUCTION & REVISED AS MARKED (1)	--	AVG	--	SJM	
MD-216-1800-EG-AR-GAD-3152	BUILDING PLANS	C01	03/06/2020	ISSUED FOR CONSTRUCTION	--	AVG	--	SJM	
MD-216-1800-EG-CV-GAD-1565	OVERALL LAYOUT PLAN	A01	31/03/2020	ISSUED FOR APPROVAL	--	AVG	--	SJM	

DESIGNER: مكتب الخليج للاستشارات الهندسية - المحدودة - المملكة العربية السعودية
GULF CONSULT ARCHITECTS AND ENGINEERS

DRAWING NUMBER					REVISION
ACCO-2-ST-002					0
DATE	27/03/2020	DATE	28/03/2020	DATE	29/03/2020
DRAWN	MAH	CHECKED	MF	APPROVED	FK

LARSEN & TOUBRO DRAWING NUMBER		REVISION
019045_900_C_G_24247_002		3
OUTOTEC DRAWING NUMBER	DOCUMENT ID	REVISION
900707__GAU01__AN02__MTL01__18035	OU100668741	3

LARSEN & TOUBRO

This drawing is the property of LARSEN & TOUBRO and must not be passed on to any person or body not authorized by us to receive it nor be copied or otherwise made use either in full or in part by such person or body without our prior permission in writing.

Outotec

The content of these documents are the sole property of Outotec Oyj. Any rights not expressly granted herein are reserved. Reproduction, transfer or distribution of part or all of the contents in any form without prior written permission of Outotec is prohibited.

MA'ADEN معادن
Saudi Arabian Mining Company شركة معادن العربية السعودية

This document and the information contained herein is Ma'aden proprietary know-how. This document or any part thereof should not be reproduced, stored in a retrieval system or transmitted by any means, electronic or otherwise, or divulged without prior written permission of Ma'aden.

DRAWN	--	--
CHECKED	AVG	30/03/2020
ENGINEER	--	--
APPROVED	SJM	31/03/2020
EMPLOYER		
SCALE	1:100	A1

MANSOURAH - MASSARAH GOLD PROJECT
GENERAL ARRANGEMENT
SECURITY BASE CAMP: COMMUNITY BUILDING
LAYOUT & DETAILS OF ROOF & GRADE SLAB

DRAWING NUMBER: MD-216-1800-EG-CV-GAD-1569 | REV: D01