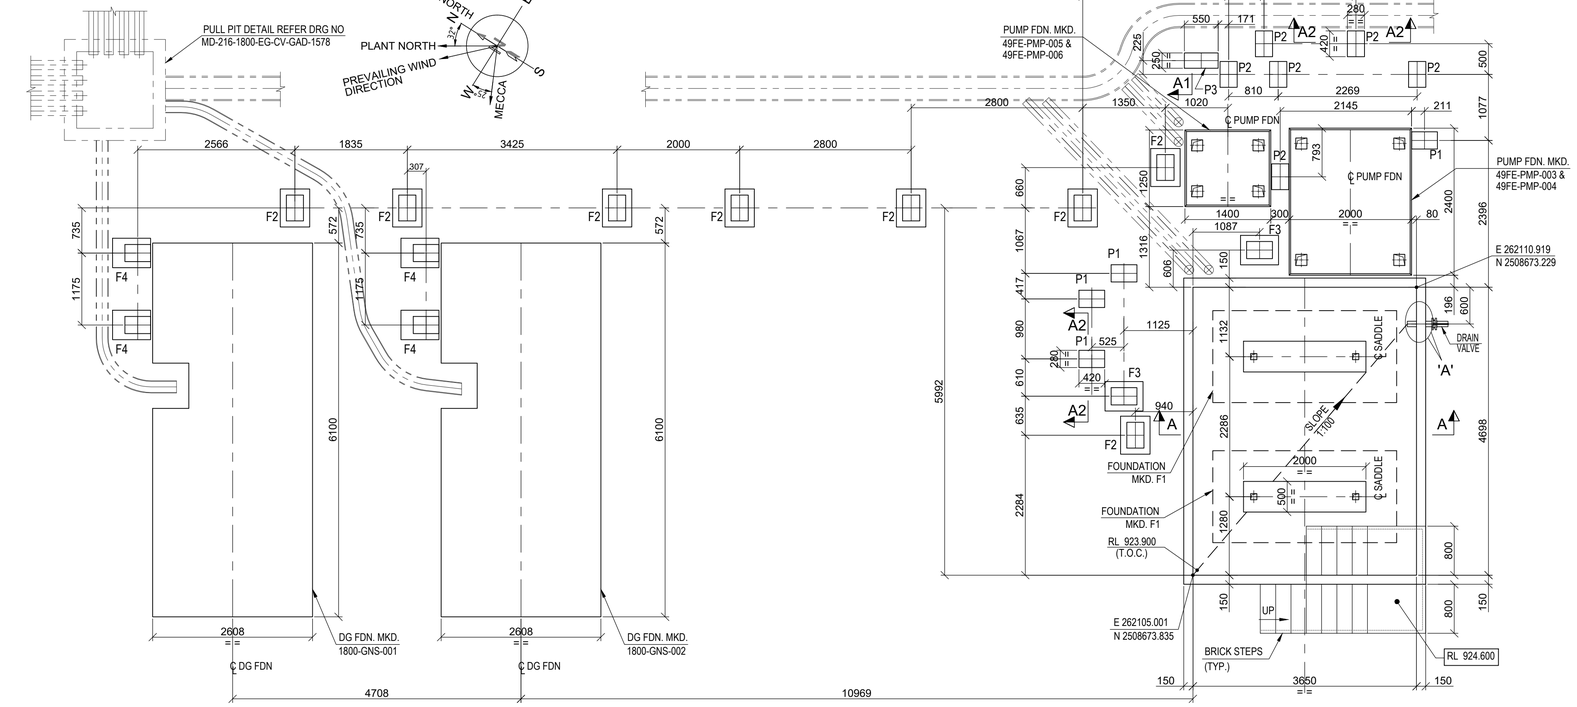
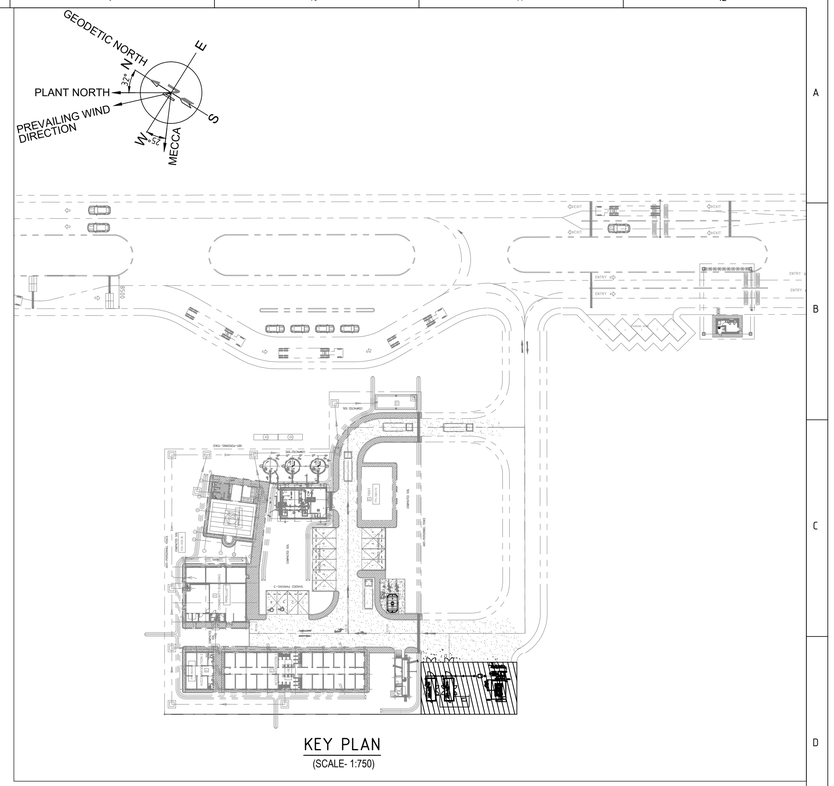
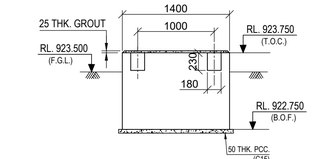
DRAWING NUMBER: MD-216-1800-EG-CV-GAD-1577 | REV: D01

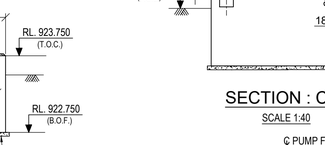



SECTION : A1-A1

SCALE 1:40

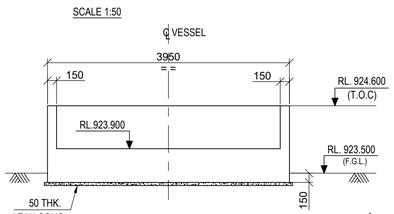



SECTION : A2-A2

SCALE 1:40

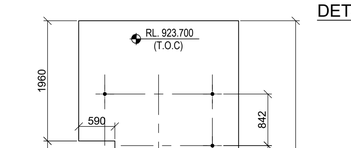
LAYOUT OF MISC. PIPE SUPPORTS & EQUIP. FDN.

SCALE 1:50



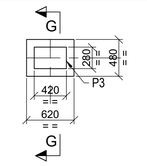

SECTION A-A

SCALE 1:50



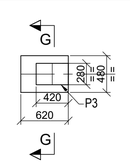

SECTION : E-E

SCALE 1:50




DETAIL OF FDN MKD. F3

SCALE 1:40




DETAIL OF FDN MKD. F4

SCALE 1:40




SECTION : D-D

SCALE 1:40



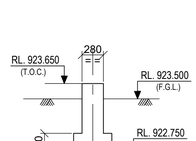

SECTION : C-C

SCALE 1:40



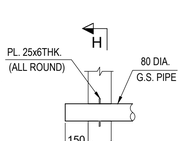

FDN. FOR DG MKD. 1800-GNS-001 & 1800-GNS-002

SCALE 1:50



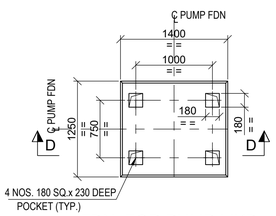

SECTION : G-G

SCALE 1:40



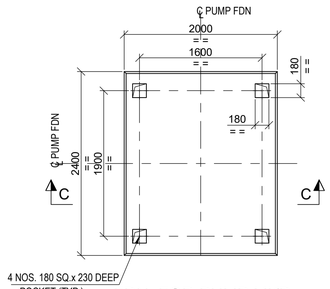

DETAIL-A

SCALE 1:20



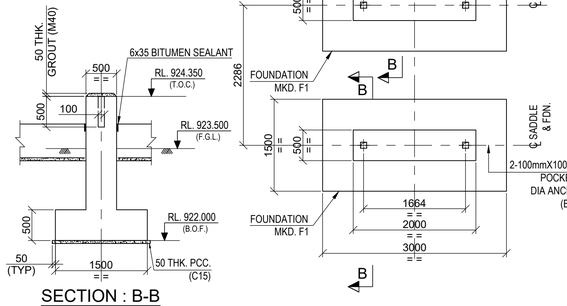

FDN. FOR PUMP MKD. 49FE-PMP-005 & 49FE-PMP-006

SCALE 1:40




FDN. FOR PUMP MKD. 49FE-PMP-003 & 49FE-PMP-004

SCALE 1:40



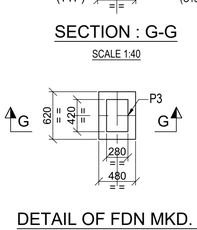

SECTION : B-B

SCALE 1:50



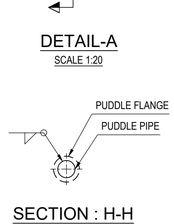

FOUNDATION LAYOUT PLAN F1

SCALE 1:50




DETAIL OF FDN MKD. F2

SCALE 1:40




SECTION : H-H

SCALE 1:20

## LEGEND :-

R.L. - REDUCED LEVEL
THK. - THICK
TYP. - TYPICAL.
MKD. - MARKED
T.O.C - TOP OF CONCRETE
T.O.G - TOP OF GROUT
℄ - CENTRE LINE
P.C.C - PLAIN CEMENT CONCRETE
F.G.L. - FINISHED GROUND LEVEL.
GA - GENERAL ARRANGEMENT
B.O.F. - BOTTOM OF FOUNDATION
DIA - DIAMETER
FDN. - FOUNDATION
STR. - STRUCTURAL
REQD. - REQUIRED
REF. - REFER
DRG. - DRAWING
PL. - PLATE

## NOTES:-

1. ALL DIMENSIONS ARE IN MILLIMETRES AND LEVELS AND CO-ORDINATES ARE IN METRES UNLESS OTHERWISE STATED.
2. MINIMUM REINFORCED CONCRETE GRADE TO BE USED FOR SUPERSTRUCTURE & SUBSTRUCTURES IS M35(5000 PSI).
3. MINIMUM LEAN CONCRETE GRADE TO BE USED FOR THE SUB-STRUCTURES IS M15(2175 PSI).
4. ALL REINFORCING STEEL SHALL BE DEFORMED BILLET STEEL BARS CONFORMING TO ASTM-A615, WITH MINIMUM YIELD STRENGTH OF FY420 MPA .
5. THE NET SOIL BEARING CAPACITY CONSIDERED IN FOUNDATION DESIGN IS 350 KPA(REFER DOC 216-3000-EG-CV-CAL-1008-A02).
6. WATER PROOFING INSULATION SHALL BE AS PER PROJECT SPECS AND ITS MATERIAL TO BE APPROVED BY ENGINEER ON SITE.
7. FOR STANDARD REINFORCEMENT DETAIL & GENERAL NOTES FOR CIVIL WORKS REFER DRAWING NO. MD-216-1000-EG-CV-DED-1005 &1001.
8. FOR REINFORCEMENTS DETAIL REF. DRG. NO. MD - 216 - 1800 - EG - CV - DED - 1568.
9. STRUCTURAL FILL SHALL CONFORM TO PROVISIONS OF DOCUMENT MD-216-1000-EG-CV-MST-1698.
10. FOR DETAILS OF SLAB RE-ENTRANCE CORNER TRIMMERS REFER DRG NO MD-101-SMEM-EG-ST-DST-0007. FOR SLAB JOINT DETAILS REFER DRG NO MD-216-1000-EG-CV-DED-1002.

| DOCUMENT NUMBER | REFERENCE DOCUMENTS | REV | DATE | REVISION DESCRIPTION | DRN | CHK | ENG | APP | EMP |
|---|---|---|---|---|---|---|---|---|---|
| MD-216-1800-EG-EL-LAD-1020 | CABLE ROUTE LAYOUT - CROSS SECTION | | | | | | | | |
| MD-216-1800-EG-EL-LAD-1019 | CABLE ROUTE LAYOUT | | | | | | | | |
| MD-216-1800-EG-EL-GAD-V565-1001 | 400 V DG SETS SECURITY BASE CAMP AREA | | | | | | | | |
| MD-216-49FE-EG-PI-GAD-V558-1006 | PIPING FOR SECURITY BASE CAMP | | | | | | | | |
| MD-216-49FE-EG-ME-LAD-V558-1006 | FUEL OIL STORAGE FOR SECURITY BASE CAMP | | | | | | | | |
| MD-216-49FE-EG-ME-GAD-V558-1023 | TANK (5.6m3) FOR EXPLOSIVE MAGAZINE AREA | | | | | | | | |
| MD-216-49FE-EG-ME-GAD-V558-1009 | TRANSFER PUMPS FOR SECURITY BASE CAMP | D01 | 28/02/2023 | AS-BUILT | PML | SJM | AVG | AG | |
| MD-216-49FE-EG-ME-GAD-V558-1008 | UNLOADING PUMPS FOR SECURITY BASE CAMP | C01 | 28/06/2021 | ISSUED FOR CONSTRUCTION AND REVISED AS PER EMPLOYER | | | | | |
| MD-216-1800-EG-CV-GAD-1565 | FACILITY SECURITY FORCES BASE CAMP | | | COMMENTS ON 28/06/2021 AND REVISED AS MARKED (C01) | PML | SJM | AVG | AG | |
| | OVERALL LAYOUT | A01 | 05/06/2021 | ISSUED FOR REVIEW | PML | SJM | AVG | AG | |

RESERVED FOR VENDOR LOGO AND DRAWING NUMBER

LARSEN & TOUBRO
This drawing is the property of LARSEN & TOUBRO and must not be passed on to any person or body not authorized by us to receive it nor be copied or otherwise made use either in full or in part by such person or body without our prior permission in writing.

Outotec
The content of these documents are the sole property of Outotec Oyj. Any rights not expressly granted herein are reserved. Reproduction, transfer or distribution of part or all of the contents in any form without prior written permission of Outotec is prohibited.

MA'ADEN معادن
Saudi Arabian Mining Company شركة التعدين العربية السعودية
This document and the information contained herein is Ma'aden proprietary know-how. This document or any part thereof should not be reproduced, stored in a retrieval system or transmitted by any means, electronic or otherwise, or divulged without prior written permission of Ma'aden.

| | | |
|---|---|---|
| LARSEN & TOUBRO DRAWING NUMBER | 019045_900_C_G_24655_001 | REVISION 2 |
| OUTOTEC DRAWING NUMBER | 900707__GAU01__AN02__MTL01__18193 | DOCUMENT ID OU100725623 / REVISION 2 |

| | | |
|---|---|---|
| DRAWN | PML | 26/05/2021 |
| CHECKED | SJM | 01/06/2021 |
| ENGINEER | AVG | 26/05/2021 |
| APPROVED | AG | 05/06/2021 |
| EMPLOYER | | |
| SCALE | 1:30 | A1 |

MANSOURAH - MASSARAH GOLD PROJECT
GENERAL ARRANGEMENT DRAWING
SECURITY BASE CAMP
LAYOUT & DETAILS OF DIESEL GENERATOR & OIL TANK FDN.

DRAWING NUMBER: MD-216-1800-EG-CV-GAD-1577 | REV: D01