


DRAWING NUMBER: MD-216-1800-EG-CV-GAD-1578 | REV: D01

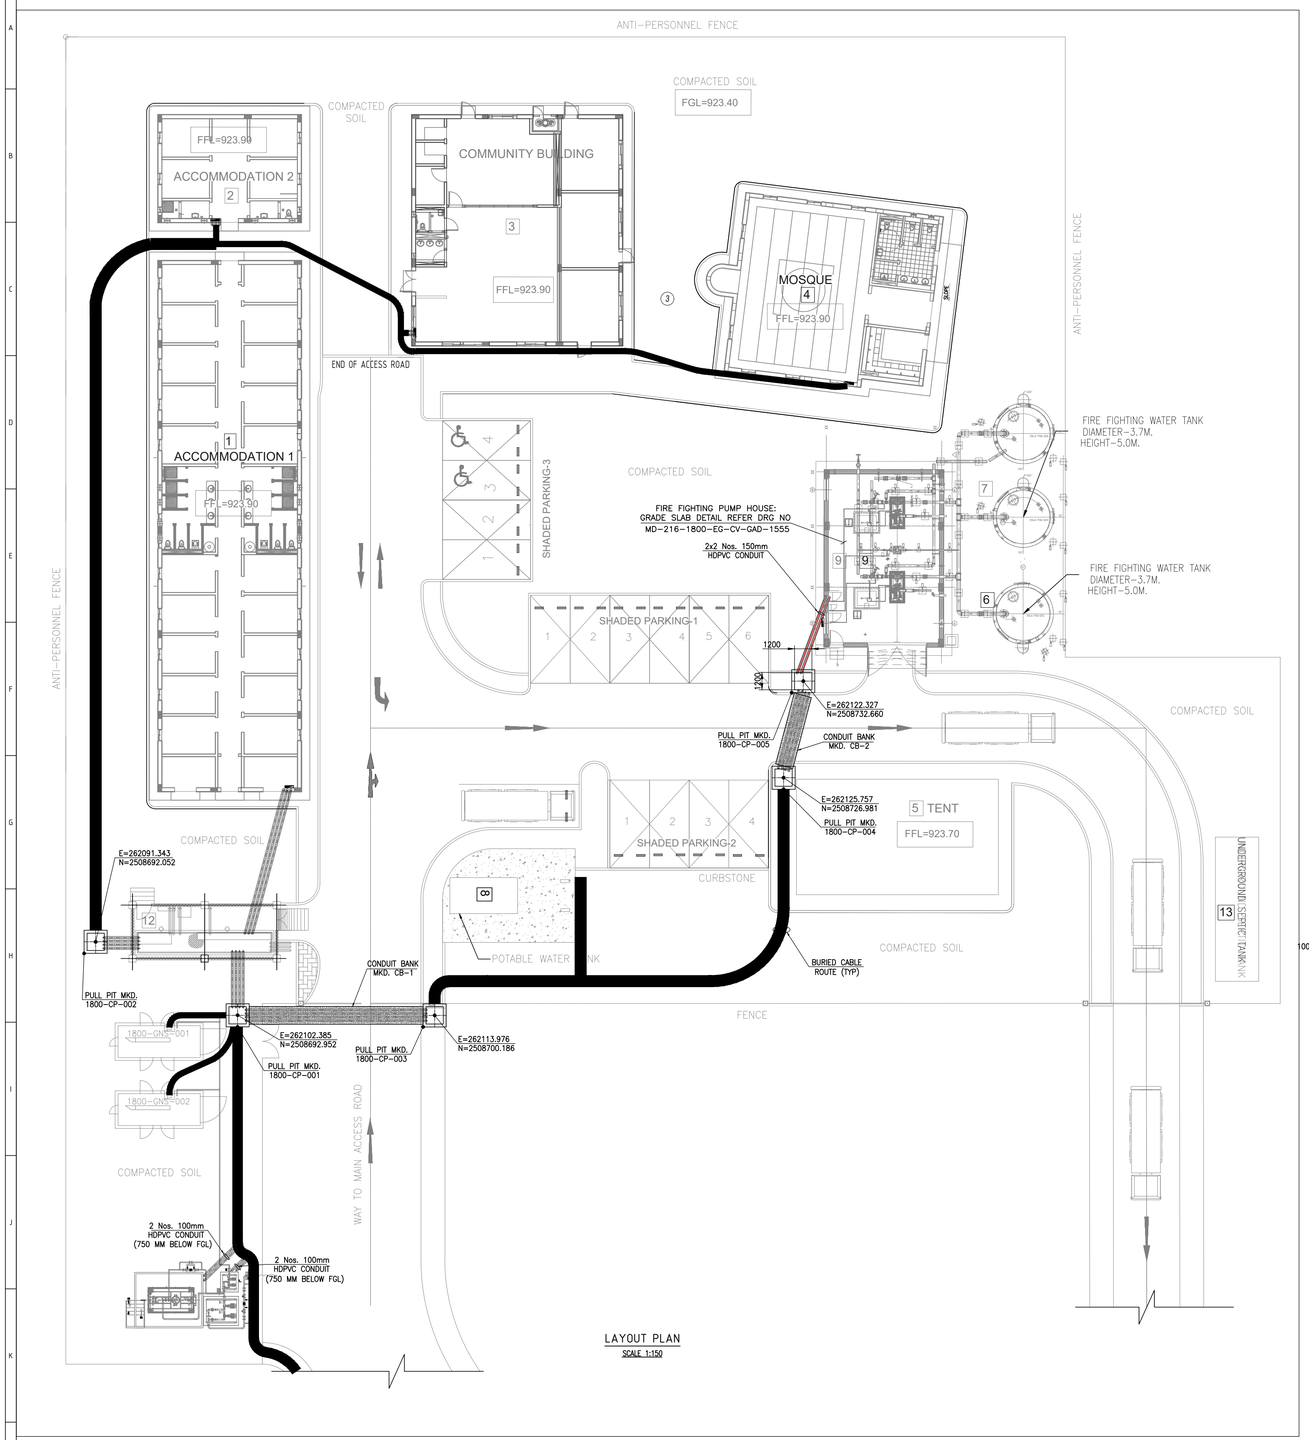


LAYOUT PLAN
SCALE 1:150

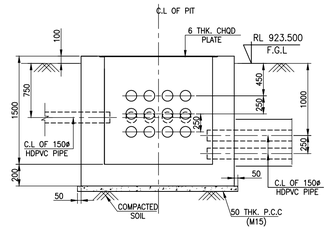


G.A. SECTION A-A
SCALE 1:30

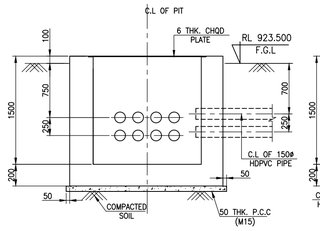


G.A. SECTION B-B
SCALE 1:30

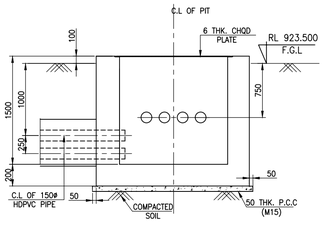


G.A. SECTION C-C
SCALE 1:30

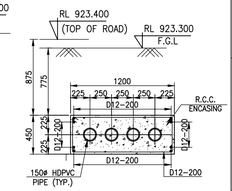


DET. OF CB-2
SCALE 1:25

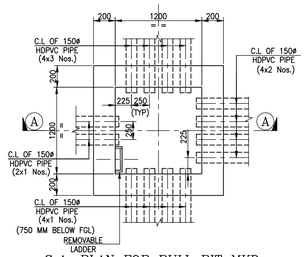


G.A. PLAN FOR PULL PIT MKD. 1800-CP-001
SCALE 1:30

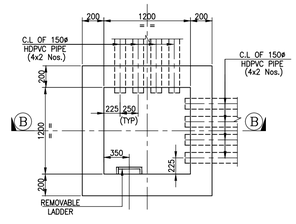


G.A. PLAN FOR PULL PIT MKD. 1800-CP-002
SCALE 1:30

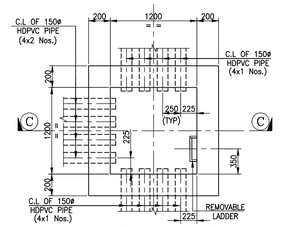


G.A. PLAN FOR PULL PIT MKD. 1800-CP-003
SCALE 1:30

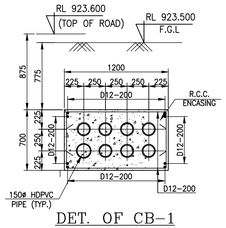


DET. OF CB-1
SCALE 1:25

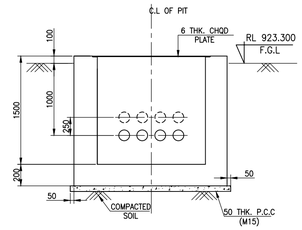


G.A. SECTION D-D
SCALE 1:30

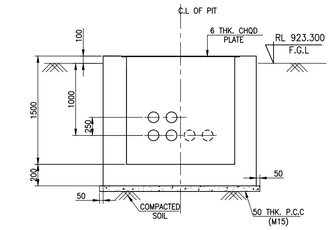


G.A. SECTION E-E
SCALE 1:30

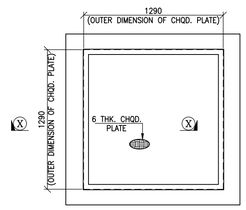


TYPICAL PLAN AT CHQD. PLATE COVER
SCALE 1:20

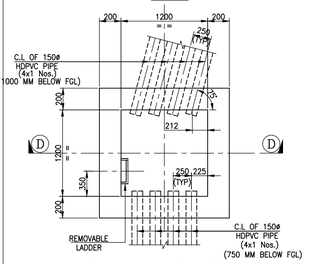


G.A. PLAN FOR PULL PIT MKD. 1800-CP-004
SCALE 1:30

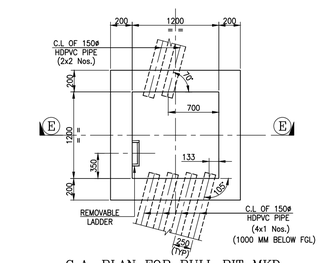


G.A. PLAN FOR PULL PIT MKD. 1800-CP-005
SCALE 1:30

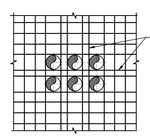


TYP. DETAIL OF WALL REINF. NEAR PIPES
SCALE 1:30

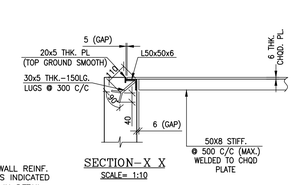

SECTION-X X
SCALE= 1:10

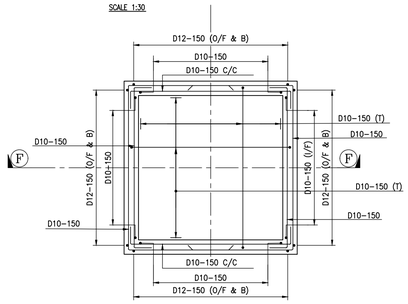

R.C. PLAN FOR PULL PIT
SCALE 1:30

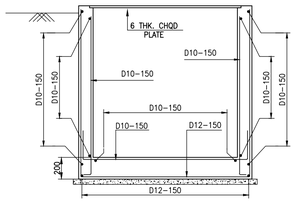

R.C. SECTION F-F
SCALE 1:30

LEGEND:

TYP.	TYPICAL
U.N.O	UNLESS NOTED OTHERWISE
G.A.	GENERAL ARRANGEMENT
R.C.	REINFORCED CONCRETE
DET.	DETAIL
CB	CONDUIT BANK
F.G.L	FINISHED GROUND LEVEL
P.C.C	PLAIN CEMENT CONCRETE
R.C.C	REINFORCED CEMENT CONCRETE
M.S.	MILD STEEL
HDPVC	HIGH-DENSITY POLYVINYL CHLORIDE
C.L	CENTRE LINE
DIA	DIAMETER
ø	DIAMETER
O/F	OUTER FACE
T	TOP
B	BOTTOM
ADMIN	ADMINISTRATION
MKD.	MARKED
CHQD.	CHEQUERED
THK.	THICK
PL.	PLATE
LG.	LONG
STIFF.	STIFFENER
C/C	CENTRE TO CENTRE
MAX.	MAXIMUM
RL	REDUCED LEVEL
DRG.	DRAWING
REINF.	REINFORCEMENT

NOTES:
1. ALL DIMENSIONS ARE IN MILLIMETRES
2. CO-ORDINATES AND LEVELS ARE IN METRES
3. GRADE OF REINFORCED CEMENT CONCRETE (R.C.C) SHALL BE M35.
4. REINFORCEMENT BARS SHALL CONFORM TO ASTM A615 GRADE 60 (FY=420 N/SQ.MM.)
5. CLEAR COVER TO MAIN REINFORCEMENT SHALL BE 25MM(MINIMUM) U.N.O.
6. FOR STANDARD REINFORCEMENT DETAIL & GENERAL NOTES FOR CIVIL WORKS REFER DRAWING NO. MD-216-1000-EG-CV-DED-1005 &1001.

DOCUMENT NUMBER	REFERENCE DOCUMENTS	REV	DATE	REVISION DESCRIPTION	DRN	CHK	ENG	APP	EMP
MD-216-1800-EG-CV-GAD-1577	LAYOUT & DETAILS OF DIESEL GENERATOR & OIL TANK FDN								
MD-216-1800-EG-CV-GAD-1570	SECURITY BASE CAMP: MOSQUE								
MD-216-1800-EG-CV-GAD-1569	SECURITY BASE CAMP: COMMUNITY BUILDING								
MD-216-1800-EG-CV-GAD-1568	SECURITY BASE CAMP: ACCOMMODATION 2								
MD-216-1800-EG-CV-GAD-1566	SECURITY BASE CAMP: ACCOMMODATION 1								
MD-216-1800-EG-CV-GAD-1550	SECURITY BASE CAMP: ELECTRICAL ROOM	D01	28/02/2023	AS-BUILT	PML	SJM	AVG	AG	
MD-216-1800-EG-CV-GAD-1555	SECURITY BASE CAMP:FIRE FIGHTING PUMP HOUSE	C01	01/07/2021	ISSUED FOR CONSTRUCTION AND REVISED AS PER EMPLOYER					
MD-216-1800-EG-EL-LAD-1019	CABLE ROUTE LAYOUT			COMMENTS ON 28/06/2021 AND REVISED AS MARKED ⚠	PML	SJM	AVG	SJM	
MD-216-1800-EG-EL-LAD-1020	CABLE ROUTE LAYOUT - CROSS SECTIONS	A01	07/06/2021	ISSUED FOR REVIEW	PML	SJM	AVG	AG	

DOCUMENT NUMBER	REFERENCE DOCUMENTS	REV	DATE	REVISION DESCRIPTION	DRN	CHK	ENG	APP	EMP

RESERVED FOR VENDOR LOGO AND DRAWING NUMBER

LARSEN & TOUBRO

This drawing is the property of LARSEN & TOUBRO and must not be passed on to any person or body not authorized by us to receive it nor be copied or otherwise made use either in full or in part by such person or body without our prior permission in writing.

Outotec

The content of these documents are the sole property of Outotec Oyj. Any rights not expressly granted herein are reserved. Reproduction, transfer or distribution of part or all of the contents in any form without prior written permission of Outotec is prohibited.

MA'ADEN معادن
Saudi Arabian Mining Company شركة معادن السعودية للتعدين

This document and the information contained herein is Ma'aden proprietary know-how. This document or any part thereof should not be reproduced, stored in a retrieval system or transmitted by any means, electronic or otherwise, or divulged without prior written permission of Ma'aden.

LARSEN & TOUBRO DRAWING NUMBER	019045_900_C_G_24657_001		REVISION 2
OUTOTEC DRAWING NUMBER	900707_GAU01_AN02_MTL01_18194	DOCUMENT ID OU100725624	REVISION 2
DRAWN	PML	02/06/2021	MANSOURAH - MASSARAH GOLD PROJECT
CHECKED	SJM	03/06/2021	GENERAL ARRANGEMENT DRAWING
ENGINEER	AVG	02/06/2021	SECURITY BASE CAMP: PULL PIT LAYOUT
APPROVED	AG	07/06/2021	SECTION & DETAILS
EMPLOYER			
SCALE	1:150, 1:50, 1:20	A0	DRAWING NUMBER: MD-216-1800-EG-CV-GAD-1578 REV: D01