


DRAWING NUMBER: MD - 216 - 1800 - EG - CV - GAD - 1583
REV: D01

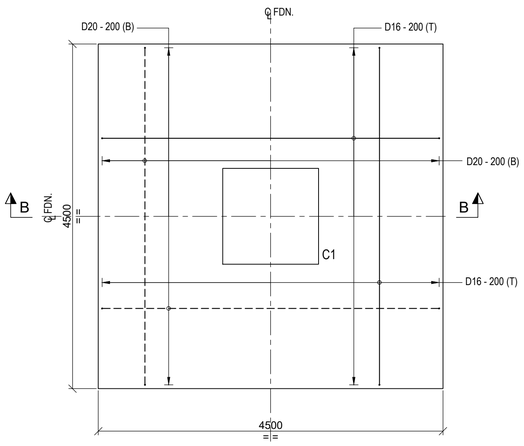


RCC. DETAIL OF FOUNDATION MKD. F1
SCALE 1:40

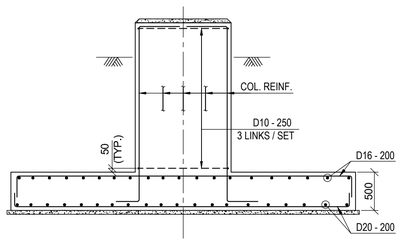


SECTION : B-B
SCALE 1:40

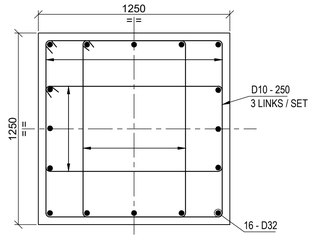


RCC. DET. OF C1
SCALE 1:20

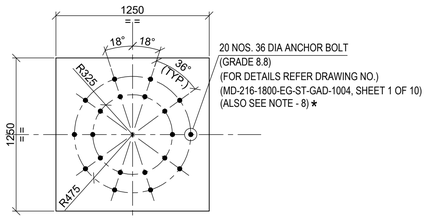



VIEW : A1-A1
SCALE 1:25

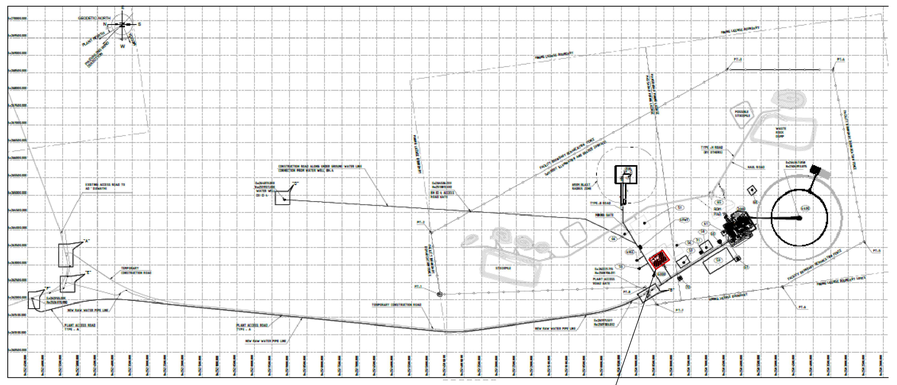

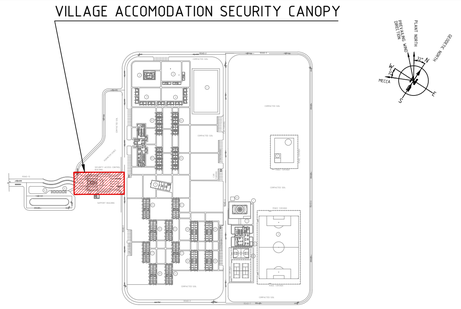


KEY PLAN
(SCALE- 1:2000)

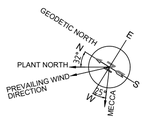


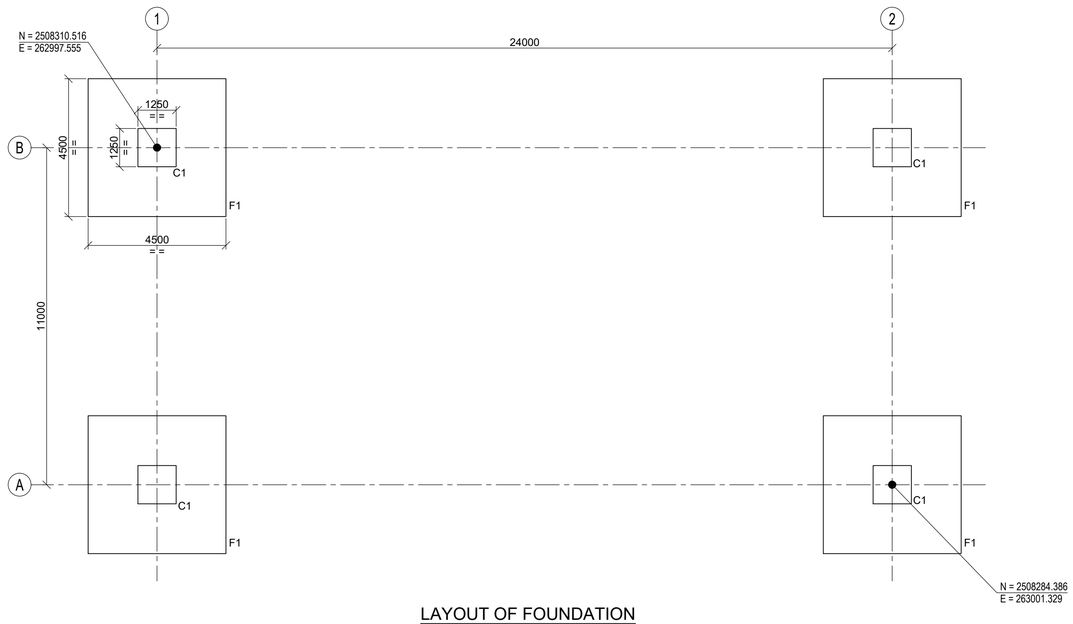

LAYOUT OF FOUNDATION
SCALE 1:100

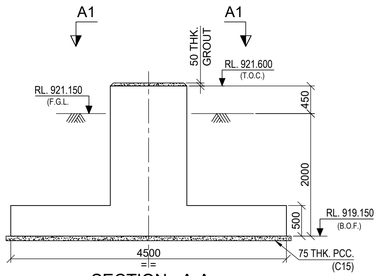

SECTION : A-A
SCALE 1:50

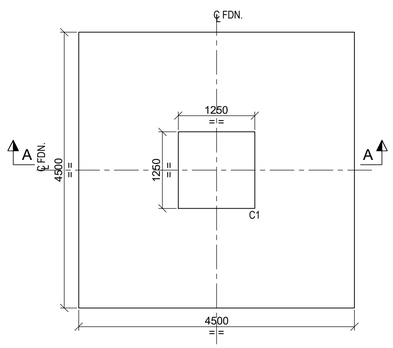

DETAIL OF FOUNDATION MKD. F1
SCALE 1:50

LEGEND :-

R.L. - REDUCED LEVEL
℄ - CENTRE LINE
T.O.C. - TOP OF CONCRETE
F.G.L. - FINISHED GROUND LEVEL
R.C - REINFORCED CONCRETE
B.O.F. - BOTTOM OF FOUNDATION
MKD. - MARKED
GA - GENERAL ARRANGEMENT
COL. - COLUMN
REINF. - REINFORCEMENT
TYP. - TYPICAL
P.C.C - PLAIN CEMENT CONCRETE
THK. - THICK
T.O.G. - TOP OF GROUT
DET. - DETAIL
DRG. - DRAWING
FDN. - FOUNDATION
R.C.C - REINFORCED CEMENT CONCRETE
BOTTOM REINFORCEMENT (B) - – – –
TOP REINFORCEMENT (T) - ———
CJ - CONSTRUCTION JOINT

NOTES:-

1. ALL DIMENSIONS ARE IN MILLIMETRES AND LEVELS AND CO-ORDINATES ARE IN METRES UNLESS OTHERWISE STATED.
2. NET SAFE BEARING CAPACITY OF SOIL AT BOTTOM OF FOUNDATION IS CONSIDERED AS 350KN/ SQ. M.
3. GRADE OF CONCRETE SHALL BE C35 (35Mpa) FOR FOUNDATION, C30 (30Mpa) FOR GRADE SLAB & C15 (15Mpa) FOR BLINDING CONCRETE.
4. GRADE OF REINFORCEMENT SHALL BE DEFORMED BAR 420 MPa (GRADE 60) - ASTM A615/A615M.
5. CLEAR COVER TO REINFORCEMENT SHALL BE AS FOLLOWS
   a) FOUNDATION = 50 mm
   b) COLUMN = 50mm
6. IF ANY PART OF FOUNDATION COMES ON BACKFILL ZONE OF ADJACENT FOUNDATION OR ANY LOOSE SOIL ARE ENCOUNTERED BELOW FOUNDATION LEVEL THE SAME SHALL BE REMOVED AND FILLED WITH PCC.
7. FOR STANDARD REINFORCEMENT DETAIL & GENERAL NOTES FOR CIVIL WORKS REFER DRAWING NO. MD-216-1000-EG-CV-DED-1005 & 1001.

★ 8. FOUNDATION H.D. BOLTS SHALL BE CAST-IN-SITU TYPE AND NOT CHEMICAL / MECHANICAL ANCHOR IN ANY CASE.

DOCUMENT NUMBER	REFERENCE DOCUMENTS	REV	DATE	REVISION DESCRIPTION	DRN	CHK	ENG	APP	EMP
		D01	28/02/2023	AS-BUILT	SYA	SJM	AVG	AG	
	HEALTH & SAFETY & SECURITY AND RISK:VAS CANOPY	C01	19/10/2021	ISSUED FOR CONSTRUCTION & REVISED AS PER EMPLOYER	SYA	SJM	AVG	AG	
MD-216-1800-EG-ST-GAD-1004	STRUCTURAL SHED PLAN, ELEVATION & SECTION			COMMENTS DATED 16/10/2021					
		A01	20/09/2021	ISSUED FOR APPROVAL	SYA	SJM	AVG	AG	

RESERVED FOR VENDOR LOGO AND DRAWING NUMBER

LARSEN & TOUBRO
This drawing is the property of LARSEN & TOUBRO and must not be passed on to any person or body not authorized by us to receive it nor be copied or otherwise made use either in full or in part by such person or body without our prior permission in writing.

Outotec
The content of these documents are the sole property of Outotec Oyj. Any rights not expressly granted herein are reserved. Reproduction, transfer or distribution of part or all of the contents in any form without prior written permission of Outotec is prohibited.

MA'ADEN معادن
Saudi Arabian Mining Company شركة التعدين العربية السعودية
This document and the information contained herein is Ma'aden proprietary know-how. This document or any part thereof should not be reproduced, stored in a retrieval system or transmitted by any means, electronic or otherwise, or divulged without prior written permission of Ma'aden.

LARSEN & TOUBRO DRAWING NUMBER	019045_900_C_G_24658_004	REVISION 2
OUTOTEC DRAWING NUMBER	900707__GAU01__AN02__MTL01__18202	DOCUMENT ID OU100730707 / REVISION 2

DRAWN	SYA	17/09/2021
CHECKED	SJM	18/09/2021
ENGINEER	AVG	17/09/2021
APPROVED	AG	20/09/2021
EMPLOYER		
SCALE	1:100, 50, 25, 40, 20	A1

MANSOURAH - MASSARAH GOLD PROJECT
GENERAL ARRANGEMENT DRAWING
HEALTH & SAFETY & SECURITY AND RISK:VILLAGE ACCOMODATION SECURITY CANOPY
FOUNDATION LAYOUT, PLAN & ELEVATION

DRAWING NUMBER: MD - 216 - 1800 - EG - CV - GAD - 1583
REV: D01