


DRAWING NUMBER: MD-216-1800-EG-CV-GAD-1588 | REV: D01

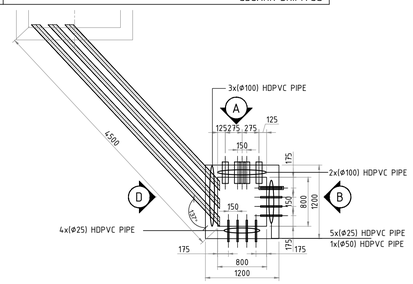



HAND HOLE
(MKD. HH-0001)

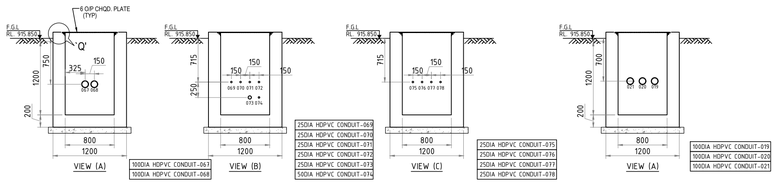

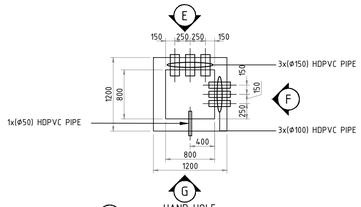



HAND HOLE
(MKD. HH-0002)

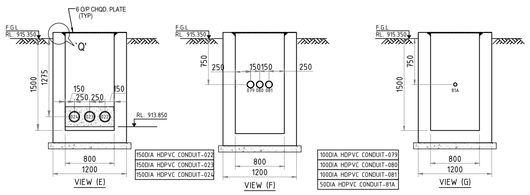

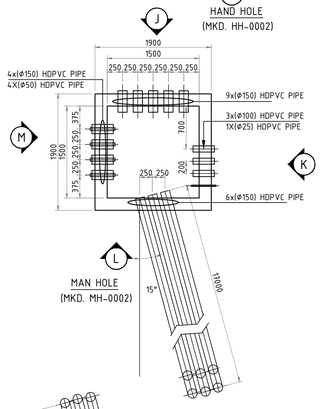


MAN HOLE
(MKD. MH-0002)

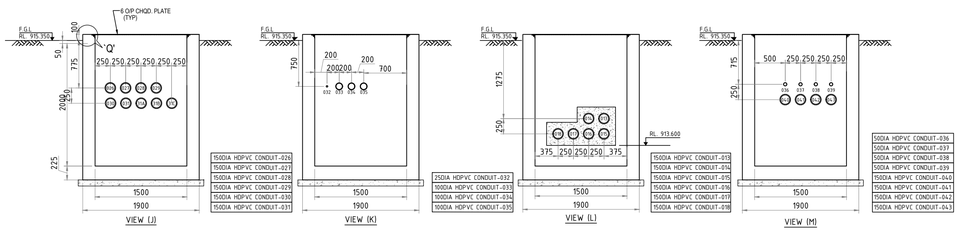

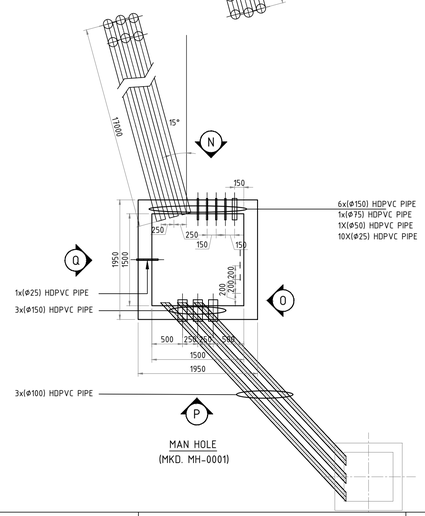

MAN HOLE
(MKD. MH-0001)

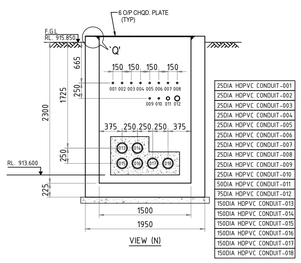

LEGEND :-

R.L. - REDUCED LEVEL
℄ - CENTRE LINE
T.O.C. - TOP OF CONCRETE
F.G.L. - FINISHED GROUND LEVEL
R.C - REINFORCED CONCRETE
B.O.F. - BOTTOM OF FOUNDATION
MKD. - MARKED
GA - GENERAL ARRANGEMENT
COL. - COLUMN
REINF. - REINFORCEMENT
TYP. - TYPICAL
P.C.C - PLAIN CEMENT CONCRETE
THK. - THICK
T.O.G. - TOP OF GROUT
DET. - DETAIL
DRG. - DRAWING
FDN. - FOUNDATION
R.C.C - REINFORCED CEMENT CONCRETE
BOTTOM REINFORCEMENT (B) - _____
TOP REINFORCEMENT (T) - _____
CJ - CONSTRUCTION JOINT

NOTES:-

1. ALL DIMENSIONS ARE IN MILLIMETRES AND LEVELS AND CO-ORDINATES ARE IN METRES UNLESS OTHERWISE STATED.
2. NET SAFE BEARING CAPACITY OF SOIL AT BOTTOM OF PIT IS CONSIDERED AS 100KN/ SQ. M.
3. GRADE OF CONCRETE SHALL BE C35 (35Mpa) & C15 (15Mpa) FOR BLINDING CONCRETE.
4. GRADE OF REINFORCEMENT SHALL BE DEFORMED BAR 420 MPa (GRADE 60) - ASTM A615/A615M.
5. CLEAR COVER TO REINFORCEMENT SHALL BE 50 mm.
6. IF ANY PART OF FOUNDATION COMES ON BACKFILL ZONE OF ADJACENT FOUNDATION OR ANY LOOSE SOIL ARE ENCOUNTERED BELOW FOUNDATION LEVEL THE SAME SHALL BE REMOVED AND FILLED WITH PCC.
7. FOR STANDARD REINFORCEMENT DETAIL & GENERAL NOTES FOR CIVIL WORKS REFER DRAWING NO. MD-216-1000-EG-CV-DED-1005 & 1001.
8. THIS DRAWING IS TO BE READ IN CONJUNCTION WITH DRAWING NO. MD-216-1800-EG-CV-GAD-1587 & 1589.

DOCUMENT NUMBER	REFERENCE DOCUMENTS			REVISION DESCRIPTION	DRN	CHK	ENG	APP	EMP
MD-216-1800-EG-CV-GAD-1589	DETAIL OF CABLE PITS & CONDUITS	D01	28/02/2023	AS-BUILT	SYA	SJM	AVG	AG	
MD-216-1800-EG-CV-GAD-1587	LAYOUT OF CABLE PITS & CONDUITS	C01	04/01/2022	ISSUED FOR CONSTRUCTION	SYA	SJM	AVG	AG	
MD-216-1800-HS-SY-LAD-V516-1139	1800 HEALTH & SAFETY & SECURITY AND RISK	A02	30/11/2021	REVISED AS PER EMPLOYER COMMENTS DATED 20/11/2021	SYA	SJM	AVG	AG	
	CABLE ROUTE (NON HCIS)	A01	30/10/2021	ISSUED FOR APPROVAL	SYA	SJM	AVG	AG	

RESERVED FOR VENDOR LOGO AND DRAWING NUMBER

LARSEN & TOUBRO

This drawing is the property of LARSEN & TOUBRO and must not be passed on to any person or body not authorized by us to receive it nor be copied or otherwise made use either in full or in part by such person or body without our prior permission in writing.

Outotec

The content of these documents are the sole property of Outotec Oyj. Any rights not expressly granted herein are reserved. Reproduction, transfer or distribution of part or all of the contents in any form without prior written permission of Outotec is prohibited.

MA'ADEN معادن
Saudi Arabian Mining Company شركة التعدين العربية السعودية

This document and the information contained herein is Ma'aden proprietary know-how. This document or any part thereof should not be reproduced, stored in a retrieval system or transmitted by any means, electronic or otherwise, or divulged without prior written permission of Ma'aden.

LARSEN & TOUBRO DRAWING NUMBER: 019045_900_C_G_24663_004 | REVISION: 3
OUTOTEC DRAWING NUMBER: 900707__GAU01__AN02__MTL01__18206 | DOCUMENT ID: OU100733903 | REVISION: 3

DRAWN	SYA	25/10/2021
CHECKED	SJM	27/10/2021
ENGINEER	AVG	25/10/2021
APPROVED	AG	30/10/2021
EMPLOYER		

SCALE: 1:100, 50, 25, 40, 20 | A1

MANSOURAH - MASSARAH GOLD PROJECT
GENERAL ARRANGEMENT DRAWING
HEALTH & SAFETY & SECURITY AND RISK : PROCESS PLANT
DETAIL OF CABLE PITS & CONDUITS

DRAWING NUMBER: MD-216-1800-EG-CV-GAD-1588 | REV: D01