DRAWING NUMBER
MD - 216 - 1800 - EG - CV - GAD - 1590
REV
D01

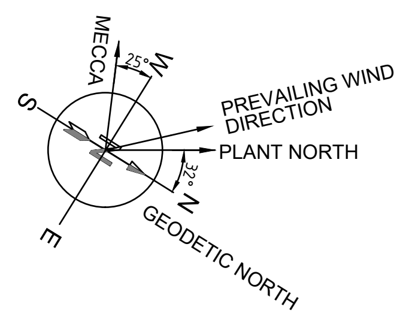

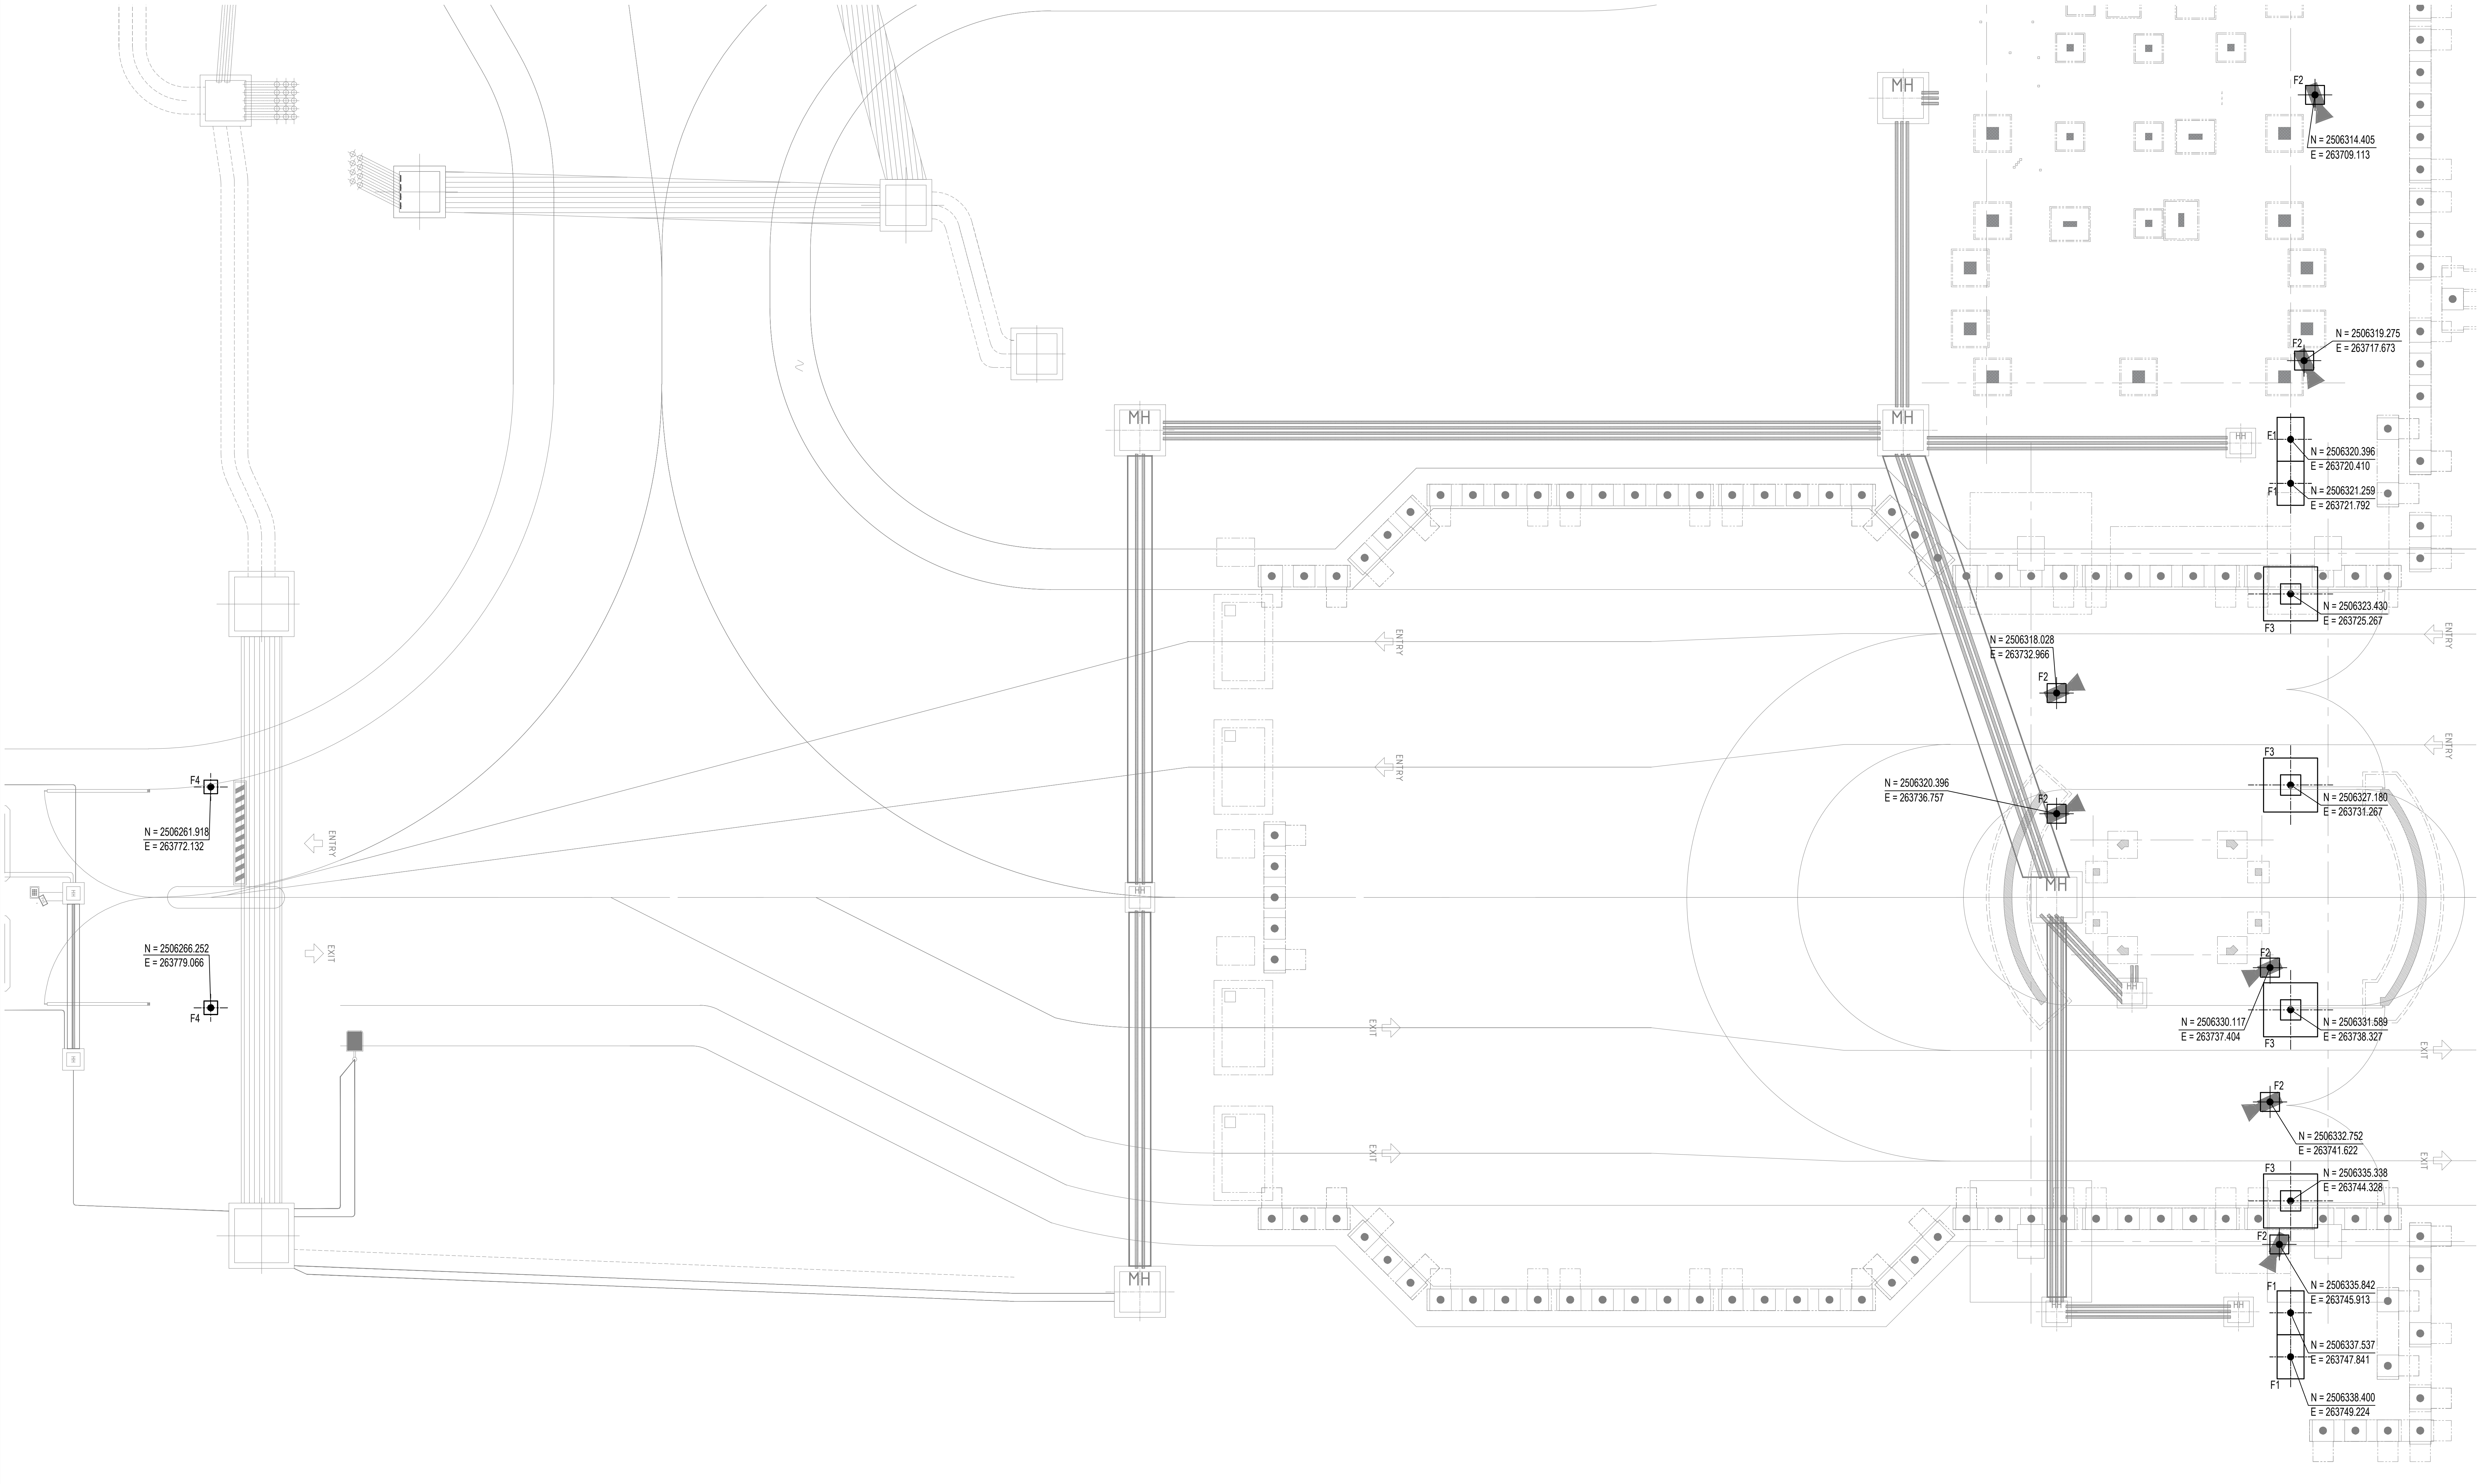

LAYOUT OF GATE, CAMERA POST & TURNSTILE FOUNDATION FOR PROCESS PLANT

(SCALE - 1:100)

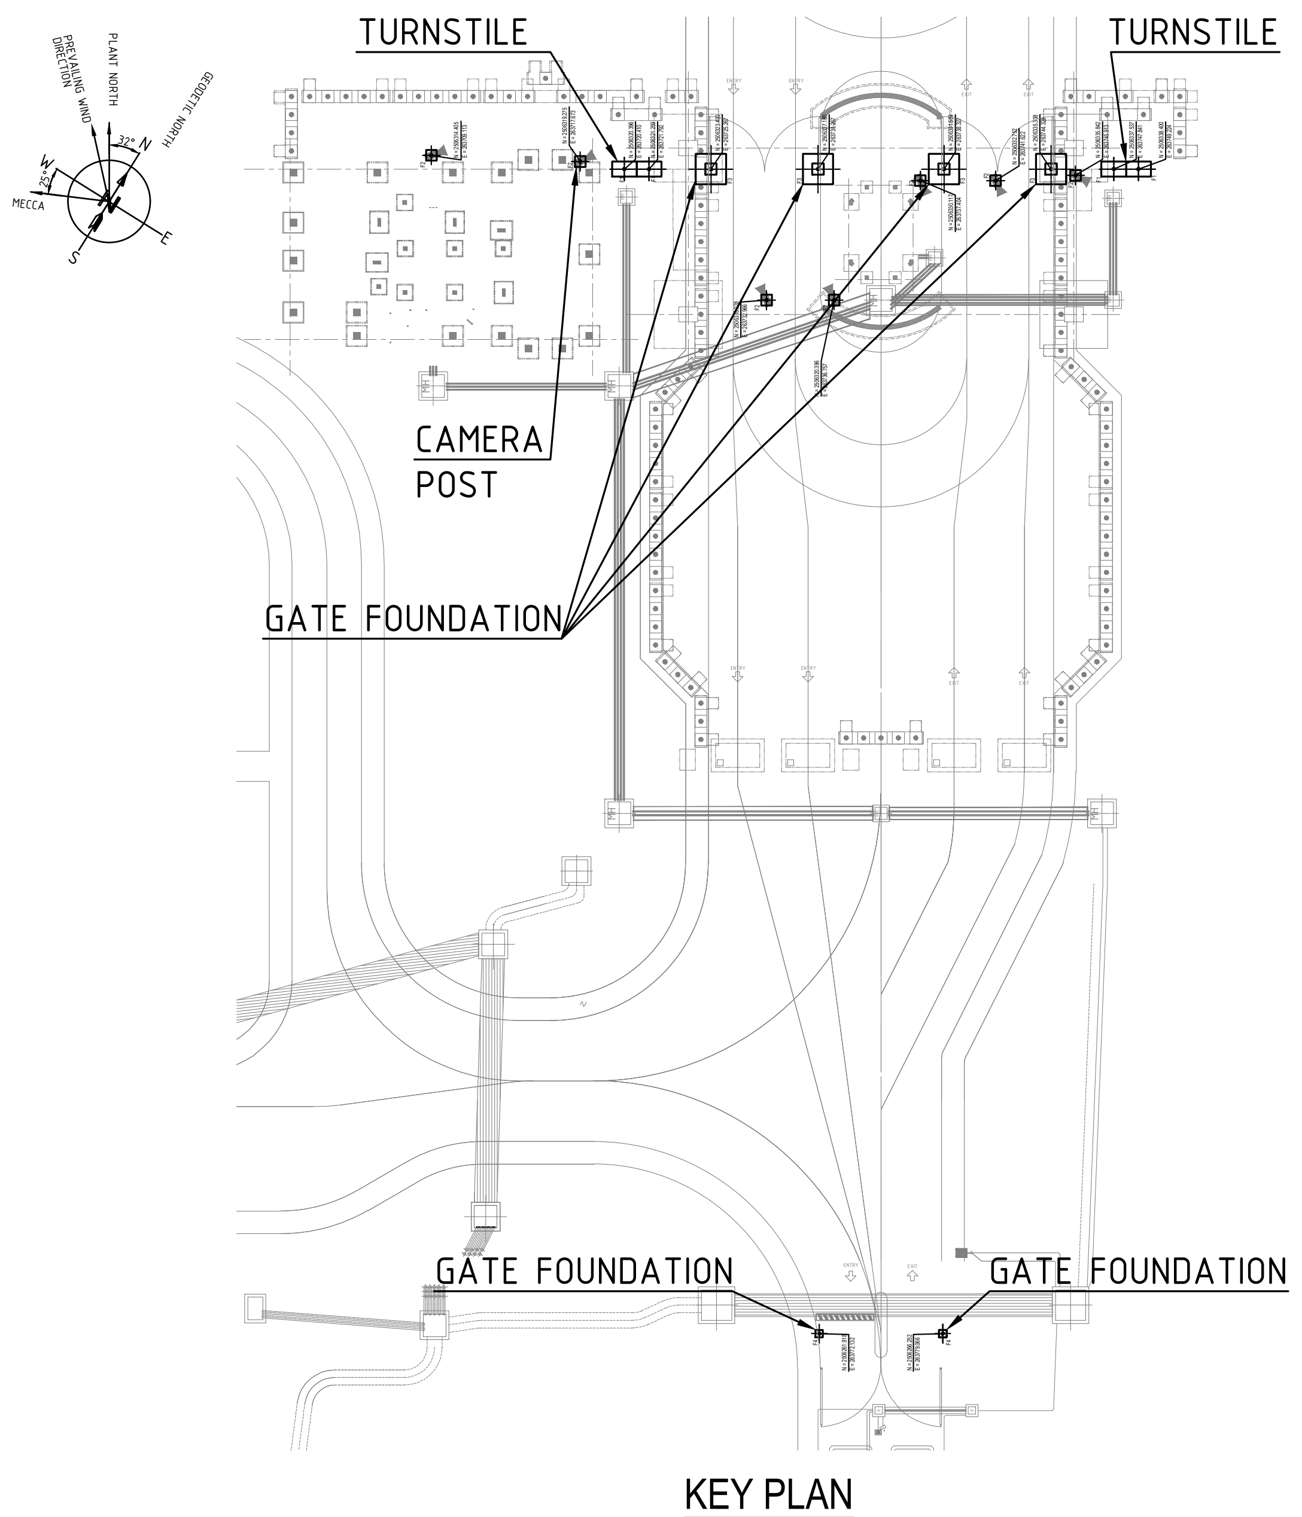

KEY PLAN
(SCALE- 1:500)

LEGEND :-

R.L. - REDUCED LEVEL
℄ - CENTRE LINE
T.O.C. - TOP OF CONCRETE
F.G.L. - FINISHED GROUND LEVEL
B.O.F. - BOTTOM OF FOUNDATION
MKD. - MARKED
GA - GENERAL ARRANGEMENT
COL. - COLUMN
TYP. - TYPICAL
P.C.C - PLAIN CEMENT CONCRETE
THK. - THICK
T.O.G. - TOP OF GROUT
DET. - DETAIL
DRG. - DRAWING
FDN. - FOUNDATION

NOTES:-

1. ALL DIMENSIONS ARE IN MILLIMETRES AND LEVELS AND CO-ORDINATES ARE IN METRES UNLESS OTHERWISE STATED.
2. NET SAFE BEARING CAPACITY OF SOIL AT BOTTOM OF PIT IS CONSIDERED AS 100KN/ SQ. M.
3. GRADE OF CONCRETE SHALL BE C35 (35Mpa) & C15 (15Mpa) FOR BLINDING CONCRETE.
4. GRADE OF REINFORCEMENT SHALL BE DEFORMED BAR 420 MPa (GRADE 60) - ASTM A615/A615M.
5. IF ANY PART OF FOUNDATION COMES ON BACKFILL ZONE OF ADJACENT FOUNDATION OR ANY LOOSE SOIL ARE ENCOUNTERED BELOW FOUNDATION LEVEL THE SAME SHALL BE REMOVED AND FILLED WITH PCC.
6. FOR STANDARD REINFORCEMENT DETAIL & GENERAL NOTES FOR CIVIL WORKS REFER DRAWING NO. MD-216-1000-EG-CV-DED-1005 & 1001.
7. FOR DETAILS OF GATE FOUNDATIONS (F3 & F4) REFER DRAWING NO. MD-216-1800-HS-SY-GAD-V516-1625.
8. FOR DETAILS OF TURNSTILE FOUNDATIONS (F1) REFER DRAWING NO. MD-216-1800-HS-SY-GAD-V516-1624.
9. FOR DETAILS OF CAMERA POST (F2) REFER DRAWING NO. MD-216-1800-HS-SY-GAD-V516-1629.

DOCUMENT NUMBER	REFERENCE DOCUMENTS			REVISION DESCRIPTION	DRN	CHK	ENG	APP	EMP
MD-216-1800-HS-SY-LAD-V516-1624	HEALTH & SAFETY & SECURITY AND RISK								
	PP & VAS - INST. DETAILS FOR TURNSTILES								
MD-216-1800-HS-SY-LAD-V516-1629	HEALTH & SAFETY & SECURITY AND RISK								
	EMS-CAMERA POLE FOUNDATION & POLE STUDY								
MD-216-1800-HS-SY-LAD-V516-1625	HEALTH & SAFETY & SECURITY AND RISK	D01	28/02/2023	AS-BUILT	SYA	SJM	AVG	AG	
	EXPLOSIVE PROCESS PLANT &	C01	12/01/2022	ISSUED FOR CONSTRUCTION & REVISED AS PER EMPLOYER	SYA	SJM	AVG	AG	
	ACCOMODATION INSTALLATION DETAIL FOR			COMMENTS DATED 08/01/2022					
	SWING/SLIDING GATE	A01	13/12/2021	ISSUED FOR APPROVAL	SYA	SJM	AVG	AG	

RESERVED FOR VENDOR LOGO AND DRAWING NUMBER

LARSEN & TOUBRO

This drawing is the property of LARSEN & TOUBRO and must not be passed on to any person or body not authorized by us to receive it nor be copied or otherwise made use either in full or in part by such person or body without our prior permission in writing.

Outotec

The content of these documents are the sole property of Outotec Oyj. Any rights not expressly granted herein are reserved. Reproduction, transfer or distribution of part or all of the contents in any form without prior written permission of Outotec is prohibited.

MA'ADEN معادن
Saudi Arabian Mining Company شركة التعدين العربية السعودية

This document and the information contained herein is Ma'aden proprietary know-how. This document or any part thereof should not be reproduced, stored in a retrieval system or transmitted by any means, electronic or otherwise, or divulged without prior written permission of Ma'aden.

LARSEN & TOUBRO DRAWING NUMBER
019045_900_C_G_24663_006
REVISION
2

OUTOTEC DRAWING NUMBER
900707 __GAU01 __AN02__MTL01 __18208
DOCUMENT ID
OU100733905
REVISION
2

DRAWN	SYA	01/12/2021
CHECKED	SJM	02/12/2021
ENGINEER	AVG	01/12/2021
APPROVED	AG	13/12/2021
EMPLOYER		
SCALE	1:100, 50, 25, 40, 20	A1

MANSOURAH - MASSARAH GOLD PROJECT
GENERAL ARRANGEMENT DRAWING
HEALTH & SAFETY & SECURITY AND RISK:PROCESS PLANT
LAYOUT OF GATE,CAMERA POST & TURNSTILE FDN.

DRAWING NUMBER
MD - 216 - 1800 - EG - CV - GAD - 1590
REV
D01