


DRAWING NUMBER: MD-216-1800-EG-CV-GAD-1591 | REV: D01

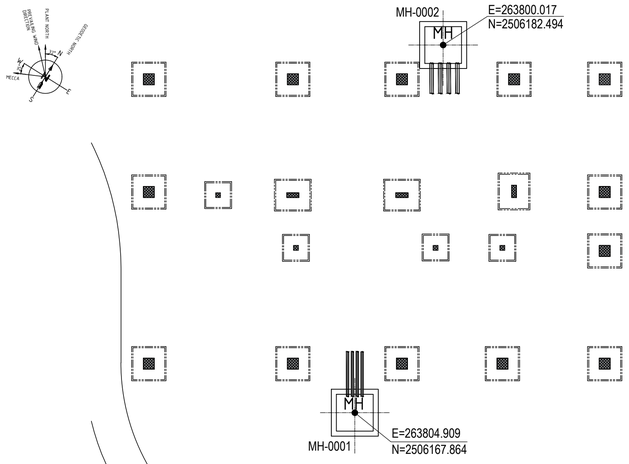


LAYOUT OF PITS & CONDUITS
FOR SECURITY CONTROL CENTRE
(SCALE- 1:100)

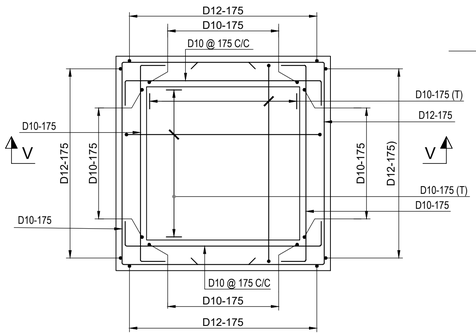


R.C. PLAN OF PULL PIT,
MAN HOLE AND HAND HOLE
(SCALE 1:30)

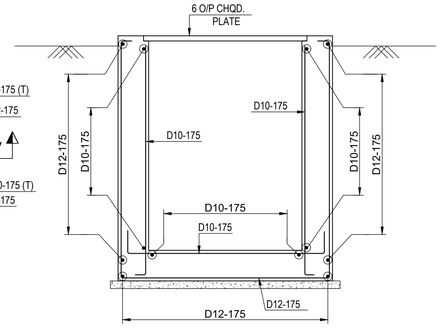


SECTION V - V
(SCALE 1:30)

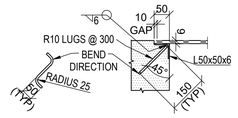


DETAIL - Q
(SCALE 1:10)

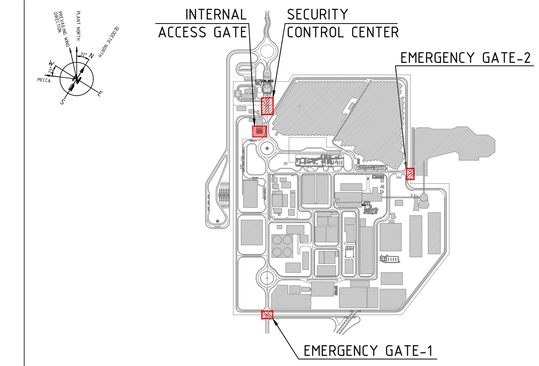


KEY PLAN

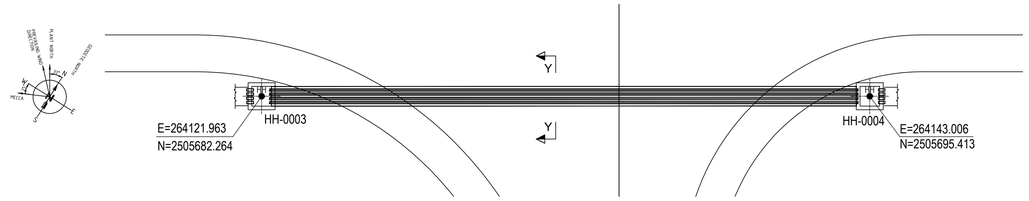


LAYOUT OF PITS & CONDUITS
FOR EMERGENCY GATE-1
(SCALE- 1:100)

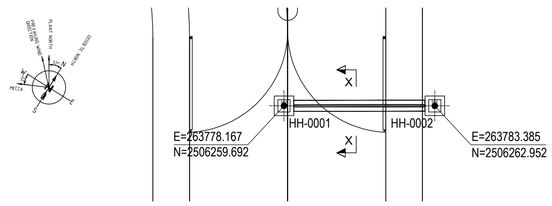


LAYOUT OF PITS & CONDUITS
FOR INTERNAL SEPARATION GATE
(SCALE- 1:100)

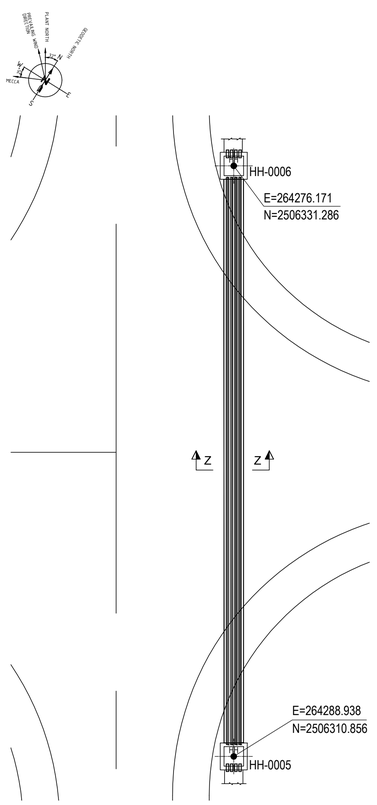


LAYOUT OF PITS & CONDUITS
FOR EMERGENCY GATE-2
(SCALE- 1:100)

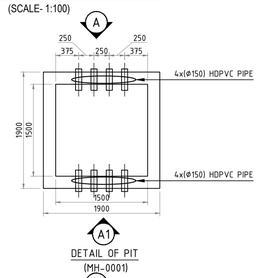


DETAIL OF PIT
(MH-0001)

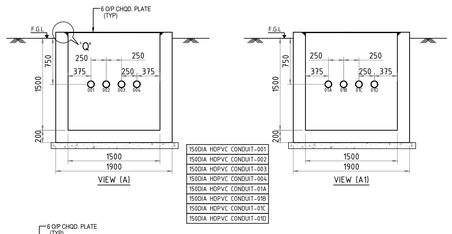


1500IA HDPVC CONDUIT-001	
1500IA HDPVC CONDUIT-002	
1500IA HDPVC CONDUIT-003	
1500IA HDPVC CONDUIT-004	
1500IA HDPVC CONDUIT-01A	
1500IA HDPVC CONDUIT-01B	
1500IA HDPVC CONDUIT-01C	
1500IA HDPVC CONDUIT-01D	

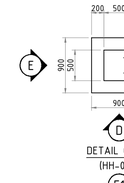


DETAIL OF PIT
(HH-0001)

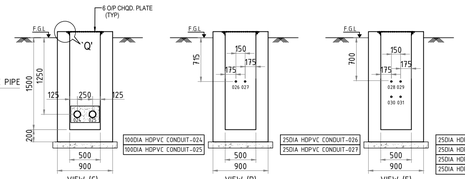

1000IA HDPVC CONDUIT-024	
1000IA HDPVC CONDUIT-025	

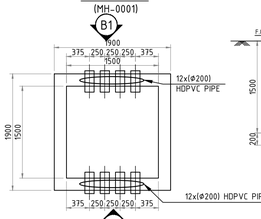


DETAIL OF PIT
(MH-0002)

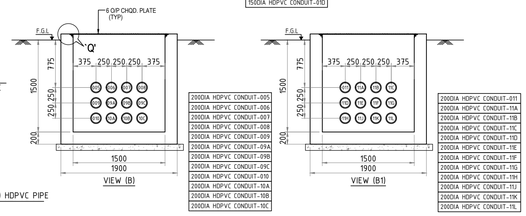


2000IA HDPVC CONDUIT-005	
2000IA HDPVC CONDUIT-006	
2000IA HDPVC CONDUIT-007	
2000IA HDPVC CONDUIT-008	
2000IA HDPVC CONDUIT-009	
2000IA HDPVC CONDUIT-09A	
2000IA HDPVC CONDUIT-09B	
2000IA HDPVC CONDUIT-09C	
2000IA HDPVC CONDUIT-010	
2000IA HDPVC CONDUIT-10A	
2000IA HDPVC CONDUIT-10B	
2000IA HDPVC CONDUIT-10C	


2000IA HDPVC CONDUIT-011	
2000IA HDPVC CONDUIT-11A	
2000IA HDPVC CONDUIT-11B	
2000IA HDPVC CONDUIT-11C	
2000IA HDPVC CONDUIT-11D	
2000IA HDPVC CONDUIT-11E	
2000IA HDPVC CONDUIT-11F	
2000IA HDPVC CONDUIT-11G	
2000IA HDPVC CONDUIT-11H	
2000IA HDPVC CONDUIT-11I	
2000IA HDPVC CONDUIT-11K	
2000IA HDPVC CONDUIT-11L	

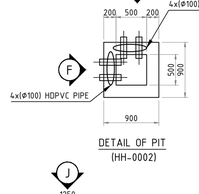

DETAIL OF PIT
(HH-0002)

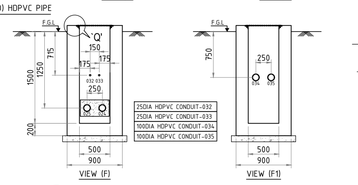


2500A HDPVC CONDUIT-032	
2500A HDPVC CONDUIT-033	
1000IA HDPVC CONDUIT-034	
1000IA HDPVC CONDUIT-035	

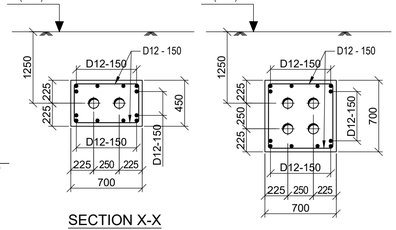


SECTION X-X
(R.C DETAILS)
SCALE 1:30

SECTION Y-Y
(R.C DETAILS)
SCALE 1:30

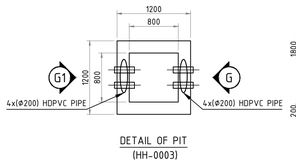


DETAIL OF PIT
(HH-0003)

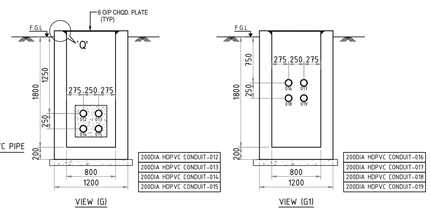


2000IA HDPVC CONDUIT-012	
2000IA HDPVC CONDUIT-013	
2000IA HDPVC CONDUIT-014	
2000IA HDPVC CONDUIT-015	

2000IA HDPVC CONDUIT-016	
2000IA HDPVC CONDUIT-017	
2000IA HDPVC CONDUIT-018	
2000IA HDPVC CONDUIT-019	

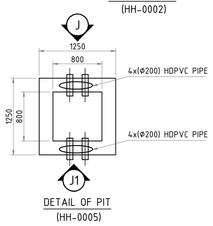


DETAIL OF PIT
(HH-0005)

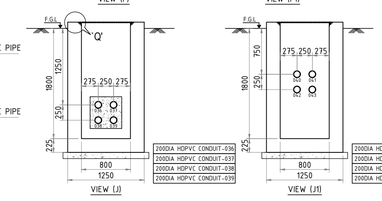


2000IA HDPVC CONDUIT-036	
2000IA HDPVC CONDUIT-037	
2000IA HDPVC CONDUIT-038	
2000IA HDPVC CONDUIT-039	


2000IA HDPVC CONDUIT-040	
2000IA HDPVC CONDUIT-041	
2000IA HDPVC CONDUIT-042	
2000IA HDPVC CONDUIT-043	

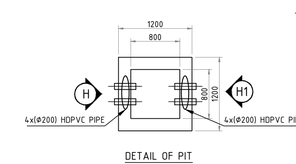


DETAIL OF PIT
(HH-0004)

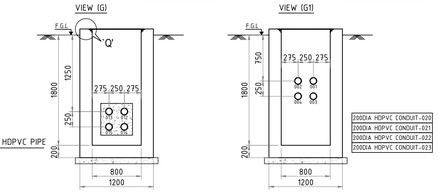


2000IA HDPVC CONDUIT-020	
2000IA HDPVC CONDUIT-021	
2000IA HDPVC CONDUIT-022	
2000IA HDPVC CONDUIT-023	

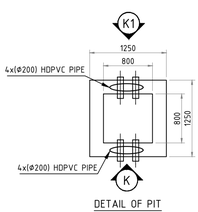

DETAIL OF PIT
(HH-0006)

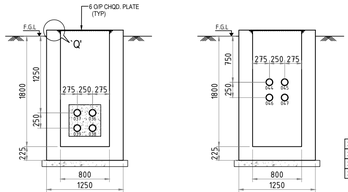

2000IA HDPVC CONDUIT-044	
2000IA HDPVC CONDUIT-045	
2000IA HDPVC CONDUIT-046	
2000IA HDPVC CONDUIT-047	

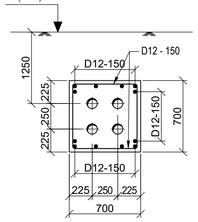

SECTION Z-Z
(R.C DETAILS)
SCALE 1:30

LEGEND :-

R.L. - REDUCED LEVEL
℄ - CENTRE LINE
T.O.C. - TOP OF CONCRETE
F.G.L. - FINISHED GROUND LEVEL
R.C - REINFORCED CONCRETE
B.O.F. - BOTTOM OF FOUNDATION
MKD. - MARKED
GA - GENERAL ARRANGEMENT
COL. - COLUMN
REINF. - REINFORCEMENT
TYP. - TYPICAL
P.C.C - PLAIN CEMENT CONCRETE
Ø - DIAMETER
DIA - DIAMETER
THK. - THICK
DRG. - DRAWING
FDN. - FOUNDATION
R.C.C - REINFORCED CEMENT CONCRETE
CHQD. - CHEQUERED
CJ - CONSTRUCTION JOINT
HDPVC - HIGH DENSITY POLYETHYLENE PIPE

NOTES:-

1. ALL DIMENSIONS ARE IN MILLIMETRES AND LEVELS AND CO-ORDINATES ARE IN METRES UNLESS OTHERWISE STATED.
2. NET SAFE BEARING CAPACITY OF SOIL AT BOTTOM OF PIT IS CONSIDERED AS 100KN/ SQ. M.
3. GRADE OF CONCRETE SHALL BE C35 (35Mpa) & C15 (15Mpa) FOR BLINDING CONCRETE.
4. GRADE OF REINFORCEMENT SHALL BE DEFORMED BAR 420 MPa (GRADE 60) - ASTM A615/A615M.
5. CLEAR COVER TO REINFORCEMENT SHALL BE 50 mm.
6. IF ANY PART OF FOUNDATION COMES ON BACKFILL ZONE OF ADJACENT FOUNDATION OR ANY LOOSE SOIL ARE ENCOUNTERED BELOW FOUNDATION LEVEL THE SAME SHALL BE REMOVED AND FILLED WITH PCC.
7. FOR STANDARD REINFORCEMENT DETAIL & GENERAL NOTES FOR CIVIL WORKS REFER DRAWING NO. MD-216-1000-EG-CV-DED-1005 & 1001.
8. THIS DRAWING IS TO BE READ IN CONJUNCTION WITH DRAWING NO. MD-216-1800-HS-SY-LAD-V516-1139.

DOCUMENT NUMBER	REFERENCE DOCUMENTS			REVISION DESCRIPTION	DRN	CHK	ENG	APP	EMP
		D01	28/02/2023	AS-BUILT	SYA	SJM	AVG	AG	
		C01	19/01/2022	ISSUED FOR CONSTRUCTION & REVISED AS PER EMPLOYER	SYA	SJM	AVG	AG	
MD-216-1800-HS-SY-LAD-V516-1139	1800 HEALTH & SAFETY & SECURITY AND RISK			COMMENTS DATED 12/01/2022					
	CABLE ROUTE (NON HCIS)	A01	21/12/2021	ISSUED FOR APPROVAL	SYA	SJM	AVG	AG	

RESERVED FOR VENDOR LOGO AND DRAWING NUMBER

LARSEN & TOUBRO

This drawing is the property of LARSEN & TOUBRO and must not be passed on to any person or body not authorized by us to receive it nor be copied or otherwise made use either in full or in part by such person or body without our prior permission in writing.

Outotec

The content of these documents are the sole property of Outotec Oyj. Any rights not expressly granted herein are reserved. Reproduction, transfer or distribution of part or all of the contents in any form without prior written permission of Outotec is prohibited.

MA'ADEN معادن
Saudi Arabian Mining Company شركة المعادن العربية السعودية

This document and the information contained herein is Ma'aden proprietary know-how. This document or any part thereof should not be reproduced, stored in a retrieval system or transmitted by any means, electronic or otherwise, or divulged without prior written permission of Ma'aden.

LARSEN & TOUBRO DRAWING NUMBER		REVISION
019045_900_C_G_24663_007		2
OUTOTEC DRAWING NUMBER	DOCUMENT ID	REVISION
900707__GAU01__AN02__MTL01__18209	OU100733906	2

DRAWN	SYA	13/12/2021
CHECKED	SJM	14/12/2021
ENGINEER	AVG	13/12/2021
APPROVED	AG	21/12/2021
EMPLOYER		
SCALE	1:100, 50, 25, 40, 20	A1

MANSOURAH - MASSARAH GOLD PROJECT
GENERAL ARRANGEMENT DRAWING
HEALTH & SAFETY & SECURITY AND RISK:PROCESS PLANT
LAYOUT & DETAIL OF CABLE PITS & CONDUITS

DRAWING NUMBER: MD-216-1800-EG-CV-GAD-1591 | REV: D01