


DRAWING NUMBER: MD-216-1800-EG-CV-GAD-1596
REV: D01

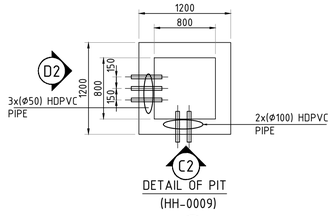



DETAIL OF PIT
(HH-0009)

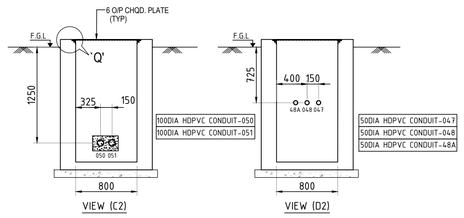


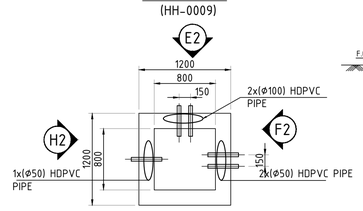


DETAIL OF PIT
(HH-0010)

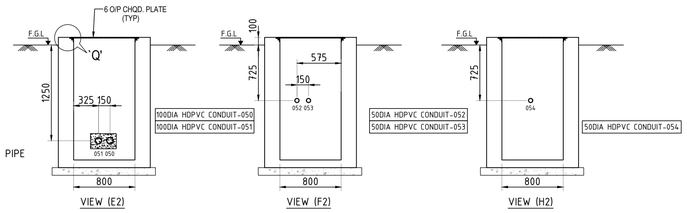

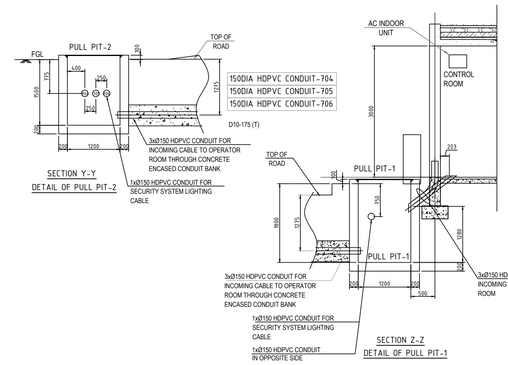


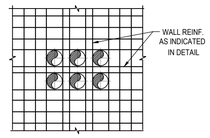


TYP. DETAIL OF WALL REINF.
NEAR PIPES
(SCALE 1:30)

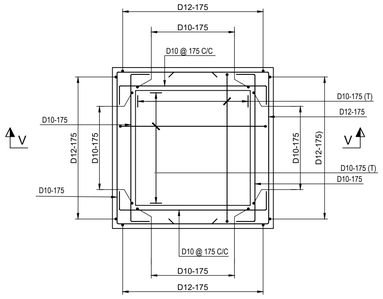


R.C. PLAN OF PULL PIT,
MAN HOLE AND HAND HOLE
(SCALE 1:30)

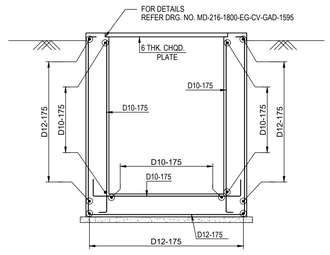


SECTION V - V
(SCALE 1:30)

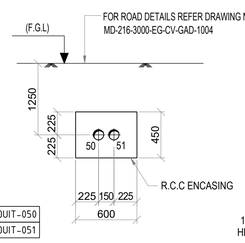


SECTION X1-X1
SCALE 1:30

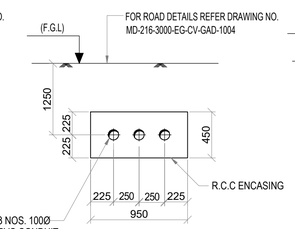


SECTION X4-X4
SCALE 1:30

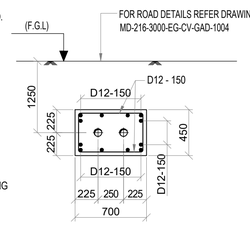


SECTION X5-X5
(R.C DETAILS)
SCALE 1:30

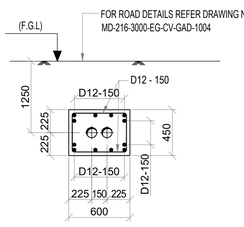


SECTION X1-X1
(R.C DETAILS)
SCALE 1:30

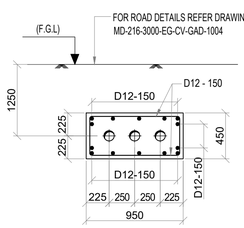


SECTION X4-X4
(R.C DETAILS)

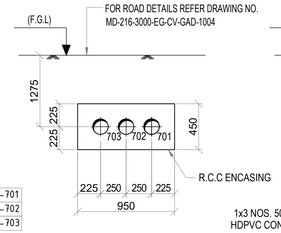


SECTION X2-X2
SCALE 1:30

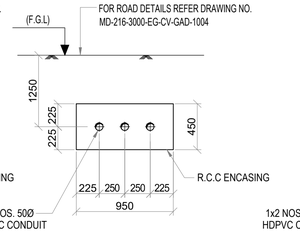


SECTION X3-X3
SCALE 1:30

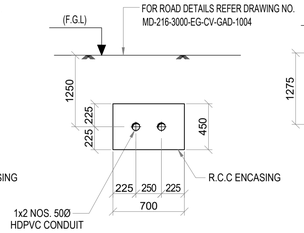

SECTION X5-X5
SCALE 1:30

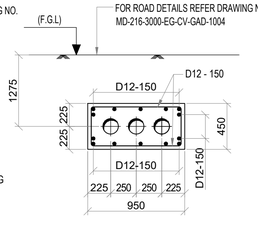

SECTION X2-X2
(R.C DETAILS)
SCALE 1:30

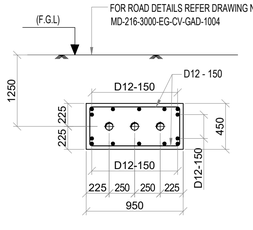

SECTION X3-X3
(R.C DETAILS)
SCALE 1:30

LEGEND :-

R.L. - REDUCED LEVEL
C - CENTRE LINE
T.O.C. - TOP OF CONCRETE
E.G.L. - FINISHED GROUND LEVEL
R.C - REINFORCED CONCRETE
B.O.F. - BOTTOM OF FOUNDATION
MKD. - MARKED
GA - GENERAL ARRANGEMENT
COL. - COLUMN
REINF. - REINFORCEMENT
TYP. - TYPICAL
P.C.C - PLAIN CEMENT CONCRETE
Ø - DIAMETRE
DIA - DIAMETRE
THK. - THICK
DRG. - DRAWING
FDN. - FOUNDATION
R.C.C - REINFORCED CEMENT CONCRETE
BOTTOM REINFORCEMENT (B) - ———
TOP REINFORCEMENT (T) - ———
CJ - CONSTRUCTION JOINT
HDPVC - HIGH DENSITY POLYETHYLENE PIPE

NOTES:-

1. ALL DIMENSIONS ARE IN MILLIMETRES AND LEVELS AND CO-ORDINATES ARE IN METRES UNLESS OTHERWISE STATED.
2. NET SAFE BEARING CAPACITY OF SOIL AT BOTTOM OF FOUNDATION IS CONSIDERED AS 100KN/ SQ. M.
3. GRADE OF CONCRETE SHALL BE C35 (35Mpa) & C15 (15Mpa) FOR BLINDING CONCRETE.
4. GRADE OF REINFORCEMENT SHALL BE DEFORMED BAR 420 MPa (GRADE 60) - ASTM A615/A615M.
5. CLEAR COVER TO REINFORCEMENT SHALL BE 50 mm.
6. IF ANY PART OF FOUNDATION COMES ON BACKFILL ZONE OF ADJACENT FOUNDATION OR ANY LOOSE SOIL ARE ENCOUNTERED BELOW FOUNDATION LEVEL THE SAME SHALL BE REMOVED AND FILLED WITH PCC.
7. FOR STANDARD REINFORCEMENT DETAIL & GENERAL NOTES FOR CIVIL WORKS REFER DRAWING NO. MD-216-1000-EG-CV-DED-1005 & 1001.
8. THIS DRAWING IS TO BE READ IN CONJUNCTION WITH DRAWING NO. MD-216-1800-EG-CV-GAD-1594 & 1595.
9. EARTHWORKS FOR ROAD CROSSINGS SHALL BE CONSTRUCTED PER 5.15 OF MD-101-SMEM-EG-CV-SPC-0003.

DOCUMENT NUMBER	REFERENCE DOCUMENTS			REVISION DESCRIPTION	DRN	CHK	ENG	APP	EMP
		D01	01/03/2023	AS-BUILT	SYA	SJM	AVG	AG	
		C01	08/02/2022	ISSUED FOR CONSTRUCTION & REVISED AS PER EMPLOYER	SYA	SJM	AVG	AG	
MD-216-1800-EG-CV-GAD-1195	DETAIL OF CABLE PITS & CONDUITS			COMMENTS DATED 08/02/2022					
MD-216-1800-EG-CV-GAD-1194	LAYOUT OF CABLE PITS & CONDUITS	A02	12/01/2022	REVISED AS PER EMPLOYER COMMENTS DATED 08/01/2022	SYA	SJM	AVG	AG	
MD-216-1800-HS-SY-LAD-V516-1134	CABLE ROUTE PIC GATE	A01	06/12/2021	ISSUED FOR APPROVAL	SYA	SJM	AVG	AG	

RESERVED FOR VENDOR LOGO AND DRAWING NUMBER

LARSEN & TOUBRO DRAWING NUMBER: 019045_900_C_G_24664_005 — REVISION: 3
OUTOTEC DRAWING NUMBER: 900707__GAU01__AN02__MTL01__18213 — DOCUMENT ID: OU100733911 — REVISION: 3

LARSEN & TOUBRO
This drawing is the property of LARSEN & TOUBRO and must not be passed on to any person or body not authorized by us to receive it nor be copied or otherwise made use either in full or in part by such person or body without our prior permission in writing.

Outotec
The content of these documents are the sole property of Outotec Oyj. Any rights not expressly granted herein are reserved. Reproduction, transfer or distribution of part or all of the contents in any form without prior written permission of Outotec is prohibited.

MA'ADEN معادن
Saudi Arabian Mining Company شركة التعدين العربية السعودية
This document and the information contained herein is Ma'aden proprietary know-how. This document or any part thereof should not be reproduced, stored in a retrieval system or transmitted by any means, electronic or otherwise, or divulged without prior written permission of Ma'aden.

DRAWN	SYA	29/11/2021	
CHECKED	SJM	30/11/2021	
ENGINEER	AVG	29/11/2021	
APPROVED	AG	06/12/2021	
EMPLOYER			
SCALE 1:100, 50, 25, 40, 20		A1	

MANSOURAH - MASSARAH GOLD PROJECT
GENERAL ARRANGEMENT DRAWING
HEALTH & SAFETY & SECURITY AND RISK : PIC AREA
DETAIL OF CABLE PITS & CONDUITS

DRAWING NUMBER: MD-216-1800-EG-CV-GAD-1596 — REV: D01