


DRAWING NUMBER MD - 216 - 1800 - EG - CV - GAD - 1599 REV D01

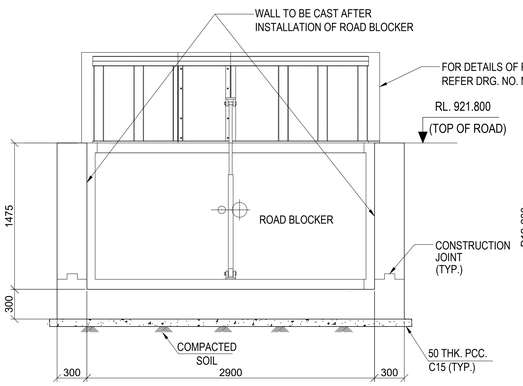


SECTION A-A
SCALE 1:30

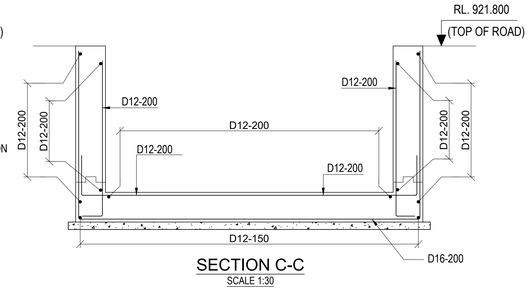


SECTION C-C
SCALE 1:30

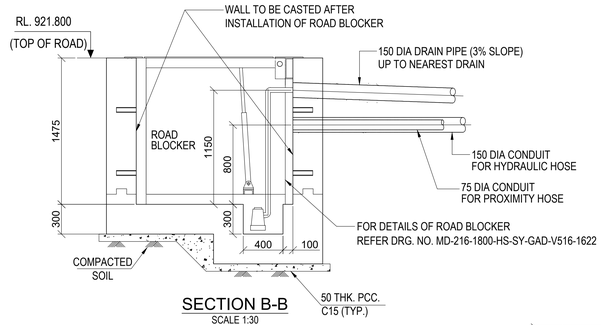


SECTION B-B
SCALE 1:30

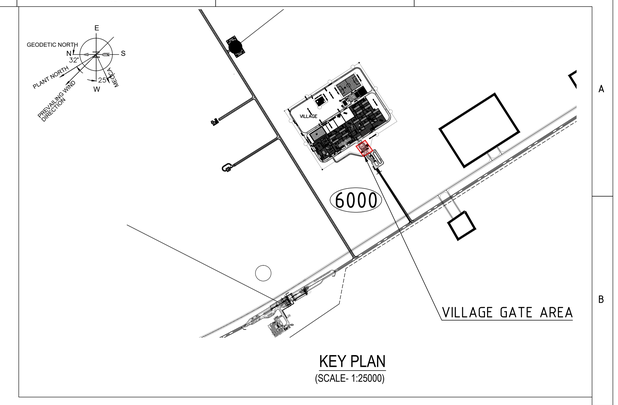


KEY PLAN
(SCALE- 1:25000)

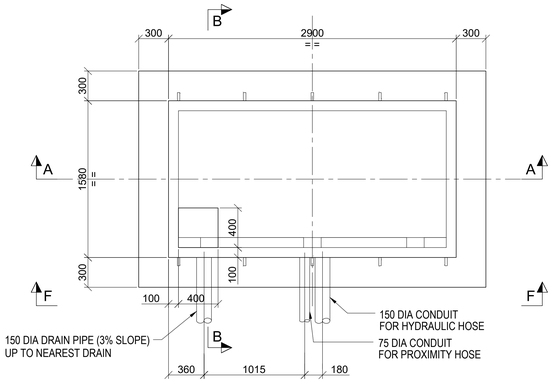


DETAIL OF FDN. MKD. F1
SCALE 1:30

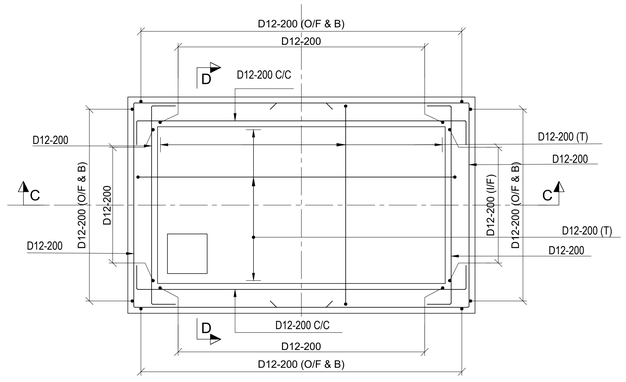


R.C. DETAIL OF FDN. MKD. F1
SCALE 1:30

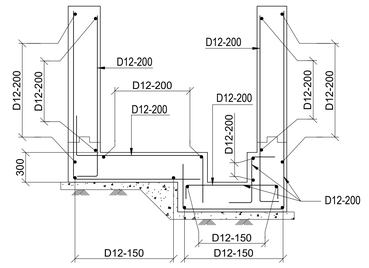


SECTION D-D
SCALE 1:30

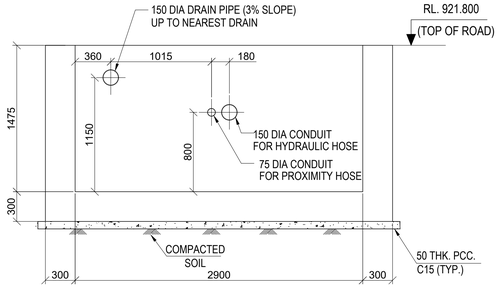


SECTION F-F
SCALE 1:30

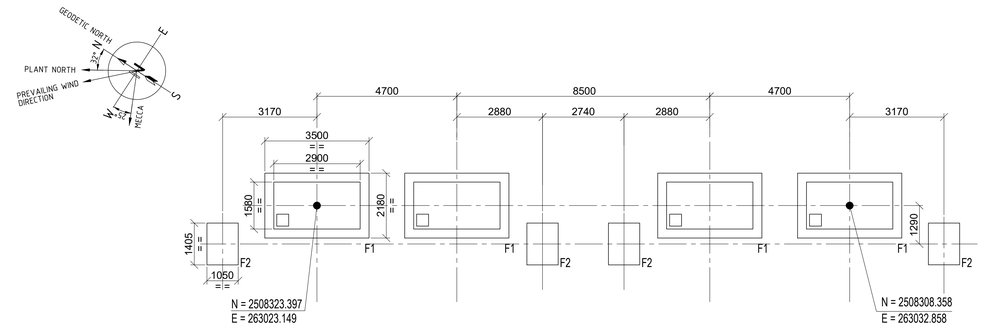


LAYOUT OF ROAD BLOCKER FOUNDATION (FOR VILLAGE AREA GATE)
(SCALE - 1:100)

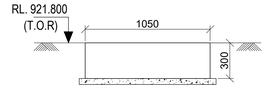

SECTION E-E
SCALE 1:25

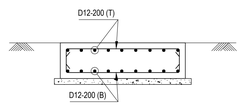

SECTION E-E
(R.C DETAILS)
SCALE 1:25

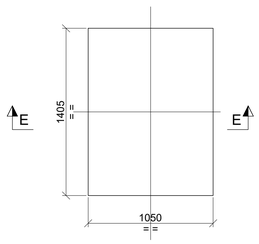

DETAIL OF FDN. MKD. F2
SCALE 1:25

LEGEND :-

R.L. - REDUCED LEVEL
℄ - CENTRE LINE
T.O.C. - TOP OF CONCRETE
F.G.L. - FINISHED GROUND LEVEL
R.C - REINFORCED CONCRETE
B.O.F. - BOTTOM OF FOUNDATION
MKD. - MARKED
GA - GENERAL ARRANGEMENT
COL. - COLUMN
REINF. - REINFORCEMENT
TYP. - TYPICAL
P.C.C - PLAIN CEMENT CONCRETE
Ø - DIAMETER
DIA - DIAMETER
THK. - THICK
DRG. - DRAWING
FDN. - FOUNDATION
R.C.C - REINFORCED CEMENT CONCRETE
BOTTOM REINFORCEMENT (B) -
TOP REINFORCEMENT (T) -
CJ - CONSTRUCTION JOINT
HDPVC - HIGH DENSITY POLYETHYLENE PIPE
T.O.R - TOP OF ROAD

NOTES:-

1. ALL DIMENSIONS ARE IN MILLIMETRES AND LEVELS AND CO-ORDINATES ARE IN METRES UNLESS OTHERWISE STATED.
2. NET SAFE BEARING CAPACITY OF SOIL AT BOTTOM OF FOUNDATION IS CONSIDERED AS 100KN/ SQ. M.
3. GRADE OF CONCRETE SHALL BE C35 (35Mpa) & C15 (15Mpa) FOR BLINDING CONCRETE.
4. GRADE OF REINFORCEMENT SHALL BE DEFORMED BAR 420 MPa (GRADE 60) - ASTM A615/A615M.
5. CLEAR COVER TO REINFORCEMENT SHALL BE 50 mm.
6. IF ANY PART OF FOUNDATION COMES ON BACKFILL ZONE OF ADJACENT FOUNDATION OR ANY LOOSE SOIL ARE ENCOUNTERED BELOW FOUNDATION LEVEL THE SAME SHALL BE REMOVED AND FILLED WITH PCC.
7. FOR STANDARD REINFORCEMENT DETAIL & GENERAL NOTES FOR CIVIL WORKS REFER DRAWING NO. MD-216-1000-EG-CV-DED-1005 & 1001.
8. THIS DRAWING IS TO BE READ IN CONJUNCTION WITH DRAWING NO. MD-216-1800-HS-SY-LAD-V516-1029.

DOCUMENT NUMBER	REFERENCE DOCUMENTS	REV	DATE	REVISION DESCRIPTION	DRN	CHK	ENG	APP	EMP
		D01	01/03/2023	AS-BUILT	SYA	SJM	AVG	AG	
		C01	12/01/2022	ISSUED FOR CONSTRUCTION & REVISED AS PER EMPLOYER	SYA	SJM	AVG	AG	
MD-216-1800-HS-SY-GAD-V516-1622	HEALTH & SAFETY & SECURITY AND RISK			COMMENTS DATED 08/01/2022					
	EMS,PPS & VAS - INST. DETAILS FOR ROBK.	A01	17/12/2021	ISSUED FOR APPROVAL	SYA	SJM	AVG	AG	

RESERVED FOR VENDOR LOGO AND DRAWING NUMBER

LARSEN & TOUBRO

This drawing is the property of LARSEN & TOUBRO and must not be passed on to any person or body not authorized by us to receive it nor be copied or otherwise made use either in full or in part by such person or body without our prior permission in writing.

Outotec

The content of these documents are the sole property of Outotec Oyj. Any rights not expressly granted herein are reserved. Reproduction, transfer or distribution of part or all of the contents in any form without prior written permission of Outotec is prohibited.

MA'ADEN معادن
Saudi Arabian Mining Company شركة المعادن العربية السعودية

This document and the information contained herein is Ma'aden proprietary know-how. This document or any part thereof should not be reproduced, stored in a retrieval system or transmitted by any means, electronic or otherwise, or divulged without prior written permission of Ma'aden.

LARSEN & TOUBRO DRAWING NUMBER	019045_900_C_G_24665_001	REVISION 2
OUTOTEC DRAWING NUMBER	900707 __GAU01 __AN02__MTL01 __18217	DOCUMENT ID 0U100733914 / REVISION 2

DRAWN	SYA	15/12/2021
CHECKED	SJM	16/12/2021
ENGINEER	AVG	15/12/2021
APPROVED	AG	17/12/2021
EMPLOYER		
SCALE	1:100, 50, 25, 40, 20	A1

MANSOURAH - MASSARAH GOLD PROJECT
GENERAL ARRANGEMENT DRAWING
HEALTH & SAFETY & SECURITY AND RISK : VILLAGE AREA
LAYOUT & DETAIL OF ROAD BLOCKER FOUNDATION

DRAWING NUMBER MD - 216 - 1800 - EG - CV - GAD - 1599 REV D01