

DRAWING NUMBER MD - 216 - 1800 - EG - CV - GAD - 1601
REV D01

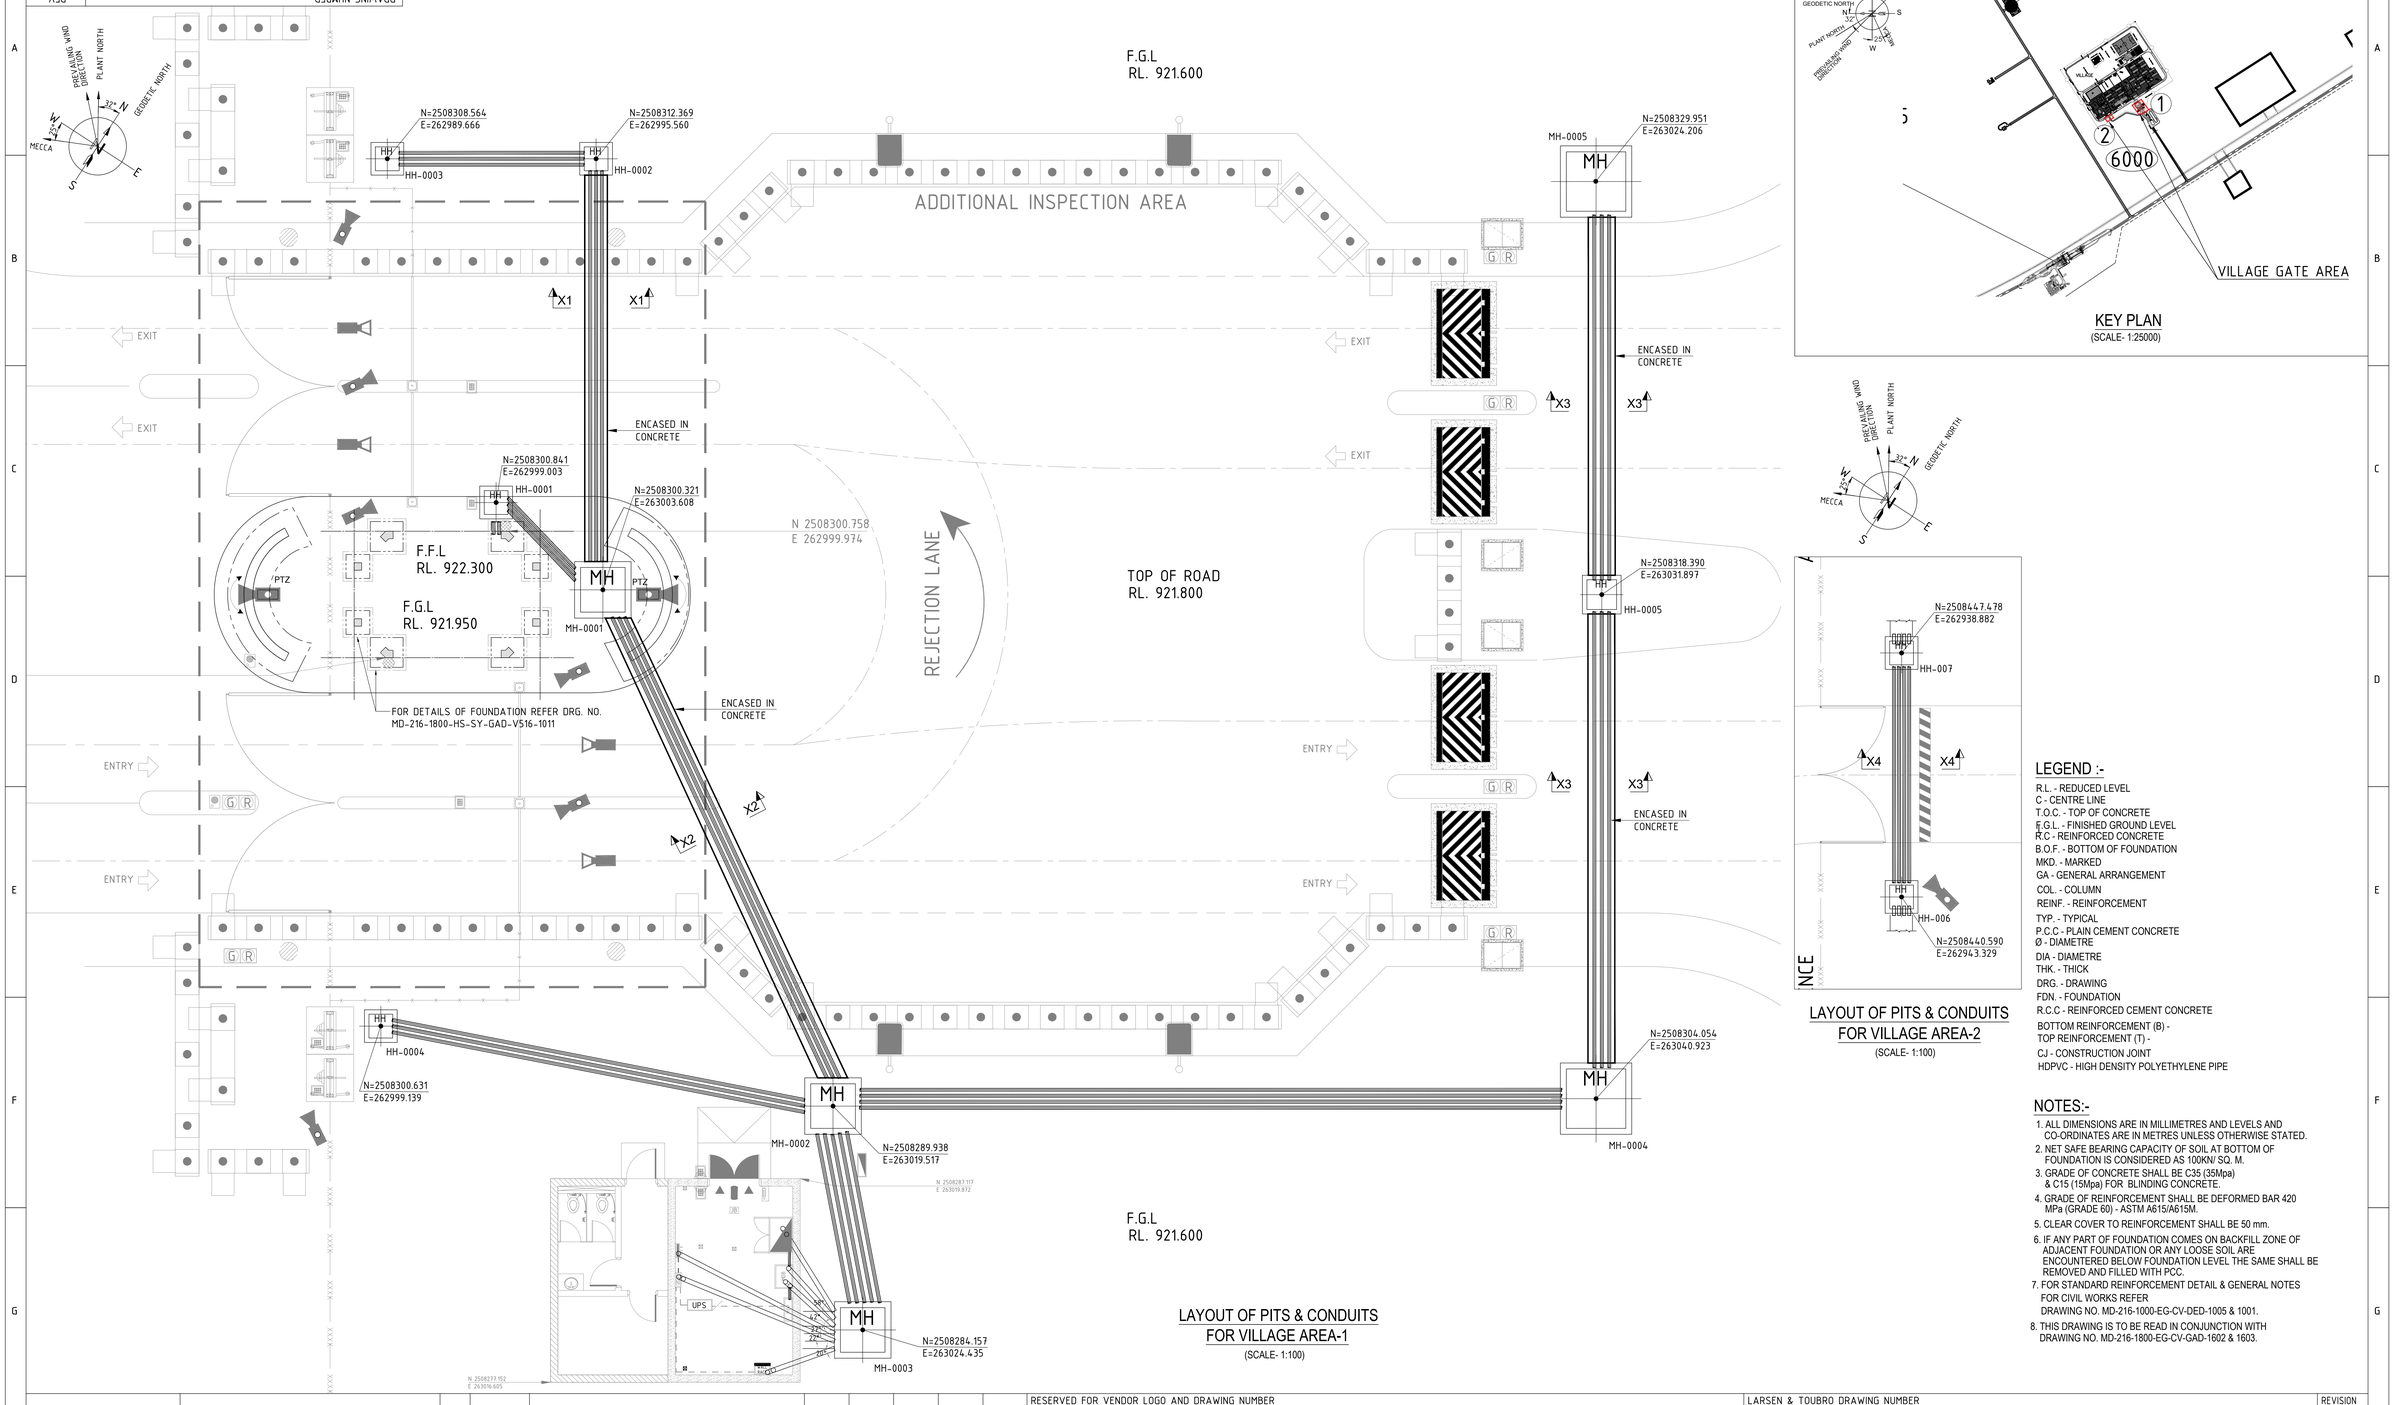


LAYOUT OF PITS & CONDUITS FOR VILLAGE AREA-1
(SCALE- 1:100)

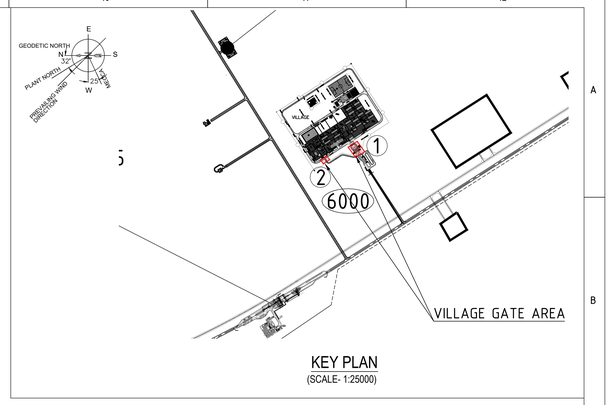


KEY PLAN
(SCALE- 1:25000)







LAYOUT OF PITS & CONDUITS FOR VILLAGE AREA-2
(SCALE- 1:100)

## LEGEND :-

R.L. - REDUCED LEVEL
C - CENTRE LINE
T.O.C. - TOP OF CONCRETE
F.G.L. - FINISHED GROUND LEVEL
R.C - REINFORCED CONCRETE
B.O.F. - BOTTOM OF FOUNDATION
MKD. - MARKED
GA - GENERAL ARRANGEMENT
COL. - COLUMN
REINF. - REINFORCEMENT
TYP. - TYPICAL
P.C.C - PLAIN CEMENT CONCRETE
Ø - DIAMETRE
DIA - DIAMETRE
THK. - THICK
DRG. - DRAWING
FDN. - FOUNDATION
R.C.C - REINFORCED CEMENT CONCRETE
BOTTOM REINFORCEMENT (B) -
TOP REINFORCEMENT (T) -
CJ - CONSTRUCTION JOINT
HDPVC - HIGH DENSITY POLYETHYLENE PIPE

## NOTES:-

1. ALL DIMENSIONS ARE IN MILLIMETRES AND LEVELS AND CO-ORDINATES ARE IN METRES UNLESS OTHERWISE STATED.
2. NET SAFE BEARING CAPACITY OF SOIL AT BOTTOM OF FOUNDATION IS CONSIDERED AS 100KN/ SQ. M.
3. GRADE OF CONCRETE SHALL BE C35 (35Mpa) & C15 (15Mpa) FOR BLINDING CONCRETE.
4. GRADE OF REINFORCEMENT SHALL BE DEFORMED BAR 420 MPa (GRADE 60) - ASTM A615/A615M.
5. CLEAR COVER TO REINFORCEMENT SHALL BE 50 mm.
6. IF ANY PART OF FOUNDATION COMES ON BACKFILL ZONE OF ADJACENT FOUNDATION OR ANY LOOSE SOIL ARE ENCOUNTERED BELOW FOUNDATION LEVEL THE SAME SHALL BE REMOVED AND FILLED WITH PCC.
7. FOR STANDARD REINFORCEMENT DETAIL & GENERAL NOTES FOR CIVIL WORKS REFER DRAWING NO. MD-216-1000-EG-CV-DED-1005 & 1001.
8. THIS DRAWING IS TO BE READ IN CONJUNCTION WITH DRAWING NO. MD-216-1800-EG-CV-GAD-1602 & 1603.

| DOCUMENT NUMBER | REFERENCE DOCUMENTS | | | REVISION DESCRIPTION | DRN | CHK | ENG | APP | EMP |
|---|---|---|---|---|---|---|---|---|---|
| | VILLAGE MAIN GATE SECURITY EQUIPMENT LAY. | A01 | 13/12/2021 | ISSUED FOR APPROVAL | SYA | SJM | AVG | AG | |
| MD-216-1800-HS-SY-LAD-V516-1129 | HEALTH & SAFETY & SECURITY AND RISK | | | COMMENTS DATED 08/01/2022 | | | | | |
| | CABLE ROUTE (NON HCIS) | C01 | 12/01/2022 | ISSUED FOR CONSTRUCTION & REVISED AS PER EMPLOYER | SYA | SJM | AVG | AG | |
| MD-216-1800-HS-SY-LAD-V516-1139 | HEALTH & SAFETY & SECURITY AND RISK | D01 | 01/03/2023 | AS-BUILT | SYA | SJM | AVG | AG | |
| MD-216-1800-EG-CV-GAD-1602 | DETAIL OF CABLE PITS & CONDUITS | | | | | | | | |
| MD-216-1800-EG-CV-GAD-1603 | DETAIL OF CABLE PITS & CONDUITS | | | | | | | | |

RESERVED FOR VENDOR LOGO AND DRAWING NUMBER

LARSEN & TOUBRO
This drawing is the property of LARSEN & TOUBRO and must not be passed on to any person or body not authorized by us to receive it nor be copied or otherwise made use either in full or in part by such person or body without our prior permission in writing.

Outotec
The content of these documents are the sole property of Outotec Oyj. Any rights not expressly granted herein are reserved. Reproduction, transfer or distribution of part or all of the contents in any form without prior written permission of Outotec is prohibited.

MA'ADEN معادن
Saudi Arabian Mining Company شركة المعادن العربية السعودية
This document and the information contained herein is Ma'aden proprietary know-how. This document or any part thereof should not be reproduced, stored in a retrieval system or transmitted by any means, electronic or otherwise, or divulged without prior written permission of Ma'aden.

| | | |
|---|---|---|
| LARSEN & TOUBRO DRAWING NUMBER | 019045_900_C_G_24665_003 | REVISION 2 |
| OUTOTEC DRAWING NUMBER | 900707 _GAU01 _AN02_MTL01 _18219 | DOCUMENT ID OU100733916 REVISION 2 |

| | | |
|---|---|---|
| DRAWN | SYA | 08/12/2021 |
| CHECKED | SJM | 09/12/2021 |
| ENGINEER | AVG | 08/12/2021 |
| APPROVED | AG | 13/12/2021 |
| EMPLOYER | | |
| SCALE | 1:100, 50, 25, 40, 20 | A1 |

MANSOURAH - MASSARAH GOLD PROJECT
GENERAL ARRANGEMENT DRAWING
HEALTH & SAFETY & SECURITY AND RISK : VILLAGE AREA
LAYOUT OF CABLE PITS & CONDUITS

DRAWING NUMBER MD - 216 - 1800 - EG - CV - GAD - 1601 REV D01