


DRAWING NUMBER: MD - 216 - 1800 - EG - CV - GAD - 1604
REV: D01

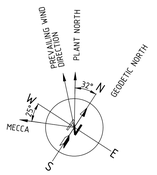

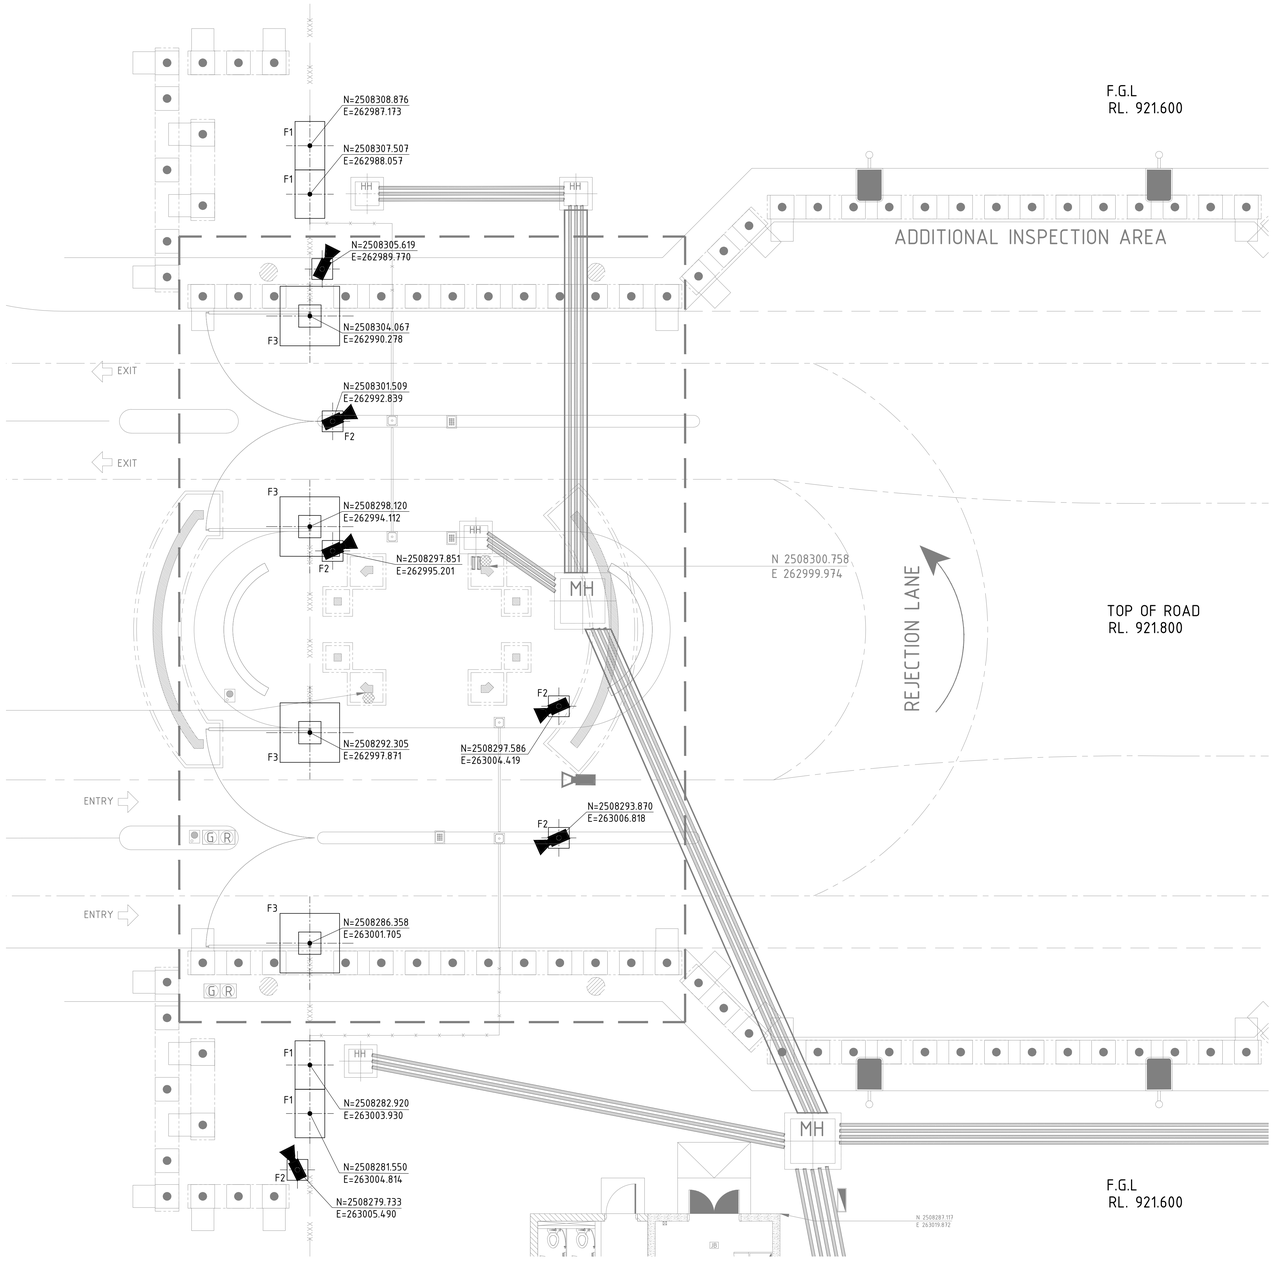

LAYOUT OF GATE, CAMERA POST & TURNSTILE FOUNDATION FOR VILLAGE AREA
(SCALE- 1:100)

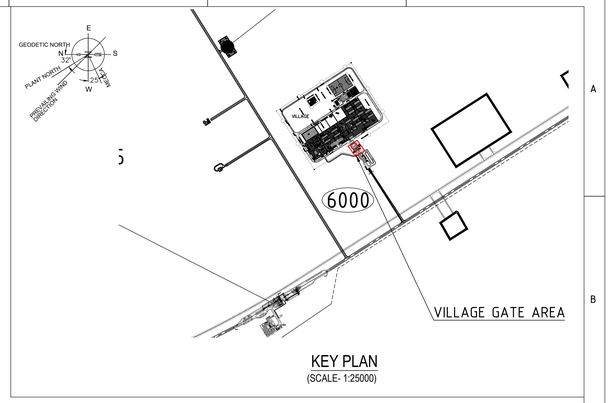

KEY PLAN
(SCALE- 1:25000)

LEGEND :-

R.L. - REDUCED LEVEL
℄ - CENTRE LINE
T.O.C. - TOP OF CONCRETE
F.G.L. - FINISHED GROUND LEVEL
R.C - REINFORCED CONCRETE
B.O.F. - BOTTOM OF FOUNDATION
MKD. - MARKED
GA - GENERAL ARRANGEMENT
COL. - COLUMN
REINF. - REINFORCEMENT
TYP. - TYPICAL
P.C.C - PLAIN CEMENT CONCRETE
Ø - DIAMETER
DIA - DIAMETER
THK. - THICK
DRG. - DRAWING
FDN. - FOUNDATION
R.C.C - REINFORCED CEMENT CONCRETE
CJ - CONSTRUCTION JOINT
HDPVC - HIGH DENSITY POLYETHYLENE PIPE

NOTES:-

1. ALL DIMENSIONS ARE IN MILLIMETRES AND LEVELS AND CO-ORDINATES ARE IN METRES UNLESS OTHERWISE STATED.
2. NET SAFE BEARING CAPACITY OF SOIL AT BOTTOM OF FOUNDATION IS CONSIDERED AS 100KN/ SQ. M.
3. GRADE OF CONCRETE SHALL BE C35 (35Mpa) & C15 (15Mpa) FOR BLINDING CONCRETE.
4. GRADE OF REINFORCEMENT SHALL BE DEFORMED BAR 420 MPa (GRADE 60) - ASTM A615/A615M.
5. CLEAR COVER TO REINFORCEMENT SHALL BE 50 mm.
6. IF ANY PART OF FOUNDATION COMES ON BACKFILL ZONE OF ADJACENT FOUNDATION OR ANY LOOSE SOIL ARE ENCOUNTERED BELOW FOUNDATION LEVEL THE SAME SHALL BE REMOVED AND FILLED WITH PCC.
7. FOR STANDARD REINFORCEMENT DETAIL & GENERAL NOTES FOR CIVIL WORKS REFER DRAWING NO. MD-216-1000-EG-CV-DED-1005 & 1001.
8. FOR DETAILS OF GATE FOUNDATIONS (F3) REFER DRAWING NO. MD-216-1800-HS-SY-GAD-V516-1625.
9. FOR DETAILS OF TURNSTILE FOUNDATIONS (F1)REFER DRAWING NO. MD-216-1800-HS-SY-GAD-V516-1624.
10. FOR DETAILS OF CAMERA POST (F2) REFER DRAWING NO. MD-216-1800-HS-SY-GAD-V516-1629.

DOCUMENT NUMBER	REFERENCE DOCUMENTS			REVISION DESCRIPTION	DRN	CHK	ENG	APP	EMP
MD-216-1800-HS-SY-LAD-V516-1624	HEALTH & SAFETY & SECURITY AND RISK								
	PP & VAS - INST. DETAILS FOR TURNSTILES								
MD-216-1800-HS-SY-LAD-V516-1629	HEALTH & SAFETY & SECURITY AND RISK								
	EMS-CAMERA POLE FOUNDATION & POLE STUDY								
MD-216-1800-HS-SY-LAD-V516-1625	HEALTH & SAFETY & SECURITY AND RISK	D01	01/03/2023	AS-BUILT	SYA	SJM	AVG	AG	
	EXPLOSIVE PROCESS PLANT &	C01	12/01/2022	ISSUED FOR CONSTRUCTION & REVISED AS PER EMPLOYER	SYA	SJM	AVG	AG	
	ACCOMODATION INSTALLATION DETAIL FOR			COMMENTS DATED 08/01/2022					
	SWING/SLIDING GATE	A01	17/12/2021	ISSUED FOR APPROVAL	SYA	SJM	AVG	AG	

RESERVED FOR VENDOR LOGO AND DRAWING NUMBER

LARSEN & TOUBRO
This drawing is the property of LARSEN & TOUBRO and must not be passed on to any person or body not authorized by us to receive it nor be copied or otherwise made use either in full or in part by such person or body without our prior permission in writing.

Outotec
The content of these documents are the sole property of Outotec Oyj. Any rights not expressly granted herein are reserved. Reproduction, transfer or distribution of part or all of the contents in any form without prior written permission of Outotec is prohibited.

MA'ADEN معادن
Saudi Arabian Mining Company شركة التعدين العربية السعودية
This document and the information contained herein is Ma'aden proprietary know-how. This document or any part thereof should not be reproduced, stored in a retrieval system or transmitted by any means, electronic or otherwise, or divulged without prior written permission of Ma'aden.


LARSEN & TOUBRO DRAWING NUMBER: 019045_900_C_G_24665_006 — REVISION: 2
OUTOTEC DRAWING NUMBER: 900707 __GAU01 __AN02__MTL01 __18222 — DOCUMENT ID: OU100733919 — REVISION: 2

DRAWN	SYA	15/12/2021
CHECKED	SJM	16/12/2021
ENGINEER	AVG	15/12/2021
APPROVED	AG	17/12/2021
EMPLOYER		
SCALE	1:100, 50, 25, 40, 20	A1

MANSOURAH - MASSARAH GOLD PROJECT
GENERAL ARRANGEMENT DRAWING
HEALTH & SAFETY & SECURITY AND RISK : VILLAGE AREA
LAYOUT OF GATE,CAMERA POST & TURNSTILE FDN.


DRAWING NUMBER: MD - 216 - 1800 - EG - CV - GAD - 1604 — REV: D01

DRAWING NUMBER: MD-216-1800-HS-SY-LAD-V516-1139 | REV: D01

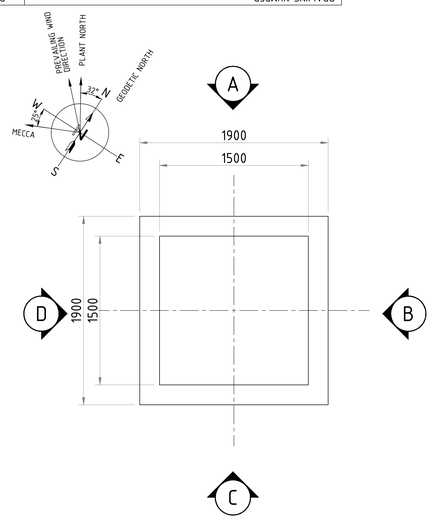


TOP VIEW

MANHOLE SIZE (1500mm X 1500mm X 1500mm)

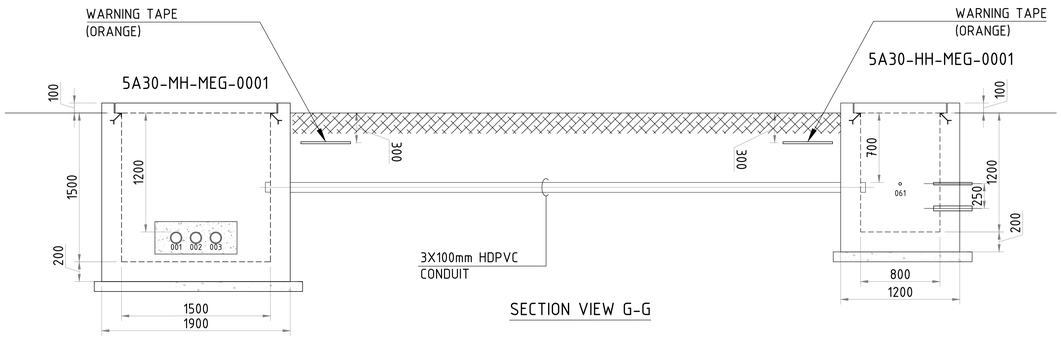


SECTION VIEW G-G


5A30-MH-MEG-0001

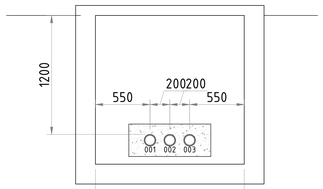


VIEW (A)

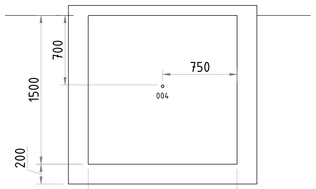

VIEW (B)

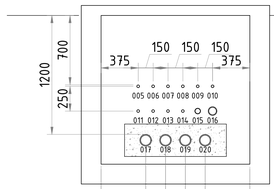

VIEW (C)

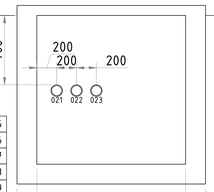


VIEW (D)

25-MEG-INS-HDPVC-005
25-MEG-INS-HDPVC-006
25-MEG-INS-HDPVC-007
25-MEG-INS-HDPVC-008
25-MEG-INS-HDPVC-009
25-MEG-INS-HDPVC-010
25-MEG-INS-HDPVC-011
25-MEG-INS-HDPVC-012
25-MEG-LV-HDPVC-013
25-MEG-LV-HDPVC-014
50-MEG-LV-HDPVC-015
75-MEG-LV-HDPVC-016
100-MEG-INS-HDPVC-017
100-MEG-INS-HDPVC-018
100-MEG-LV-HDPVC-019
100-MEG-LV-HDPVC-020

100-MEG-INS-HDPVC-001
100-MEG-INS-HDPVC-002
100-MEG-LV-HDPVC-003

25-MEG-INS-HDPVC-004

100-MEG-INS-HDPVC-021
100-MEG-INS-HDPVC-022
100-MEG-LV-HDPVC-023

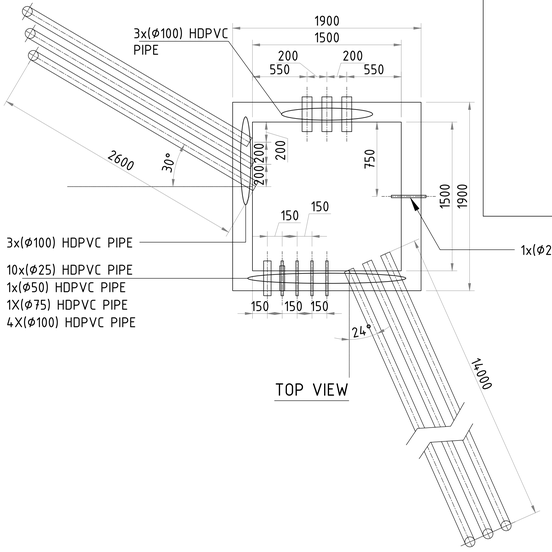

TOP VIEW

SECURITY SYSTEM CABLE ROUTE PROCESS
ACCOMMODATION VILLAGE MAIN ENTRANCE GATE

NOTES:

1. ALL DIMENSIONS ARE IN MILLIMETER, CO-ORDINATES AND ELEVATION ARE IN METER, UNLESS OTHERWISE STATED.
2. ALL THE HDPVC CONDUITS ARE SHOWN IN DRAWING WILL BE EMBEDDED AND TOP WILL BE RAISED BY 100 mm WITH RESPECT TO THE FLOOR ELEVATION AT START / END POINT OF THE HDPVC CONDUIT.
3. BENDING RADIUS FOR HDPVC CONDUIT USED FOR HIGH VOLTAGE CABLE LAYING WILL BE 1200 mm.
4. BENDING RADIUS FOR HDPVC CONDUIT USED FOR LOW VOLTAGE CABLE LAYING WILL BE 450 mm.
5. FOR OVERALL CABLE ROUTE LAYOUT OF VILLAGE REFER DRAWING "MD-216-6000-EG-EL-LAD-1019"

LEGENDS

MH : MANHOLE

HH : HAND HOLE

MEG : MAIN ENTRANCE GATE


PIPE HIERARCHY IN DUCT BANK

XXX_XXXX_XX_XXX_XXX

- SEQUENCE NUMBERS
- PIPE MATERIAL
- CLASS(LV, HV, CTR, INS, CI)
- AREA CODE
- PIPE SIZE

LV LOW VOLTAGE POWER CABLE
HV HIGH VOLTAGE POWER CABLE
CTR CONTROL CABLE
INS INSTRUMENTATION CABLE
CI CONTROL / INSTRUMENTATION CABLE

KEY PLAN:

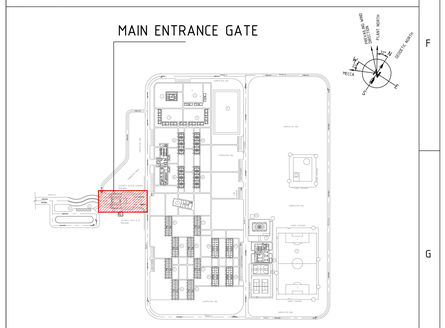

DOCUMENT NUMBER	REFERENCE DOCUMENTS	REV	DATE	REVISION DESCRIPTION	DRN	CHK	ENG	APP	EMP
MD-216-6000-EG-EL-LAD-1019	MAIN CABLE ROUTE LAYOUT-VILLAGE								
MD-216-1800-HS-SY-LAD-V516-1029	VILLAGE MAIN GATE SECURITY EQUIPMENT LAYOUT								
MD-216-1800-HS-SY-GAD-V516-1624	INSTALLATION DETAILS FOR TURNSTILES								
MD-216-1800-HS-SY-GAD-V516-1625	INSTALLATION DETAILS FOR SWING/SLIDING GATE								
MD-216-1800-HS-SY-GAD-V516-1622	INSTALLATION DETAILS FOR ROAD BLOCKER								
MD-216-1800-HS-SY-GAD-V516-1627	INSTALLATION DETAILS FOR BOLLARDS								
MD-216-1800-HS-SY-GAD-V516-1623	INSTALLATION DETAILS FOR ARM BARRIER								
MD-216-1800-HS-SY-BFD-V516-1001	SECURITY SYSTEM BLOCK DIAGRAM	D01	01/03/2023	AS-BUILT	--	SYY/AYB	--	SMB	
MD-216-1800-HS-SY-BFD-V516-1004	ACS BLOCK DIAGRAM	C01	10/08/2021	ISSUED FOR CONSTRUCTION	--	SYY/AYB	--	SMB	
MD-216-1800-HS-SY-DED-V516-1008	SACS INSTALLATION DETAILS	A01	20/05/2021	ISSUED FOR APPROVAL	--	SYY/AYB	--	SMB	

SAS SYSTEMS ENGINEERING
سالم للتوكيلات و الخدمات
Salem Agencies & Services Co.
SECURITY SYSTEM DIVISION

DRAWING NUMBER					REVISION
5A30-DRW-SAS-CNL-VAS-S12-001 (02 OF 06)					A04
DATE	08/08/2021	DATE	09/08/2021	DATE	10/08/2021
DRAWN	IK	CHECKED	AS	APPROVED	AD

LARSEN & TOUBRO DRAWING NUMBER: O19045_950_E_V_31853_001 — REVISION: 2
OUTOTEC DRAWING NUMBER: 900707__GAU01__AN02__EQS03__18181 — DOCUMENT ID: OU100723933 — REVISION: 2

LARSEN & TOUBRO

This drawing is the property of *LARSEN & TOUBRO* and must not be passed on to any person or body not authorized by us to receive it nor be copied or otherwise made use either in full or in part by such person or body without our prior permission in writing.

Outotec


The content of these documents are the sole property of Outotec Oyj. Any rights not expressly granted herein are reserved. Reproduction, transfer or distribution of part or all of the contents in any form without prior written permission of Outotec is prohibited.

MA'ADEN معادن
Saudi Arabian Mining Company شركة معادن العربية السعودية

This document and the information contained herein is Ma'aden proprietary know-how. This document or any part thereof should not be reproduced, stored in a retrieval system or transmitted by any means, electronic or otherwise, or divulged without prior written permission of Ma'aden.


DRAWN	--	--	MANSOURAH - MASSARAH GOLD PROJECT
CHECKED	SYY/AYB	18/05/2021	LAYOUT
ENGINEER	--	--	HEALTH & SAFETY & SECURITY AND RISK
APPROVED	SMB	20/05/2021	CABLE ROUTE (NON HCIS) SHEET (13 OF 39)
EMPLOYER			
SCALE	1:30	A1	DRAWING NUMBER: MD-216-1800-HS-SY-LAD-V516-1139 — REV: D01


DRAWING NUMBER: MD- 216- 1800- HS- SY-LAD- V516-1139 | REV: D01

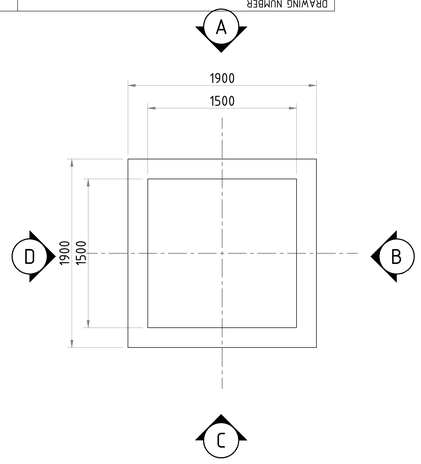

TOP VIEW


MANHOLE SIZE (1500mm X 1500mm X 1500mm)

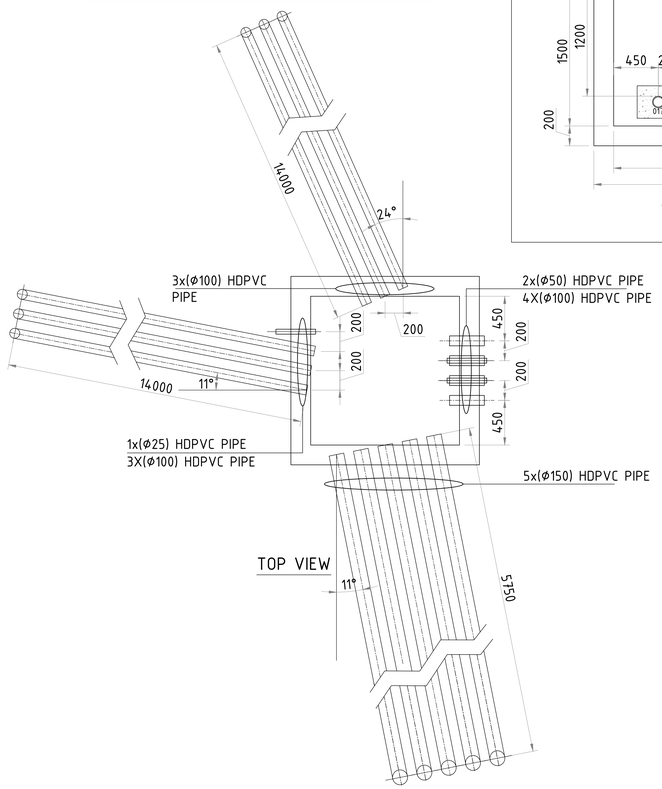

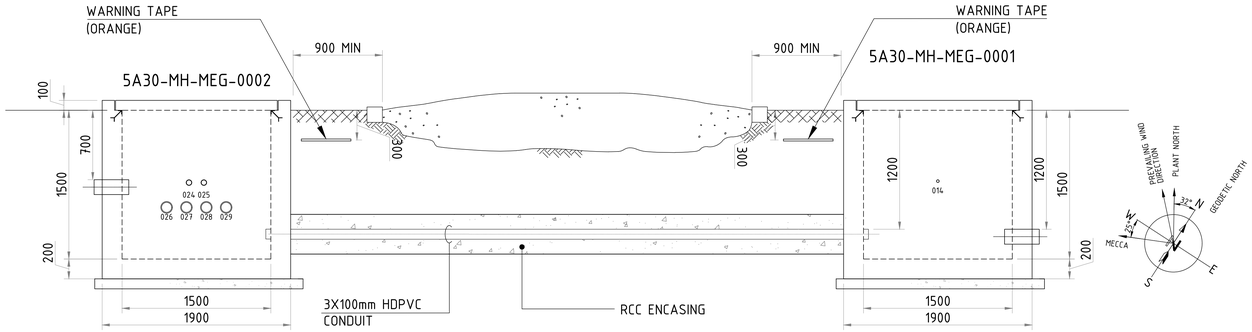

SECTION VIEW F-F
TYPICAL SECTION ROAD CROSSING

5A30-MH-MEG-0002

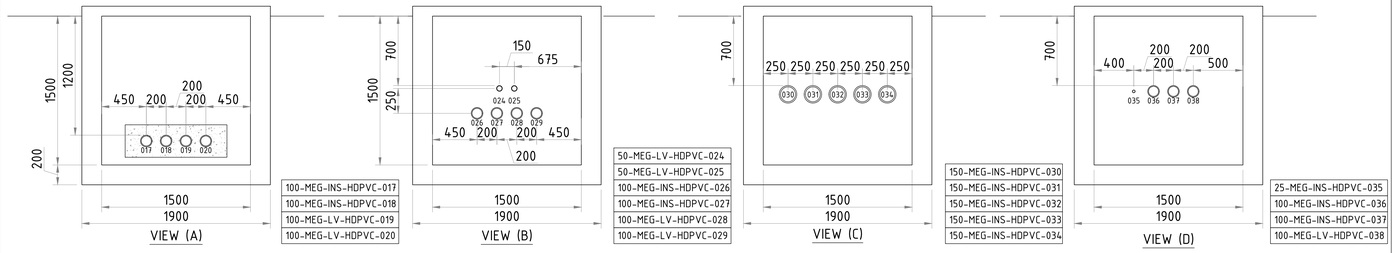

NOTES:

1. ALL DIMENSIONS ARE IN MILLIMETER, CO-ORDINATES AND ELEVATION ARE IN METER, UNLESS OTHERWISE STATED.
2. ALL THE HDPVC CONDUITS ARE SHOWN IN DRAWING WILL BE EMBEDDED AND TOP WILL BE RAISED BY 100 mm WITH RESPECT TO THE FLOOR ELEVATION AT START / END POINT OF THE HDPVC CONDUIT.
3. BENDING RADIUS FOR HDPVC CONDUIT USED FOR HIGH VOLTAGE CABLE LAYING WILL BE 1200 mm.
4. BENDING RADIUS FOR HDPVC CONDUIT USED FOR LOW VOLTAGE CABLE LAYING WILL BE 450 mm.
5. FOR OVERALL CABLE ROUTE LAYOUT OF VILLAGE REFER DRAWING "MD-216-6000-EG-EL-LAD-1019"

LEGENDS

MH : MANHOLE

HH : HAND HOLE

MEG : MAIN ENTRANCE GATE


PIPE HIERARCHY IN DUCT BANK

XXX_XXXX_XX_XXX_XXX

- SEQUENCE NUMBERS
- PIPE MATERIAL
- CLASS(LV, HV, CTR, INS, CI)
- AREA CODE
- PIPE SIZE

LV LOW VOLTAGE POWER CABLE
HV HIGH VOLTAGE POWER CABLE
CTR CONTROL CABLE
INS INSTRUMENTATION CABLE
CI CONTROL / INSTRUMENTATION CABLE

KEY PLAN:

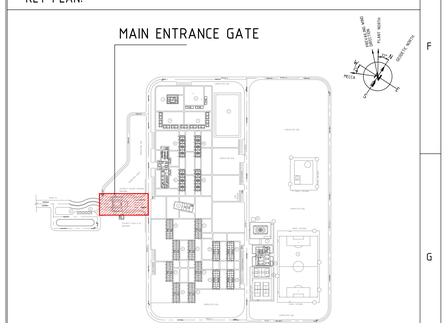

SECURITY SYSTEM CABLE ROUTE PROCESS
ACCOMMODATION VILLAGE MAIN ENTRANCE GATE

DOCUMENT NUMBER	REFERENCE DOCUMENTS	REV	DATE	REVISION DESCRIPTION	DRN	CHK	ENG	APP	EMP
MD-216-6000-EG-EL-LAD-1019	MAIN CABLE ROUTE LAYOUT-VILLAGE								
MD-216-1800-HS-SY-LAD-V516-1029	VILLAGE MAIN GATE SECURITY EQUIPMENT LAYOUT								
MD-216-1800-HS-SY-GAD-V516-1624	INSTALLATION DETAILS FOR TURNSTILES								
MD-216-1800-HS-SY-GAD-V516-1625	INSTALLATION DETAILS FOR SWING/SLIDING GATE								
MD-216-1800-HS-SY-GAD-V516-1622	INSTALLATION DETAILS FOR ROAD BLOCKER								
MD-216-1800-HS-SY-GAD-V516-1627	INSTALLATION DETAILS FOR BOLLARDS								
MD-216-1800-HS-SY-GAD-V516-1623	INSTALLATION DETAILS FOR ARM BARRIER								
MD-216-1800-HS-SY-BFD-V516-1001	SECURITY SYSTEM BLOCK DIAGRAM	D01	01/03/2023	AS-BUILT	--	SYY/AYB	--	SMB	
MD-216-1800-HS-SY-BFD-V516-1004	ACS BLOCK DIAGRAM	C01	10/08/2021	ISSUED FOR CONSTRUCTION	--	SYY/AYB	--	SMB	
MD-216-1800-HS-SY-DED-V516-1008	SACS INSTALLATION DETAILS	A01	20/05/2021	ISSUED FOR APPROVAL	--	SYY/AYB	--	SMB	

SAS SYSTEMS ENGINEERING
سالم للتوكيلات و الخدمات
Salem Agencies & Services Co.
SECURITY SYSTEM DIVISION

LARSEN & TOUBRO

This drawing is the property of *LARSEN & TOUBRO* and must not be passed on to any person or body not authorized by us to receive it nor be copied or otherwise made use either in full or in part by such person or body without our prior permission in writing.

Outotec

The content of these documents are the sole property of Outotec Oyj. Any rights not expressly granted herein are reserved. Reproduction, transfer or distribution of part or all of the contents in any form without prior written permission of Outotec is prohibited.

MA'ADEN معادن
Saudi Arabian Mining Company شركة التعدين العربية السعودية

This document and the information contained herein is Ma'aden proprietary know-how. This document or any part thereof should not be reproduced, stored in a retrieval system or transmitted by any means, electronic or otherwise, or divulged without prior written permission of Ma'aden.

DRAWN	--	--
CHECKED	SYY/AYB	18/05/2021
ENGINEER	--	--
APPROVED	SMB	20/05/2021
EMPLOYER		
SCALE	1:30	A1

DRAWING NUMBER						REVISION
5A30-DRW-SAS-CNL-VAS-S12-001 (03 OF 06)						A04
DATE	08/08/2021	DATE	09/08/2021	DATE	10/08/2021	
DRAWN	IK	CHECKED	AS	APPROVED	AD	

LARSEN & TOUBRO DRAWING NUMBER		REVISION
019045_950_E_V_31853_001		2
OUTOTEC DRAWING NUMBER	DOCUMENT ID	REVISION
900707__GAU01__AN02__EQS03__18181	0U100723933	2

MANSOURAH - MASSARAH GOLD PROJECT
LAYOUT
HEALTH & SAFETY & SECURITY AND RISK
CABLE ROUTE (NON HCIS) SHEET (14 OF 39)


DRAWING NUMBER: MD- 216- 1800- HS- SY- LAD- V516-1139 | REV: D01

DRAWING NUMBER: MD-216-1800-HS-SY-LAD-V516-1139 | REV: D01

SECURITY SYSTEM CABLE ROUTE PROCESS ACCOMMODATION VILLAGE MAIN ENTRANCE GATE

NOTES:

1. ALL DIMENSIONS ARE IN MILLIMETER, CO-ORDINATES AND ELEVATION ARE IN METER, UNLESS OTHERWISE STATED.
2. ALL THE HDPVC CONDUITS ARE SHOWN IN DRAWING WILL BE EMBEDDED AND TOP WILL BE RAISED BY 100 mm WITH RESPECT TO THE FLOOR ELEVATION AT START / END POINT OF THE HDPVC CONDUIT.
3. BENDING RADIUS FOR HDPVC CONDUIT USED FOR HIGH VOLTAGE CABLE LAYING WILL BE 1200 mm.
4. BENDING RADIUS FOR HDPVC CONDUIT USED FOR LOW VOLTAGE CABLE LAYING WILL BE 450 mm.
5. FOR OVERALL CABLE ROUTE LAYOUT OF VILLAGE REFER DRAWING "MD-216-6000-EG-EL-LAD-1019"

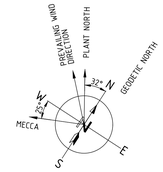

LEGENDS

MH : MANHOLE

HH : HAND HOLE

MEG : MAIN ENTRANCE GATE


PIPE HIERARCHY IN DUCT BANK

XXX_XXXX_XX_XXX_XXX


- SEQUENCE NUMBERS
- PIPE MATERIAL
- CLASS(LV, HV, CTR, INS, CI)
- AREA CODE
- PIPE SIZE

LV LOW VOLTAGE POWER CABLE
HV HIGH VOLTAGE POWER CABLE
CTR CONTROL CABLE
INS INSTRUMENTATION CABLE
CI CONTROL / INSTRUMENTATION CABLE


5A30-MH-MEG-0003

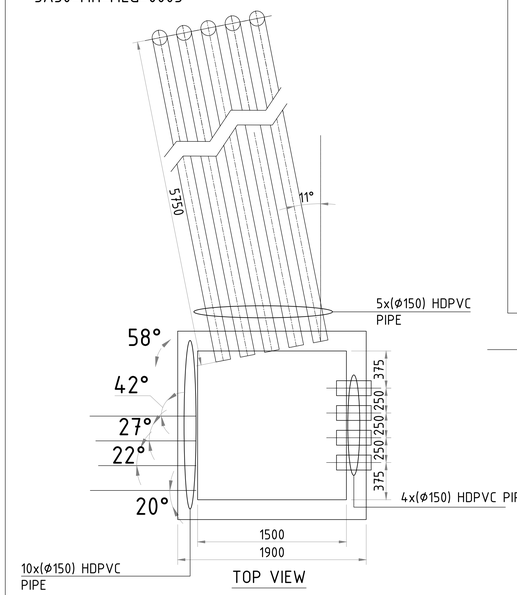


TOP VIEW

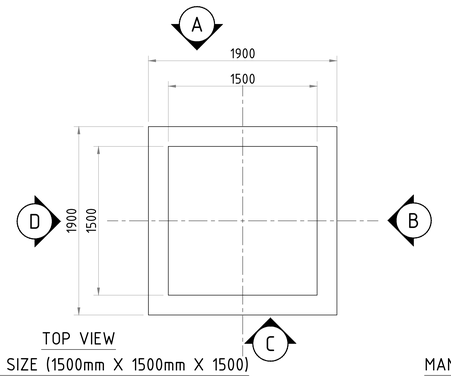

TOP VIEW
MANHOLE SIZE (1500mm X 1500mm X 1500)

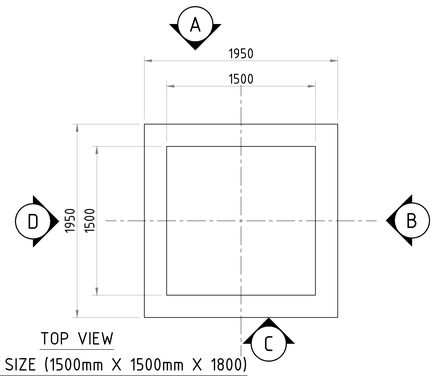


TOP VIEW
MANHOLE SIZE (1500mm X 1500mm X 1800)

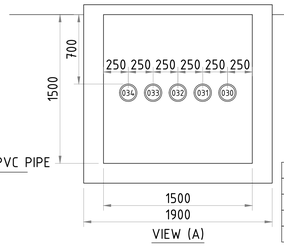


VIEW (A)


150-MEG-INS-HDPVC-030
150-MEG-INS-HDPVC-031
150-MEG-INS-HDPVC-032
150-MEG-INS-HDPVC-033
150-MEG-INS-HDPVC-034

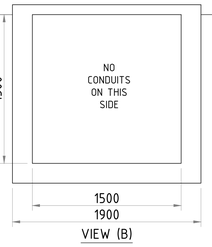

VIEW (B)

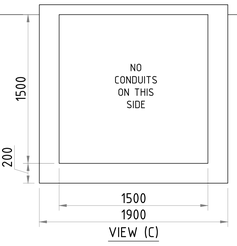


VIEW (C)

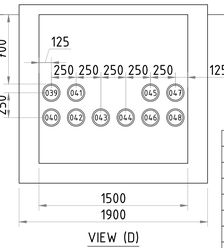


VIEW (D)

150-MEG-LV-HDPVC-039
150-MEG-LV-HDPVC-040
150-MEG-LV-HDPVC-041
150-MEG-LV-HDPVC-042
150-MEG-LV-HDPVC-043
150-MEG-INS-HDPVC-044
150-MEG-LV-HDPVC-045
150-MEG-LV-HDPVC-046
150-MEG-INS-HDPVC-047
150-MEG-INS-HDPVC-048

5A30-MH-MEG-0004

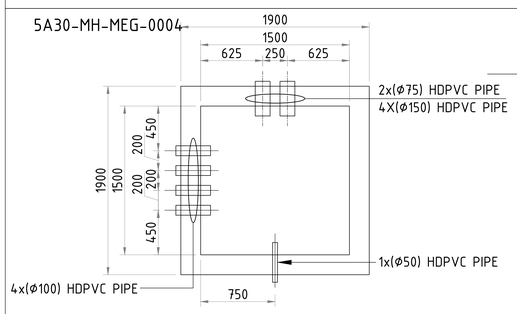


TOP VIEW

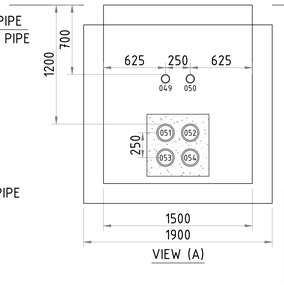


VIEW (A)


75-MEG-INS-HDPVC-049
75-MEG-LV-HDPVC-050
150-MEG-INS-HDPVC-051
150-MEG-INS-HDPVC-052
150-MEG-LV-HDPVC-053
150-MEG-LV-HDPVC-054

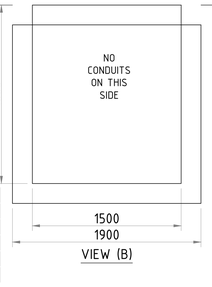

VIEW (B)

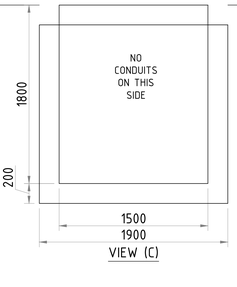


VIEW (C)

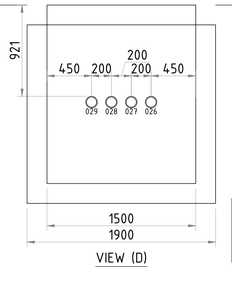


VIEW (D)

100-MEG-INS-HDPVC-026
100-MEG-INS-HDPVC-027
100-MEG-LV-HDPVC-028
100-MEG-LV-HDPVC-029


5A30-MH-MEG-0005

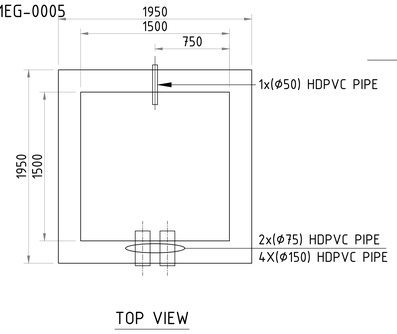


TOP VIEW

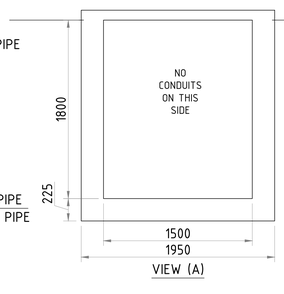

VIEW (A)

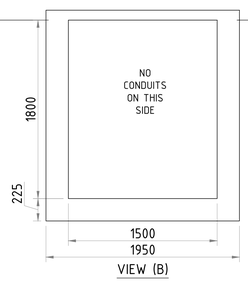


VIEW (B)

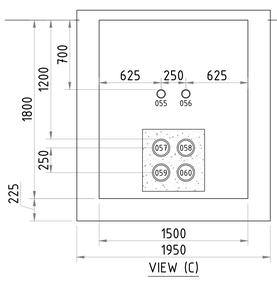

VIEW (C)


75-MEG-INS-HDPVC-055
75-MEG-LV-HDPVC-056
150-MEG-INS-HDPVC-057
150-MEG-INS-HDPVC-058
150-MEG-LV-HDPVC-059
150-MEG-LV-HDPVC-060

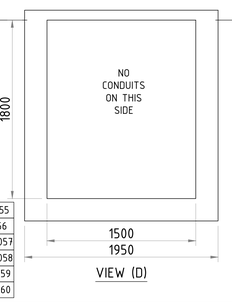

VIEW (D)

KEY PLAN:

MAIN ENTRANCE GATE

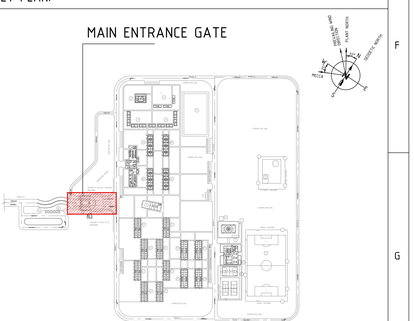

DOCUMENT NUMBER	REFERENCE DOCUMENTS	REV	DATE	REVISION DESCRIPTION	DRN	CHK	ENG	APP	EMP
MD-216-6000-EG-EL-LAD-1019	MAIN CABLE ROUTE LAYOUT-VILLAGE								
MD-216-1800-HS-SY-LAD-V516-1029	VILLAGE MAIN GATE SECURITY EQUIPMENT LAYOUT								
MD-216-1800-HS-SY-GAD-V516-1624	INSTALLATION DETAILS FOR TURNSTILES								
MD-216-1800-HS-SY-GAD-V516-1625	INSTALLATION DETAILS FOR SWING/SLIDING GATE								
MD-216-1800-HS-SY-GAD-V516-1622	INSTALLATION DETAILS FOR ROAD BLOCKER								
MD-216-1800-HS-SY-GAD-V516-1627	INSTALLATION DETAILS FOR BOLLARDS								
MD-216-1800-HS-SY-GAD-V516-1623	INSTALLATION DETAILS FOR ARM BARRIER								
MD-216-1800-HS-SY-BFD-V516-1001	SECURITY SYSTEM BLOCK DIAGRAM	D01	01/03/2023	AS-BUILT	--	SYY/AYB	--	SMB	
MD-216-1800-HS-SY-BFD-V516-1004	ACS BLOCK DIAGRAM	C01	10/08/2021	ISSUED FOR CONSTRUCTION	--	SYY/AYB	--	SMB	
MD-216-1800-HS-SY-DED-V516-1008	SACS INSTALLATION DETAILS	A01	20/05/2021	ISSUED FOR APPROVAL	--	SYY/AYB	--	SMB	

SAS SYSTEMS ENGINEERING

سالم للتوكيلات و الخدمات
Salem Agencies & Services Co.
SECURITY SYSTEM DIVISION

DRAWING NUMBER						REVISION
5A30-DRW-SAS-CNL-VAS-S12-001 (04 OF 06)						A04
DATE	08/08/2021	DATE	09/08/2021	DATE	10/08/2021	
DRAWN	IK	CHECKED	AS	APPROVED	AD	






MA'ADEN معادن
Saudi Arabian Mining Company شركة معادن العربية السعودية

This document and the information contained herein is Ma'aden proprietary know-how. This document or any part thereof should not be reproduced, stored in a retrieval system or transmitted by any means, electronic or otherwise, or divulged without prior written permission of Ma'aden.


DRAWN	--	--
CHECKED	SYY/AYB	18/05/2021
ENGINEER	--	--
APPROVED	SMB	20/05/2021
EMPLOYER		
SCALE	1:30	A1


MANSOURAH - MASSARAH GOLD PROJECT
LAYOUT
HEALTH & SAFETY & SECURITY AND RISK
CABLE ROUTE (NON HCIS) SHEET (15 OF 39)

DRAWING NUMBER	REV
MD- 216- 1800- HS- SY- LAD- V516-1139	D01

DRAWING NUMBER MD-216-1800-HS-SY-LAD-V516-1139 REV D01


SECURITY SYSTEM CABLE ROUTE PROCESS ACCOMMODATION VILLAGE MAIN ENTRANCE GATE

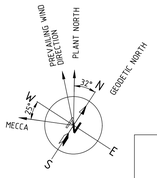

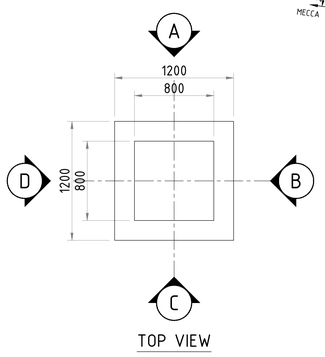


TOP VIEW

HANDHOLE SIZE (800mm X 800mm X Varies)

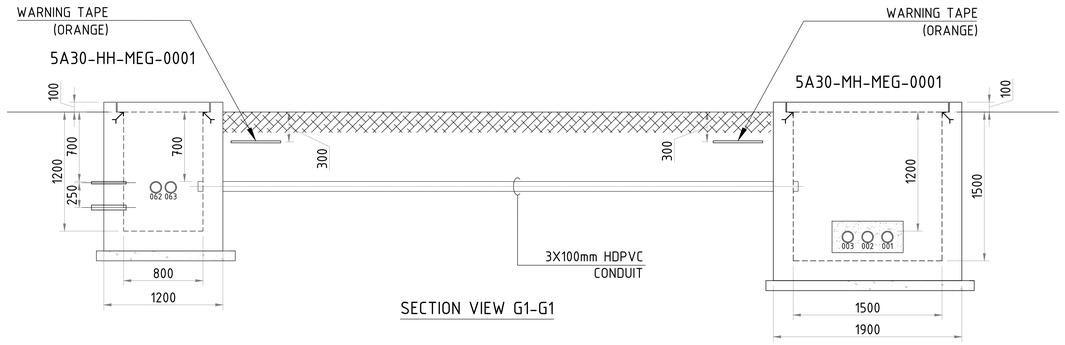


SECTION VIEW G1-G1


5A30-HH-MEG-0001

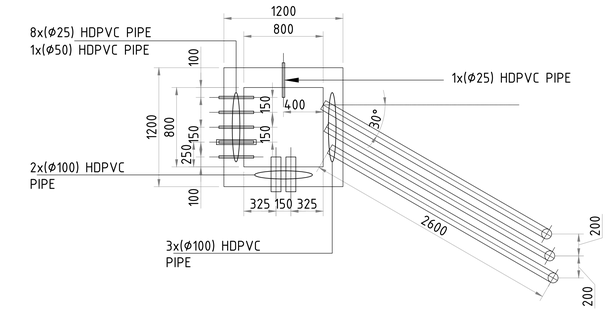


TOP VIEW

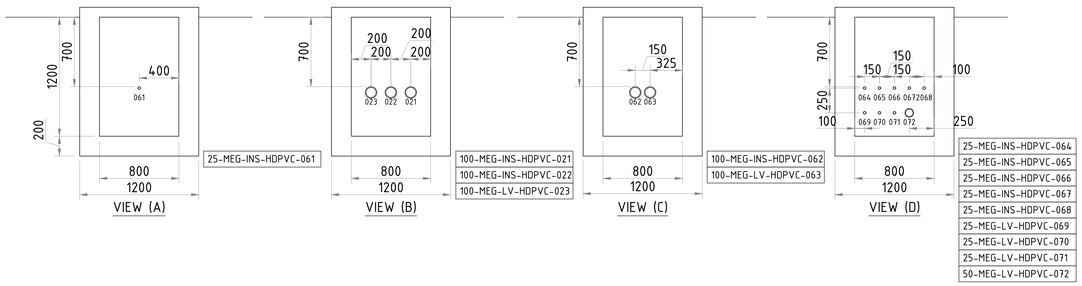

5A30-HH-MEG-0002

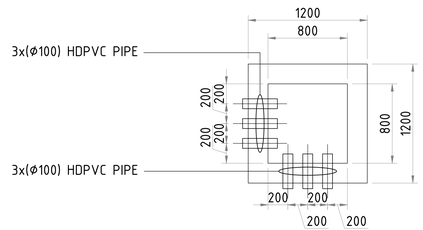

TOP VIEW

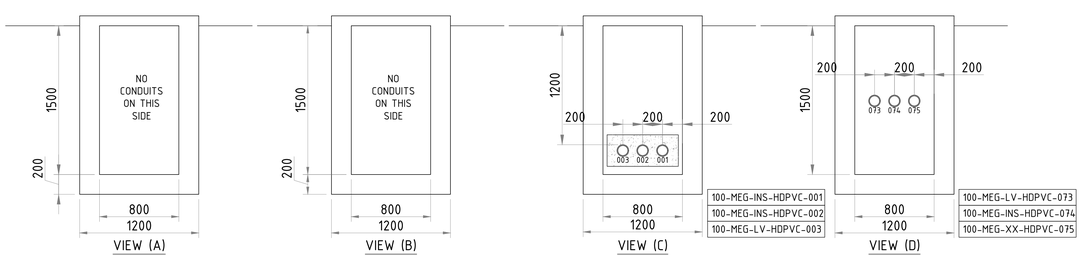

NOTES:

1. ALL DIMENSIONS ARE IN MILLIMETER, CO-ORDINATES AND ELEVATION ARE IN METER, UNLESS OTHERWISE STATED.
2. ALL THE HDPVC CONDUITS ARE SHOWN IN DRAWING WILL BE EMBEDDED AND TOP WILL BE RAISED BY 100 mm WITH RESPECT TO THE FLOOR ELEVATION AT START / END POINT OF THE HDPVC CONDUIT.
3. BENDING RADIUS FOR HDPVC CONDUIT USED FOR HIGH VOLTAGE CABLE LAYING WILL BE 1200 mm.
4. BENDING RADIUS FOR HDPVC CONDUIT USED FOR LOW VOLTAGE CABLE LAYING WILL BE 450 mm.
5. FOR OVERALL CABLE ROUTE LAYOUT OF VILLAGE REFER DRAWING "MD-216-6000-EG-EL-LAD-1019"

LEGENDS

MH : MANHOLE

HH : HAND HOLE

MEG : MAIN ENTRANCE GATE


PIPE HIERARCHY IN DUCT BANK

XXX_XXXX_XX_XXX_XXX

- SEQUENCE NUMBERS
- PIPE MATERIAL
- CLASS(LV, HV, CTR, INS, CI)
- AREA CODE
- PIPE SIZE

LV LOW VOLTAGE POWER CABLE
HV HIGH VOLTAGE POWER CABLE
CTR CONTROL CABLE
INS INSTRUMENTATION CABLE
CI CONTROL / INSTRUMENTATION CABLE

KEY PLAN:

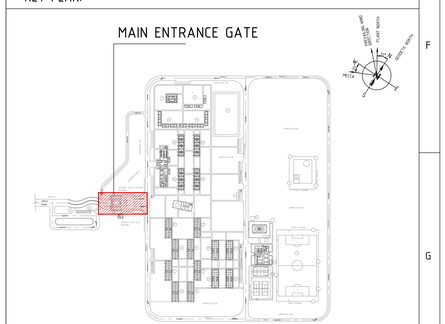

DOCUMENT NUMBER	REFERENCE DOCUMENTS	REV	DATE	REVISION DESCRIPTION	DRN	CHK	ENG	APP	EMP
MD-216-6000-EG-EL-LAD-1019	MAIN CABLE ROUTE LAYOUT-VILLAGE								
MD-216-1800-HS-SY-LAD-V516-1029	VILLAGE MAIN GATE SECURITY EQUIPMENT LAYOUT								
MD-216-1800-HS-SY-GAD-V516-1624	INSTALLATION DETAILS FOR TURNSTILES								
MD-216-1800-HS-SY-GAD-V516-1625	INSTALLATION DETAILS FOR SWING/SLIDING GATE								
MD-216-1800-HS-SY-GAD-V516-1622	INSTALLATION DETAILS FOR ROAD BLOCKER								
MD-216-1800-HS-SY-GAD-V516-1627	INSTALLATION DETAILS FOR BOLLARDS								
MD-216-1800-HS-SY-GAD-V516-1623	INSTALLATION DETAILS FOR ARM BARRIER								
MD-216-1800-HS-SY-BFD-V516-1001	SECURITY SYSTEM BLOCK DIAGRAM	D01	01/03/2023	AS-BUILT	--	SYY/AYB	--	SMB	
MD-216-1800-HS-SY-BFD-V516-1004	ACS BLOCK DIAGRAM	C01	10/08/2021	ISSUED FOR CONSTRUCTION	--	SYY/AYB	--	SMB	
MD-216-1800-HS-SY-DED-V516-1008	SACS INSTALLATION DETAILS	A01	20/05/2021	ISSUED FOR APPROVAL	--	SYY/AYB	--	SMB	

SAS SYSTEMS ENGINEERING — سالم للتوكيلات و الخدمات Salem Agencies & Services Co. SECURITY SYSTEM DIVISION

LARSEN & TOUBRO

This drawing is the property of LARSEN & TOUBRO and must not be passed on to any person or body not authorized by us to receive it nor be copied or otherwise made use either in full or in part by such person or body without our prior permission in writing.

Outotec

The content of these documents are the sole property of Outotec Oyj. Any rights not expressly granted herein are reserved. Reproduction, transfer or distribution of part or all of the contents in any form without prior written permission of Outotec is prohibited.

MA'ADEN معادن Saudi Arabian Mining Company شركة المعادن العربية السعودية


This document and the information contained herein is Ma'aden proprietary know-how. This document or any part thereof should not be reproduced, stored in a retrieval system or transmitted by any means, electronic or otherwise, or divulged without prior written permission of Ma'aden.

DRAWING NUMBER	5A30-DRW-SAS-CNL-VAS-S12-001 (05 OF 06)	REVISION	A04
DATE / DRAWN	08/08/2021 / IK	DATE / CHECKED	09/08/2021 / AS
DATE / APPROVED	10/08/2021 / AD		
LARSEN & TOUBRO DRAWING NUMBER	O19045_950_E_V_31853_001	REVISION	2
OUTOTEC DRAWING NUMBER	900707__GAU01__AN02__EQS03___18181	DOCUMENT ID / REVISION	OU100723933 / 2

DRAWN	--	--	MANSOURAH - MASSARAH GOLD PROJECT
CHECKED	SYY/AYB	18/05/2021	LAYOUT
ENGINEER	--	--	HEALTH & SAFETY & SECURITY AND RISK
APPROVED	SMB	20/05/2021	CABLE ROUTE (NON HCIS) SHEET (16 OF 39)
EMPLOYER			
SCALE 1:30		A1	DRAWING NUMBER MD-216-1800-HS-SY-LAD-V516-1139 / REV D01

DRAWING NUMBER: MD-216-1800-HS-SY-LAD-V516-1139 | REV: D01

SECURITY SYSTEM CABLE ROUTE PROCESS
ACCOMMODATION VILLAGE MAIN ENTRANCE GATE

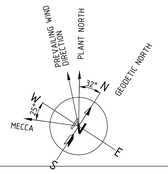

NOTES:

1. ALL DIMENSIONS ARE IN MILLIMETER, CO-ORDINATES AND ELEVATION ARE IN METER, UNLESS OTHERWISE STATED.
2. ALL THE HDPVC CONDUITS ARE SHOWN IN DRAWING WILL BE EMBEDDED AND TOP WILL BE RAISED BY 100 mm WITH RESPECT TO THE FLOOR ELEVATION AT START / END POINT OF THE HDPVC CONDUIT.
3. BENDING RADIUS FOR HDPVC CONDUIT USED FOR HIGH VOLTAGE CABLE LAYING WILL BE 1200 mm.
4. BENDING RADIUS FOR HDPVC CONDUIT USED FOR LOW VOLTAGE CABLE LAYING WILL BE 450 mm.
5. FOR OVERALL CABLE ROUTE LAYOUT OF VILLAGE REFER DRAWING "MD-216-6000-EG-EL-LAD-1019"

LEGENDS

MH : MANHOLE

HH : HAND HOLE

MEG : MAIN ENTRANCE GATE


PIPE HIERARCHY IN DUCT BANK

XXX_XXXX_XX_XXX_XXX


- SEQUENCE NUMBERS
- PIPE MATERIAL
- CLASS(LV, HV, CTR, INS, CI)
- AREA CODE
- PIPE SIZE

LV LOW VOLTAGE POWER CABLE
HV HIGH VOLTAGE POWER CABLE
CTR CONTROL CABLE
INS INSTRUMENTATION CABLE
CI CONTROL / INSTRUMENTATION CABLE

5A30-HH-MEG-0003

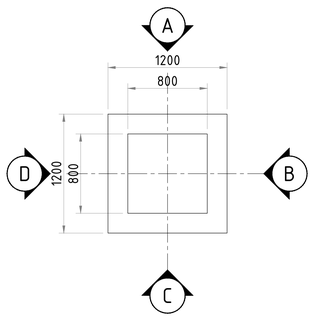


TOP VIEW
HANDHOLE SIZE
(800mm X 800mm X 1200mm)

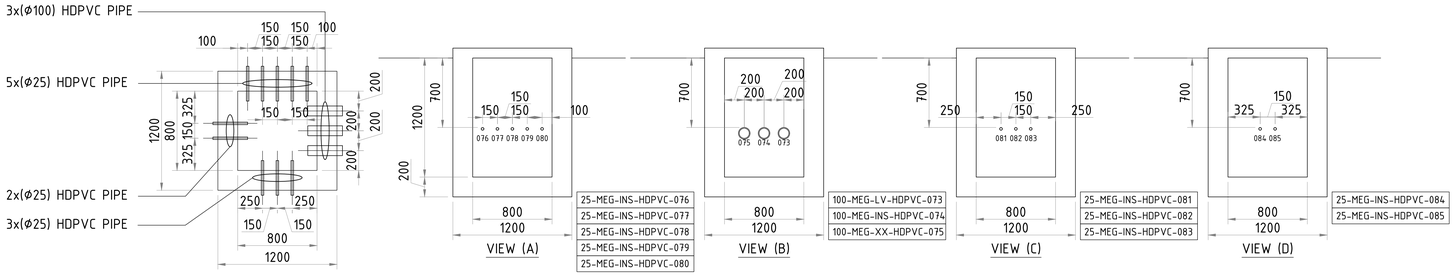


TOP VIEW


5A30-HH-MEG-0004

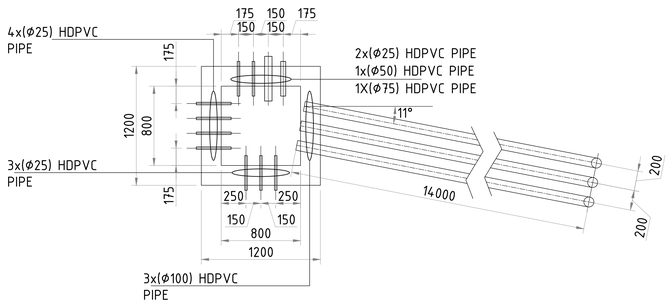


TOP VIEW

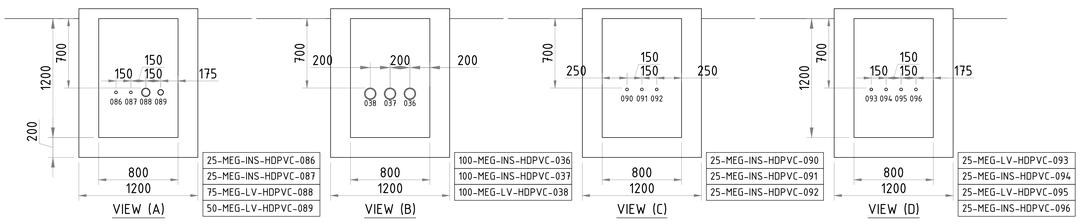


5A30-HH-MEG-0005

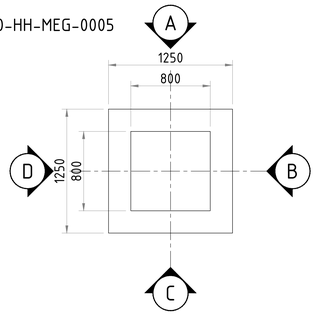


TOP VIEW
HANDHOLE SIZE
(800mm X 800mm X 1800mm)

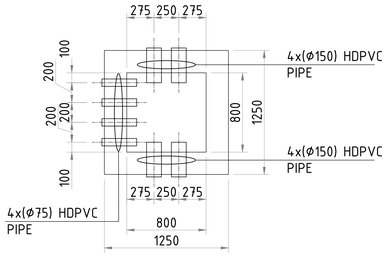

TOP VIEW

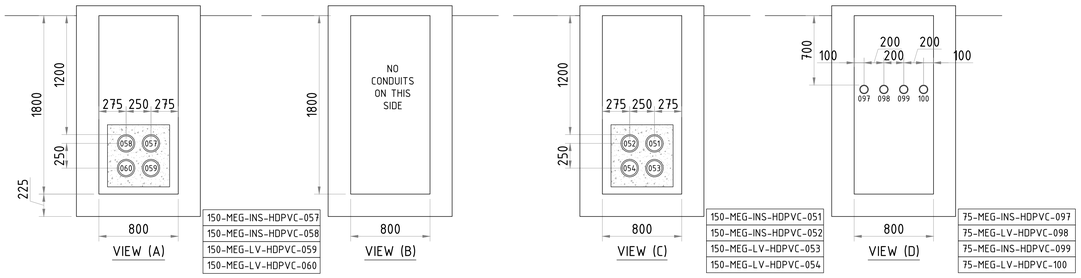

KEY PLAN:

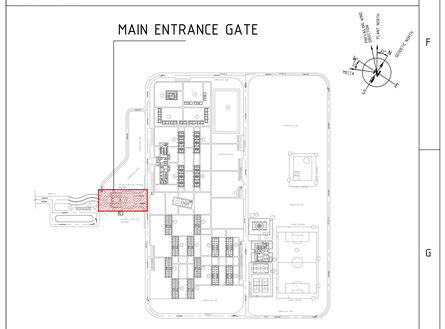

DOCUMENT NUMBER	REFERENCE DOCUMENTS	REV	DATE	REVISION DESCRIPTION	DRN	CHK	ENG	APP	EMP
MD-216-6000-EG-EL-LAD-1019	MAIN CABLE ROUTE LAYOUT-VILLAGE								
MD-216-1800-HS-SY-LAD-V516-1029	VILLAGE MAIN GATE SECURITY EQUIPMENT LAYOUT								
MD-216-1800-HS-SY-GAD-V516-1624	INSTALLATION DETAILS FOR TURNSTILES								
MD-216-1800-HS-SY-GAD-V516-1625	INSTALLATION DETAILS FOR SWING/SLIDING GATE								
MD-216-1800-HS-SY-GAD-V516-1622	INSTALLATION DETAILS FOR ROAD BLOCKER								
MD-216-1800-HS-SY-GAD-V516-1627	INSTALLATION DETAILS FOR BOLLARDS								
MD-216-1800-HS-SY-GAD-V516-1623	INSTALLATION DETAILS FOR ARM BARRIER								
MD-216-1800-HS-SY-BFD-V516-1001	SECURITY SYSTEM BLOCK DIAGRAM	D01	01/03/2023	AS-BUILT	--	SYY/AYB	--	SMB	
MD-216-1800-HS-SY-BFD-V516-1004	ACS BLOCK DIAGRAM	C01	10/08/2021	ISSUED FOR CONSTRUCTION	--	SYY/AYB	--	SMB	
MD-216-1800-HS-SY-DED-V516-1008	SACS INSTALLATION DETAILS	A01	20/05/2021	ISSUED FOR APPROVAL	--	SYY/AYB	--	SMB	

SAS SYSTEMS ENGINEERING — سالم للتوكيلات و الخدمات — Salem Agencies & Services Co. — SECURITY SYSTEM DIVISION

DRAWING NUMBER	5A30-DRW-SAS-CNL-VAS-S12-001 (06 OF 06)			REVISION	A04
DATE	08/08/2021	DATE	09/08/2021	DATE	10/08/2021
DRAWN	IK	CHECKED	AS	APPROVED	AD

LARSEN & TOUBRO DRAWING NUMBER: 019045_950_E_V_31853_001 — REVISION: 2
OUTOTEC DRAWING NUMBER: 900707__GAU01__AN02__EQS03___18181 — DOCUMENT ID: OU100723933 — REVISION: 2

This drawing is the property of LARSEN & TOUBRO and must not be passed on to any person or body not authorized by us to receive it nor be copied or otherwise made use either in full or in part by such person or body without our prior permission in writing.

The content of these documents are the sole property of Outotec Oyj. Any rights not expressly granted herein are reserved. Reproduction, transfer or distribution of part or all of the contents in any form without prior written permission of Outotec is prohibited.

This document and the information contained herein is Ma'aden proprietary know-how. This document or any part thereof should not be reproduced, stored in a retrieval system or transmitted by any means, electronic or otherwise, or divulged without prior written permission of Ma'aden.

DRAWN	--	--
CHECKED	SYY/AYB	18/05/2021
ENGINEER	--	--
APPROVED	SMB	20/05/2021
EMPLOYER		
SCALE	1:30	A1

MANSOURAH - MASSARAH GOLD PROJECT
LAYOUT
HEALTH & SAFETY & SECURITY AND RISK
CABLE ROUTE (NON HCIS) SHEET (17 OF 39)

DRAWING NUMBER: MD-216-1800-HS-SY-LAD-V516-1139 — REV: D01