


DRAWING NUMBER MD- 216 -1800- EG- CV- GAD- 1608 | REV D01

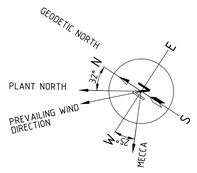


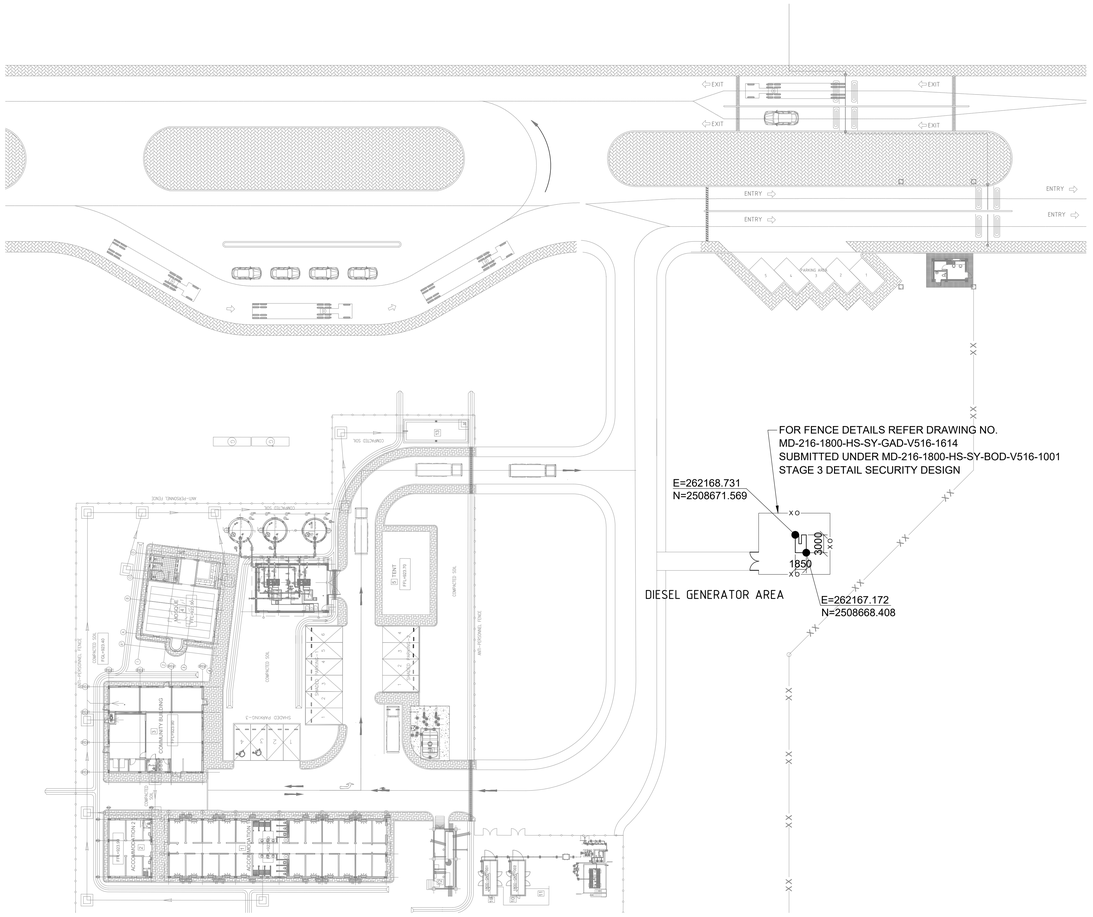


DIESEL GENERATOR LAYOUT FOR PIC AREA
SCALE 1:500

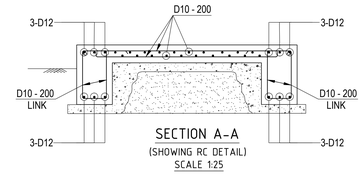


SECTION A-A
(SHOWING RC DETAIL)
SCALE 1:25

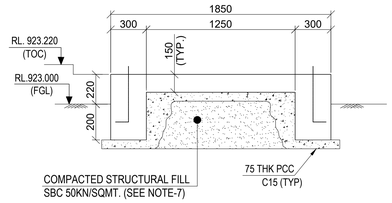

SECTION A-A
SCALE 1:25

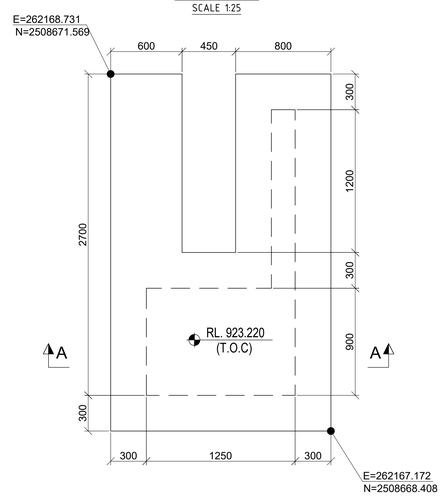

PLAN OF DIESEL GENERATOR FOUNDATION
SCALE 1:25

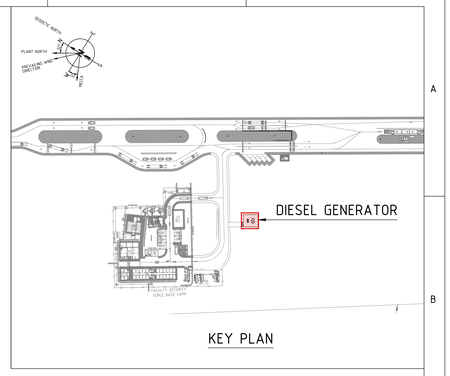

LEGENDS :-

R.L. - REDUCED LEVEL
CL. - CENTRE LINE
T.O.C. - TOP OF CONCRETE
TYP. - TYPICAL
T.O.G. - TOP OF GROUT
B.O.F. - BOTTOM OF FOUNDATION
F.G.L. - FINISHED GROUND LEVEL.
F.F.L. - FINISHED FLOOR LEVEL
P.C.C - PLAIN CEMENT CONCRETE
DET. - DETAIL
FDN. - FOUNDATION
THK. - THICK
R.C.C - REINFORCED CEMENT CONCRETE
MKD. - MARKED
D.G - DIESEL GENERATOR

NOTES:-

1. ALL DIMENSIONS ARE IN MILLIMETRES AND LEVELS AND CO-ORDINATES ARE IN METRES UNLESS OTHERWISE STATED.
2. NET SAFE BEARING CAPACITY OF SOIL AT BOTTOM OF FOUNDATION IS CONSIDERED AS 50 KN/ SQM.
3. GRADE OF CONCRETE SHALL BE C35 (35Mpa) FOR FOUNDATION & C15 (15Mpa) FOR BLINDING CONCRETE.
4. GRADE OF REINFORCEMENT SHALL BE DEFORMED BAR 420 MPa (GRADE 60) - ASTM A615/A615M.
5. CLEAR COVER TO REINFORCEMENT SHALL BE SLAB = 25 MM.
6. FOR STANDARD REINFORCEMENT DETAIL & GENERAL NOTES FOR CIVIL WORKS REFER DRAWING NO. MD-216-1000-EG-CV-DED-1005 & 1001.
7. STRUCTURAL FILL SHALL CONFORM TO PROVISIONS OF DOCUMENT MD-216-1000-EG-CV-MST-1698.
9. FOR THE DETAILS OF EDGE THICKENING, RE-ENTRANT REABR, REFER DRAWING NO. MD-101-SMEM-EG-ST-DST-0002 & 0004.

DOCUMENT NUMBER	REFERENCE DOCUMENTS	REV	DATE	REVISION DESCRIPTION	DRN	CHK	ENG	APP	EMP
		D01	01/03/2023	AS-BUILT	SYA	SJM	SJM	AG	
		C01	23/02/2022	ISSUED FOR CONSTRUCTION & REVISED AS PER EMPLOYER COMMENTS DATED 25/01/2022	SYA	SJM	SJM	AG	
MD-216-1800-HS-SY-LAD-V516-1072	HEALTH & SAFETY & SECURITY AND RISK								
	DIESEL GENERATOR LAYOUT PIC AREA	A01	31/12/2021	ISSUED FOR APPROVAL	SYA	SJM	SJM	AG	

RESERVED FOR VENDOR LOGO AND DRAWING NUMBER

LARSEN & TOUBRO

This drawing is the property of LARSEN & TOUBRO and must not be passed on to any person or body not authorized by us to receive it nor be copied or otherwise made use either in full or in part by such person or body without our prior permission in writing.

Outotec

The content of these documents are the sole property of Outotec Oyj. Any rights not expressly granted herein are reserved. Reproduction, transfer or distribution of part or all of the contents in any form without prior written permission of Outotec is prohibited.

MA'ADEN معادن
Saudi Arabian Mining Company شركة المعادن العربية السعودية

This document and the information contained herein is Ma'aden proprietary know-how. This document or any part thereof should not be reproduced, stored in a retrieval system or transmitted by any means, electronic or otherwise, or divulged without prior written permission of Ma'aden.

LARSEN & TOUBRO DRAWING NUMBER: O19045_900_C_G_24666_002 | REVISION: 2
OUTOTEC DRAWING NUMBER: 900707_ GAU01_ AN02_ MTL01_ 18226 | DOCUMENT ID: OU100740013 | REVISION: 2

DRAWN	SYA	27/12/2021
CHECKED	SJM	28/12/2021
ENGINEER	AVG	27/12/2021
APPROVED	AG	31/12/2021
EMPLOYER		
SCALE	1:250	A1

MANSOURAH - MASSARAH GOLD PROJECT
GENERAL ARRANGEMENT DRAWING
HEALTH & SAFETY & SECURITY AND RISK
LAYOUT & DETAILS OF DG FDN. FOR PIC AREA

DRAWING NUMBER: MD- 216- 1800- EG- CV- GAD- 1608 | REV: D01