

DRAWING NUMBER: MD - 216 - 3520 - EG - CV - DED - 1284 | REV: D01

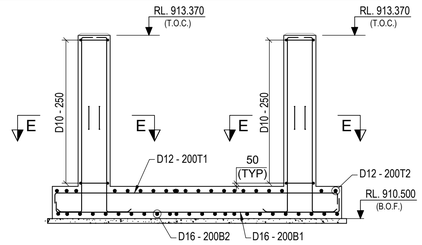


SECTION : M-M
(SCALE 1:50)


R.C.C DETAIL OF FOUNDATION MKD. F4
(SCALE 1:50)

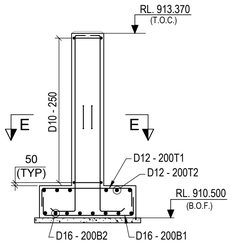


SECTION : D-D
(SCALE 1:50)

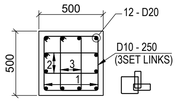


SECTION : E-E
(SCALE 1:25)

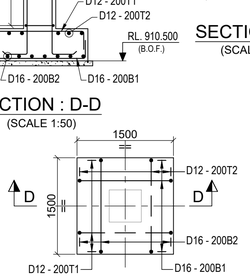


R.C.C DETAIL OF FOUNDATION MKD. F1
(SCALE 1:50)

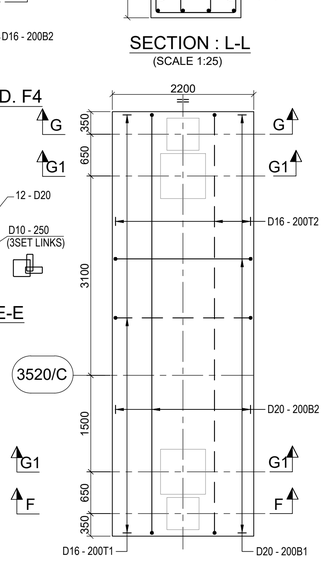


DETAIL OF FOUNDATION MKD. F2
(SCALE 1:50)

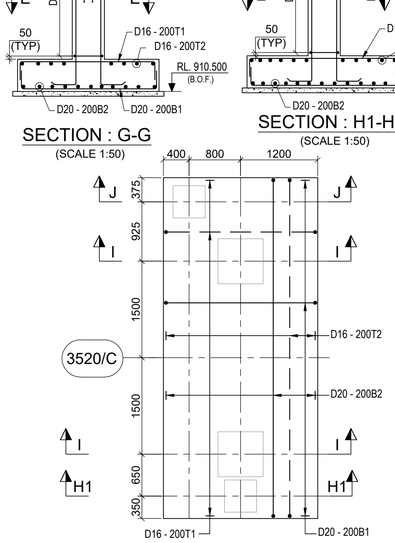


R.C.C DETAIL OF FOUNDATION MKD. F2A
(SCALE 1:50)

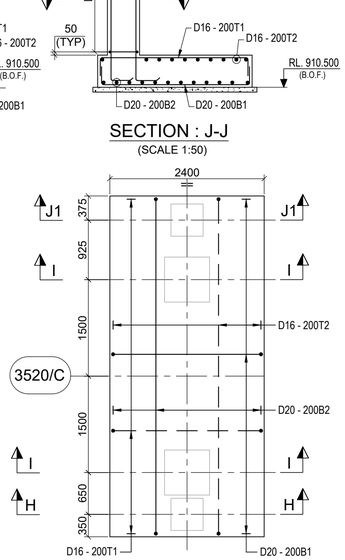


DETAIL OF FOUNDATION MKD. F2B
(SCALE 1:50)

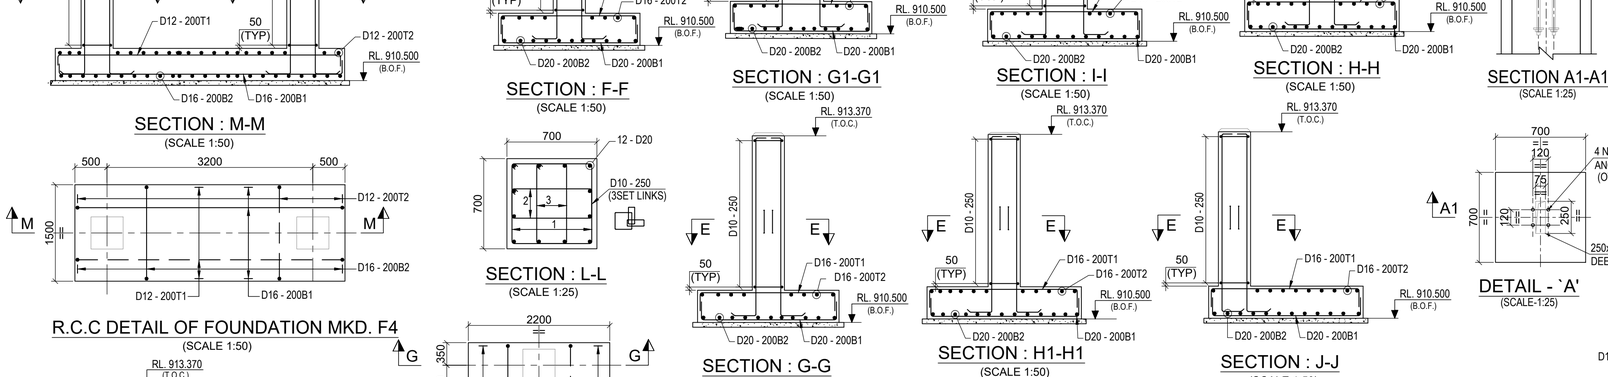


BOLT PLAN AND SHEAR KEY DETAILS OF NEUTRALIZATION AND THICKENING AREA PIPE RACK
(SCALE 1:100)

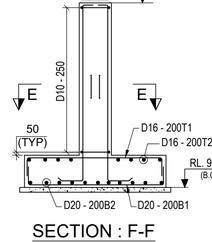


SECTION : F-F
(SCALE 1:50)

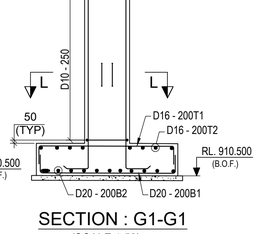


SECTION : G1-G1
(SCALE 1:50)

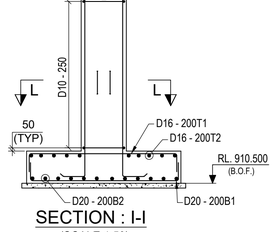


SECTION : I-I
(SCALE 1:50)

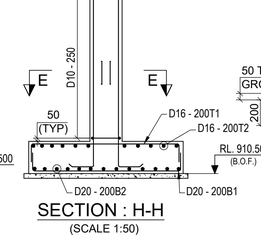


SECTION : H-H
(SCALE 1:50)

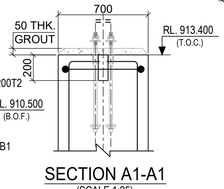


SECTION A1-A1
(SCALE 1:25)

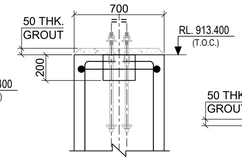


SECTION B1-B1
(SCALE 1:25)

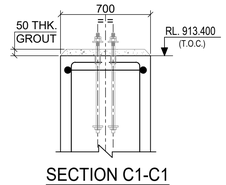


SECTION C1-C1
(SCALE 1:25)

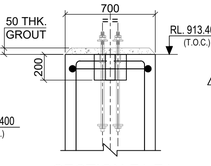


SECTION F1-F1
(SCALE 1:25)

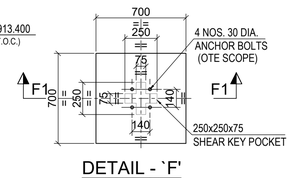


DETAIL - `F'
(SCALE-1:25)

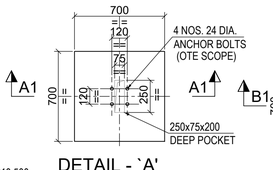


DETAIL - `A'
(SCALE-1:25)

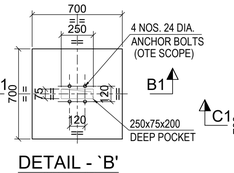


DETAIL - `B'
(SCALE-1:25)

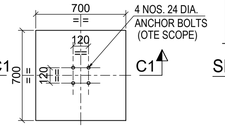


DETAIL - `C'
(SCALE-1:25)

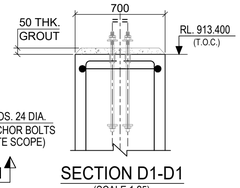


SECTION D1-D1
(SCALE 1:25)

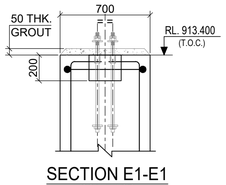


SECTION E1-E1
(SCALE 1:25)

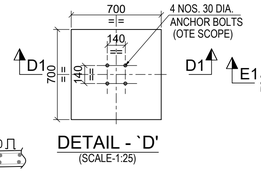


DETAIL - `D'
(SCALE-1:25)

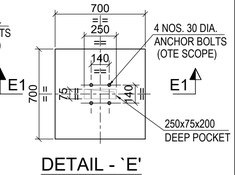


DETAIL - `E'
(SCALE-1:25)

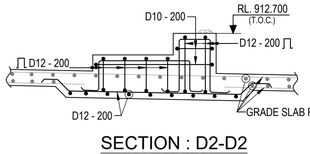


SECTION : D2-D2
(REF. GA DWG.)
(SCALE 1:30)

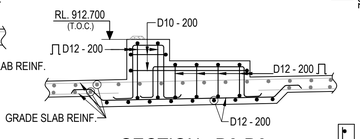


SECTION : D3-D3
(REF. GA DWG.)
(SCALE 1:30)

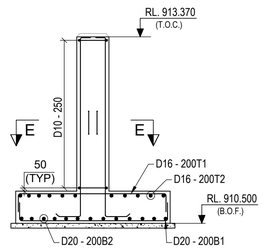


SECTION : J1-J1
(SCALE 1:50)

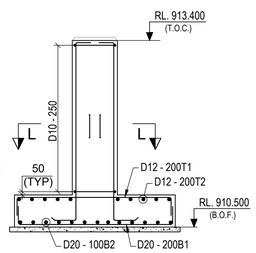


SECTION : K-K
(SCALE 1:50)

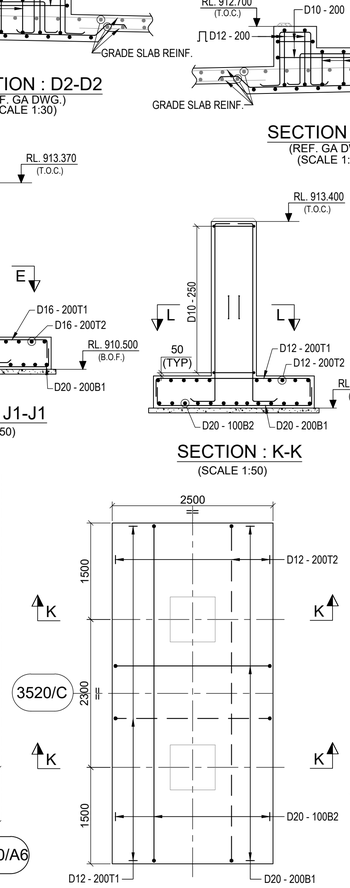

DETAIL OF FOUNDATION MKD. F3
(SCALE 1:50)

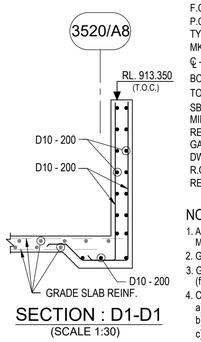

SECTION : D1-D1
(SCALE 1:30)

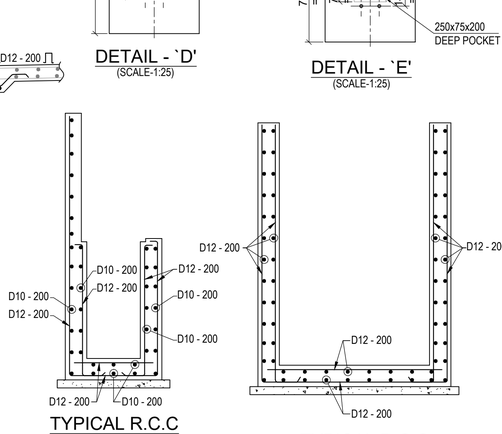

TYPICAL R.C.C DETAIL OF CANAL
(SCALE 1:30)

TYPICAL R.C.C DETAIL OF PIT
(SCALE 1:30)

LEGEND.:-

R.L. - REDUCED LEVEL
T.O.C - TOP OF CONCRETE
B.O.F - BOTTOM OF FOUNDATION
F.G.L - FINISHED GROUND LEVEL
P.C.C - PLAIN CEMENT CONCRETE
TYP - TYPICAL
MKD - MARKED
℄ - CENTRE LINE
BOTTOM REINF.(B) - – – – – –
TOP REINF.(T) - ———
SBC - SAFE BEARING CAPACITY
MIN. - MINIMUM
REF. - REFER
GA - GENERAL ARRANGEMENT
DWG. - DRAWING
R.C.C. - REINFORCED CEMENT CONCRETE
REINF. - REINFORCEMENT

NOTES:-

1. ALL DIMENSIONS ARE IN MILLIMETRES AND LEVELS ARE IN METRES UNLESS OTHERWISE STATED.
2. GRADE OF CONCRETE SHALL BE C35 UNLESS NOTED OTHERWISE.
3. GRADE OF REINFORCEMENT SHALL BE DEFORMED BAR ASTM A615-GRADE 60 (fy=420 MPa)
4. CLEAR COVER TO MAIN REINFORCEMENT SHALL BE AS FOLLOWS:
   a) FOUNDATION : 75 mm. (BOTTOM & SIDE)
   b) FOUNDATION : 50 mm. (TOP)
   c) COLUMN & PEDESTAL : 50 mm.
5. FOR LAP & SPLICE LENGTHS OF REINF. REF. DWG. NO. MD-216-1000-EG-CV-DED-1001.
6. FOR GA DRAWING REF. DWG. NO. MD - 216 - 3520 - EG - CV - GAD - 1284. MD - 216 - 3520 - EG - CV - GAD - 1285.

DOCUMENT NUMBER	REFERENCE DOCUMENTS	REV	DATE	REVISION DESCRIPTION	DRN	CHK	ENG	APP	EMP
		D01	22/02/2023	AS-BUILT	SBH	BDA	STY	AG	
		C03	21/12/2020	ISSUED FOR CONSTRUCTION & REVISED AS MKD.	SBH	BDA	STY	AG	
		C02	28/10/2020	ISSUED FOR CONSTRUCTION & REVISED AS MKD.	SBH	BDA	STY	AG	
		C01	16/06/2020	ISSUED FOR CONSTRUCTION & REVISED AS MKD.	SBH	BDA	STY	AG	
		A02	18/05/2020	REVISED AS PER EMPLOYER	SBH	BDA	STY	AG	
				COMMENTS ON 30/04/2020 & REVISED AS MKD.					
		A01	21/03/2020	ISSUED FOR REFERENCE	SBH	BDA	STY	AG	

RESERVED FOR VENDOR LOGO AND DRAWING NUMBER

LARSEN & TOUBRO

This drawing is the property of LARSEN & TOUBRO and must not be passed on to any person or body not authorized by us to receive it nor be copied or otherwise made use either in full or in part by such person or body without our prior permission in writing.

Outotec

The content of these documents are the sole property of Outotec Oyj. Any rights not expressly granted herein are reserved. Reproduction, transfer or distribution of part or all of the contents in any form without prior written permission of Outotec is prohibited.

MA'ADEN معادن
Saudi Arabian Mining Company شركة التعدين العربية السعودية

This document and the information contained herein is Ma'aden proprietary know-how. This document or any part thereof should not be reproduced, stored in a retrieval system or transmitted by any means, electronic or otherwise, or divulged without prior written permission of Ma'aden.

DRAWN	SBH	19/03/2020
CHECKED	BDA	20/03/2020
ENGINEER	STY	19/03/2020
APPROVED	AG	21/03/2020
EMPLOYER		
SCALE	1:30	A1

LARSEN & TOUBRO DRAWING NUMBER: 019045_450_C_D_24120_002 | REVISION: 5
OUTOTEC DRAWING NUMBER: 900707__GAU01__RN13__CTB17__35201 | DOCUMENT ID: OU100668962 | REVISION: 5

MANSOURAH - MASSARAH GOLD PROJECT
DETAIL DRAWING
NEUTRALIZATION AND THICKENING
GRADE SLAB & PIPE RACK FOUNDATION

DRAWING NUMBER: MD - 216 - 3520 - EG - CV - DED - 1284 | REV: D01