


DRAWING NUMBER: MD - 216 - 3520 - EG - CV - DED - 1285
REV: D01

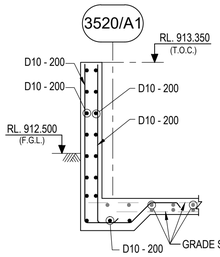


SECTION : D4 - D4
(REF. GA DWG.)
(SCALE 1:30)

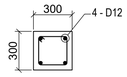


SECTION : 16F - 16F
(SCALE 1:25)

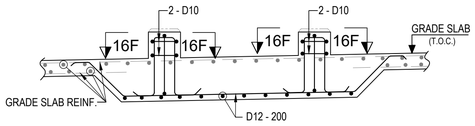


DETAIL OF PEDESTAL MKD. P-1A
(REF. GA DWG.)
(SCALE 1:30)

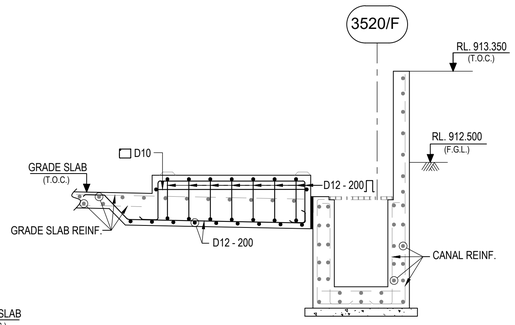


SECTION : D5 - D5
(REF. GA DWG.)
(SCALE 1:30)

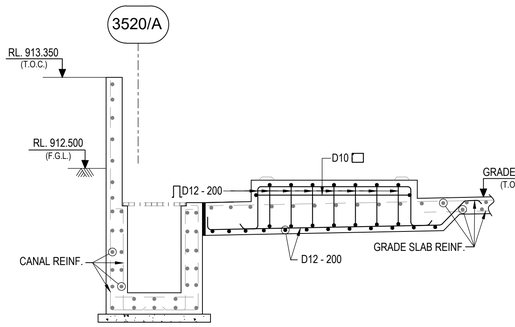


SECTION : D6 - D6
(REF. GA DWG.)
(SCALE 1:30)

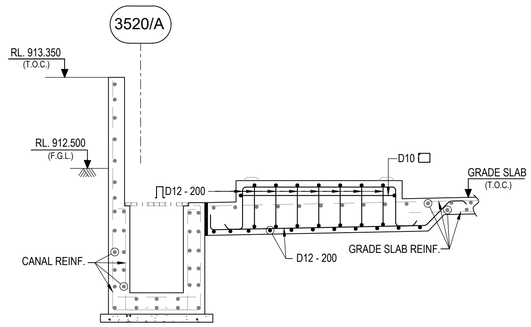


SECTION : D6A - D6A
(REF. GA DWG.)
(SCALE 1:30)

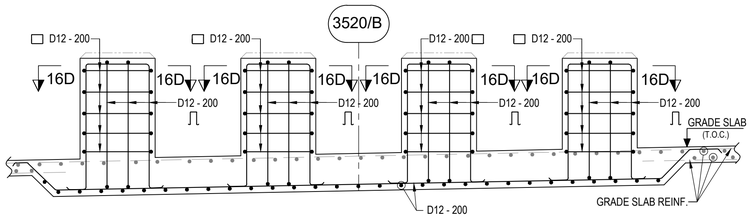


DETAIL OF PEDESTAL MKD. P-22, P-23, P-24 & P-25
(REF. GA DWG.)
(SCALE 1:30)

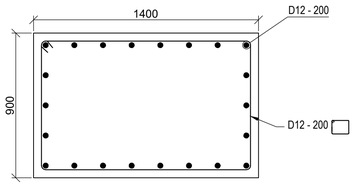


SECTION 16A - 16A
(SCALE 1:20)

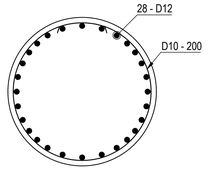


SECTION 16B - 16B
(SCALE 1:30)

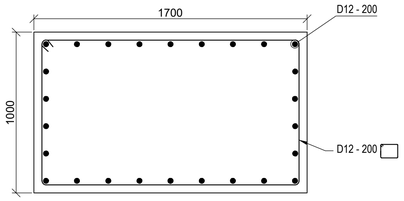


SECTION 16C - 16C
(SCALE 1:20)

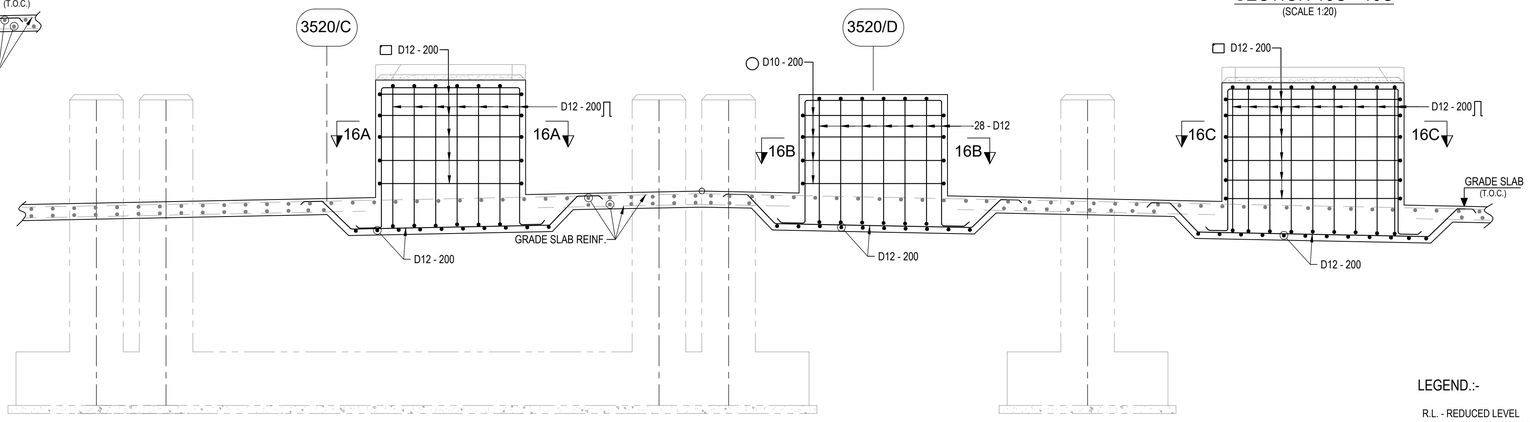


DETAIL OF PEDESTAL MKD. P-16, P-17, P-18, P-19 & P-20
(REF. GA DWG.)
(SCALE 1:30)

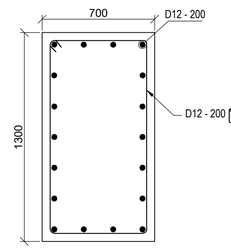


SECTION 16D - 16D
(SCALE 1:20)

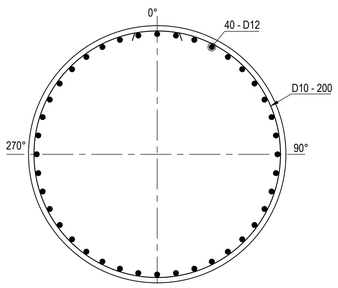


SECTION 5A - 5A
(SCALE 1:30)

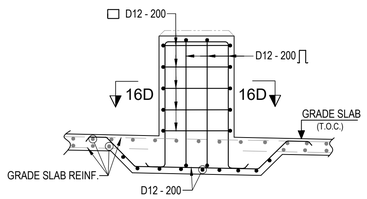


DETAIL OF PEDESTAL MKD. P-3 & P-4
(REF. GA DWG.)
(SCALE 1:30)

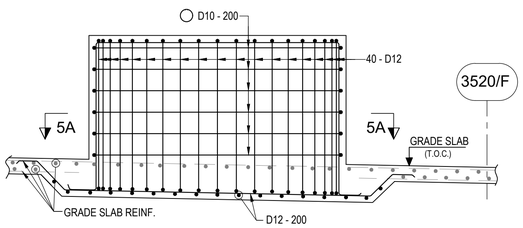

DETAIL OF PEDESTAL MKD. P-5
(REF. GA DWG.)
(SCALE 1:30)

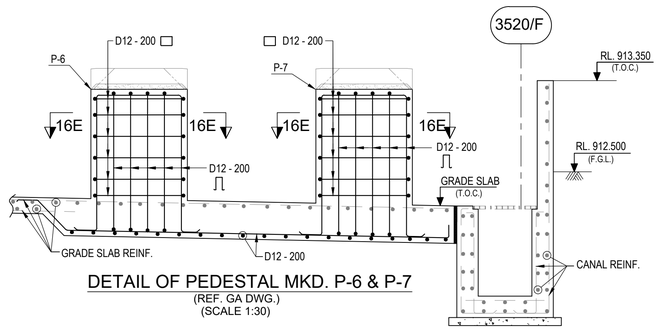

DETAIL OF PEDESTAL MKD. P-6 & P-7
(REF. GA DWG.)
(SCALE 1:30)

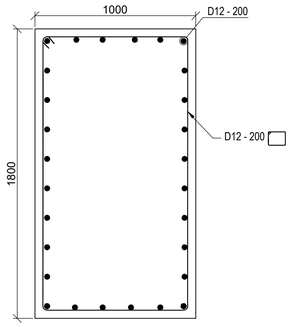

SECTION 16E - 16E
(SCALE 1:20)

LEGEND.:-

R.L. - REDUCED LEVEL
T.O.C - TOP OF CONCRETE
F.G.L - FINISHED GROUND LEVEL
P.C.C - PLAIN CEMENT CONCRETE
TYP - TYPICAL
MKD - MARKED
℄ - CENTRE LINE
MIN. - MINIMUM
REF. - REFER
GA - GENERAL ARRANGEMENT
DRG. - DRAWING
REINF. - REINFORCEMENT

NOTES:-

1. ALL DIMENSIONS ARE IN MILLIMETRES AND LEVELS ARE IN METRES UNLESS OTHERWISE STATED.
2. GRADE OF CONCRETE SHALL BE C35 UNLESS NOTED OTHERWISE.
3. GRADE OF REINFORCEMENT SHALL BE DEFORMED BAR ASTM A615-GRADE 60 (fy=420 MPa)
4. CLEAR COVER TO MAIN REINFORCEMENT SHALL BE AS FOLLOWS:
   a) WALL : 50 mm. (FOR DOUBLE LAYER REINF.)
      75 mm. (FOR SINGLE LAYER REINF.)
   b) PEDESTAL : 50 mm.
5. FOR LAP & SPLICE LENGTHS OF REINF. REF. DWG. NO. MD-216-1000-EG-CV-DED-1001.
6. FOR GA DRAWING REF. DRG. NO. MD - 216 - 3520 - EG - CV - GAD - 1284.
   MD - 216 - 3520 - EG - CV - GAD - 1285.
   MD - 216 - 3520 - EG - CV - GAD - 1286.
   MD - 216 - 3520 - EG - CV - GAD - 1287.
   MD - 216 - 3520 - EG - CV - GAD - 1288.
7. FOR GENERAL NOTE OF CIVIL WORK REF. DRG. NO : MD-216-1000-EG-CV-DED-1001.
8. REINFORCEMENT MAY BE ADJUSTED AT SITE TO ACCOMMODATE EMBEDDED PART.

DOCUMENT NUMBER	REFERENCE DOCUMENTS	REV	DATE	REVISION DESCRIPTION	DRN	CHK	ENG	APP	EMP
		D01	22/02/2023	AS-BUILT	SBH	BDA	STY	AG	
		C02	19/10/2020	ISSUED FOR CONSTRUCTION & REVISED AS MKD.	SBH	BDA	STY	AG	
		C01	08/07/2020	ISSUED FOR CONSTRUCTION	SBH	BDA	STY	AG	
		A01	18/05/2020	ISSUED FOR REFERENCE	SBH	BDA	STY	AG	

RESERVED FOR VENDOR LOGO AND DRAWING NUMBER

LARSEN & TOUBRO

This drawing is the property of LARSEN & TOUBRO and must not be passed on to any person or body not authorized by us to receive it nor be copied or otherwise made use either in full or in part by such person or body without our prior permission in writing.

Outotec

The content of these documents are the sole property of Outotec Oyj. Any rights not expressly granted herein are reserved. Reproduction, transfer or distribution of part or all of the contents in any form without prior written permission of Outotec is prohibited.

MA'ADEN معادن
Saudi Arabian Mining Company شركة التعدين العربية السعودية

This document and the information contained herein is Ma'aden proprietary know-how. This document or any part thereof should not be reproduced, stored in a retrieval system or transmitted by any means, electronic or otherwise, or divulged without prior written permission of Ma'aden.

LARSEN & TOUBRO DRAWING NUMBER: 019045_450_C_D_24120_003 — REVISION: 3
OUTOTEC DRAWING NUMBER: 900707__GAU01__RN13__CTB17__35202 — DOCUMENT ID: OU100676809 — REVISION: 3

DRAWN	SBH	15/05/2020
CHECKED	BDA	16/05/2020
ENGINEER	STY	15/05/2020
APPROVED	AG	18/05/2020
EMPLOYER		
SCALE	1:30	A1

MANSOURAH - MASSARAH GOLD PROJECT
DETAIL DRAWING
NEUTRALIZATION AND THICKENING
GRADE SLAB

DRAWING NUMBER: MD - 216 - 3520 - EG - CV - DED - 1285 — REV: D01