


DRAWING NUMBER: MD - 216 - 3520 - EG - CV - DED - 1286 | REV: D01

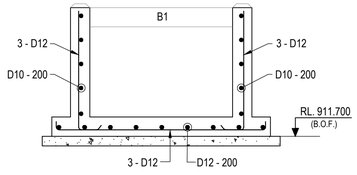


SECTION : A3 - A3
(SCALE 1:25)

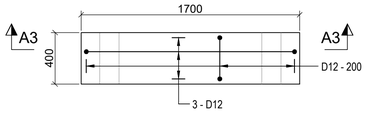


DETAIL OF FOUNDATION MKD. F1B & F1C
(SCALE 1:25)

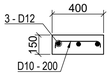


DETAIL OF B1
(SCALE-1:25)

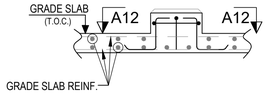


DETAIL OF FOUNDATION MKD. F1F & F1L
(SCALE 1:25)

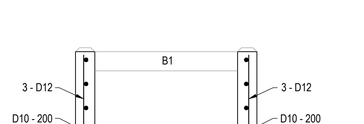


SECTION : A1 - A1
(SCALE 1:25)

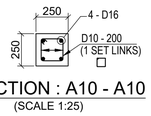


SECTION : A10 - A10
(SCALE 1:25)

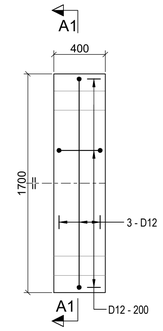


DETAIL OF FOUNDATION MKD. F1A & F1D
(SCALE 1:25)

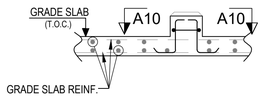


DETAIL OF FOUNDATION MKD. F1E, F1G, F1H, F1K, F1KA & F1KB
(SCALE 1:25)

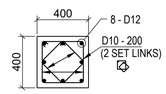


SECTION : B8 - B8
(SCALE 1:25)

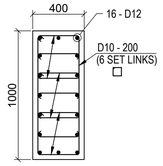


SECTION : B9 - B9
(SCALE 1:25)

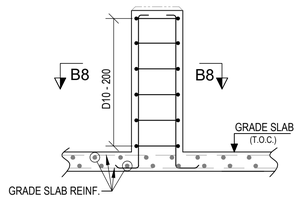


DETAIL OF PEDESTAL MKD. P1N & P1P
(SCALE 1:25)

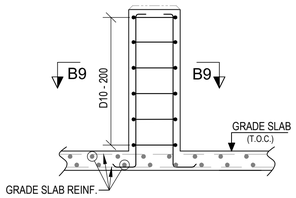

DETAIL OF PEDESTAL MKD. P1Q
(SCALE 1:25)

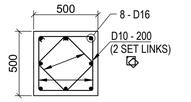


SECTION : B5 - B5
(SCALE 1:25)

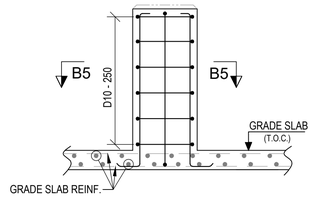


DETAIL OF PEDESTAL MKD. P1F
(SCALE 1:25)

SECTION : B6 - B6
(SCALE 1:25)

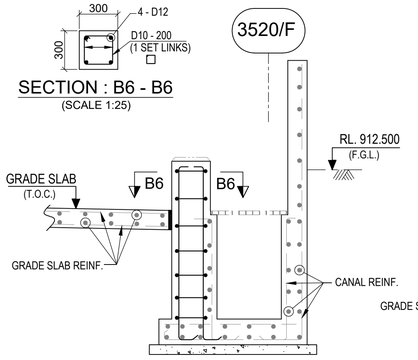


DETAIL OF PEDESTAL MKD. P1G
(SCALE 1:25)

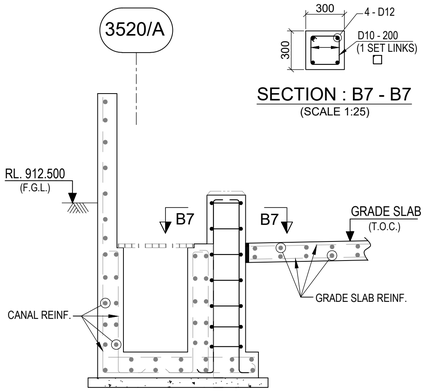


DETAIL OF PEDESTAL MKD. P1L
(SCALE 1:25)


SECTION : B7 - B7
(SCALE 1:25)

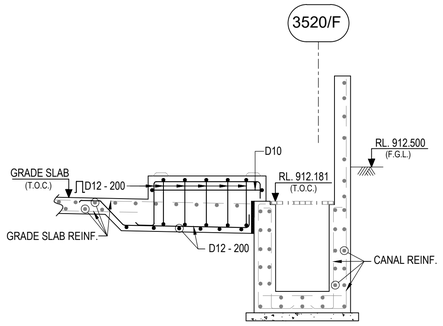


SECTION : D6D - D6D
(REF. GA DWG.)
(SCALE 1:30)

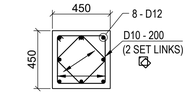


SECTION : B1C - B1C
(SCALE 1:25)

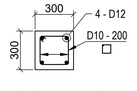


SECTION : B1B - B1B
(SCALE 1:25)

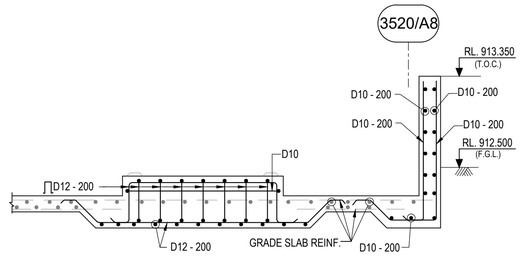


SECTION : D6B - D6B
SECTION : D6C - D6C
(REF. GA DWG.)
(SCALE 1:30)

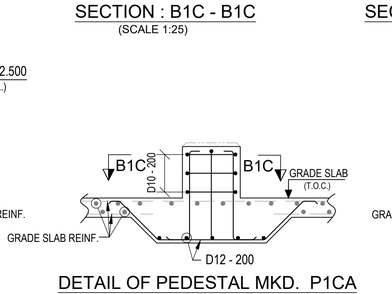


DETAIL OF PEDESTAL MKD. P1CA
(SCALE 1:25)

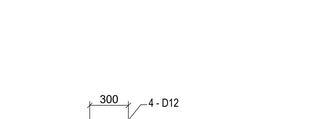


DETAIL OF PEDESTAL MKD. P1CB
(SCALE 1:25)

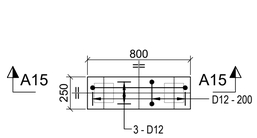


DETAIL OF FOUNDATION MKD. F1J
(SCALE 1:25)

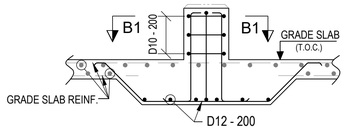


DETAIL OF PEDESTAL MKD. P1B
(SCALE 1:25)

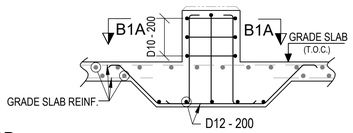


DETAIL OF PEDESTAL MKD. P1C
(SCALE 1:25)

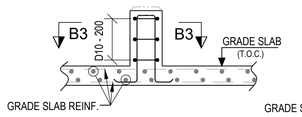

DETAIL OF PEDESTAL MKD. P1D, P1H, P1J, P1K & P1M
(SCALE 1:25)

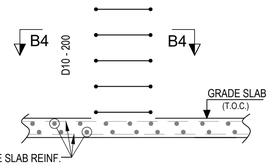

DETAIL OF PEDESTAL MKD. P1E
(SCALE 1:25)

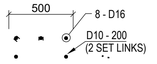

LEGEND.:-

R.L. - REDUCED LEVEL
T.O.C - TOP OF CONCRETE
F.G.L - FINISHED GROUND LEVEL
P.C.C - PLAIN CEMENT CONCRETE
TYP - TYPICAL
MKD - MARKED
℄ - CENTRE LINE
MIN. - MINIMUM
REF. - REFER
GA - GENERAL ARRANGEMENT
DRG. - DRAWING
REINF. - REINFORCEMENT

NOTES:-

1. ALL DIMENSIONS ARE IN MILLIMETRES AND LEVELS ARE IN METRES UNLESS OTHERWISE STATED.
2. GRADE OF CONCRETE SHALL BE C35 UNLESS NOTED OTHERWISE.
3. GRADE OF REINFORCEMENT SHALL BE DEFORMED BAR ASTM A615-GRADE 60 (fy=420 MPa)
4. CLEAR COVER TO MAIN REINFORCEMENT SHALL BE AS FOLLOWS:
   a) WALL : 50 mm. (FOR DOUBLE LAYER REINF.)
      75 mm. (FOR SINGLE LAYER REINF.)
   b) PEDESTAL : 50 mm.
5. FOR LAP & SPLICE LENGTHS OF REINF. REF. DRG. NO. MD-216-1000-EG-CV-DED-1001.
6. FOR GA DRAWING REF. DRG. NO. MD - 216 - 3520 - EG - CV - GAD - 1284.
   MD - 216 - 3520 - EG - CV - GAD - 1285.
   MD - 216 - 3520 - EG - CV - GAD - 1286.
   MD - 216 - 3520 - EG - CV - GAD - 1287.
   MD - 216 - 3520 - EG - CV - GAD - 1288.
7. FOR GENERAL NOTE OF CIVIL WORK REF. DRG. NO : MD-216-1000-EG-CV-DED-1001.
8. REINFORCEMENT MAY BE ADJUSTED AT SITE TO ACCOMMODATE EMBEDDED PART.

DOCUMENT NUMBER	REFERENCE DOCUMENTS	REV	DATE	REVISION DESCRIPTION	DRN	CHK	ENG	APP	EMP
		D01	22/02/2023	AS-BUILT	SBH	BDA	STY	AG	
		C03	23/02/2021	ISSUED FOR CONSTRUCTION & REVISED AS MKD.	SBH	BDA	STY	AG	
		C02	21/12/2020	ISSUED FOR CONSTRUCTION & REVISED AS MKD.	SBH	BDA	STY	AG	
		C01	09/11/2020	ISSUED FOR CONSTRUCTION	SBH	BDA	STY	AG	
		A01	20/10/2020	ISSUED FOR REFERENCE	SBH	BDA	STY	AG	

RESERVED FOR VENDOR LOGO AND DRAWING NUMBER

LARSEN & TOUBRO DRAWING NUMBER: 019045_450_C_D_24120_004 | REVISION: 4
OUTOTEC DRAWING NUMBER: 900707__GAU01__RN13__CTB17__35208 | DOCUMENT ID: OU100698207 | REVISION: 4

LARSEN & TOUBRO
This drawing is the property of LARSEN & TOUBRO and must not be passed on to any person or body not authorized by us to receive it nor be copied or otherwise made use either in full or in part by such person or body without our prior permission in writing.

Outotec
The content of these documents are the sole property of Outotec Oyj. Any rights not expressly granted herein are reserved. Reproduction, transfer or distribution of part or all of the contents in any form without prior written permission of Outotec is prohibited.

MA'ADEN معادن
Saudi Arabian Mining Company شركة التعدين العربية السعودية
This document and the information contained herein is Ma'aden proprietary know-how. This document or any part thereof should not be reproduced, stored in a retrieval system or transmitted by any means, electronic or otherwise, or divulged without prior written permission of Ma'aden.

DRAWN	SBH	16/10/2020	MANSOURAH - MASSARAH GOLD PROJECT
CHECKED	BDA	17/10/2020	DETAIL DRAWING
ENGINEER	STY	16/10/2020	NEUTRALIZATION AND THICKENING
APPROVED	AG	19/10/2020	PLATFORM SUPPORT,STAIR & PEDESTAL FOUNDATION
EMPLOYER			
SCALE	1:30	A1	

DRAWING NUMBER: MD - 216 - 3520 - EG - CV - DED - 1286 | REV: D01