MD-216-3520-EG-CV-GAD-1006 DRAWING NUMBER REV D01

PV-A1
1:50

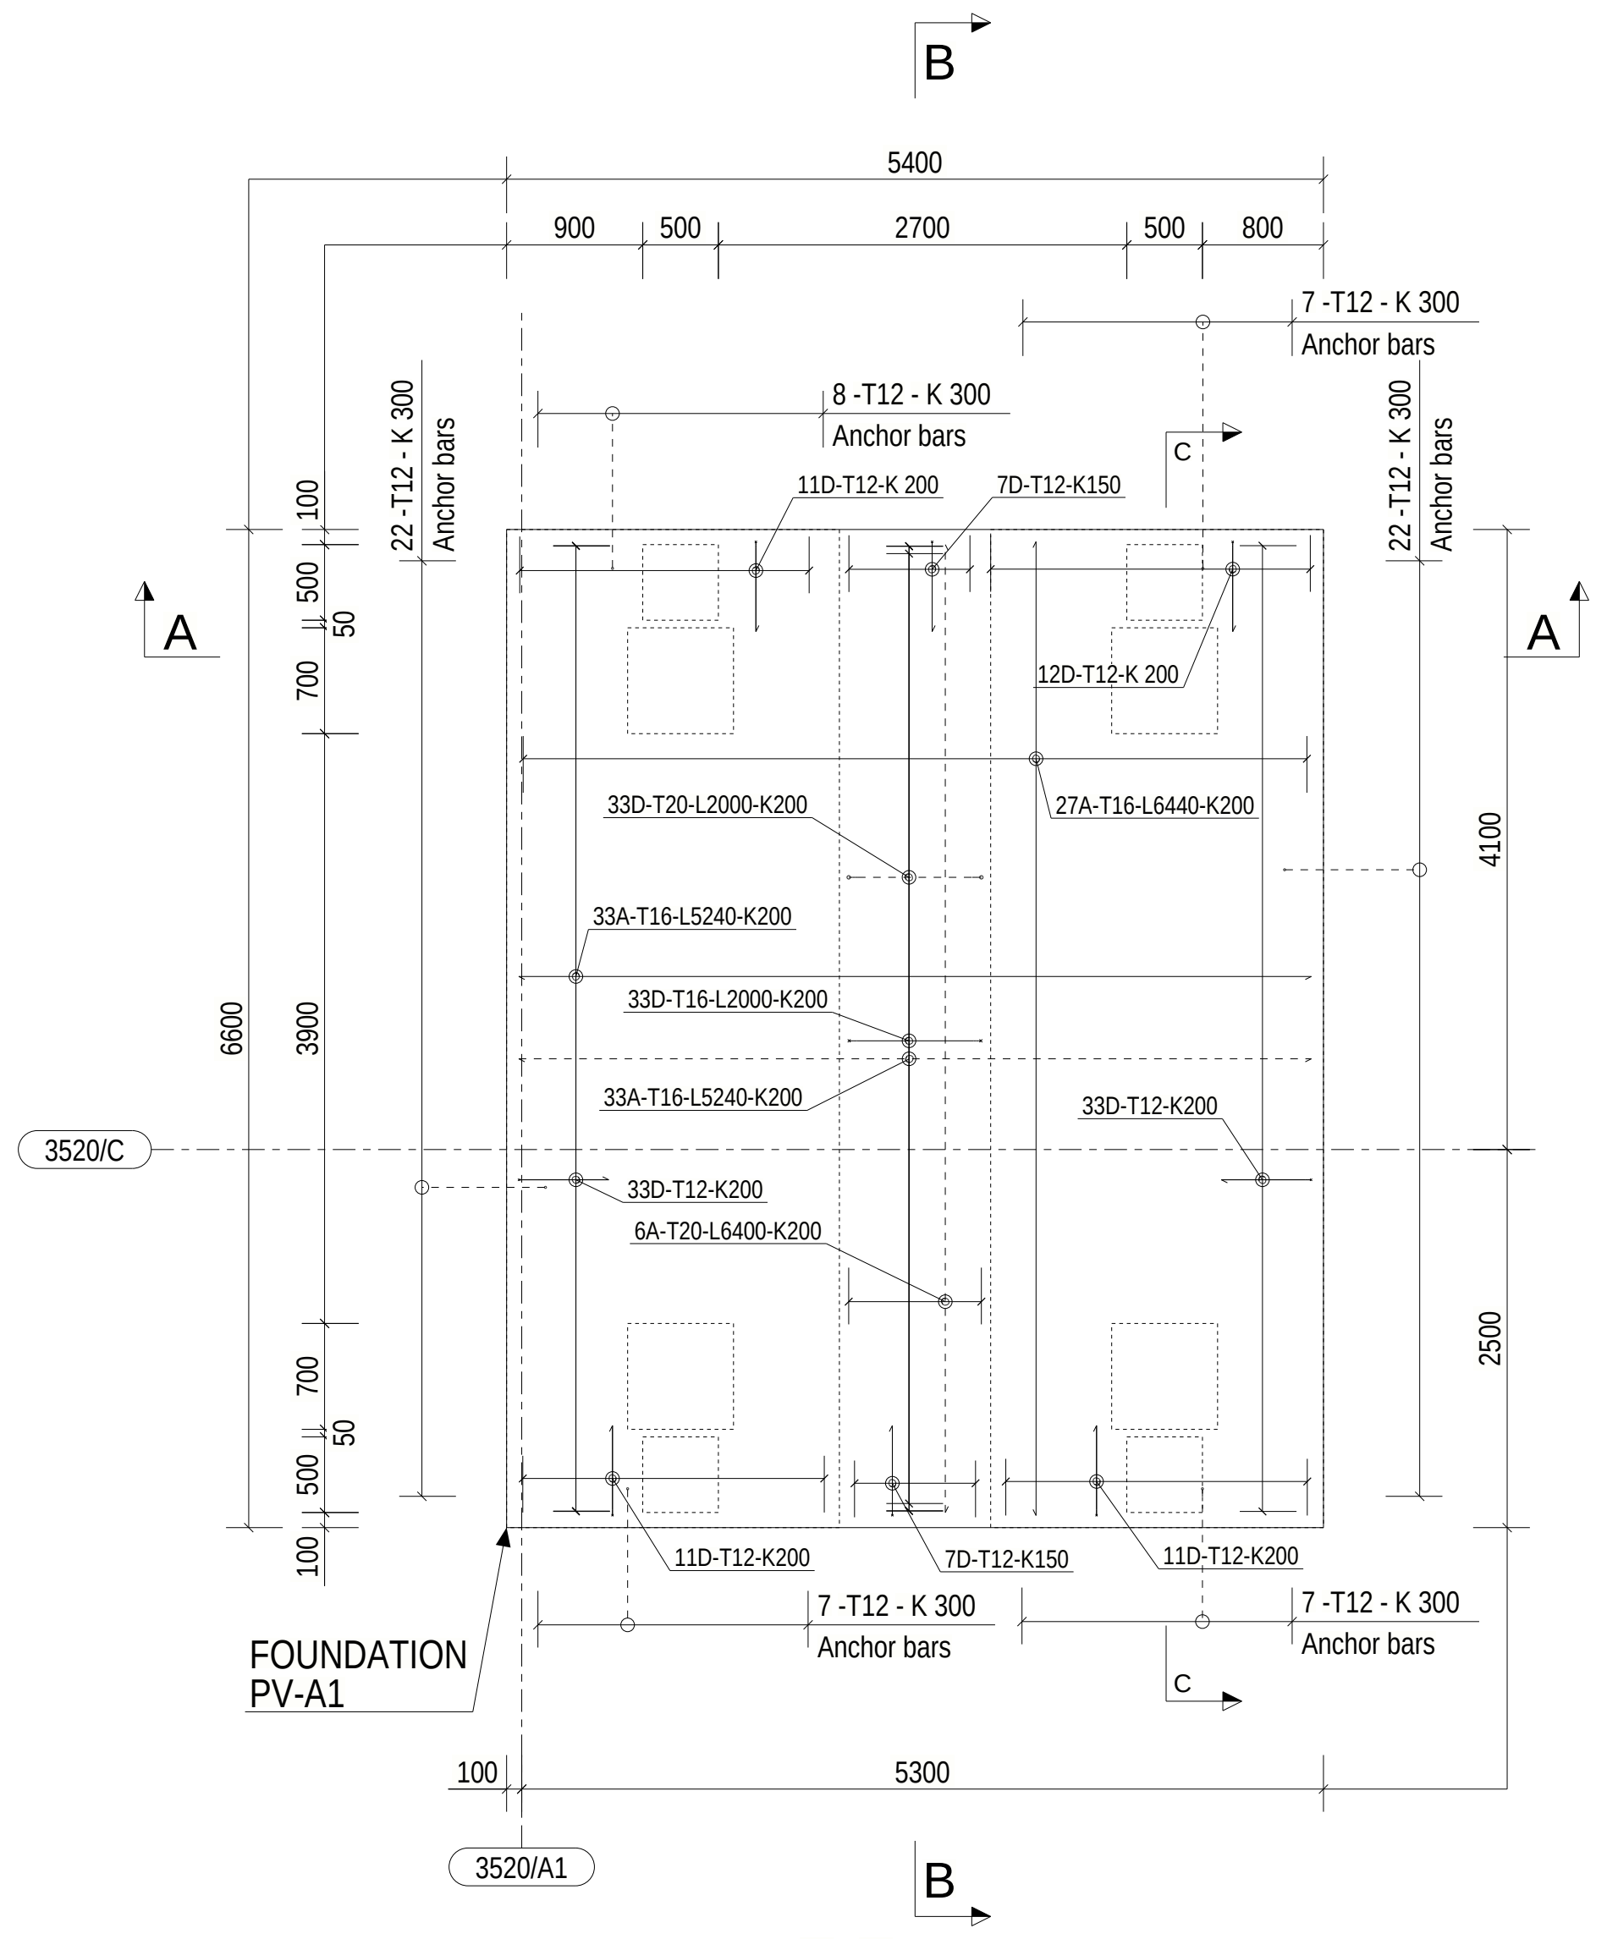
B
5400
900
500
2700
500
800
7-T12 - K 300
Anchor bars
8 -T12 - K 300
Anchor bars
22 -T12 - K 300
Anchor bars
A
A
3520/C
6600
5300
4100
2500
7 -T12 - K 300
Anchor bars
FOUNDATION
PV-A1
3520/A1
B

PV-A2
1:50

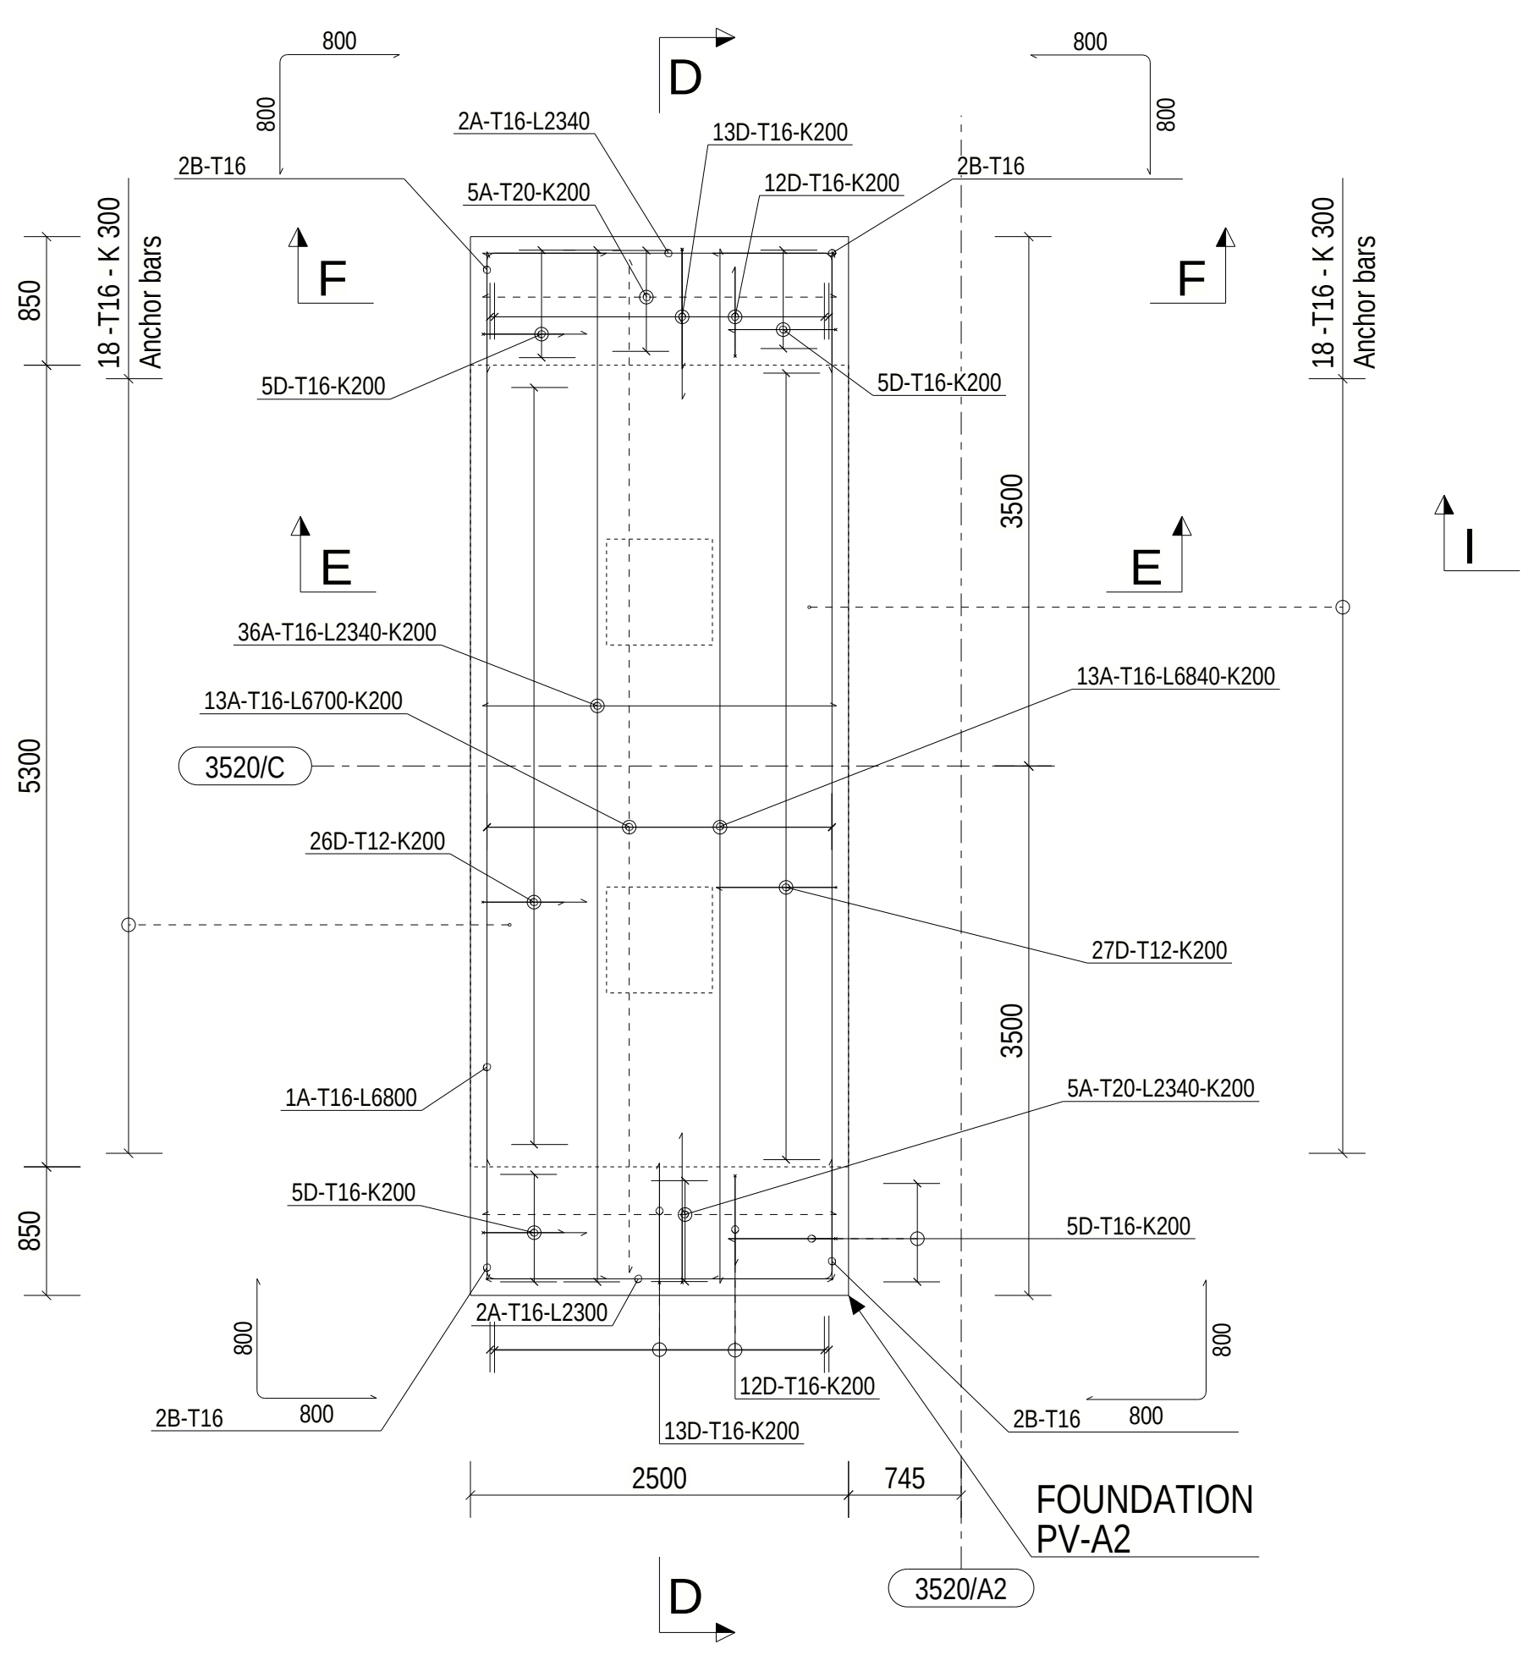
D
F
F
E
E
18 -T16 - K 300
Anchor bars
3520/C
3500
5300
2500
745
FOUNDATION
PV-A2
3520/A2
D

PV-A3
1:50

A02

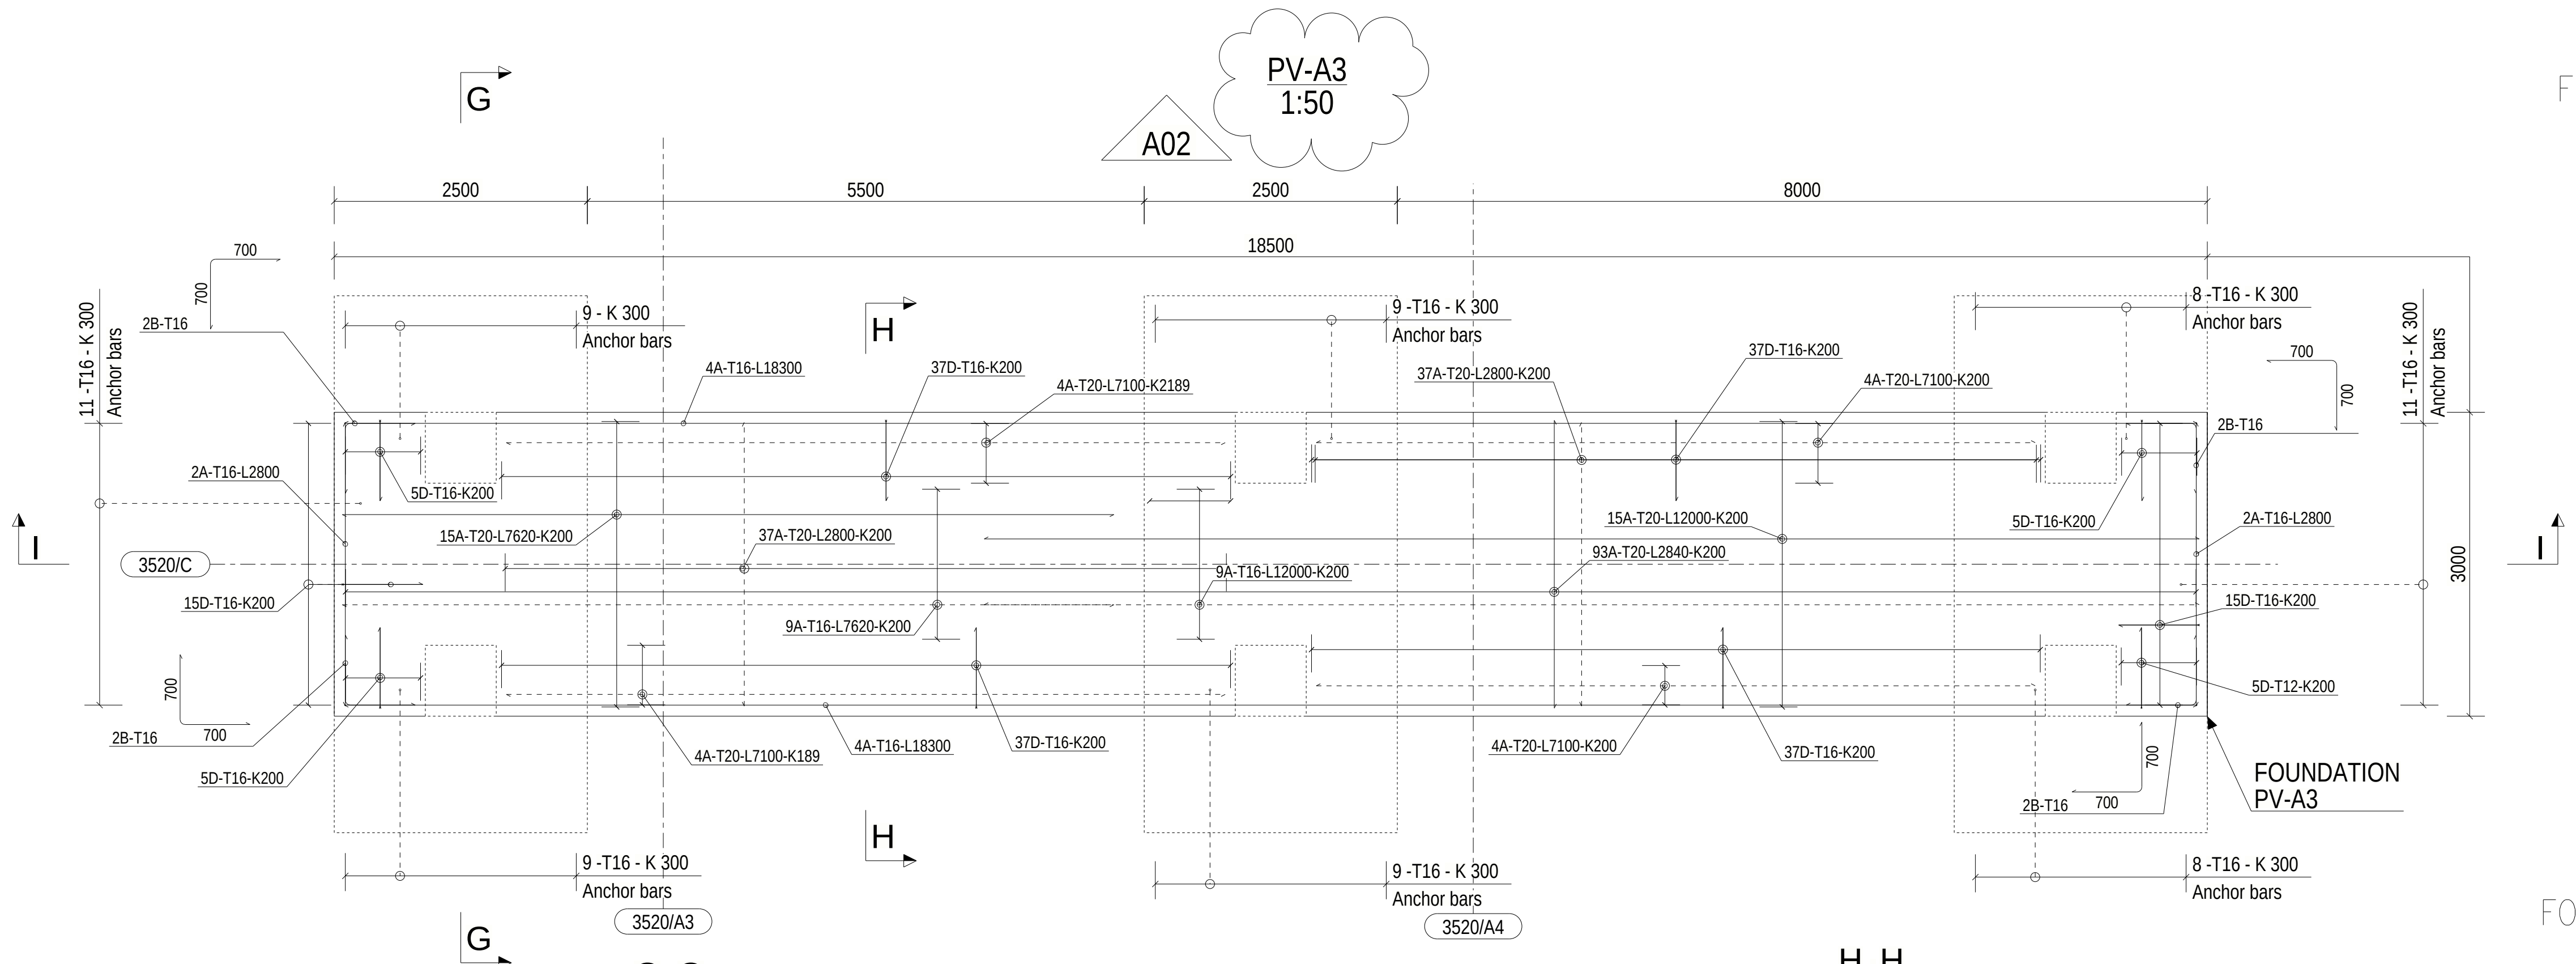
G
2500
5500
2500
8000
18500
9 - K 300
Anchor bars
9 -T16 - K 300
Anchor bars
8 -T16 - K 300
Anchor bars
11 -T16 - K 300
Anchor bars
H
I
I
3520/C
3000
FOUNDATION
PV-A3
9 -T16 - K 300
Anchor bars
3520/A3
3520/A4
H
G

FOR 500/600mm FOUNDATION TOPPING

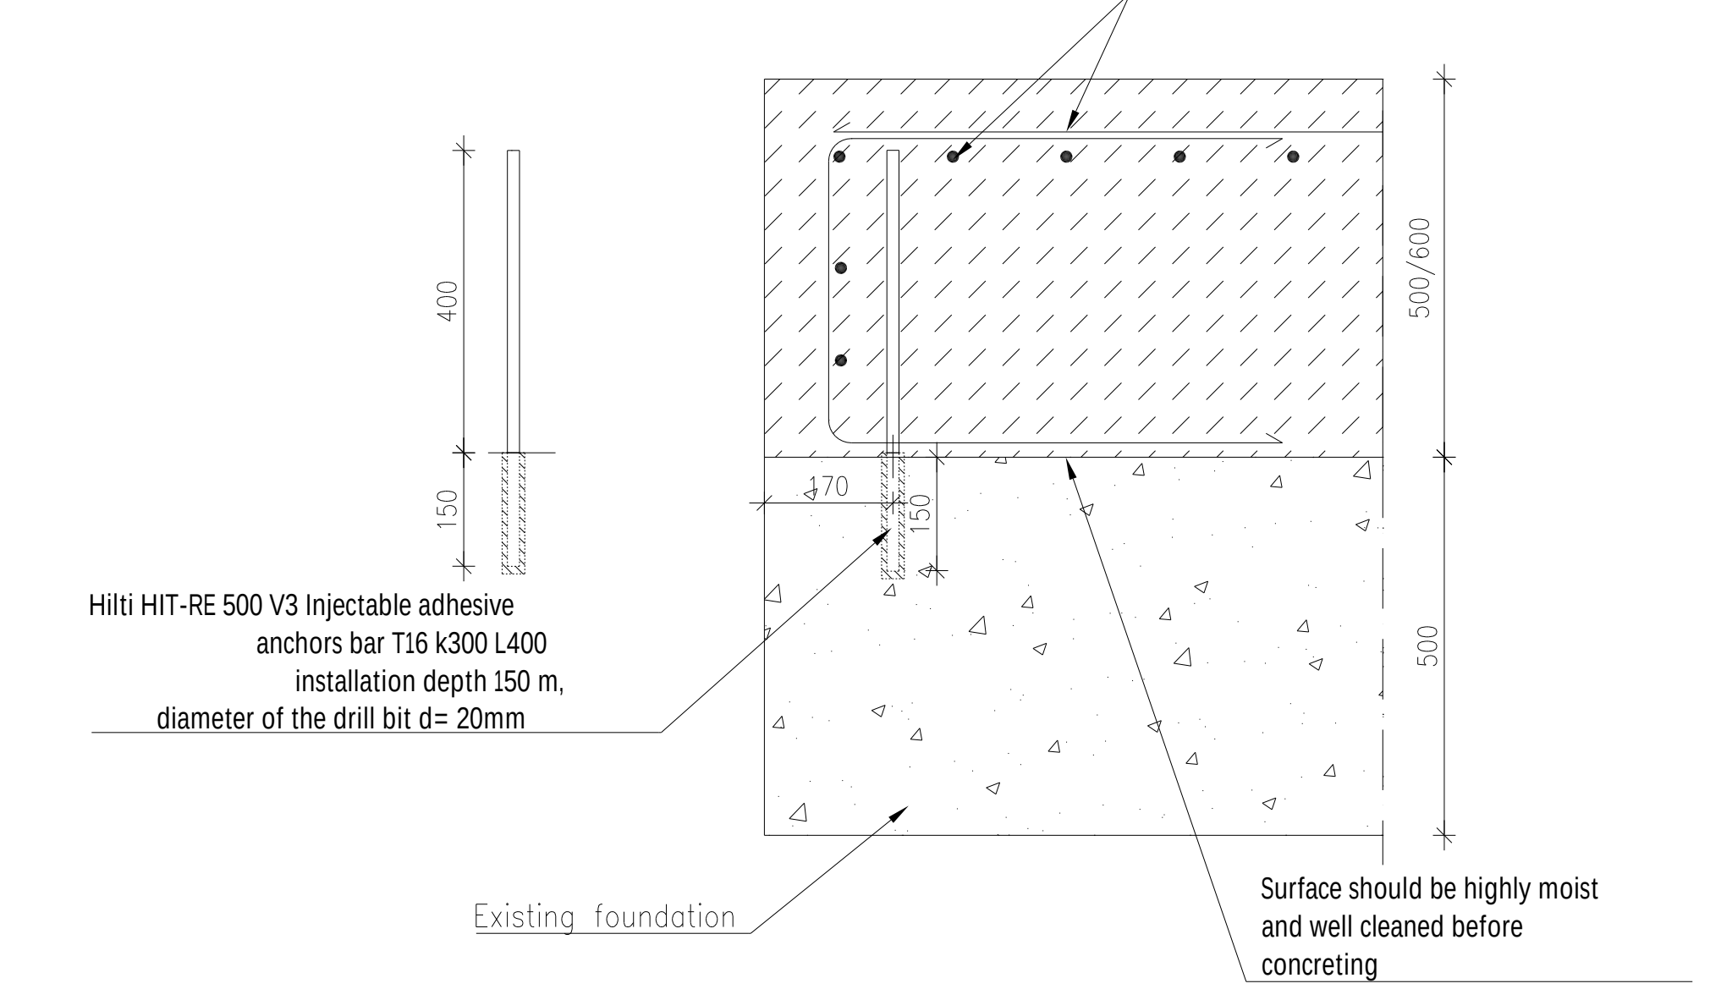
Reinforcement details according
to the main drawing
Hilti HIT-RE 500 V3 Injectable adhesive
anchors bar T16 k300 L400
installation depth 150 m,
diameter of the drill bit d= 20mm
Existing foundation
Surface should be highly moist
and well cleaned before
concreting
500/600
500
150
170
400

FOR 300mm FOUNDATION TOPPING

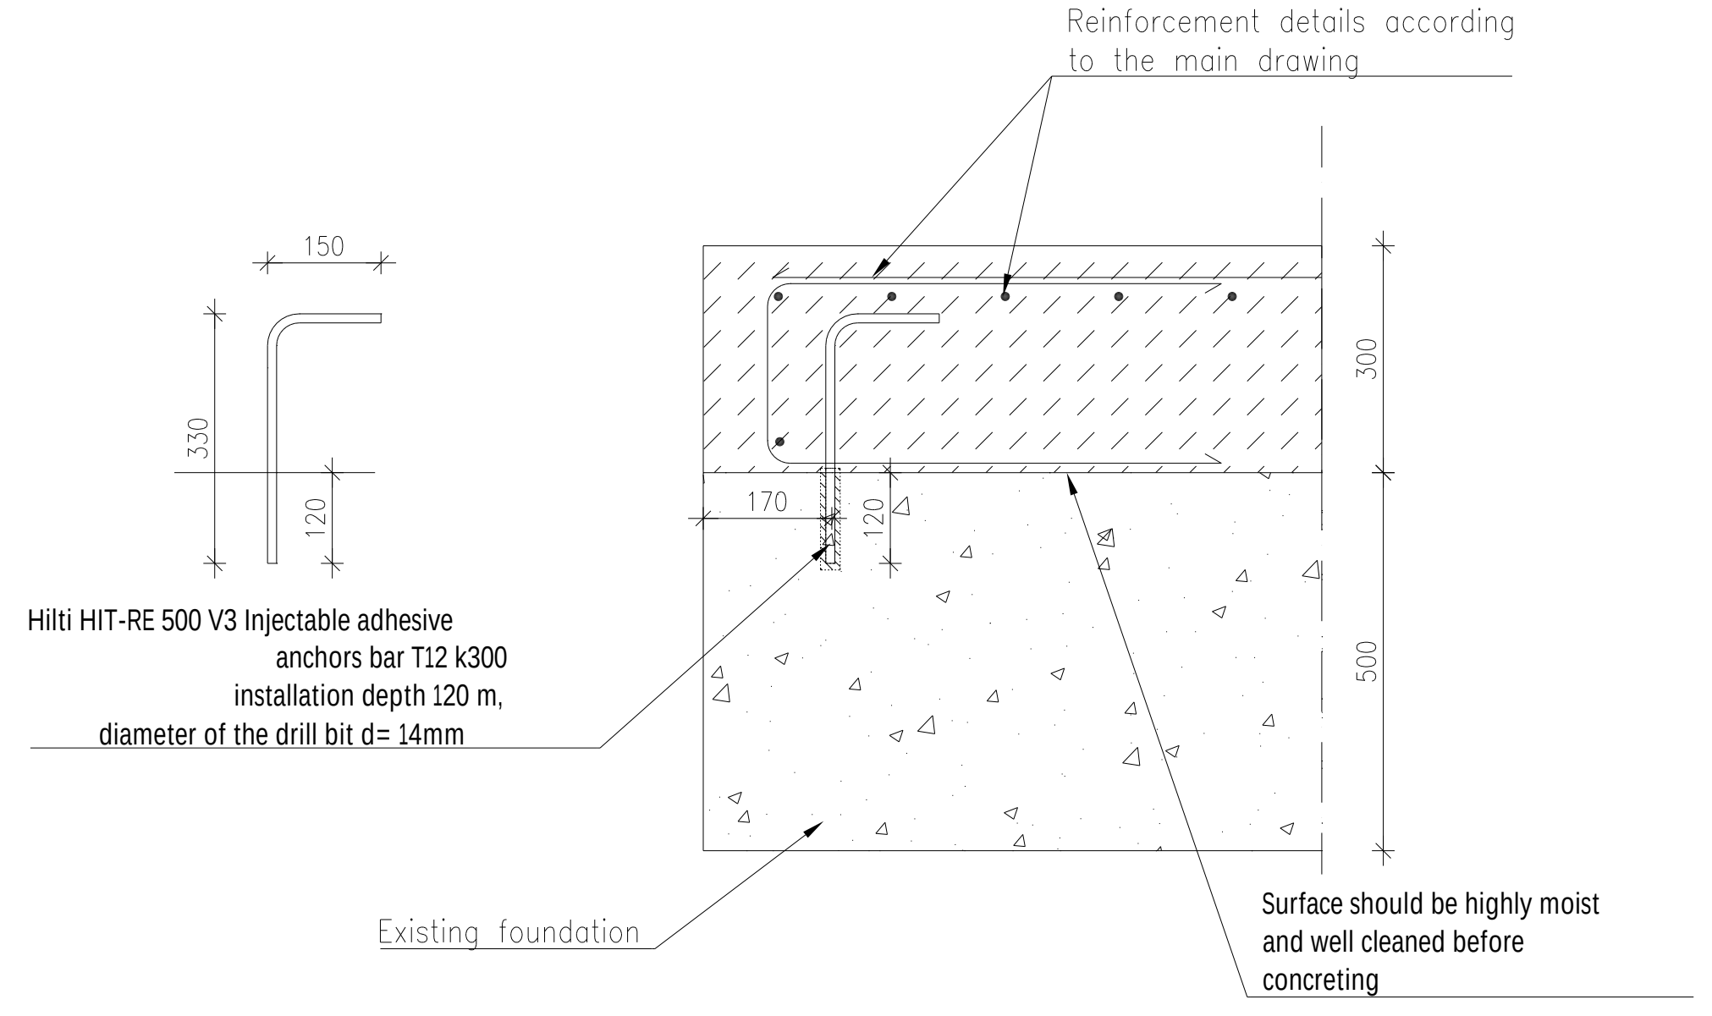
Reinforcement details according
to the main drawing
Hilti HIT-RE 500 V3 Injectable adhesive
anchors bar T12 k300
installation depth 120 m,
diameter of the drill bit d= 14mm
Existing foundation
Surface should be highly moist
and well cleaned before
concreting
150
300
500
170
120

G_G
1:50

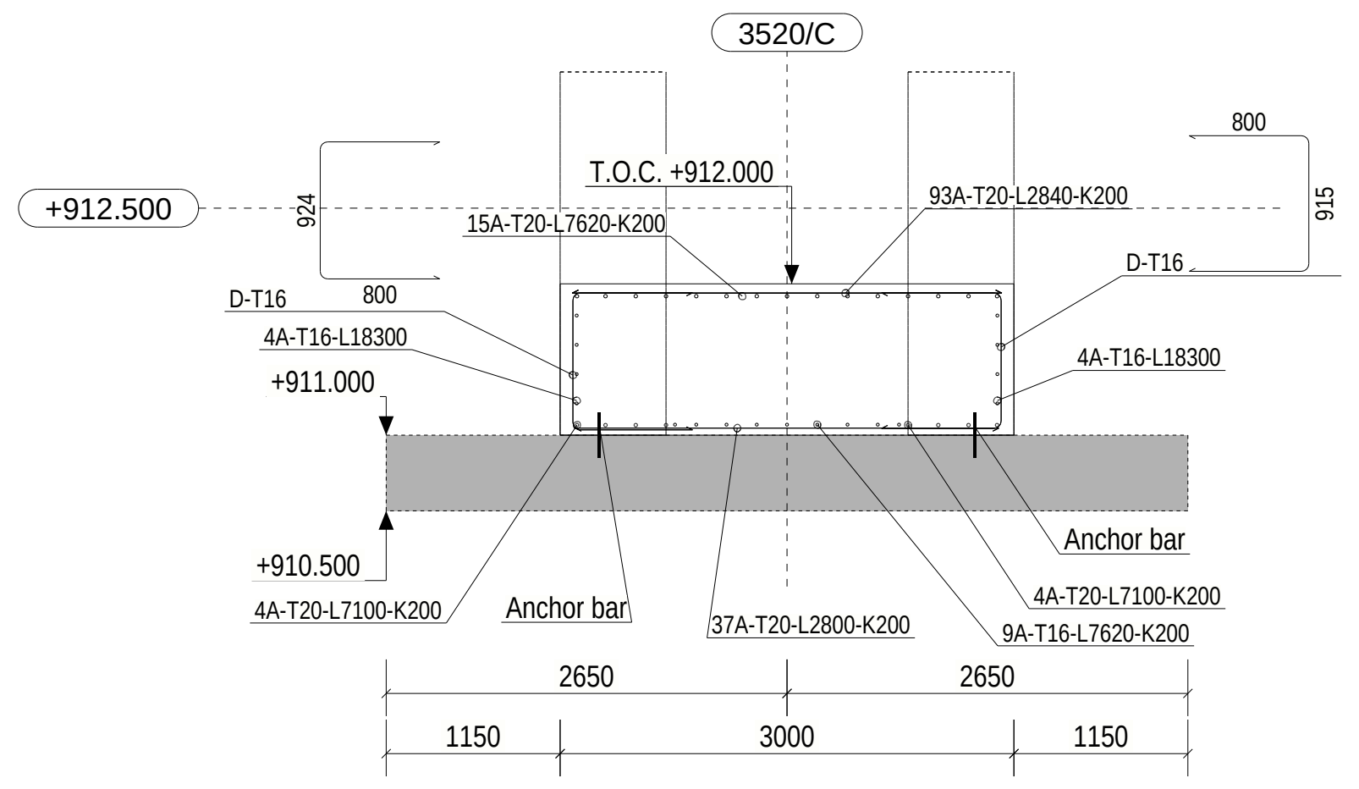
3520/C
+912.500
T.O.C. +912.000
+911.000
+910.500
Anchor bar
2650
3000
2650
1150
1150

H_H
1:50

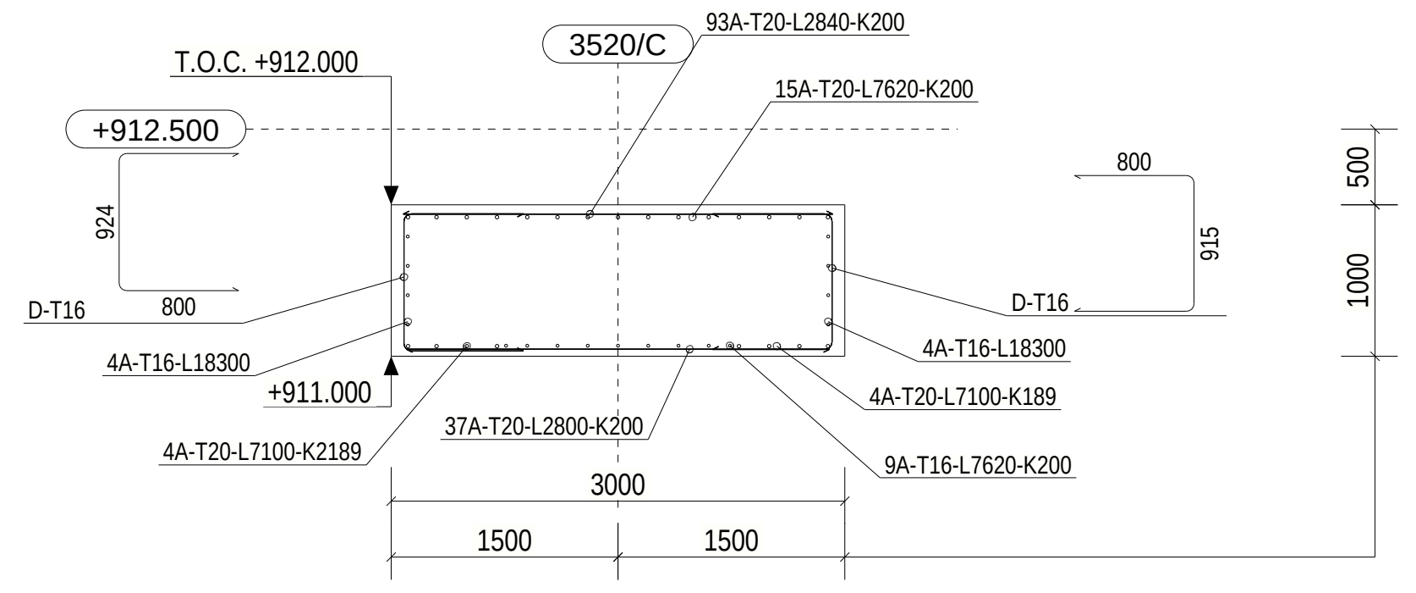
3520/C
T.O.C. +912.000
+912.500
+911.000
3000
1500
1500

A_A
1:50

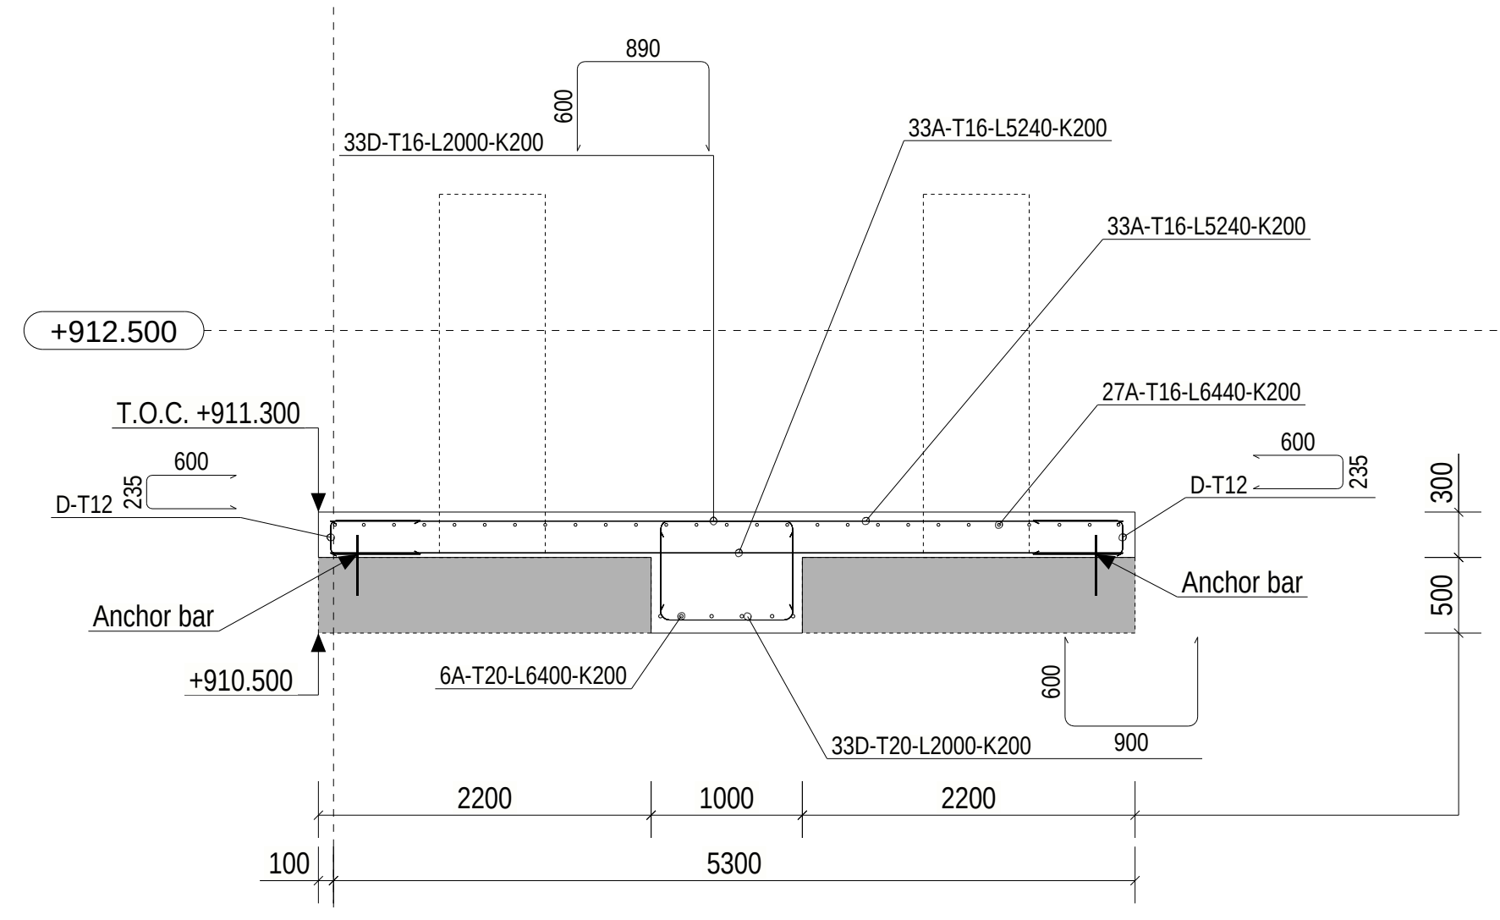
3520/A1
+912.500
T.O.C. +911.300
Anchor bar
Anchor bar
+910.500
2200
1000
2200
5300

D_D
1:50

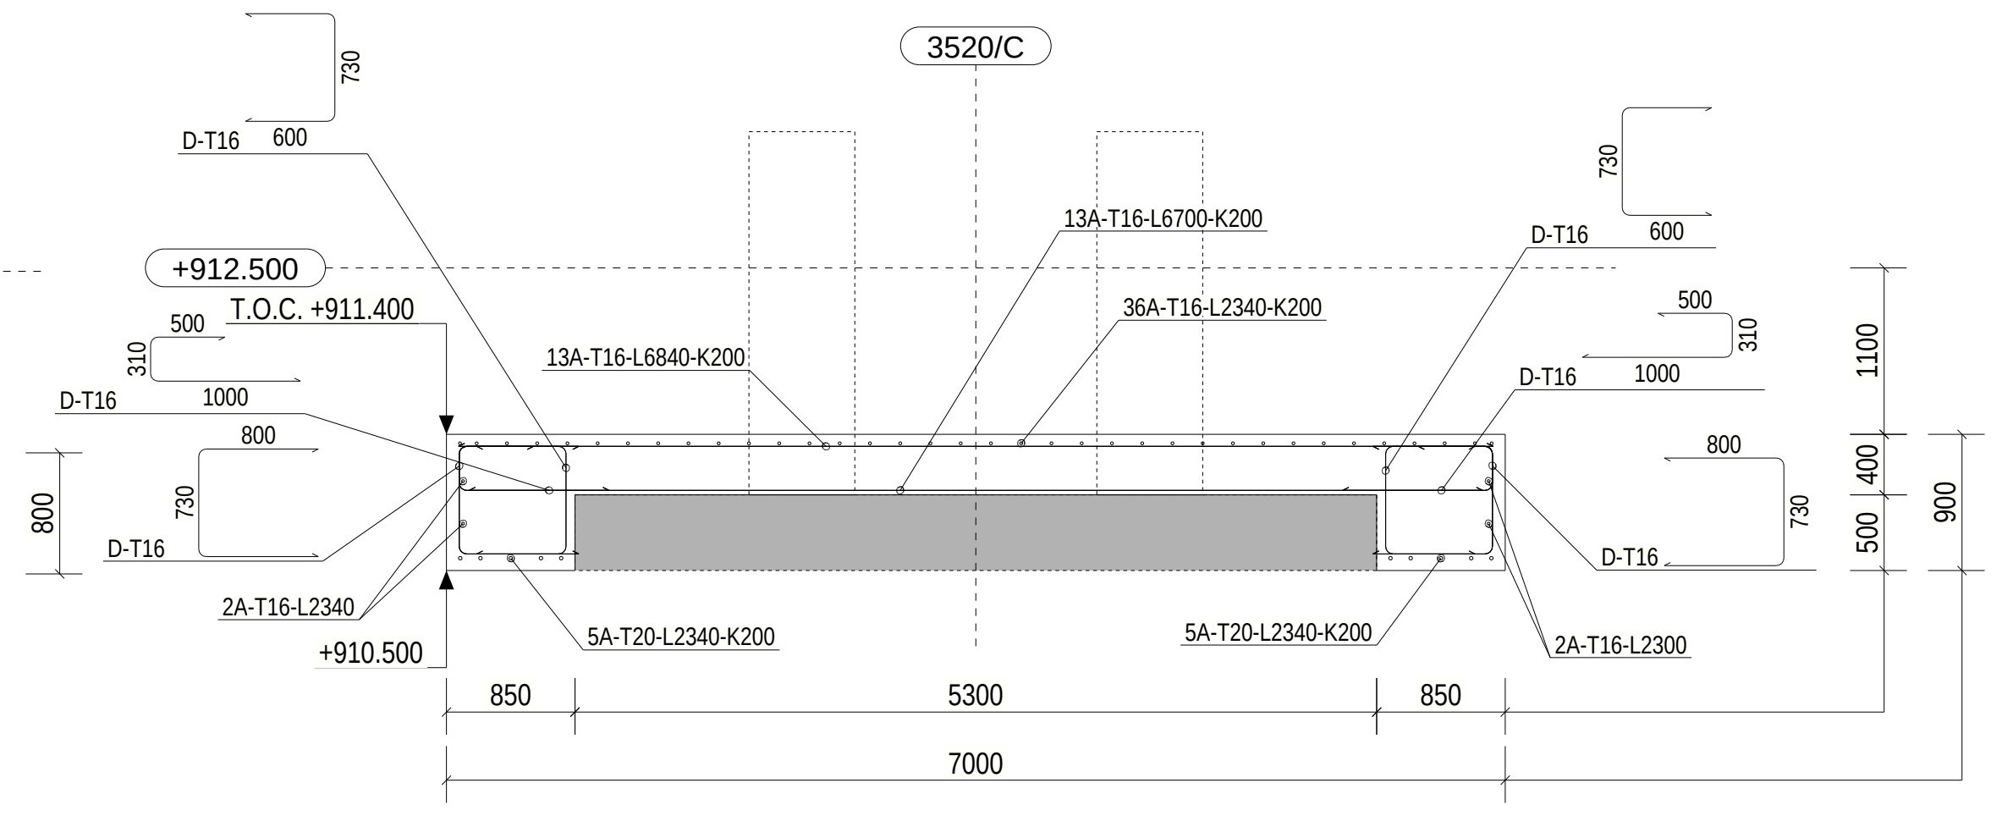
3520/C
+912.500
T.O.C. +911.400
+910.500
850
5300
850
7000

I_I
1:50

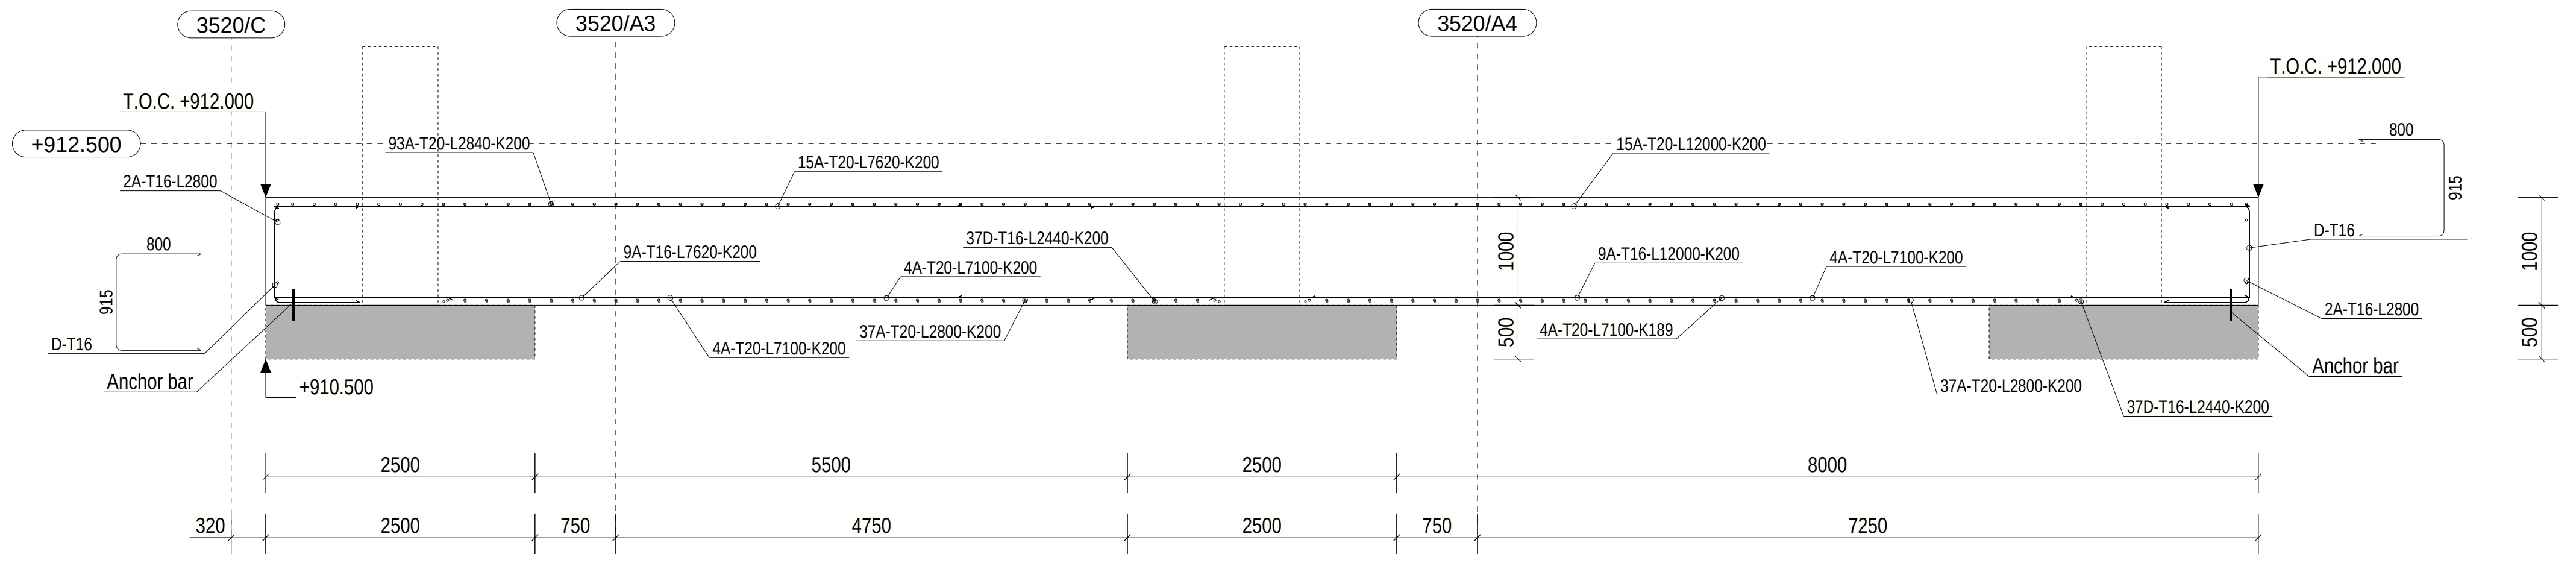
3520/C
3520/A3
3520/A4
T.O.C. +912.000
T.O.C. +912.000
+912.500
Anchor bar
Anchor bar
+910.500
2500
5500
2500
8000
320
2500
750
4750
2500
750
7250

B_B
1:50

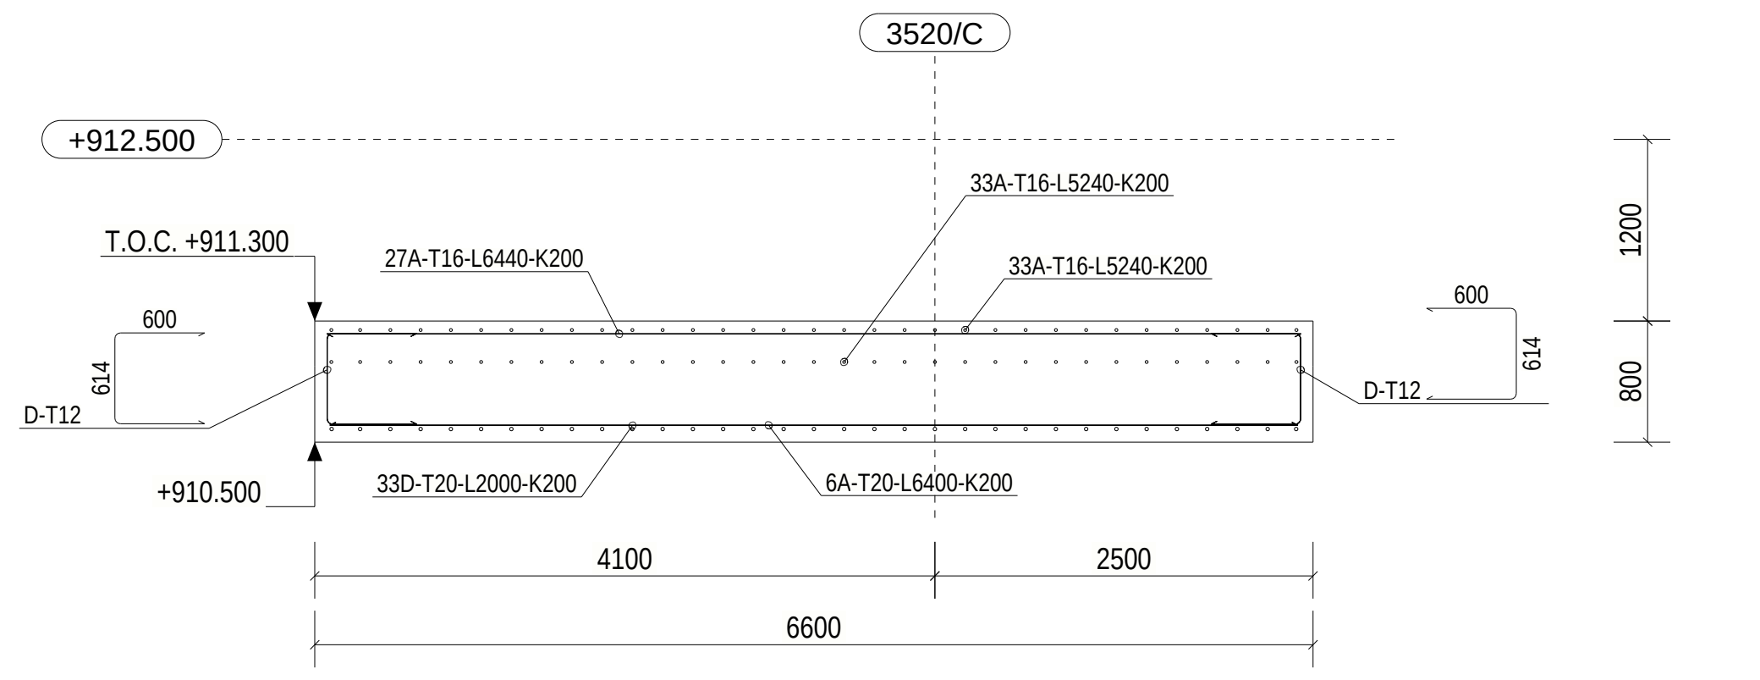
3520/C
+912.500
T.O.C. +911.300
+910.500
4100
2500
6600

E_E
1:50

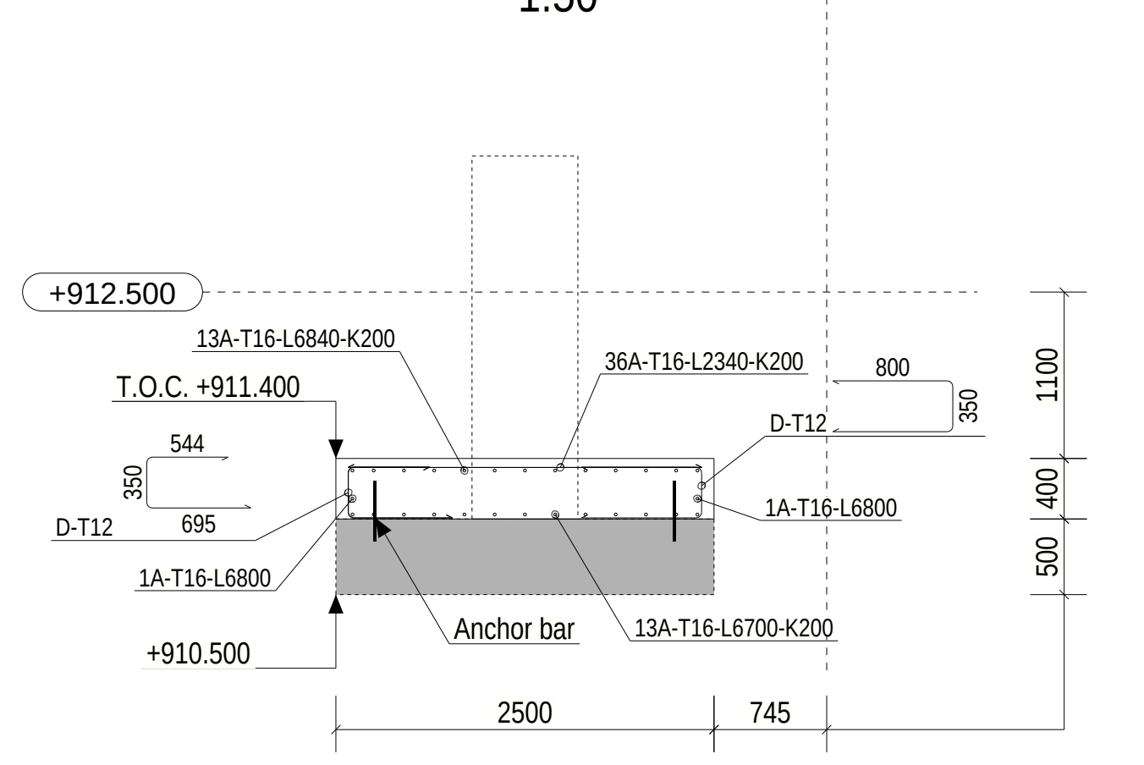
3520/A2
+912.500
T.O.C. +911.400
Anchor bar
+910.500
2500
745

PV-A4
1:50

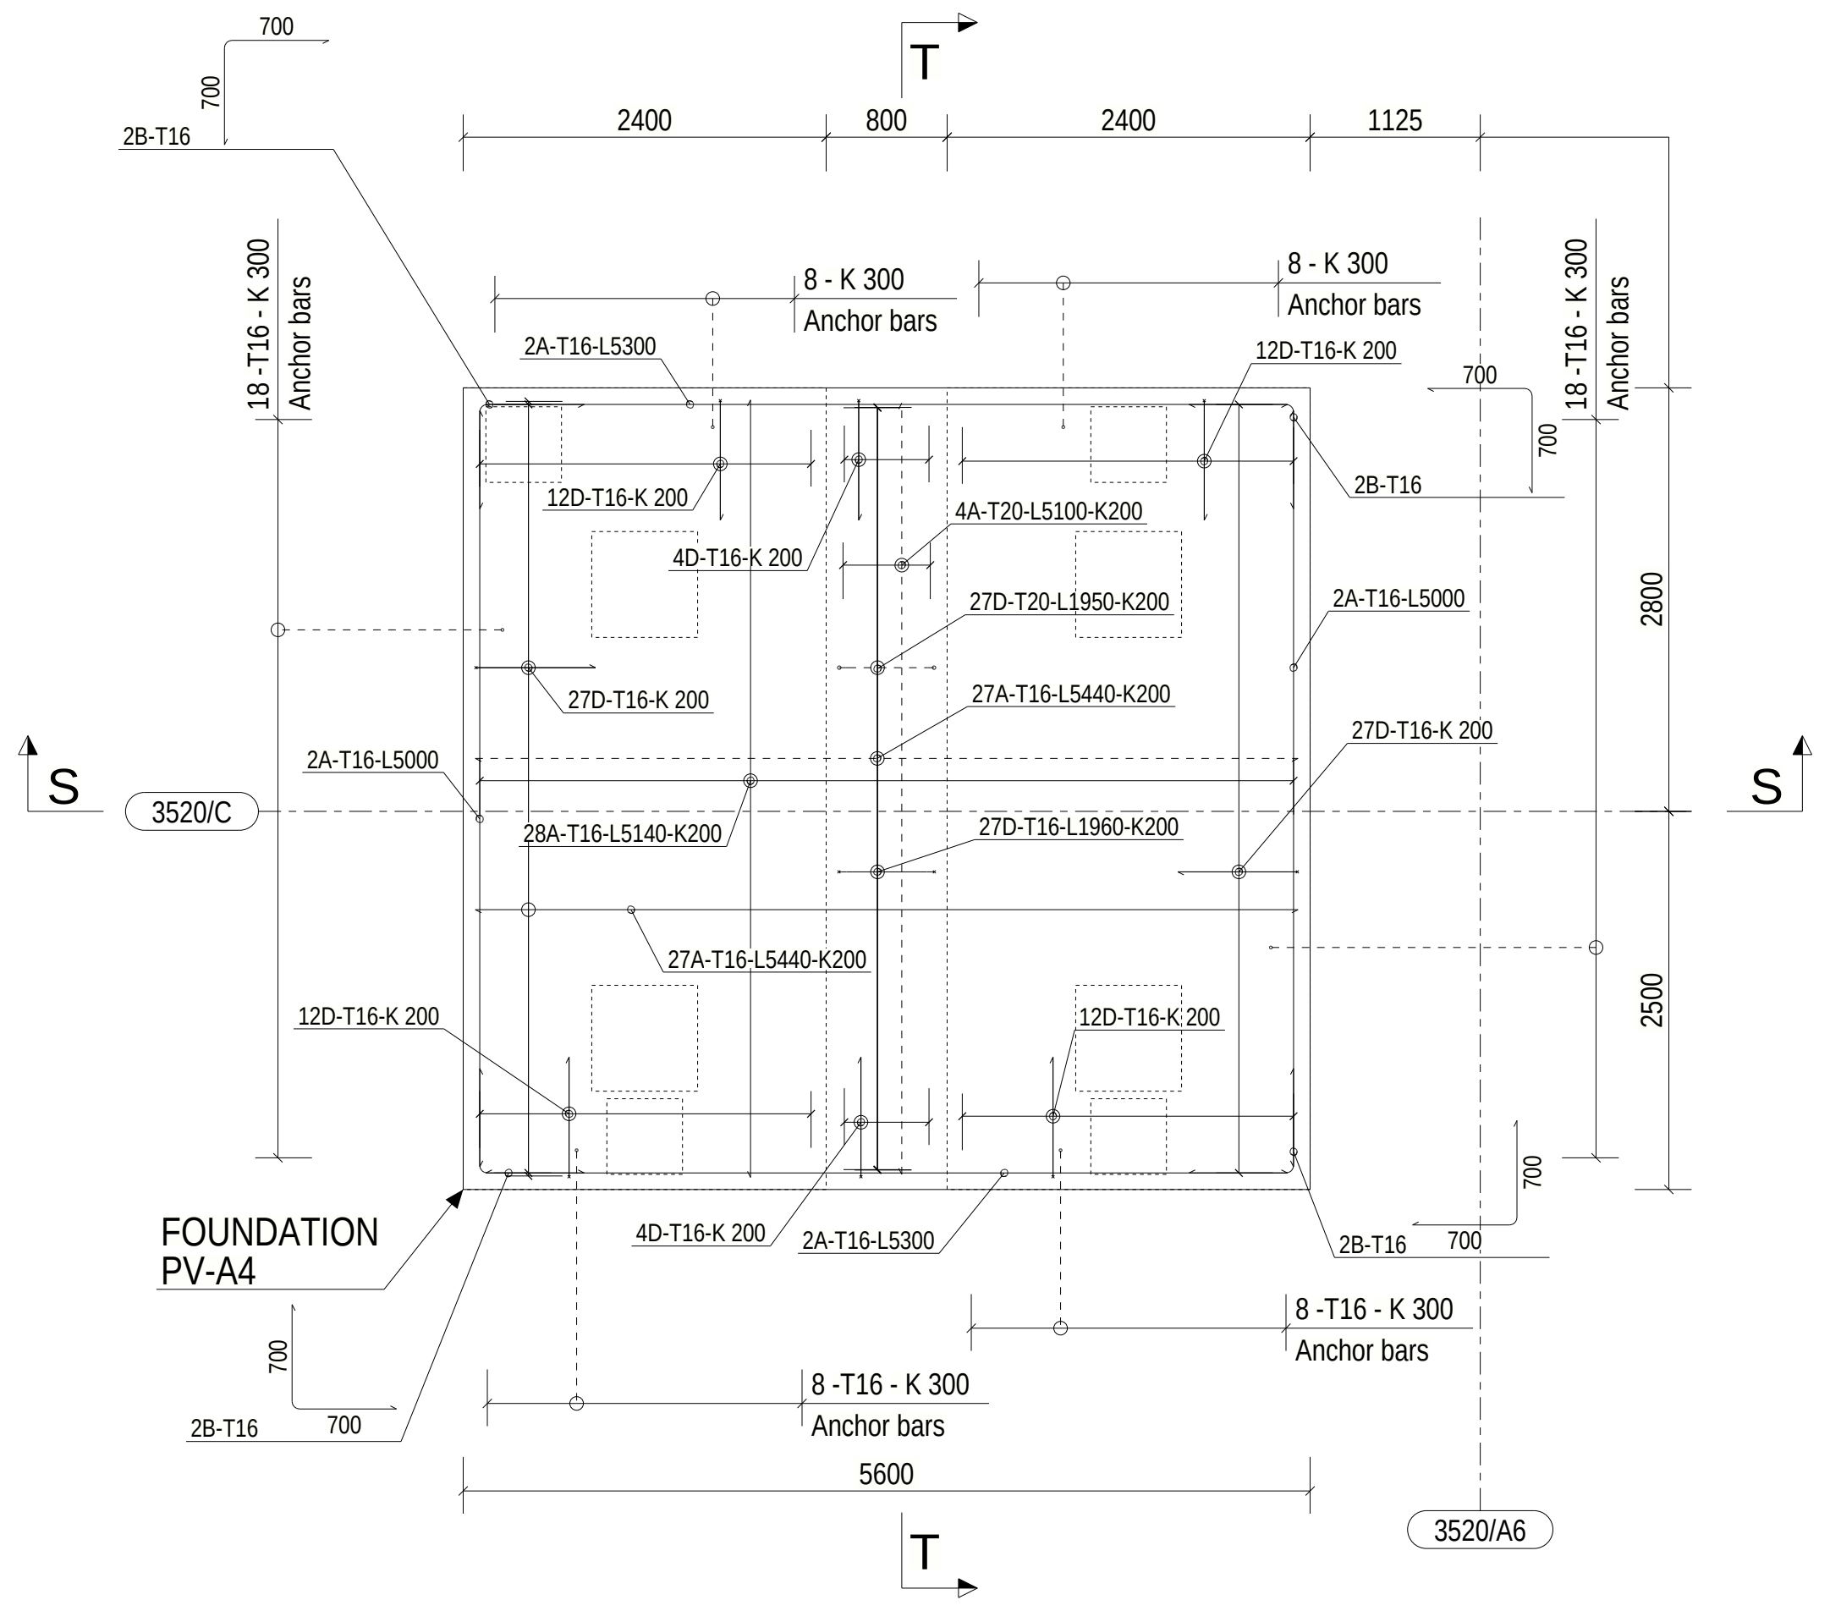
T
2400
800
2400
1125
8 - K 300
Anchor bars
8 - K 300
Anchor bars
18 -T16 - K 300
Anchor bars
S
S
3520/C
2800
2500
FOUNDATION
PV-A4
8 -T16 - K 300
Anchor bars
8 -T16 - K 300
Anchor bars
5600
3520/A6
T

S_S
1:50

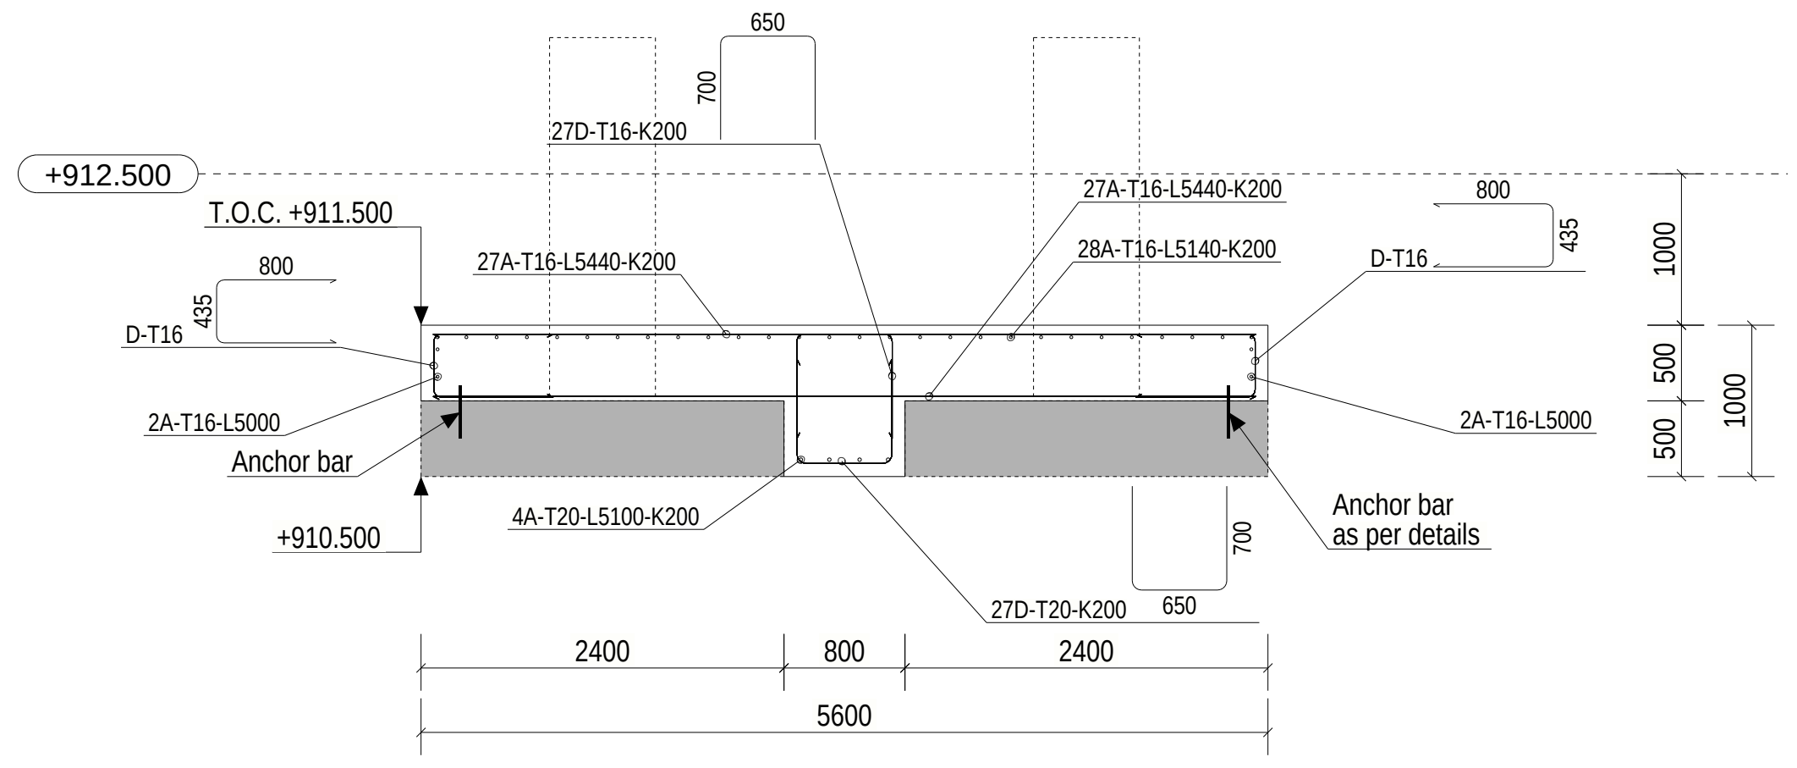
+912.500
T.O.C. +911.500
Anchor bar
Anchor bar
as per details
+910.500
2400
800
2400
5600

C_C
1:50

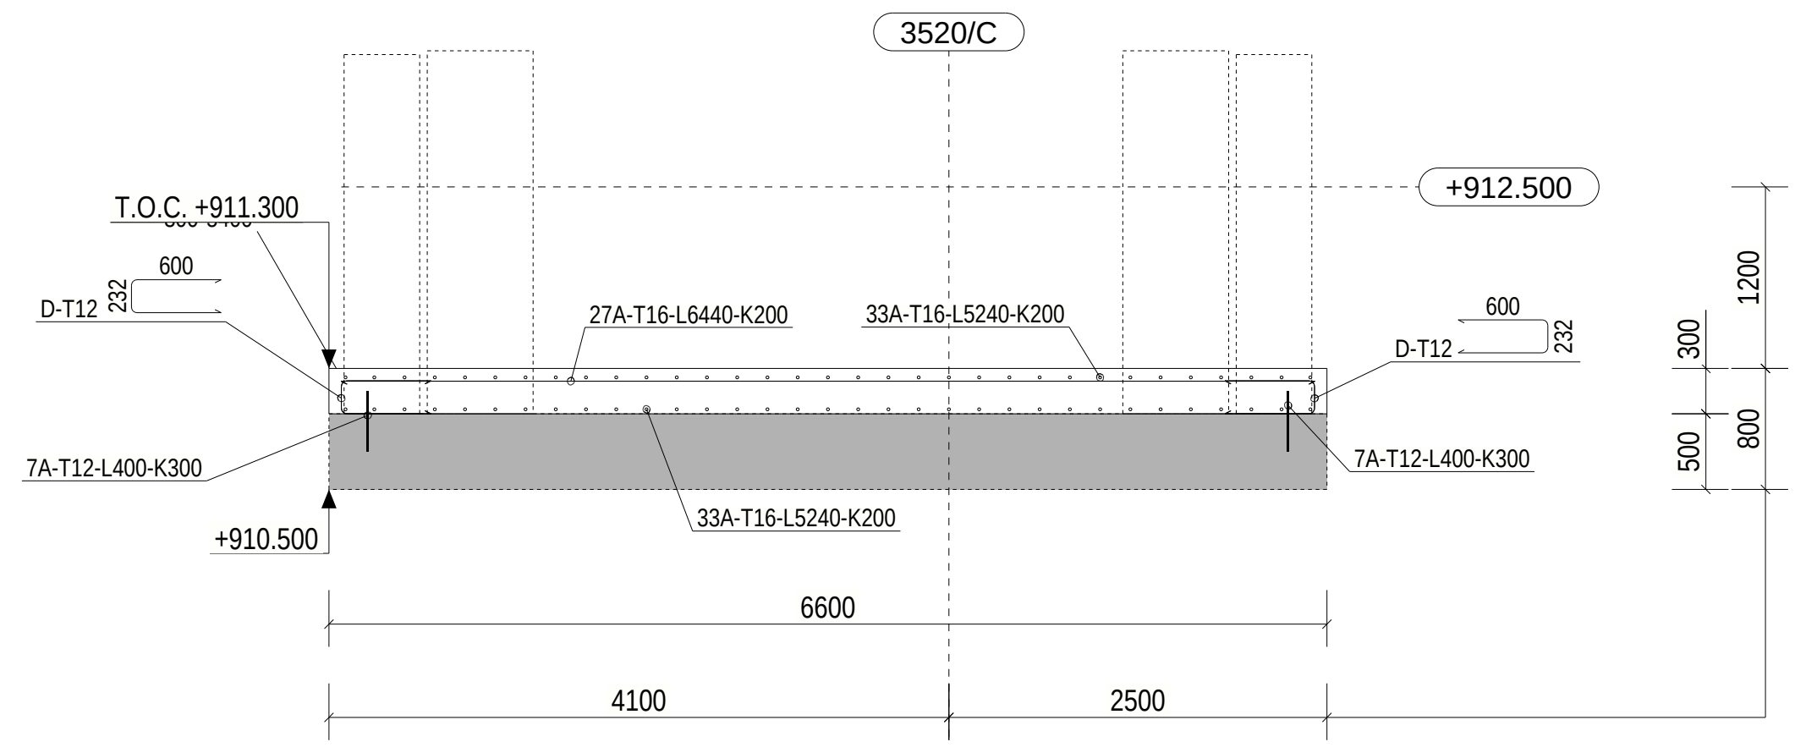
3520/C
T.O.C. +911.300
+912.500
+910.500
6600
4100
2500

F_F
1:50

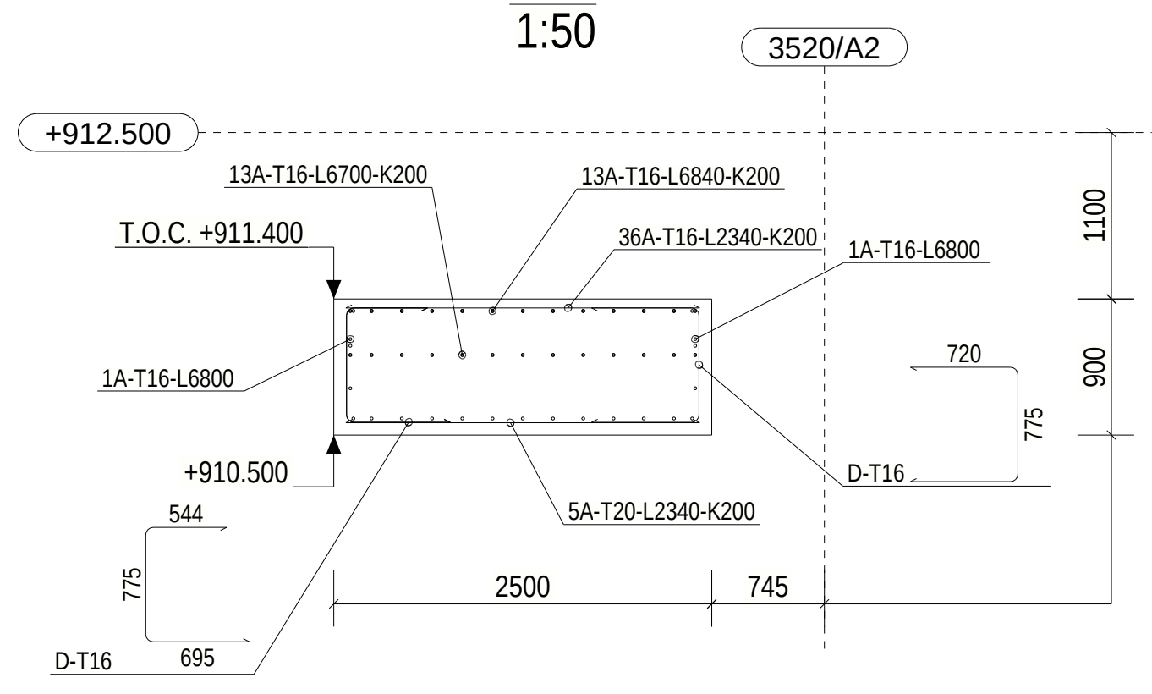
3520/A2
+912.500
T.O.C. +911.400
+910.500
2500
745

T_T
1:50

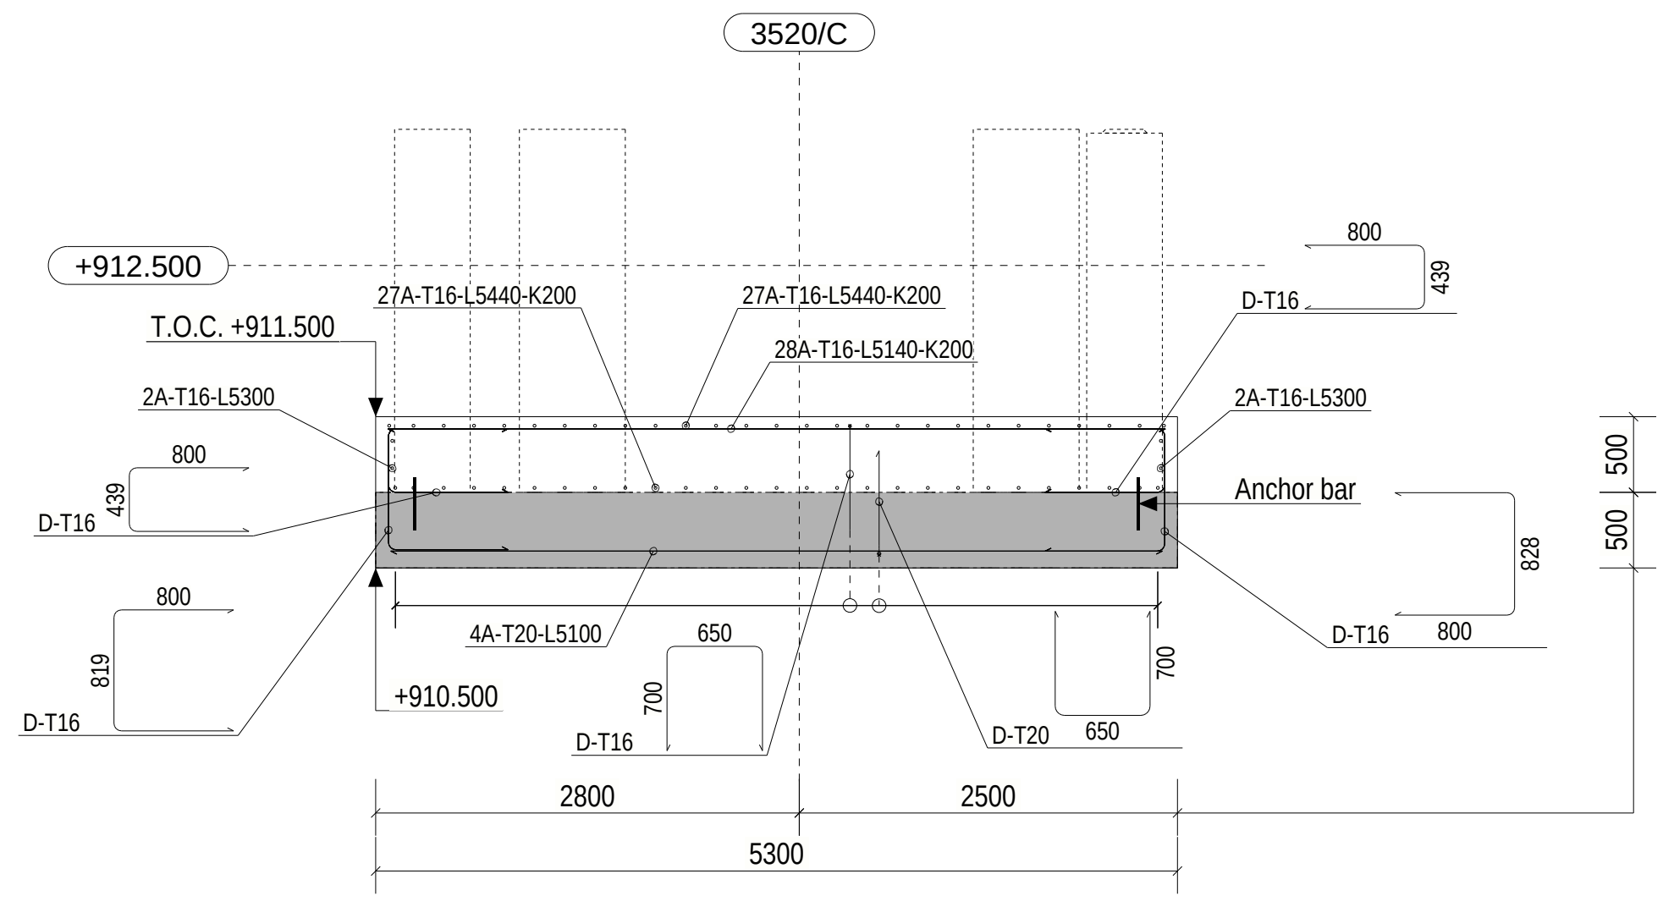
3520/C
+912.500
T.O.C. +911.500
Anchor bar
+910.500
2800
2500
5300

LEGEND:
R.L. - REDUCED LEVEL
T.O.C. - TOP OF CONCRETE
B.O.F. - BOTTOM OF FOUNDATION
F.G.L. - FINISHED GROUND LEVEL
P.C.C. - PLAIN CEMENT CONCRETE
TYP - TYPICAL
MKD - MARKED
CL - CENTER LINE
BOTTOM REINF. (B) - - - - - - - -
TOP REINF. (T) ———
SBC - SAFE BEARING CAPACITY
MIN. - MINIMUM
REF. - REFERED
GA - GENERAL ARRANGEMENT
DWG. - DRAWING
R.C.C. - REINFORCED CEMENT CONCRETE

#A, #B, #U- QUANTITY AND SHAPE OF REBARS
T20- DIAMETER OF REBAR 20mm
L2000- LENGHT OF REBAR 2000mm
K150- REBAR SPACING CENTER TO CENTER 150 mm

NOTES:

1. ALL DIMENSIONS ARE IN MILLIMETRES AND LEVELS ARE IN METRES UNLESS OTHERWISE STATED
2. GRADE OF CONCRETE SHALL BE C35 UNLESS NOTED OTHERWISE
3. GRADE OF REINFORCEMENT SHALL BE DEFORMED BAR ASTM A615-GRADE 60 (fy=420MPa)
4. CLEAR COVER TO MAIN REINFORCEMENT SHALL BE AS FOLLOWS:
a) FOUNDATION: 75 mm (BOTTOM & SIDE)
b) FOUNDATION: 50 mm (TOP)
c) COLUMN & PEDESTAL: 50 mm
5. MINIMUM LAP LENGTHS OF REINFORCEMENT SHALL BE 40XBAR DIAMETER

KEYPLAN

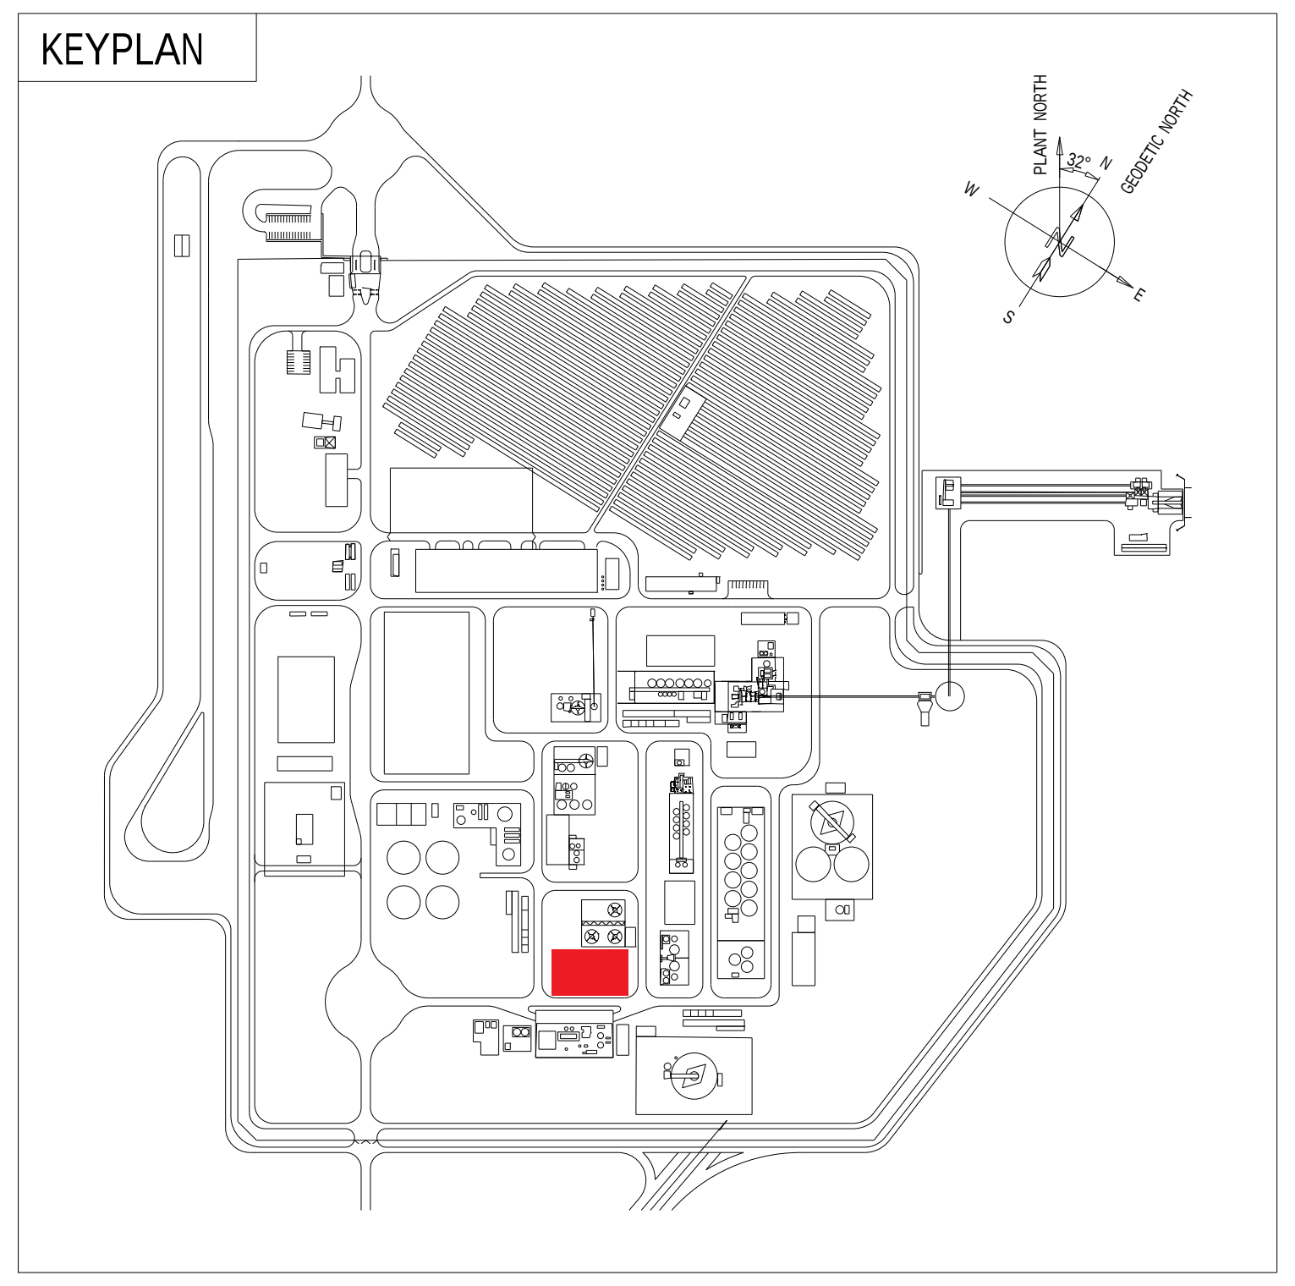
PLANT NORTH
32°
N
GEODETIC NORTH

DOCUMENT NUMBER	REFERENCE DOCUMENTS	DOCUMENT NUMBER	REFERENCE DOCUMENTS	REV	DATE	REVISION DESCRIPTION	DRN	CHK	ENG	APP	EMP	REV	DATE	REVISION DESCRIPTION	DRN	CHK	ENG	APP	EMP
MD-216-3520-EG-CV-RPT-1001	CALCULATION REPORT FOR REINFORCEMENT OF RACK FOUNDATION			D01	04/01/2023	AS-BUILT	AbdDus	PerKoi	MauNot	DorGol									
MD-216-3520-EG-ST-CAL-1001	CALCULATION REPORT FOR DESIGN OF STRUCTURE 3520 NEUTRALIZATION AND THICKENING	MD-216-1000-EG-ST-CRT-1001	DESIGN CRITERIA 1000 GOLD PROCESSING PLANT CIVIL,STRUCTURAL AND ARCHITECTURAL	C01	18.01.2021	ISSUED FOR CONSTRUCTION	AbdDus	PerKoi	MauNot	DorGol									
MD-216-3520-EG-CV-DED-1284	PIPE RACK FOUNDATION REINFORCEMENT DRAWING	MD-216-3520-EG-ST-CAL-2263	CALCULATION	A01	12.11.2020	ISSUED FOR APPROVAL	AbdDus	PerKoi	MauNot	LuiPiz									
MD-216-3520-EG-CV-CAL-1284	DESIGN CALCULATION 3520	MD-216-3520-EG-CV-GAD-1284	GENERAL ARRANGEMENT DRAWING	A02	18.12.2020	ISSUED FOR APPROVAL, REVISED AS PER CLIENT COMMENTS	AbdDus	PerKoi	MauNot	LuiPiz									

RESERVED FOR VENDOR LOGO AND DRAWING NUMBER

LARSEN & TOUBRO

This drawing is the property of LARSEN & TOUBRO and must not be passed on to any person or body not authorized by us to recieve it or be copied or otherwise made use either in full or in part by such person or body without our prior permission in writing.

Outotec

The content of these documents are the sole property of Outotec Oyj. Any rights not expressly granted herein are reserved. Reproduction, transfer or distribution of part or all of the contents in any form without prior written permission of Outotec is prohibited.

MA'ADEN معادن
Saudi Arabian Mining Company شركة التعدين العربية السعودية

This document and the information contained herein is Ma'aden proprietary know-how. This document or any part thereof should not be reproduced, stored in a retrieval system or transmitted by any means, electronic or otherwise, or divulged without prior written permission of Ma'aden.

LARSEN & TOUBRO DRAWING NUMBER
019045-450-C-G-24947-002
REVISION 3

OUTOTEC DRAWING NUMBER
900707_GAU01_RN13_MLD20_35201
DOCUMENT ID
OU100706979
REVISION 3

DRAWN	AbdDus	12.11.2020
CHECKED	PerKoi	12.11.2020
ENGINEER	MauNot	12.11.2020
APPROVED	LuiPiz	12.11.2020
EMPLOYER		
SCALE	1:50	A0

MANSOURAH - MASSARAH GOLD PROJECT
FOUNDATION DRAWING 3520
DIMENSION AND REINFORCEMENT DRAWING

DRAWING NUMBER
MD-216-3520-EG-CV-GAD-1006
REV
D01

Tekla Structures