


DRAWING NUMBER MD-216-3520-EG-CV-GAD-1282 | REV D01

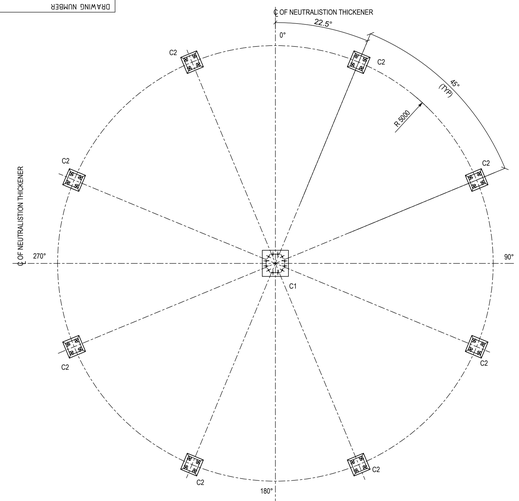


PLAN AT RL 913.350
(SCALE 1:50)

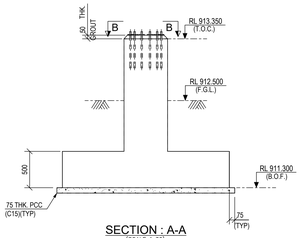


SECTION : A-A
(SCALE 1:30)

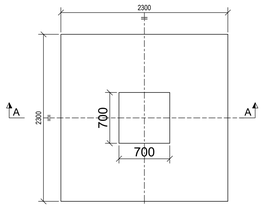


DETAIL OF FOUNDATION MKD. F1
(SCALE 1:30)

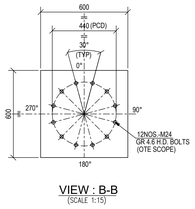


VIEW : B-B
(SCALE 1:15)

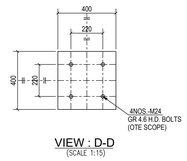

VIEW : D-D
(SCALE 1:15)

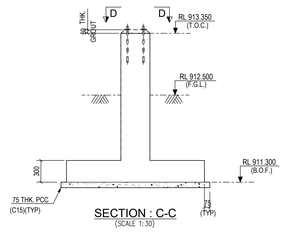


SECTION : C-C
(SCALE 1:30)

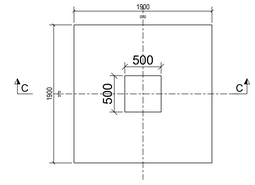


DETAIL OF FOUNDATION MKD. F2
(SCALE 1:30)



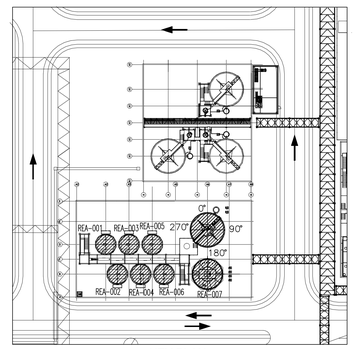

KEY PLAN
(SCALE 1:750)

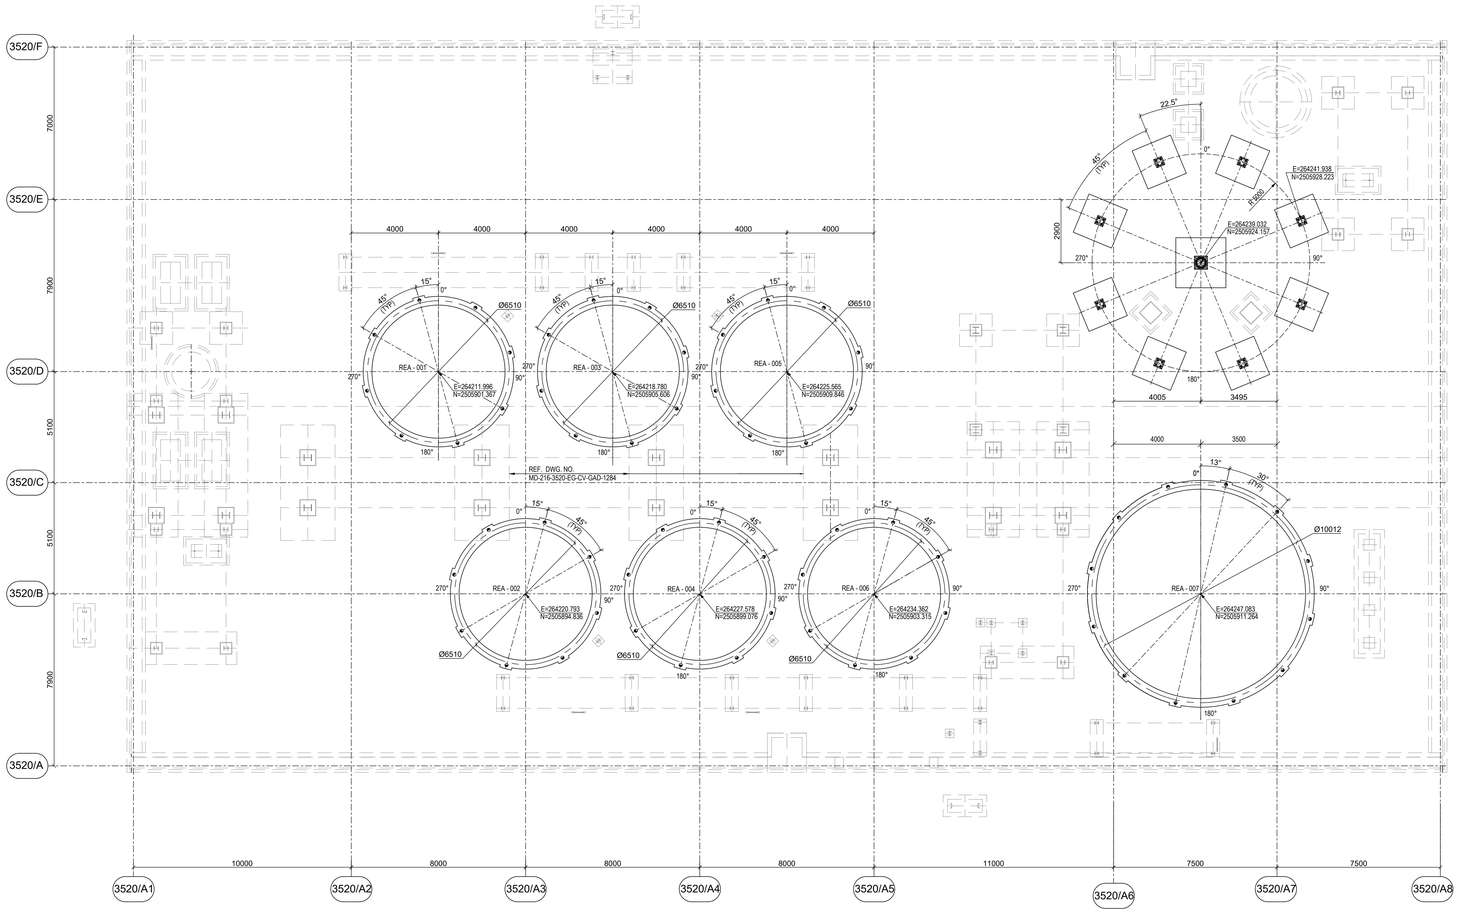

LAYOUT PLAN FOR PROCESS WATER NEUTRALISTION AND THICKENING AREA
(SCALE 1:100)

PLAN AT RL 911.300(B.O.FDN.)
(SCALE 1:50)

LEGEND:-

T.O.C - TOP OF CONCRETE
B.O.F - BOTTOM OF FOUNDATION
F.G.L - FINISHED GROUND LEVEL
P.C.C - PLAIN CEMENT CONCRETE
℄ - CENTER LINE
R - RADIUS

NOTES:-

1. ALL DIMENSIONS ARE IN MILLIMETRES AND LEVELS ARE IN METRES UNLESS OTHERWISE STATED.
2. GRADE OF CONCRETE SHALL BE C35
3. GRADE OF REINFORCEMENT SHALL BE DEFORMED BAR ASTM A615-GRADE 60 (fy=420 MPa)
4. NET SAFE BEARING CAPACITY CONSIDERED AT THE FOUNDING LEVEL IS 460 KN/SQ. M
5. IF ANY PART OF FOUNDATION COMES ON BACKFILL ZONE OF ADJACENT FOUNDATION OR ANY LOOSE PACKETS ARE ENCOUNTERED BELOW FOUNDATION LEVEL THE SAME SHALL BE REMOVED AND FILLED WITH PCC.
6. THIS DWG. SHALL READ IN CONJUNCTION WITH DRG. NO. MD - 216 - 3520 - EG - CV - GAD - 1283.
7. FOR DETAIL DRAWING REF. DRG. NO. MD - 216 - 3520 - EG - CV - DED - 1283.

DOCUMENT NUMBER	REFERENCE DOCUMENTS	REV	DATE	REVISION DESCRIPTION	DRN	CHK	ENG	APP	EMP
MD-216-3520-EG-CV-GAD-1001	CIVIL WORKS GUIDE DRAWING 3520 NEUTRALIZATION AND THICKENING PLAN AT EL. +915.00								
MD-216-3520-EG-ME-GAD-1009	LOAD PLAN NEUTRALIZATION AND THICKENING PLAN AT EL. +925.280								
MD-216-3520-EG-ME-GAD-1008	LOAD PLAN NEUTRALIZATION AND THICKENING PLAN AT EL. +912.500								
MD-216-3520-EG-ME-PLN-1007	FOUNDATION AND LOAD PLAN NEUTRALIZATION THICKENER UNDERFLOW	D01	18/02/2023	AS-BUILT	NAEW-SN	BDA	STY	AG	
MD-216-3520-EG-ME-PLN-1002	FOUNDATION AND LOAD PLAN NEUTRALIZATION REACTOR	C02	19/05/2020	ISSUED FOR CONSTRUCTION & REVISED AS MKD. C02	SBH	BDA	STY	AG	
MD-216-3520-EG-ME-PLN-1001	FOUNDATION AND LOAD PLAN NEUTRALIZATION REACTOR	C01	28/04/2020	ISSUED FOR CONSTRUCTION	SBH	BDA	STY	AG	
MD-216-3520-EG-ME-GAD-1002	3520 NEUTRALIZATION AND THICKENING	A02	04/03/2020	REVISED AS PER EMPLOYER COMMENTS ON 05/02/2020	SBH	BDA	STY	AG	
MD-216-3520-EG-ME-GAD-1001	3520 NEUTRALIZATION AND THICKENING	A01	10/01/2020	ISSUED FOR REFERENCE	SBH	BDA	STY	AG	

RESERVED FOR VENDOR LOGO AND DRAWING NUMBER

LARSEN & TOUBRO

This drawing is the property of LARSEN & TOUBRO and must not be passed on to any person or body not authorized by us to receive it nor be copied or otherwise made use either in full or in part by such person or body without our prior permission in writing.

Outotec

The content of these documents are the sole property of Outotec Oyj. Any rights not expressly granted herein are reserved. Reproduction, transfer or distribution of part or all of the contents in any form without prior written permission of Outotec is prohibited.

MA'ADEN معادن Saudi Arabian Mining Company شركة معادن العربية السعودية

This document and the information contained herein is Ma'aden proprietary know-how. This document or any part thereof should not be reproduced, stored in a retrieval system or transmitted by any means, electronic or otherwise, or divulged without prior written permission of Ma'aden.

LARSEN & TOUBRO DRAWING NUMBER	019045_450_C_G_24119_001
REVISION	4
OUTOTEC DRAWING NUMBER	900707__GAU01__RN13__MTL01__35206
DOCUMENT ID	OU100665285
REVISION	4
DRAWN	SBH 08/01/2020
CHECKED	BDA 09/01/2020
ENGINEER	STY 08/01/2020
APPROVED	AG 10/01/2020
EMPLOYER	
SCALE	1:100
	A0

MANSOURAH - MASSARAH GOLD PROJECT
GENERAL ARRANGEMENT
NEUTRALIZATION AND THICKENING
LAYOUT & THICKENER FOUNDATION

DRAWING NUMBER: MD - 216 - 3520 - EG - CV - GAD - 1282 | REV: D01