


DRAWING NUMBER MD-216-3520-EG-CV-GAD-1283 REV D01

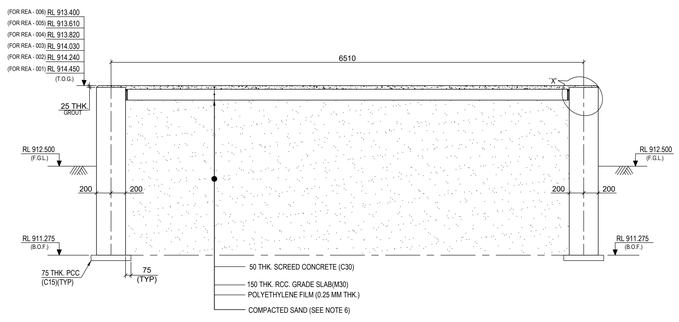


SECTION : A-A
(SCALE 1:30)

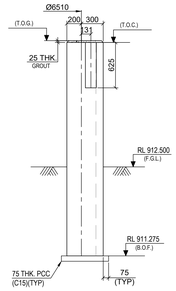


SECTION : B-B
(SCALE 1:30)

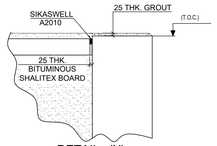


DETAIL - 'X'
(SCALE 1:20)

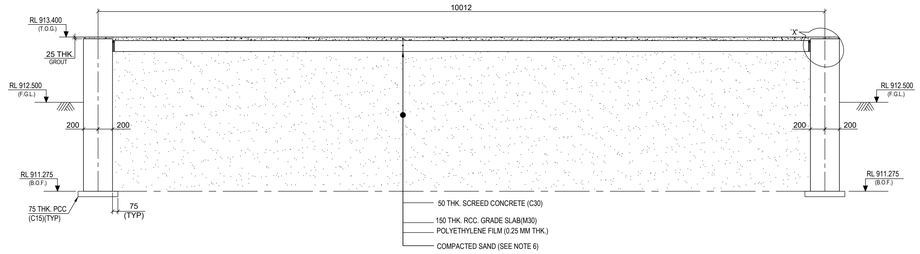


SECTION : C-C
(SCALE 1:30)

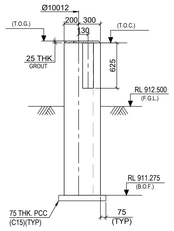


SECTION : D-D
(SCALE 1:30)

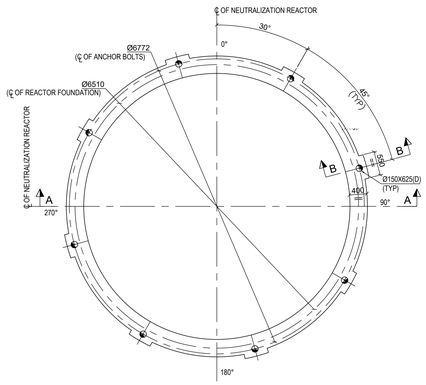


PLAN AT TOP OF FOUNDATION
(FOR NEUTRALIZATION REACTOR : REA - 001,003 & 005)
(SCALE 1:50)

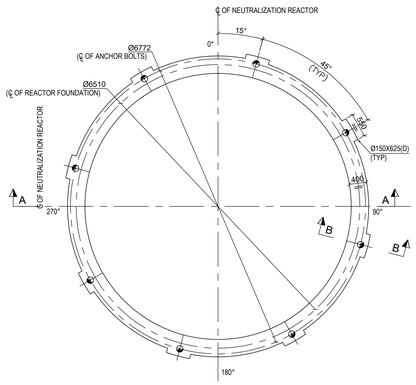


PLAN AT TOP OF FOUNDATION
(FOR NEUTRALIZATION REACTOR : REA - 002,004 & 006)
(SCALE 1:50)

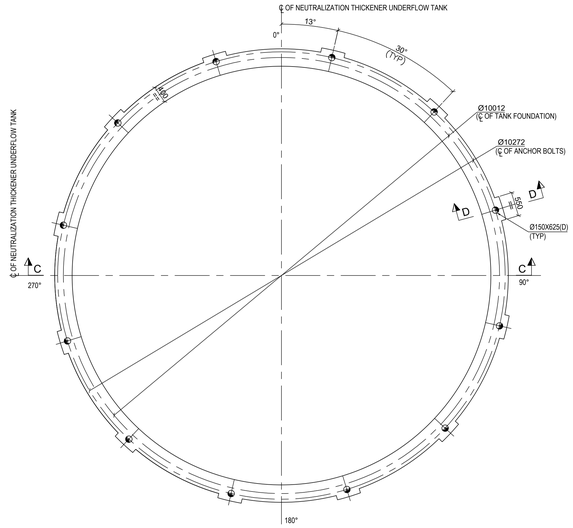


PLAN AT TOP OF FOUNDATION
(FOR NEUTRALIZATION THICKENER UNDERFLOW TANK : REA - 007)
(SCALE 1:50)

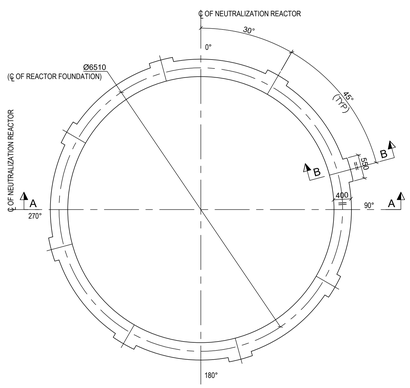

PLAN AT BOTTOM OF FOUNDATION
(FOR NEUTRALIZATION REACTOR : REA - 001,003 & 005)
(SCALE 1:50)

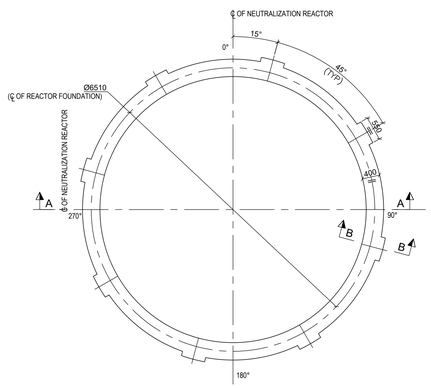

PLAN AT BOTTOM OF FOUNDATION
(FOR NEUTRALIZATION REACTOR : REA - 002,004 & 006)
(SCALE 1:50)

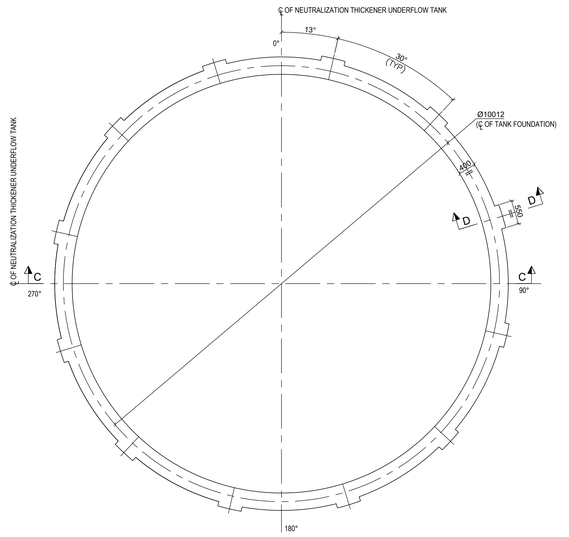

PLAN AT BOTTOM OF FOUNDATION
(FOR NEUTRALIZATION THICKENER UNDERFLOW TANK : REA - 007)
(SCALE 1:50)

LEGEND :-

T.O.C - TOP OF CONCRETE
B.O.F - BOTTOM OF FOUNDATION
F.G.L - FINISHED GROUND LEVEL
P.C.C - PLAIN CEMENT CONCRETE
℄ - CENTRE LINE
T.O.G - TOP OF GROUT
THK. - THICK
EQV. - EQUIVALENT
D - DEPTH
Ø - DIA
TYP - TYPICAL
R.C.C - REINFORCED CEMENT CONCRETE

NOTES:-

1. ALL DIMENSIONS ARE IN MILLIMETRES AND LEVELS ARE IN METRES UNLESS OTHERWISE STATED.
2. GRADE OF CONCRETE SHALL BE M35.
3. GRADE OF REINFORCEMENT SHALL BE DEFORMED BAR ASTM A615-GRADE 60 (fy=420 MPa)
4. NET SAFE BEARING CAPACITY CONSIDERED AT THE FOUNDING LEVEL IS 460 KN/SQ. M
5. IF ANY PART OF FOUNDATION COMES ON BACKFILL ZONE OF ADJACENT FOUNDATION OR ANY LOOSE POCKETS ARE ENCOUNTERED BELOW FOUNDATION LEVEL THE SAME SHALL BE REMOVED AND FILLED WITH PCC.
6. SAND SHALL BE COMPACTED TO A MAXIMUM DEPTH OF 300MM & SHALL BE COMPACTED TO 90% RELATIVE DENSITY AS DETERMINED BY ASTM D4253 & ASTM D4254
7. THIS DRG. SHELL READ IN CONJUNCTION WITH DRG. NO. MD - 216 - 3520 - EG - CV - GAD - 1282.
8. FOR DETAIL DRAWING REF. DRG. NO. MD - 216 - 3520 - EG - CV - DED - 1283.

DOCUMENT NUMBER	REFERENCE DOCUMENTS	REV	DATE	REVISION DESCRIPTION	DRN	CHK	ENG	APP	EMP
MD-216-3520-EG-CV-GAD-1001	CIVIL WORKS GUIDE DRAWING 3520 NEUTRALIZATION AND THICKENING PLAN AT EL. +912.500								
MD-216-3520-EG-ME-GAD-1009	LOAD PLAN NEUTRALIZATION AND THICKENING PLAN AT EL. +925.280								
MD-216-3520-EG-ME-GAD-1008	LOAD PLAN NEUTRALIZATION AND THICKENING PLAN AT EL. +912.500	D01	22/02/2023	AS-BUILT	SBH	BDA	STY	AG	
MD-216-3520-EG-ME-PLN-1007	FOUNDATION AND LOAD PLAN NEUTRALIZATION THICKENER UNDERFLOW	C03	08/09/2020	ISSUED FOR CONSTRUCTION & REVISED AS MKD.	SBH	BDA	STY	AG	
MD-216-3520-EG-ME-PLN-1002	FOUNDATION AND LOAD PLAN NEUTRALIZATION REACTOR	C02	16/05/2020	ISSUED FOR CONSTRUCTION & REVISED AS MKD.	SBH	BDA	STY	AG	
MD-216-3520-EG-ME-PLN-1001	FOUNDATION AND LOAD PLAN NEUTRALIZATION REACTOR	C01	28/04/2020	ISSUED FOR CONSTRUCTION	SBH	BDA	STY	AG	
MD-216-3520-EG-ME-GAD-1002	3520 NEUTRALIZATION AND THICKENING	A02	04/03/2020	REVISED AS PER EMPLOYER COMMENTS ON 05/02/2020	SBH	BDA	STY	AG	
MD-216-3520-EG-ME-GAD-1001	3520 NEUTRALIZATION AND THICKENING	A01	10/01/2020	ISSUED FOR REFERENCE	SBH	BDA	STY	AG	

RESERVED FOR VENDOR LOGO AND DRAWING NUMBER

LARSEN & TOUBRO

This drawing is the property of LARSEN & TOUBRO and must not be passed on to any person or body not authorized by us to receive it nor be copied or otherwise made use either in full or in part by such person or body without our prior permission in writing.

Outotec

The content of these documents are the sole property of Outotec Oyj. Any rights not expressly granted herein are reserved. Reproduction, transfer or distribution of part or all of the contents in any form without prior written permission of Outotec is prohibited.

MA'ADEN معادن Saudi Arabian Mining Company شركة المعادن العربية السعودية

This document and the information contained herein is Ma'aden. proprietary know-how. This document or any part thereof should not be reproduced, stored in a retrieval system or transmitted by any means, electronic or otherwise, or divulged without prior written permission of Ma'aden.

LARSEN & TOUBRO DRAWING NUMBER: 019045_450_C_G_24119_002 — REVISION: 5
OUTOTEC DRAWING NUMBER: 900707__GAU01__RN13__MTL01__35207 — DOCUMENT ID: OU100668956 — REVISION: 5

DRAWN	SBH	08/01/2020
CHECKED	BDA	09/01/2020
ENGINEER	STY	08/01/2020
APPROVED	AG	10/01/2020
EMPLOYER		
SCALE	1:100	A0

MANSOURAH - MASSARAH GOLD PROJECT
GENERAL ARRANGEMENT
NEUTRALIZATION AND THICKENING
TANK FOUNDATION

DRAWING NUMBER: MD - 216 - 3520 - EG - CV - GAD - 1283 — REV: D01