
DRAWING NUMBER: MD - 216 - 3520 - EG - CV - GAD - 1284
REV: D01

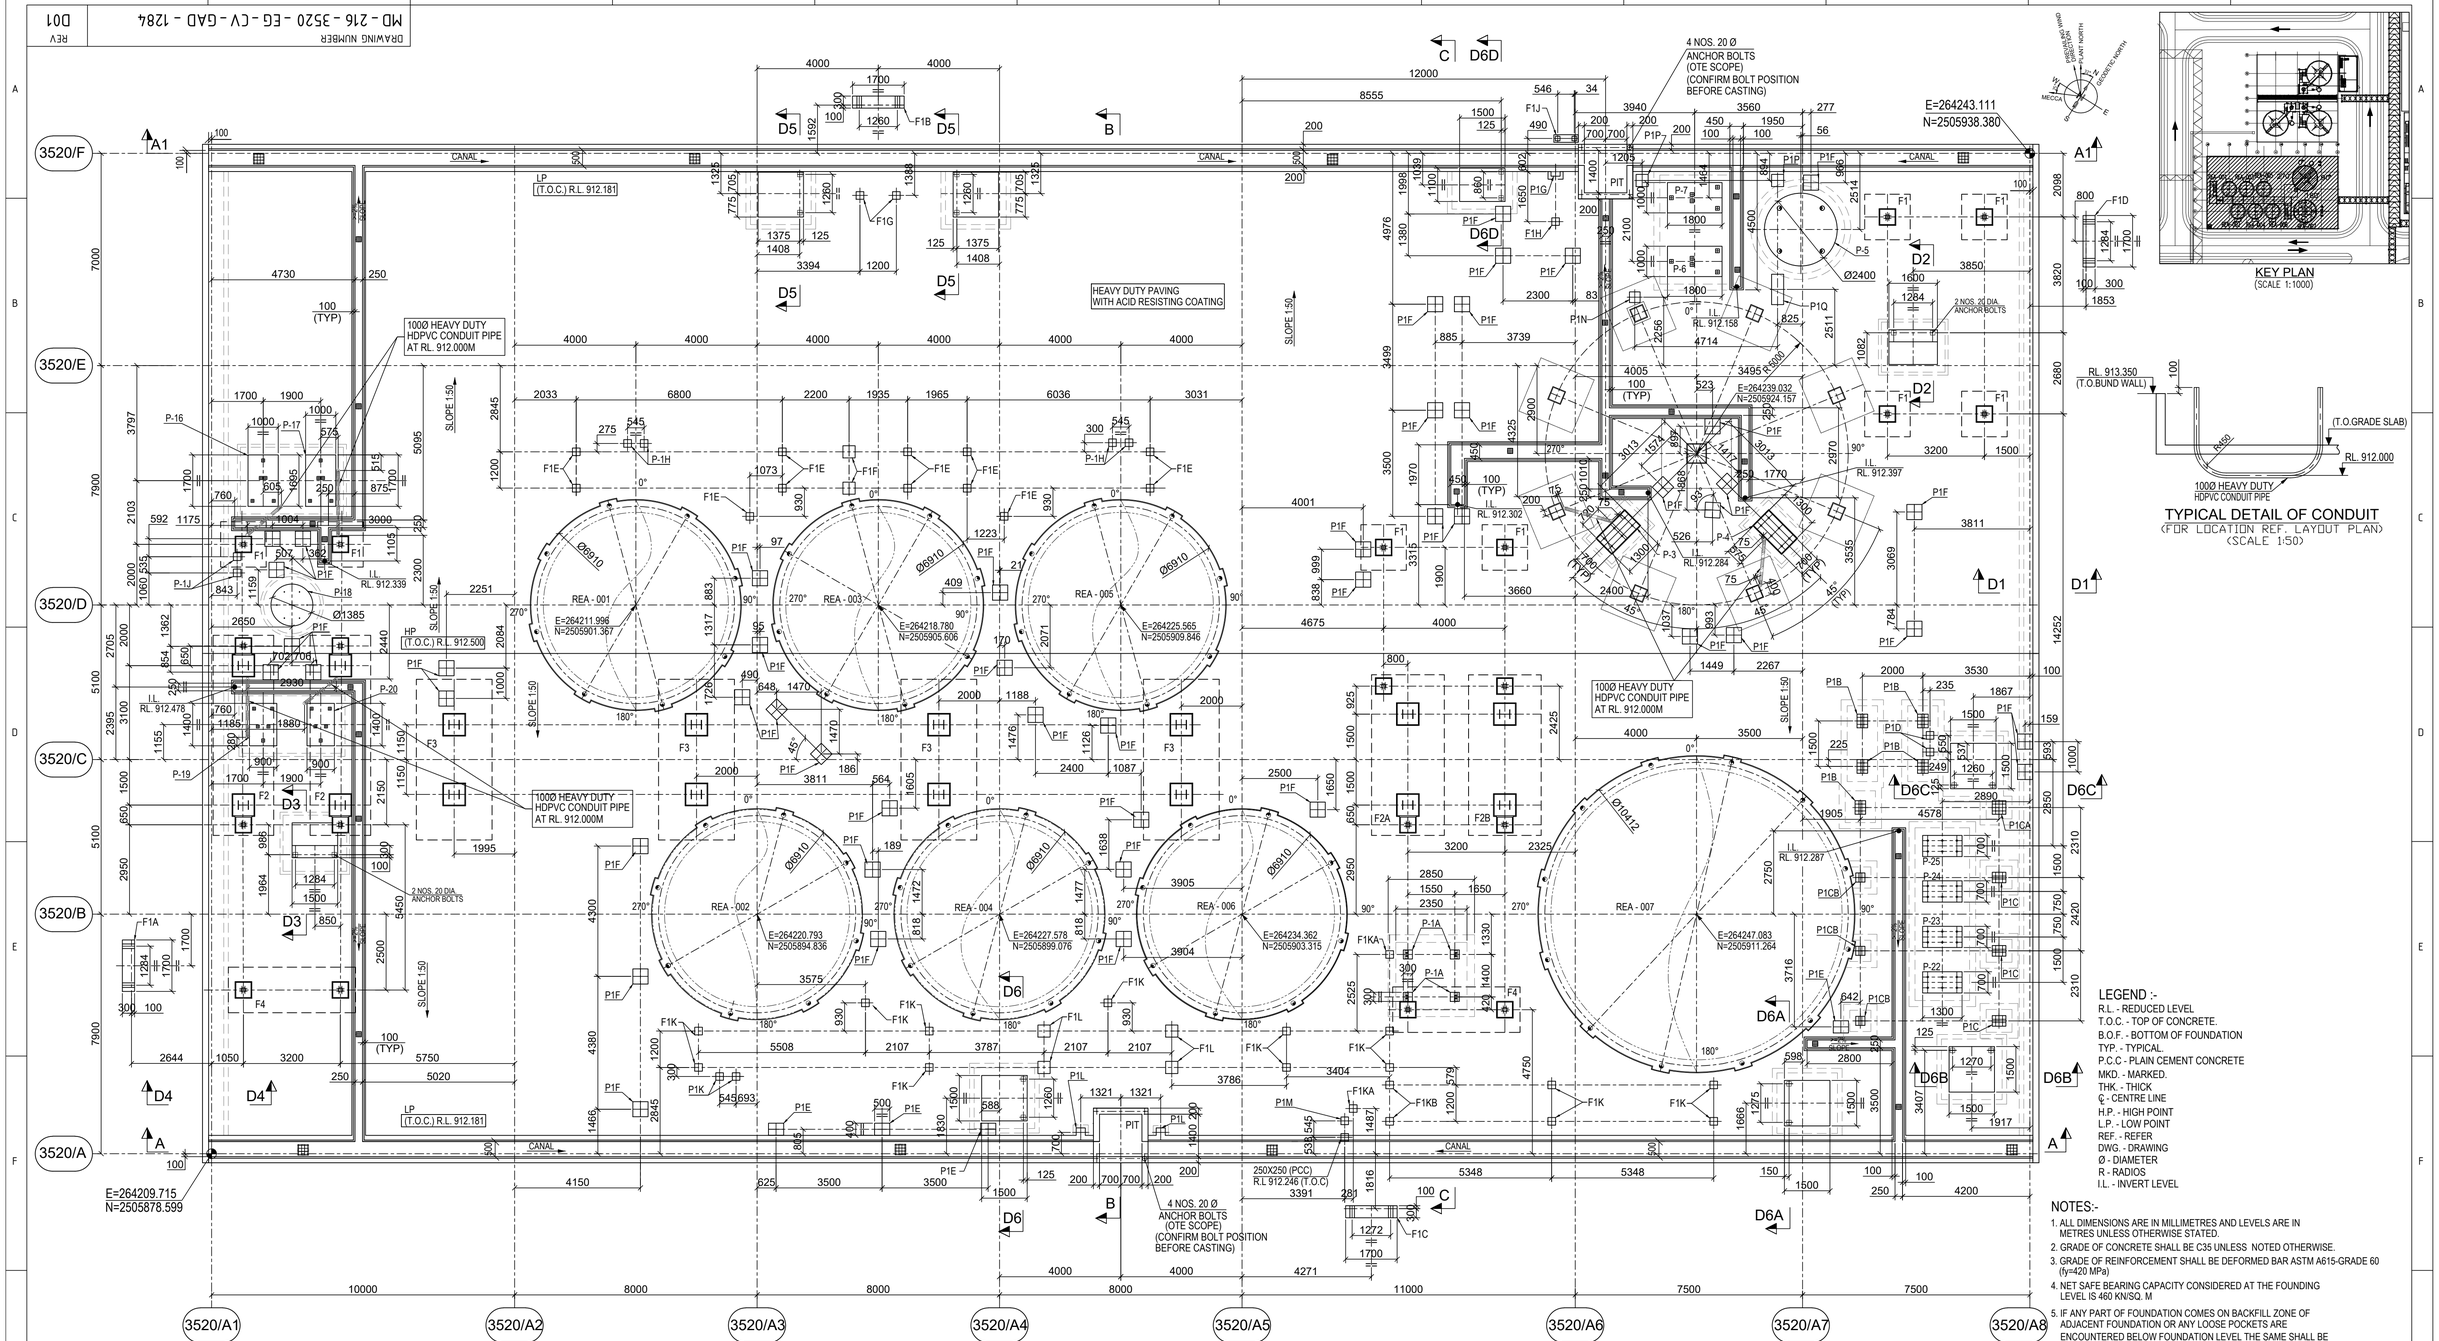

TYPICAL DETAIL OF CONDUIT
(FOR LOCATION REF. LAYOUT PLAN)
(SCALE 1:50)

LAYOUT PLAN FOR PROCESS WATER NEUTRALIZATION AND THICKENING AREA
(SCALE 1:100)

LEGEND :-
R.L. - REDUCED LEVEL
T.O.C. - TOP OF CONCRETE.
B.O.F. - BOTTOM OF FOUNDATION
TYP. - TYPICAL
P.C.C - PLAIN CEMENT CONCRETE
MKD. - MARKED.
THK. - THICK
℄ - CENTRE LINE
H.P. - HIGH POINT
L.P. - LOW POINT
REF. - REFER
DWG. - DRAWING
Ø - DIAMETER
R - RADIOS
I.L. - INVERT LEVEL

NOTES:-
1. ALL DIMENSIONS ARE IN MILLIMETRES AND LEVELS ARE IN METRES UNLESS OTHERWISE STATED.
2. GRADE OF CONCRETE SHALL BE C35 UNLESS NOTED OTHERWISE.
3. GRADE OF REINFORCEMENT SHALL BE DEFORMED BAR ASTM A615-GRADE 60 (fy=420 MPa)
4. NET SAFE BEARING CAPACITY CONSIDERED AT THE FOUNDING LEVEL IS 460 KN/SQ. M
5. IF ANY PART OF FOUNDATION COMES ON BACKFILL ZONE OF ADJACENT FOUNDATION OR ANY LOOSE POCKETS ARE ENCOUNTERED BELOW FOUNDATION LEVEL THE SAME SHALL BE REMOVED AND FILLED WITH PCC.
6. FOR DETAIL DRAWING REF. DRG. NO. MD - 216 - 3510 - EG - CV - DED - 1284 & 1285.
7. FOR STANDARD DETAILS OF PAVING REF. DRG. NO : MD-216-1000-EG-CV-DED-1002.
8. FOR FOUNDATION BOLT DETAILS REF. DRG. NO : MD-216-1000-EG-CV-DED-1003.
9. THIS DRAWING SHOULD READ IN CONJUNCTION WITH DRG. NO. MD - 216 - 3510 - EG - CV - GAD - 1285 & 1286.
10. FOR ELECTRICAL CABLE ROUTE LAYOUT EMBEDDED PART REF. DRG. NO : MD-216-3500-EG-EL-LAD-1005.

DOCUMENT NUMBER	REFERENCE DOCUMENTS	REV	DATE	REVISION DESCRIPTION	DRN	CHK	ENG	APP	EMP
		D01	22/02/2023	AS-BUILT	SBH	BDA	STY	AG	
		C07	08/03/2021	ISSUED FOR CONSTRUCTION & REVISED AS MKD.	SBH	BDA	STY	AG	
		C06	23/02/2021	ISSUED FOR CONSTRUCTION & REVISED AS MKD.	SBH	BDA	STY	AG	
MD-216-3520-EG-ME-GAD-1017	NEUTRALIZATION THICKENER OVERFLOW TANK	C05	21/12/2020	ISSUED FOR CONSTRUCTION & REVISED AS MKD.	SBH	BDA	STY	AG	
MD-216-3520-EG-ME-GAD-1048	NEUTRALIZATION THICKENER OVERFLOW TANK	C04	19/10/2020	ISSUED FOR CONSTRUCTION & REVISED AS MKD.	SBH	BDA	STY	AG	
MD-216-3520-EG-ME-GAD-1047	LAUNDER STRUCTURE LOADING DIAGRAM	C03	16/06/2020	ISSUED FOR CONSTRUCTION & REVISED AS MKD.	SBH	BDA	STY	AG	
MD-216-3520-EG-CV-GAD-1001	PLAN AT EL. +912.500	C02	19/05/2020	ISSUED FOR CONSTRUCTION & REVISED AS MKD.	SBH	BDA	STY	AG	
MD-216-3520-EG-ME-GAD-1009	PLAN AT EL. +925.280	C01	06/05/2020	ISSUED FOR CONSTRUCTION	SBH	BDA	STY	AG	
MD-216-3520-EG-ME-GAD-1008	PLAN AT EL. +912.500	A01	21/03/2020	ISSUED FOR REFERENCE	SBH	BDA	STY	AG	

RESERVED FOR VENDOR LOGO AND DRAWING NUMBER

LARSEN & TOUBRO DRAWING NUMBER: 019045_450_C_G_24119_003 — REVISION: 8
OUTOTEC DRAWING NUMBER: 900707__GAU01__RN13__MTL01__35208 — DOCUMENT ID: OU100668957 — REVISION: 8

LARSEN & TOUBRO
This drawing is the property of LARSEN & TOUBRO and must not be passed on to any person or body not authorized by us to receive it nor be copied or otherwise made use either in full or in part by such person or body without our prior permission in writing.

Outotec
The content of these documents are the sole property of Outotec Oyj. Any rights not expressly granted herein are reserved. Reproduction, transfer or distribution of part or all of the contents in any form without prior written permission of Outotec is prohibited.

MA'ADEN معادن
Saudi Arabian Mining Company شركة التعدين العربية السعودية
This document and the information contained herein is Ma'aden proprietary know-how. This document or any part thereof should not be reproduced, stored in a retrieval system or transmitted by any means, electronic or otherwise, or divulged without prior written permission of Ma'aden.

DRAWN	SBH	19/03/2020
CHECKED	BDA	20/03/2020
ENGINEER	STY	19/03/2020
APPROVED	AG	21/03/2020
EMPLOYER		
SCALE	1:30	A1

MANSOURAH - MASSARAH GOLD PROJECT
GENERAL ARRANGEMENT
NEUTRALIZATION AND THICKENING
GRADE SLAB & PIPE RACK FOUNDATION

DRAWING NUMBER: MD - 216 - 3520 - EG - CV - GAD - 1284 — REV: D01