


DRAWING NUMBER MD-216-3520-EG-CV-GAD-1285 REV D01

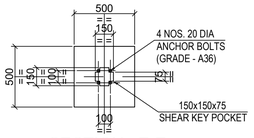


SECTION : E-E
(SCALE 1:25)

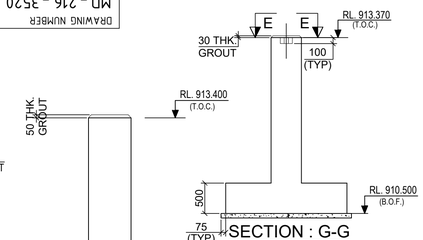


SECTION : G-G
(SCALE 1:50)

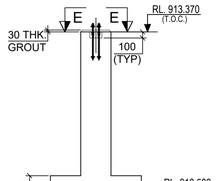


SECTION : D-D
(SCALE 1:50)

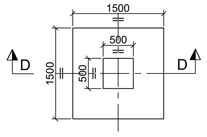


DETAIL OF FOUNDATION MKD. F1
(SCALE 1:50)

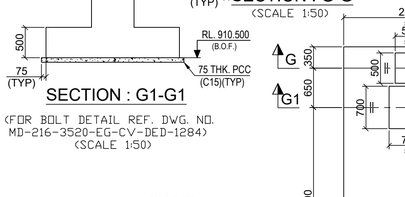


SECTION : G1-G1
(FOR BOLT DETAIL REF. DWG. NO. MD-216-3520-EG-CV-DED-1284)
(SCALE 1:50)

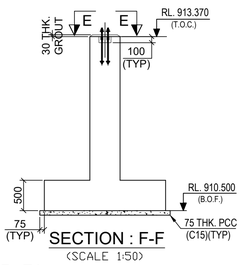


SECTION : F-F
(SCALE 1:50)

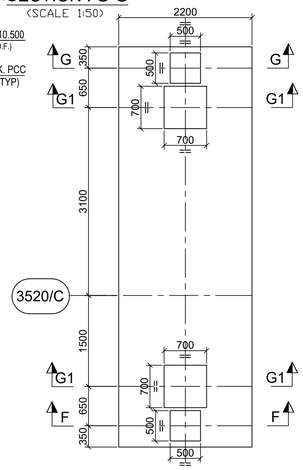


DETAIL OF FOUNDATION MKD. F2
(SCALE 1:50)

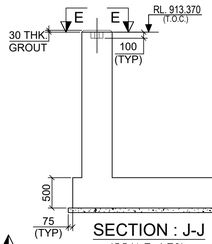


SECTION : J-J
(SCALE 1:50)

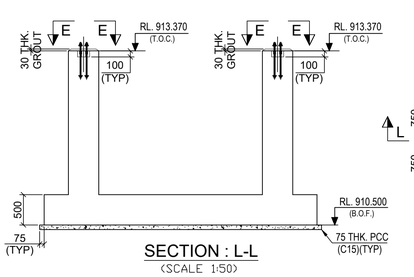


SECTION : L-L
(SCALE 1:50)

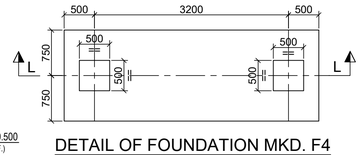


DETAIL OF FOUNDATION MKD. F4
(SCALE 1:50)

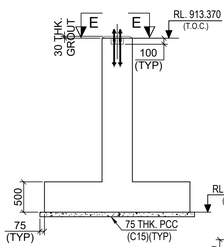


SECTION : H1-H1
(SCALE 1:50)

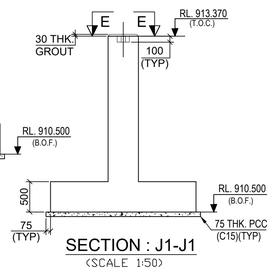


SECTION : J1-J1
(SCALE 1:50)

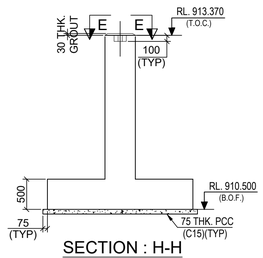


SECTION : H-H
(SCALE 1:50)

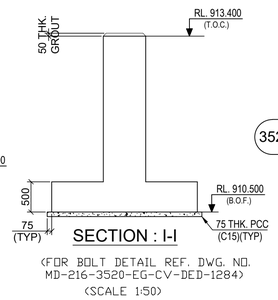


SECTION : I-I
(FOR BOLT DETAIL REF. DWG. NO. MD-216-3520-EG-CV-DED-1284)
(SCALE 1:50)

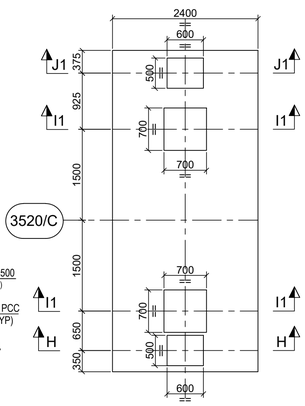


DETAIL OF FOUNDATION MKD. F2B
(SCALE 1:50)

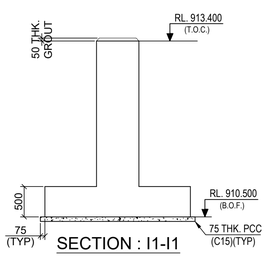


SECTION : I1-I1
(FOR BOLT DETAIL REF. DWG. NO. MD-216-3520-EG-CV-DED-1284)
(SCALE 1:50)

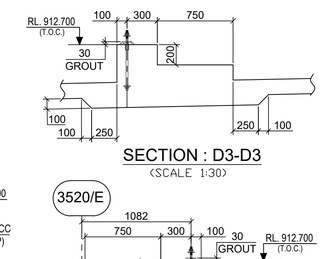


SECTION : D3-D3
(SCALE 1:30)

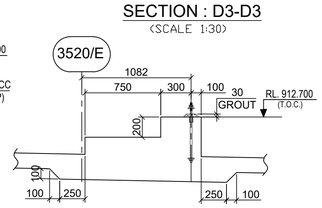


SECTION : D2-D2
(SCALE 1:30)

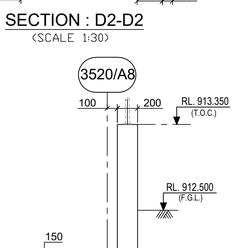


SECTION : D1-D1
(SCALE 1:30)

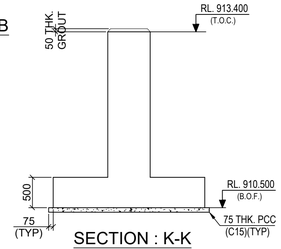


SECTION : K-K
(FOR BOLT DETAIL REF. DWG. NO. MD-216-3520-EG-CV-DED-1284)
(SCALE 1:50)

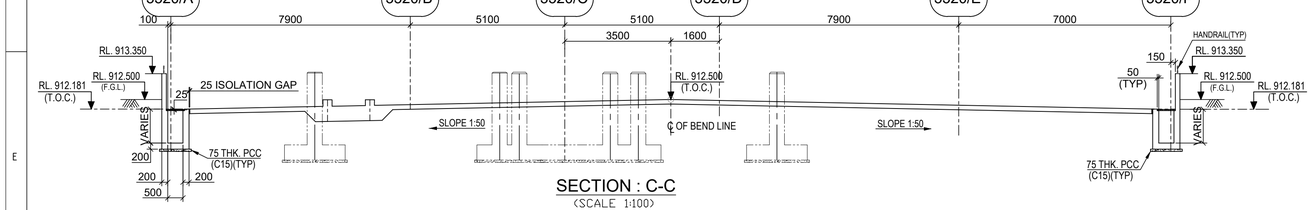


SECTION : C-C
(SCALE 1:100)

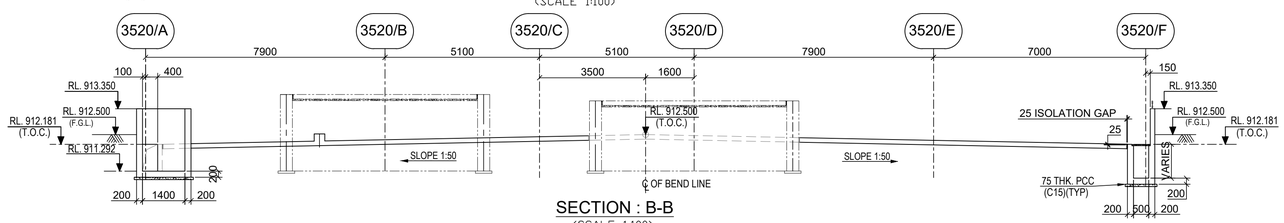


SECTION : B-B
(SCALE 1:100)

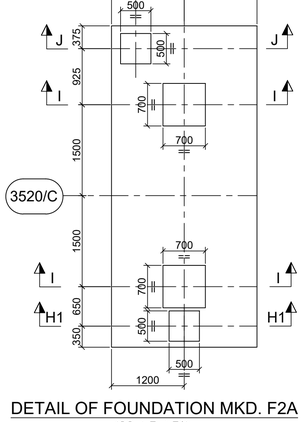

DETAIL OF FOUNDATION MKD. F2A
(SCALE 1:50)

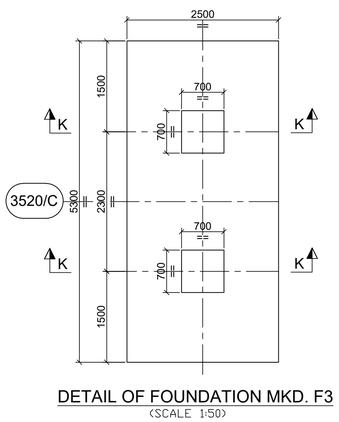

DETAIL OF FOUNDATION MKD. F3
(SCALE 1:50)

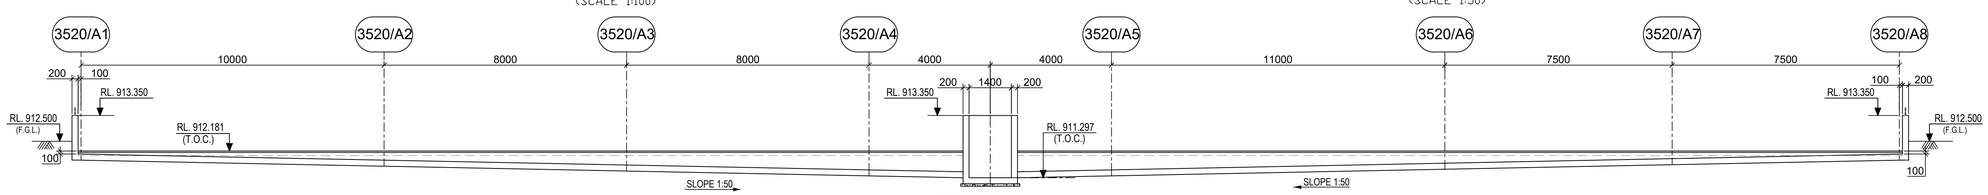

SECTION : A-A
(SCALE 1:100)

LEGEND :-

R.L. - REDUCED LEVEL
T.O.C. - TOP OF CONCRETE.
B.O.F. - BOTTOM OF FOUNDATION
F.G.L - FINISHED GROUND LEVEL
TYP. - TYPICAL.
P.C.C - PLAIN CEMENT CONCRETE
MKD. - MARKED.
THK. - THICK
℄ - CENTRE LINE
H.P. - HIGH POINT
L.P. - LOW POINT
REF. - REFER
DRG. - DRAWING
DIA - DIAMETER

NOTES:-

1. ALL DIMENSIONS ARE IN MILLIMETRES AND LEVELS ARE IN METRES UNLESS OTHERWISE STATED.
2. GRADE OF CONCRETE SHALL BE C35 UNLESS NOTED OTHERWISE.
3. GRADE OF REINFORCEMENT SHALL BE DEFORMED BAR ASTM A615-GRADE 60 (fy=420 MPa)
4. NET SAFE BEARING CAPACITY CONSIDERED AT THE FOUNDING LEVEL IS 460 KN/SQ. M
5. IF ANY PART OF FOUNDATION COMES ON BACKFILL ZONE OF ADJACENT FOUNDATION OR ANY LOOSE POCKETS ARE ENCOUNTERED BELOW FOUNDATION LEVEL THE SAME SHALL BE REMOVED AND FILLED WITH PCC.
6. FOR DETAIL DRAWING REF. DRG. NO. MD - 216 - 3510 - EG - CV - DED - 1284 & 1285.
7. FOR STANDARD DETAILS OF PAVING REF. DRG. NO : MD-216-1000-EG-CV-DED-1002.
8. FOR FOUNDATION BOLT DETAILS REF. DRG. NO : MD-216-1000-EG-CV-DED-1003.
9. THIS DRAWING SHOULD READ IN CONJUNCTION WITH DRG. NO. MD - 216 - 3510 - EG - CV - GAD - 1284 & 1286.

DOCUMENT NUMBER	REFERENCE DOCUMENTS	REV	DATE	REVISION DESCRIPTION	DRN	CHK	ENG	APP	EMP
		D01	18/02/2023	AS-BUILT	NAEW-SN	BDA	STY	AG	
MD-216-3520-EG-ME-GAD-1047	LAUNDER STRUCTURE LOADING DIAGRAM	C03	21/12/2020	ISSUED FOR CONSTRUCTION & REVISED AS MKD.	SBH	BDA	STY	AG	
MD-216-3520-EG-CV-GAD-1001	PLAN AT EL. +912.500	C02	16/06/2020	ISSUED FOR CONSTRUCTION & REVISED AS MKD.	SBH	BDA	STY	AG	
MD-216-3520-EG-ME-GAD-1009	PLAN AT EL. +925.280	C01	18/05/2020	ISSUED FOR CONSTRUCTION & REVISED AS MKD.	SBH	BDA	STY	AG	
MD-216-3520-EG-ME-GAD-1008	PLAN AT EL. +912.500	A01	21/03/2020	ISSUED FOR REFERENCE	SBH	BDA	STY	AG	

RESERVED FOR VENDOR LOGO AND DRAWING NUMBER

LARSEN & TOUBRO

This drawing is the property of LARSEN & TOUBRO and must not be passed on to any person or body not authorized by us to receive it nor be copied or otherwise made use either in full or in part by such person or body without our prior permission in writing.

Outotec

The content of these documents are the sole property of Outotec Oyj. Any rights not expressly granted herein are reserved. Reproduction, transfer or distribution of part or all of the contents in any form without prior written permission of Outotec is prohibited.

MA'ADEN معادن
Saudi Arabian Mining Company شركة التعدين العربية السعودية

This document and the information contained herein is Ma'aden proprietary know-how. This document or any part thereof should not be reproduced, stored in a retrieval system or transmitted by any means, electronic or otherwise, or divulged without prior written permission of Ma'aden.

LARSEN & TOUBRO DRAWING NUMBER: 019045_450_C_G_24119_004 — REVISION: 4
OUTOTEC DRAWING NUMBER: 900707__GAU01__RN13__MTL01__35232 — DOCUMENT ID: OU100676250 — REVISION: 4

DRAWN	SBH	19/03/2020
CHECKED	BDA	20/03/2020
ENGINEER	STY	19/03/2020
APPROVED	AG	21/03/2020
EMPLOYER		
SCALE	1:30	A1

MANSOURAH - MASSARAH GOLD PROJECT
GENERAL ARRANGEMENT
NEUTRALIZATION AND THICKENING
SECTIONS

DRAWING NUMBER: MD - 216 - 3520 - EG - CV - GAD - 1285 — REV: D01