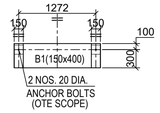
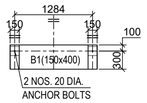
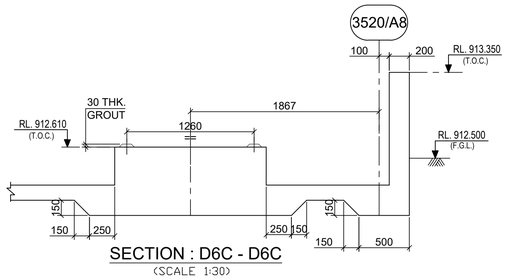
DRAWING NUMBER: MD-216-3520-EG-CV-GAD-1287 | REV: D01



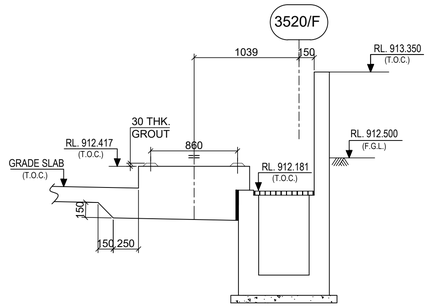

VIEW : A6 - A6
(SCALE 1:50)



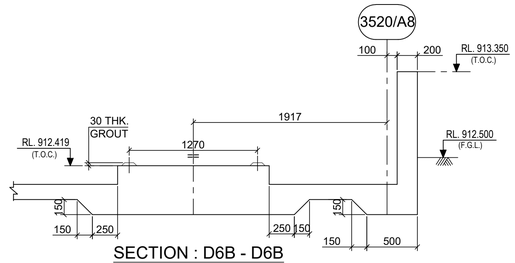

VIEW : A8 - A8
(SCALE 1:50)



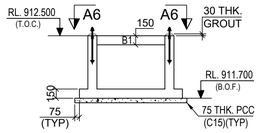

SECTION : D6C - D6C
(SCALE 1:30)



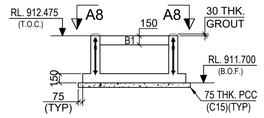

SECTION : D6D - D6D
(SCALE 1:30)



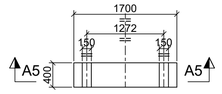

SECTION : D6B - D6B
(SCALE 1:30)



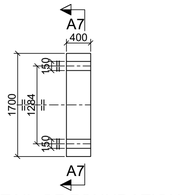

SECTION : A5 - A5
(SCALE 1:50)



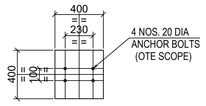

SECTION : A7 - A7
(SCALE 1:50)



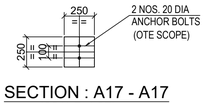

DETAIL OF FOUNDATION
MKD. F1C
(SCALE 1:50)



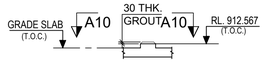

DETAIL OF FOUNDATION
MKD. F1D
(SCALE 1:50)



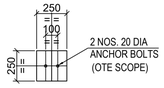

SECTION : A12 - A12
(SCALE 1:25)



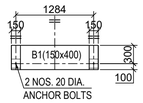

SECTION : A17 - A17
(SCALE 1:25)



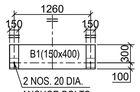

DETAIL OF FOUNDATION
MKD. F1H
(SCALE 1:50)



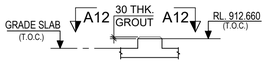

SECTION : A21 - A21
(SCALE 1:25)



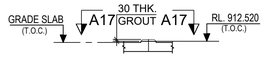

VIEW : A2 - A2
(SCALE 1:50)



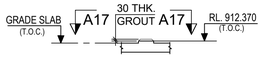

VIEW : A4 - A4
(SCALE 1:50)



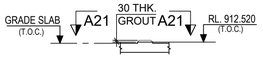

DETAIL OF FOUNDATION
MKD. F1F
(SCALE 1:50)



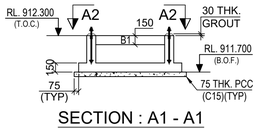

DETAIL OF FOUNDATION
MKD. F1K
(SCALE 1:50)



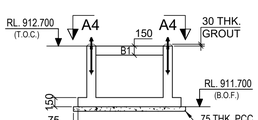

DETAIL OF FOUNDATION
MKD. F1KB
(SCALE 1:50)



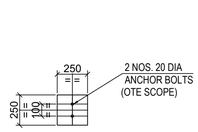

DETAIL OF FOUNDATION
MKD. F1KA
(SCALE 1:50)



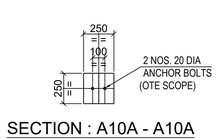

SECTION : A1 - A1
(SCALE 1:50)



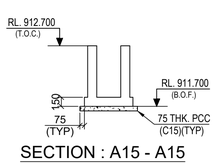

SECTION : A3 - A3
(SCALE 1:50)



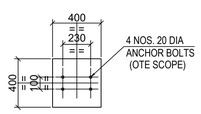

SECTION : A10 - A10
(SCALE 1:25)



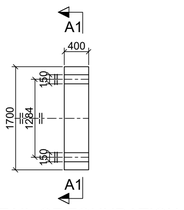

SECTION : A10A - A10A
(SCALE 1:25)



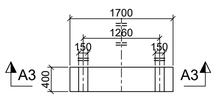

SECTION : A15 - A15
(SCALE 1:50)



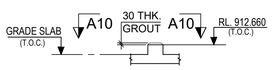

SECTION : A19 - A19
(SCALE 1:25)



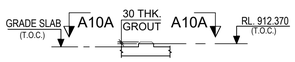

DETAIL OF FOUNDATION
MKD. F1A
(SCALE 1:50)



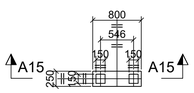

DETAIL OF FOUNDATION
MKD. F1B
(SCALE 1:50)



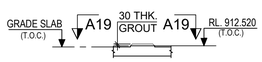

DETAIL OF FOUNDATION
MKD. F1E
(SCALE 1:50)




DETAIL OF FOUNDATION
MKD. F1G
(SCALE 1:50)




DETAIL OF FOUNDATION
MKD. F1J
(SCALE 1:50)




DETAIL OF FOUNDATION
MKD. F1L
(SCALE 1:50)

LEGEND :-
R.L. - REDUCED LEVEL
T.O.C. - TOP OF CONCRETE.
B.O.F. - BOTTOM OF FOUNDATION
F.G.L - FINISHED GROUND LEVEL
P.C.C - PLAIN CEMENT CONCRETE
TYP. - TYPICAL.
MKD. - MARKED.
THK. - THICK
REF. - REFER
DRG. - DRAWING
DIA - DIAMETER

NOTES:-
1. ALL DIMENSIONS ARE IN MILLIMETRES AND LEVELS ARE IN METRES UNLESS OTHERWISE STATED.
2. GRADE OF CONCRETE SHALL BE C35 UNLESS NOTED OTHERWISE.
3. GRADE OF REINFORCEMENT SHALL BE DEFORMED BAR ASTM A615-GRADE 60 (fy=420 MPa)
4. NET SAFE BEARING CAPACITY CONSIDERED AT THE FOUNDING LEVEL IS 460 KN/SQ. M
5. IF ANY PART OF FOUNDATION COMES ON BACKFILL ZONE OF ADJACENT FOUNDATION OR ANY LOOSE POCKETS ARE ENCOUNTERED BELOW FOUNDATION LEVEL THE SAME SHALL BE REMOVED AND FILLED WITH PCC.
6. FOR DETAIL DRAWING REF. DRG. NO. MD - 216 - 3510 - EG - CV - DED - 1284,1285&1286.
7. FOR STANDARD DETAILS OF PAVING REF. DRG. NO : MD-216-1000-EG-CV-DED-1002.
8. THIS DRAWING SHOULD READ IN CONJUNCTION WITH DRG. NO. MD - 216 - 3510 - EG - CV - GAD - 1284, 1285 & 1286.
9. FOR GENERAL NOTE OF CIVIL WORK REF. DRG. NO : MD-216-1000-EG-CV-DED-1001.

| DOCUMENT NUMBER | REFERENCE DOCUMENTS | REV | DATE | REVISION DESCRIPTION | DRN | CHK | ENG | APP | EMP |
|---|---|---|---|---|---|---|---|---|---|
| MD-216-3520-EG-ME-GAD-1017 | NEUTRALIZATION THICKENER OVERFLOW TANK | | | | | | | | |
| MD-216-3520-EG-ME-GAD-1048 | NEUTRALIZATION THICKENER OVERFLOW TANK | D01 | 22/02/2023 | AS-BUILT | SBH | BDA | STY | AG | |
| MD-216-3520-EG-ME-GAD-1047 | LAUNDER STRUCTURE LOADING DIAGRAM | C03 | 23/02/2021 | ISSUED FOR CONSTRUCTION & REVISED AS MKD. | SBH | BDA | STY | AG | |
| MD-216-3520-EG-CV-GAD-1001 | PLAN AT EL. +912.500 | C02 | 21/12/2020 | ISSUED FOR CONSTRUCTION & REVISED AS MKD. | SBH | BDA | STY | AG | |
| MD-216-3520-EG-ME-GAD-1009 | PLAN AT EL. +925.280 | C01 | 09/11/2020 | ISSUED FOR CONSTRUCTION | SBH | BDA | STY | AG | |
| MD-216-3520-EG-ME-GAD-1008 | PLAN AT EL. +912.500 | A01 | 19/10/2020 | ISSUED FOR REFERENCE | SBH | BDA | STY | AG | |

RESERVED FOR VENDOR LOGO AND DRAWING NUMBER

LARSEN & TOUBRO

This drawing is the property of LARSEN & TOUBRO and must not be passed on to any person or body not authorized by us to receive it nor be copied or otherwise made use either in full or in part by such person or body without our prior permission in writing.

Outotec

The content of these documents are the sole property of Outotec Oyj. Any rights not expressly granted herein are reserved. Reproduction, transfer or distribution of part or all of the contents in any form without prior written permission of Outotec is prohibited.

MA'ADEN معادن
Saudi Arabian Mining Company شركة التعدين العربية السعودية

This document and the information contained herein is Ma'aden proprietary know-how. This document or any part thereof should not be reproduced, stored in a retrieval system or transmitted by any means, electronic or otherwise, or divulged without prior written permission of Ma'aden.

LARSEN & TOUBRO DRAWING NUMBER: 019045_450_C_G_24119_006 | REVISION: 4
OUTOTEC DRAWING NUMBER: 900707__GAU01__RN13__MTL01__35234 | DOCUMENT ID: OU100698206 | REVISION: 4

| | | |
|---|---|---|
| DRAWN | SBH | 16/10/2020 |
| CHECKED | BDA | 17/10/2020 |
| ENGINEER | STY | 16/10/2020 |
| APPROVED | AG | 19/10/2020 |
| EMPLOYER | | |
| SCALE | 1:30 | A1 |

MANSOURAH - MASSARAH GOLD PROJECT
GENERAL ARRANGEMENT
NEUTRALIZATION AND THICKENING
PLATFORM SUPPORT & STAIR FOUNDATION

DRAWING NUMBER: MD - 216 - 3520 - EG - CV - GAD - 1287 | REV: D01