

DRAWING NUMBER: MD-216-3520-EG-CV-GAD-1289 | REV: D01

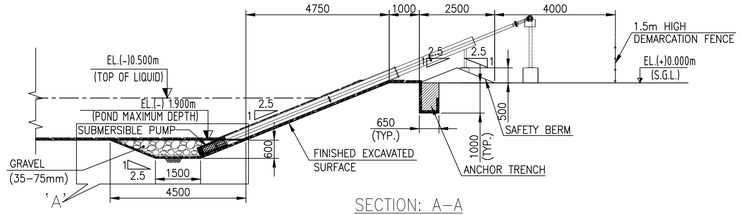


SECTION: A-A


SCALE-1:100

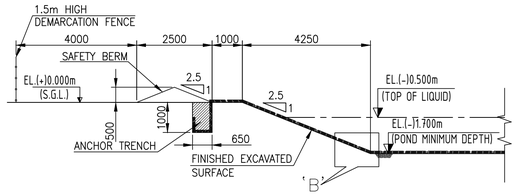

SECTION: B-B


SCALE-1:100

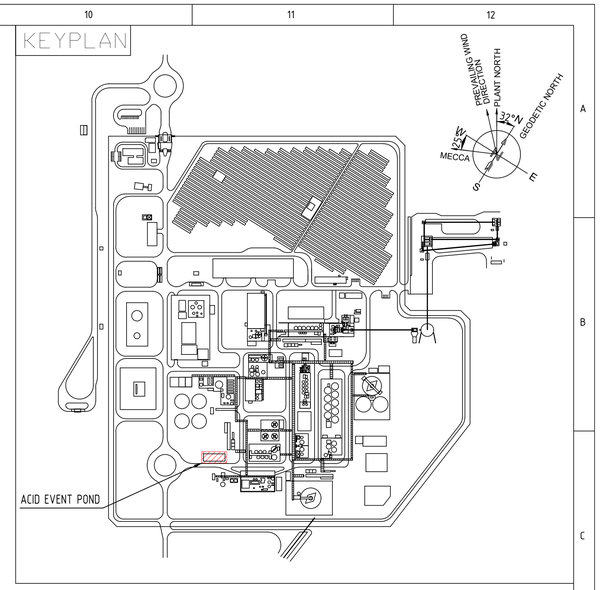

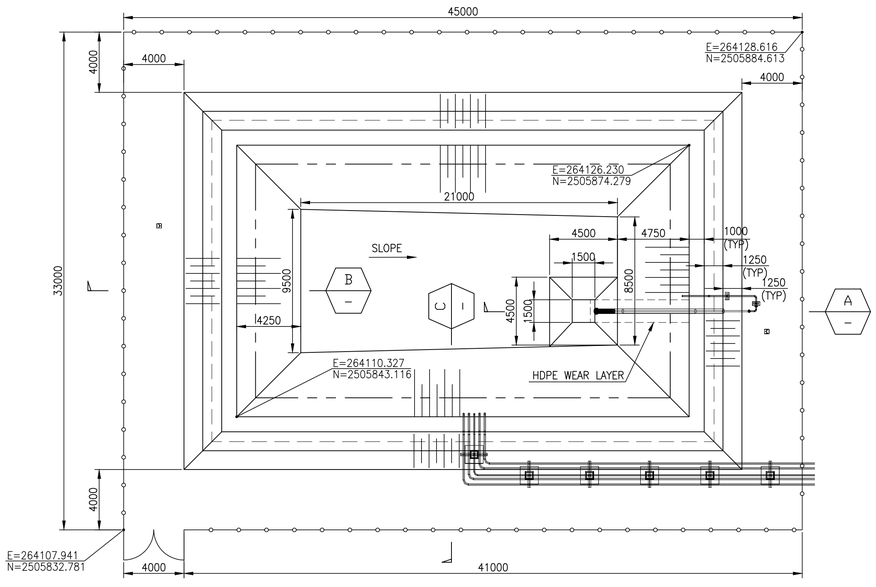


PLAN OF ACIDIC EVENT POND

SCALE-1:200

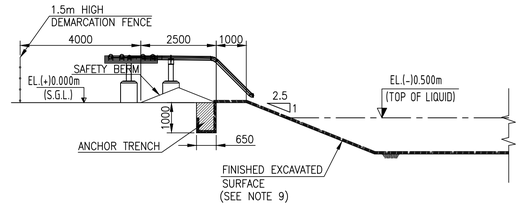


SECTION: C-C

SCALE-1:100

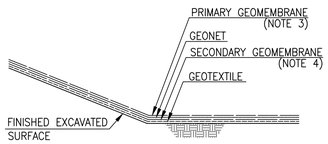

DETAIL-B
LINER SUBGRADE

SCALE-1:30

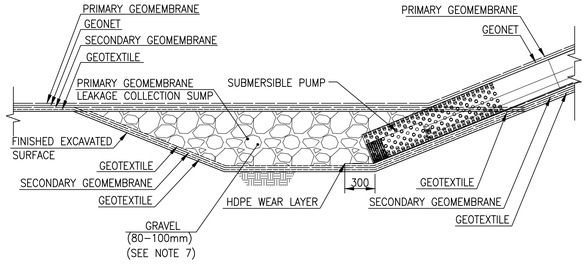

DETAIL-A
LINER SUBGRADE

SCALE-1:30

LEGENDS:

TYP - TYPICAL
SGL - STRIPPED GROUND LEVEL
EL - ELEVATION LEVEL

NOTES:

1. ALL DIMENSIONS ARE IN MILLIMETRES.
2. CO-ORDINATES AND LEVELS ARE IN METRES.
3. ROWAD HDPE DOUBLE ENHANCED TEXTURED BLACK (HDE)(ETEX): Model: HDE 2.00 mm FOR PRIMARY GEOMEMBRANE.
4. ROWAD HDPE DOUBLE SMOOTH BLACK (HDS): Model: HDS 2.00 mm FOR SECONDARY GEOMEMBRANE.
5. GEOTEXTILE SHALL CONFORM TO CL. 11 OF DOC. # MD-216-4400-EG-CV-SPC-1003.
6. GEOGRID LAYER ON RAMP SHALL BE A BI-AXIAL GEOGRID. 80kN/m BY 80kN/m (MINIMUM).
7. THE GRAVEL OF SIZE 80-100mm. SHALL BE COATED WITH ACID PROOF COAT VIZ. SIKAGARD 63 (OR EQUIVALENT).
8. ANCHOR TRENCH AND SAFETY BERM SHALL BE GENERAL EARTH FILL (FINE) SOURCED FROM EXCAVATION OF THE POND AT DEPTH LESS THAN 1.5-2m APPROVED BY ENGINEER. ZONE 3B MATERIAL SHALL BE USED FOR BACKFILLING OF ANCHOR TRENCH REFER CL. NO. 9.7.3 OF DOC. # MD-216-4400-EG-CV-SPC-1003 FOR COMPECTION REQUIREMENT.
9. EARTHWORK PREPARATION SHALL BE IN CONFORMANCE TO CL. NO. 7.1.3 (TYPE A4) OF DOC. NO. MD-216-4400-EG-CV-SPC-1003.

DOCUMENT NUMBER	REFERENCE DOCUMENTS	REV	DATE	REVISION DESCRIPTION	DRN	CHK	ENG	APP	EMP
		D01	18/02/2023	AS-BUILT	NAEW-SN	SJM	BJB	AG	
		C01	27/05/2021	ISSUED FOR CONSTRUCTION	SYA	SJM	BJB	AG	
		A02	17/04/2021	REVISED AS PER EMPLOYER'S COMMENTS ON 20/03/2021 AND REVISED AS MKD.	APEX	BJB	APEX	SJM	
MD-216-3520-EG-ME-GAD-1059	ACIDIC EVENT POND	A01	05/02/2021	ISSUED FOR REVIEW	APEX	BJB	APEX	SJM	

RESERVED FOR VENDOR LOGO AND DRAWING NUMBER

LARSEN & TOUBRO

This drawing is the property of LARSEN & TOUBRO and must not be passed on to any person or body not authorized by us to receive it nor be copied or otherwise made use either in full or in part by such person or body without our prior permission in writing.

Outotec

The content of these documents are the sole property of Outotec Oyj. Any rights not expressly granted herein are reserved. Reproduction, transfer or distribution of part or all of the contents in any form without prior written permission of Outotec is prohibited.

MA'ADEN معادن
Saudi Arabian Mining Company شركة معادن العربية السعودية

This document and the information contained herein is Ma'aden proprietary know-how. This document or any part thereof should not be reproduced, stored in a retrieval system or transmitted by any means, electronic or otherwise, or divulged without prior written permission of Ma'aden.

LARSEN & TOUBRO DRAWING NUMBER: 019045_450_C_G_24635_001 | REVISION: 3

OUTOTEC DRAWING NUMBER: 900707__GAU01__RN13__MTL01__35241 | DOCUMENT ID: OU100714974 | REVISION: 3

DRAWN	APEX	12/01/2021
CHECKED	BJB	03/02/2021
ENGINEER	APEX	12/01/2021
APPROVED	SJM	05/02/2021
EMPLOYER		
SCALE	1:200,100,30	A1

MANSOURAH - MASSARAH GOLD PROJECT
GENERAL ARRANGEMENT DRAWING
NEUTRALIZATION & THICKENING
LAYOUT & DETAILS OF ACIDIC EVENT POND

DRAWING NUMBER: MD-216-3520-EG-CV-GAD-1289 | REV: D01