

DRAWING NUMBER: MD - 216 - 3540 - EG - CV - GAD - 1292
REV: D01


SCHEDULE OF BOLTS									
BOLT MARK	LEVEL (T.O.C)	D BOLT DIA. MM	NO. OF BOLTS	BxB BOTTOM PLATE (SQUARE) SQ MM	DIMENSIONS (MM)				
					L	A	C	T	H
M1	RL 912.925	32	8	100x100	800	605	180	16	35
M2	RL 912.918	32	1	100x100	800	612	180	16	35
M3	RL 912.618	32	1	100x100	800	912	180	16	35

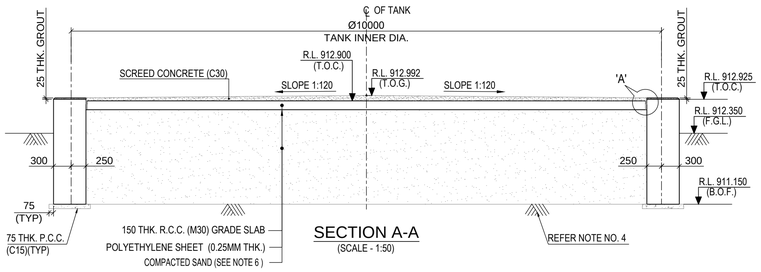


SECTION A-A
(SCALE - 1:50)

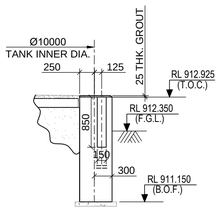


SECTION B-B
(SCALE - 1:50)

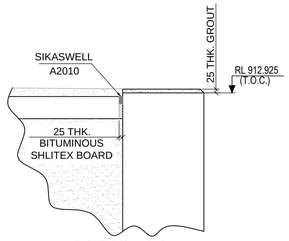


DETAIL - 'A'
(SCALE 1:20)

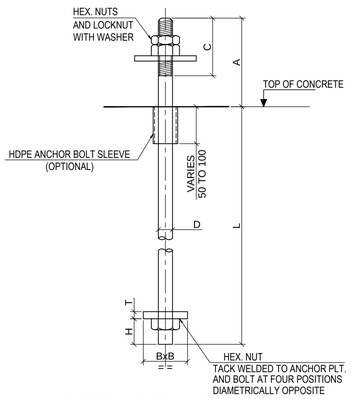


TYPICAL DETAIL OF BOLT
(SCALE - 1:50)

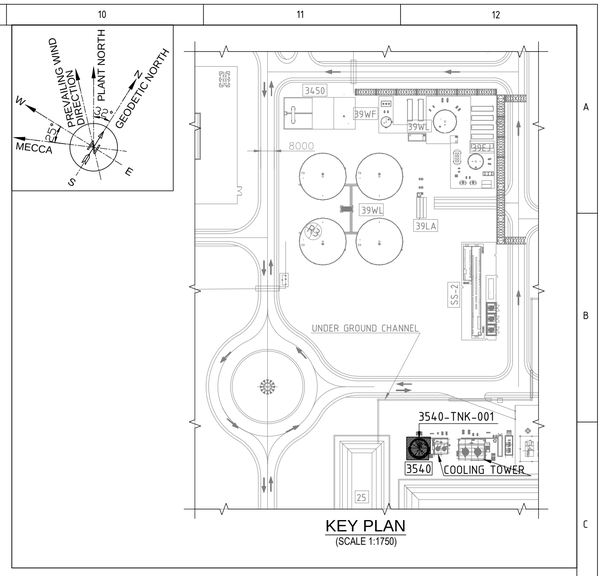


KEY PLAN
(SCALE 1:1750)

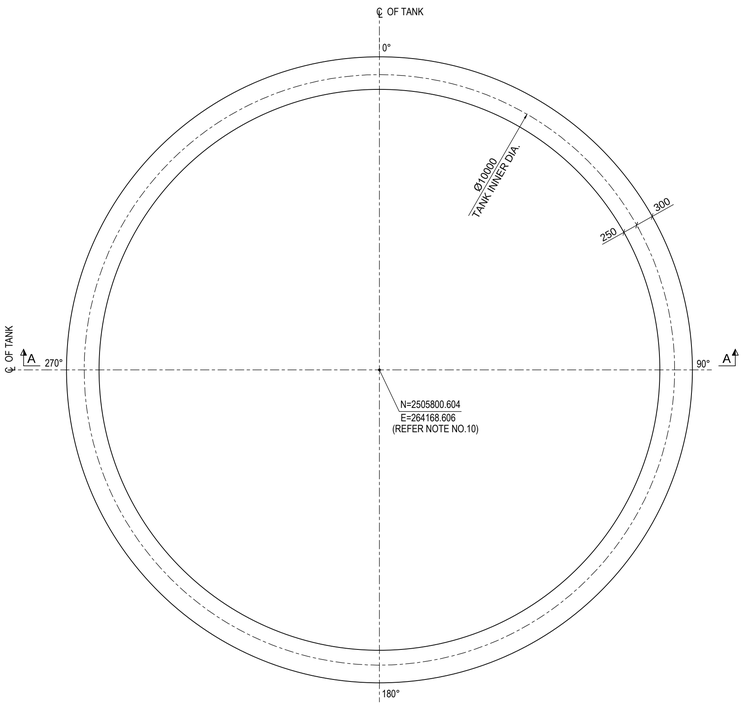


PLAN AT BOTTOM OF FOUNDATION
(SCALE - 1:50)

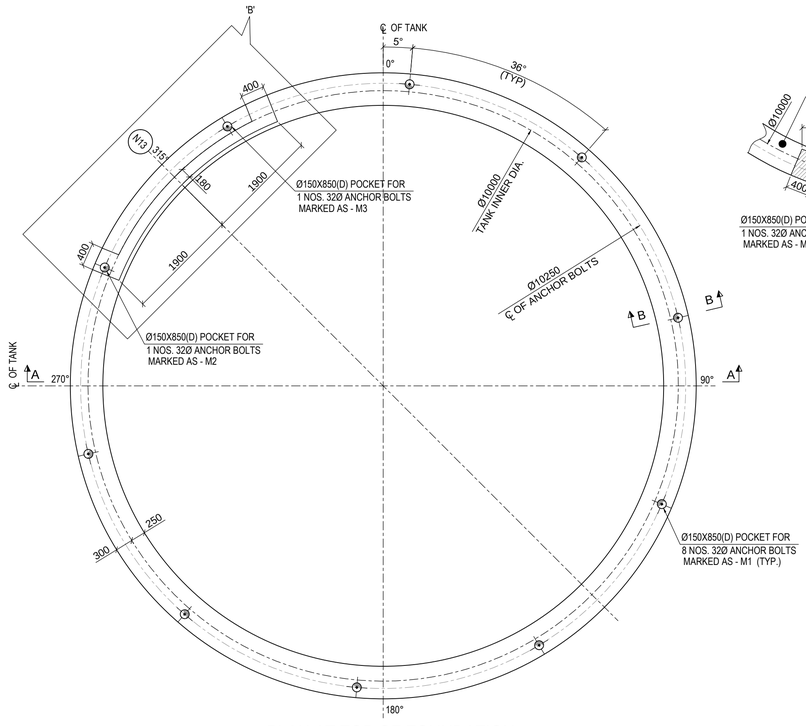

PLAN AT TOP OF FOUNDATION
(SCALE - 1:50)

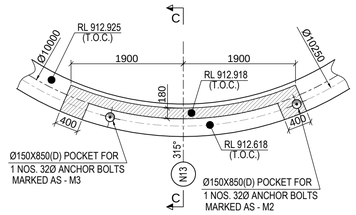

DETAIL - 'B'
(SCALE - 1:50)

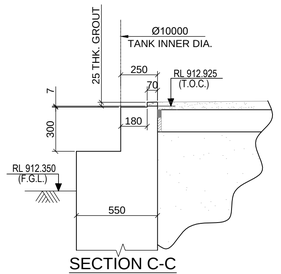

SECTION C-C
(SCALE 1:20)

LEGEND :-

R.L. - REDUCED LEVEL
T.O.C. - TOP OF CONCRETE.
T.O.G. - TOP OF GROUT
B.O.F. - BOTTOM OF FOUNDATION
F.G.L. - FINISHED GROUND LEVEL
TYP. - TYPICAL.
P.C.C - PLAIN CEMENT CONCRETE
R.C.C - REINFORCED CEMENT CONCRETE
PL. - PLATE
THK. - THICK
℄ - CENTRE LINE

NOTES:-

1. ALL DIMENSIONS ARE IN MILLIMETRE AND LEVELS ARE IN METRES UNLESS OTHERWISE STATED.
2. GRADE OF CONCRETE SHALL BE C35 UNLESS NOTED OTHERWISE.
3. GRADE OF REINFORCEMENT SHALL BE DEFORMED BAR ASTM A615-GRADE 60 (fy=420 MPa)
4. NET SAFE BEARING CAPACITY CONSIDERED AT THE FOUNDING LEVEL IS 375 KN/SQ. M
5. IF ANY PART OF FOUNDATION COMES ON BACKFILL ZONE OF ADJACENT FOUNDATION OR ANY LOOSE POCKETS ARE ENCOUNTERED BELOW FOUNDATION LEVEL THE SAME SHALL BE REMOVED AND FILLED WITH PCC.
6. SAND SHALL BE COMPACTED TO A MAXIMUM DEPTH OF 300MM & SHALL BE COMPACTED TO 80% RELATIVE DENSITY AS DETERMINED BY ASTM D4253 & ASTM D4254
7. FOR REINFORCEMENT DRAWING REFER DRG. NO. MD-216-3540-EG-CV-DED-1293.
8. FOR DETAIL OF FOUNDATION BOLT REFER DRG. NO : MD-216-1000-EG-CV-DED-1003.
9. GENERAL NOTE FOR CIVIL WORK REFER DRG. NO : MD-216-1000-EG-CV-DED-1001.
10. TANK CO-ORDINATE MENTIONED IN THIS DRAWING ARE BASED AS ON DATE E3D LAYOUT. HOWEVER, BEFORE CONSTRUCTION FINAL CO-ORDINATES SHOULD BE VERIFIED.

DOCUMENT NUMBER	REFERENCE DOCUMENTS	REV	DATE	REVISION DESCRIPTION	DRN	CHK	ENG	APP	EMP
MD-216-3540-EG-ME-GAD-1003	POX PROCESS WATER TANK 3540-TNK-001	D01	16/03/2023	AS-BUILT	APM	BDA	SUE	AG	
MD-216-3540-EG-ST-GAD-1003	ROOF SYSTEM OF TANK 3540-TNK-001	C02	18/08/2020	ISSUED FOR CONSTRUCTION	APM	BDA	SUE	AG	
MD-216-3540-EG-ST-GAD-1002	SHELL PLT DETAIL OF TANK 3540-TNK-001	C01	26/05/2020	ISSUED FOR CONSTRUCTION	APM	BDA	SUE	AG	
MD-216-3540-EG-ST-GAD-1001	PLAN, ELVN & DETAIL OF TANK 3540-TNK-001	A01	29/04/2020	ISSUED FOR REFERENCE	APM	BDA	SUE	AG	

RESERVED FOR VENDOR LOGO AND DRAWING NUMBER

LARSEN & TOUBRO DRAWING NUMBER: O19045_450_C_G_24126_001 — REVISION: 3
OUTOTEC DRAWING NUMBER: 900707__GAU01__AG02__MTL01__35405 — DOCUMENT ID: OU100681006 — REVISION: 3

LARSEN & TOUBRO
This drawing is the property of LARSEN & TOUBRO and must not be passed on to any person or body not authorized by us to receive it nor be copied or otherwise made use either in full or in part by such person or body without our prior permission in writing.
Outotec
The content of these documents are the sole property of Outotec Oy. Any rights not expressly granted herein are reserved. Reproduction, transfer or distribution of part or all of the contents in any form without prior written permission of Outotec is prohibited.
MA'ADEN معادن Saudi Arabian Mining Company شركة معادن العربية السعودية
This document and the information contained herein is Ma'aden proprietary know-how. This document or any part thereof should not be reproduced, stored in a retrieval system or transmitted by any means, electronic or otherwise, or divulged without prior written permission of Ma'aden.

DRAWN	APM	27/04/2020
CHECKED	BDA	28/04/2020
ENGINEER	SUE	27/04/2020
APPROVED	AG	29/04/2020
EMPLOYER		
SCALE	1:100, 1:50	A1

MANSOURAH - MASSARAH GOLD PROJECT
GENERAL ARRANGEMENT DRAWING
POX PROCESS WATER TANK 3540-TNK-001
FOUNDATION PLAN & SECTIONS

DRAWING NUMBER: MD - 216 - 3540 - EG - CV - GAD - 1292 — REV: D01