


DRAWING NUMBER: MD - 216 - 3540 - EG - CV - GAD - 1395
REV: D01

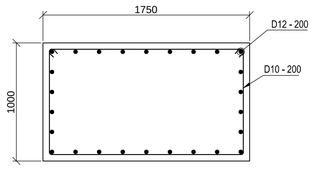


SECTION C-C
(SCALE - 1:25)

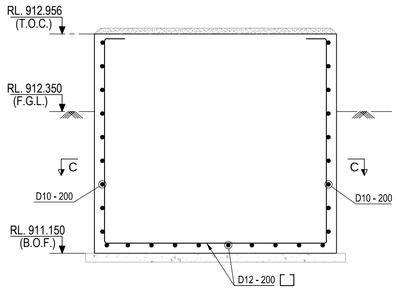


SECTION A-A
(SHOWING REINFORCEMENT ONLY)
(SCALE - 1:25)

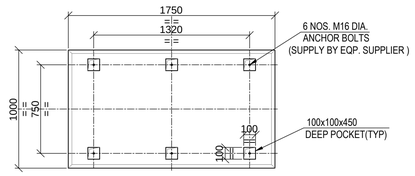


SECTION B-B
(SCALE - 1:25)

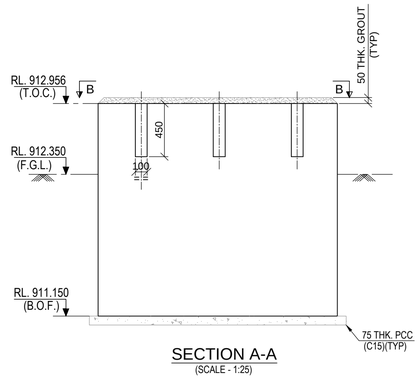


SECTION A-A
(SCALE - 1:25)

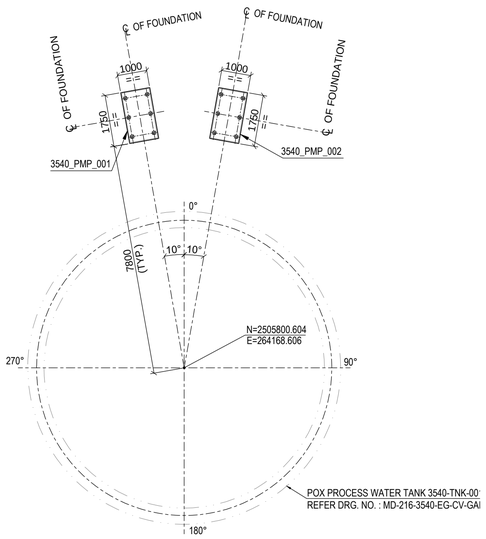


FOUNDATION LAYOUT PLAN OF
PROCESS WATER DISTRIBUTION PUMP
(SCALE 1:100)

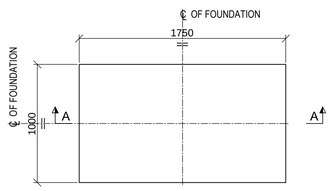

PLAN AT BOTTOM OF FOUNDATION
(3540 - PMP - 001 & 002)
(SCALE - 1:50)

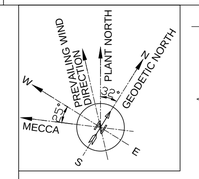

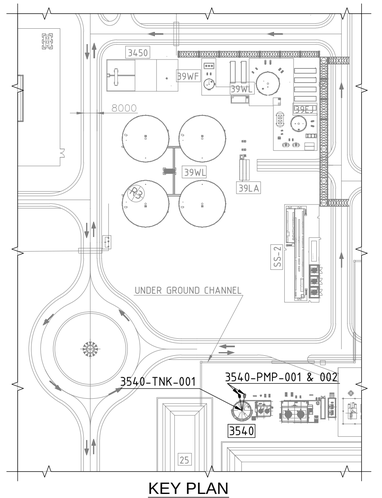

KEY PLAN
(SCALE 1:1750)

LEGEND :-

R.L. - REDUCED LEVEL
T.O.C. - TOP OF CONCRETE.
T.O.G. - TOP OF GROUT
B.O.F. - BOTTOM OF FOUNDATION
F.G.L. - FINISHED GROUND LEVEL
TYP. - TYPICAL.
P.C.C - PLAIN CEMENT CONCRETE
R.C.C - REINFORCED CEMENT CONCRETE
THK. - THICK
℄ - CENTRE LINE
DIA. - DIAMETER

NOTES:-

1. ALL DIMENSIONS ARE IN MILLIMETRE AND LEVELS ARE IN METRES UNLESS OTHERWISE STATED.
2. GRADE OF CONCRETE SHALL BE C35 UNLESS NOTED OTHERWISE.
3. GRADE OF REINFORCEMENT SHALL BE DEFORMED BAR ASTM A615-GRADE 60 (fy=420 MPa)
4. CLEAR COVER TO MAIN REINFORCEMENT SHALL BE AS FOLLOWS:
   a) FOUNDATION = 50 mm.
5. NET SAFE BEARING CAPACITY CONSIDERED AT THE FOUNDING LEVEL IS 375 KN/SQ. M
6. IF ANY PART OF FOUNDATION COMES ON BACKFILL ZONE OF ADJACENT FOUNDATION OR ANY LOOSE POCKETS ARE ENCOUNTERED BELOW FOUNDATION LEVEL THE SAME SHALL BE REMOVED AND FILLED WITH PCC.
7. GENERAL NOTE FOR CIVIL WORK REFER DRG. NO : MD-216-1000-EG-CV-DED-1001.
8. FOR STANDARD REINFORCEMENT DETAIL REFER DRG. NO : MD-216-1000-EG-CV-DED-1005.
9. REINFORCEMENT MAY BE SLIGHTLY ADJUSTED AT SITE TO ACCOMMODATE EMBEDDED PART.
10. TANK CO-ORDINATE MENTIONED IN THIS DRAWING ARE BASED AS ON DATE E3D LAYOUT. HOWEVER, BEFORE CONSTRUCTION FINAL CO-ORDINATES SHOULD BE VERIFIED.

DOCUMENT NUMBER	REFERENCE DOCUMENTS	REV	DATE	REVISION DESCRIPTION	DRN	CHK	ENG	APP	EMP
		D01	16/03/2023	AS-BUILT	SBH	BDA	SUE	AG	
		C01	14/08/2020	ISSUED FOR CONSTRUCTION	SBH	BDA	SUE	AG	
MD-216-3540-EG-ME-GAD-V563-1001	POX PROCESS WATER DISTRIBUTION PUMP	A01	24/07/2020	ISSUED FOR REFERENCE	SBH	BDA	SUE	AG	

RESERVED FOR VENDOR LOGO AND DRAWING NUMBER

LARSEN & TOUBRO

This drawing is the property of LARSEN & TOUBRO and must not be passed on to any person or body not authorized by us to receive it nor be copied or otherwise made use either in full or in part by such person or body without our prior permission in writing.

Outotec

The content of these documents are the sole property of Outotec Oyj. Any rights not expressly granted herein are reserved. Reproduction, transfer or distribution of part or all of the contents in any form without prior written permission of Outotec is prohibited.

MA'ADEN معادن
Saudi Arabian Mining Company شركة المعادن العربية السعودية

This document and the information contained herein is Ma'aden proprietary know-how. This document or any part thereof should not be reproduced, stored in a retrieval system or transmitted by any means, electronic or otherwise, or divulged without prior written permission of Ma'aden.

LARSEN & TOUBRO DRAWING NUMBER: 019045_450_C_G_24151_002 — REVISION: 2
OUTOTEC DRAWING NUMBER: 900707 _GAU01 _AG02_MTL01 _39509 — DOCUMENT ID: OU100691457 — REVISION: 2

DRAWN	SBH	22/07/2020
CHECKED	BDA	23/07/2020
ENGINEER	SUE	22/07/2020
APPROVED	AG	24/07/2020
EMPLOYER		
SCALE	1:100, 1:50	A1

MANSOURAH - MASSARAH GOLD PROJECT
GENERAL ARRANGEMENT DRAWING
PROCESS WATER STORAGE
POX PROCESS WATER DISTRIBUTION PUMP FOUNDATION

DRAWING NUMBER: MD - 216 - 3540 - EG - CV - GAD - 1395 — REV: D01