


DRAWING NUMBER: MD-216-3610-EG-CV-DED-1001 | REV: D01

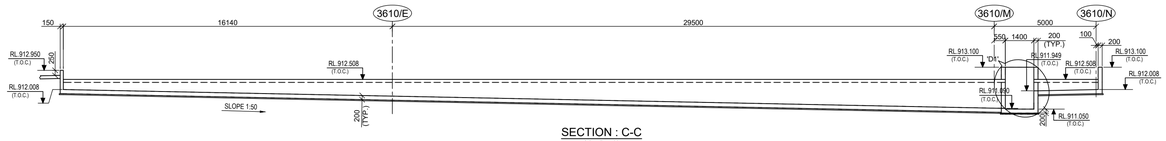


SECTION : C-C
SCALE 1:100

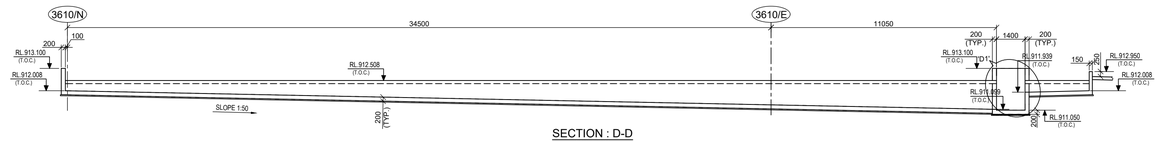


SECTION : D-D
SCALE 1:100

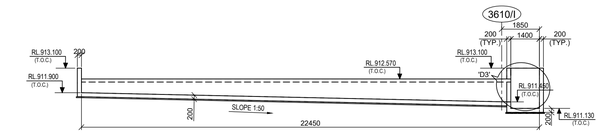


SECTION : E-E
SCALE 1:100

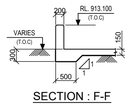


SECTION : F-F
SCALE 1:50

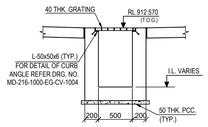


SECTION : G-G
SCALE 1:30

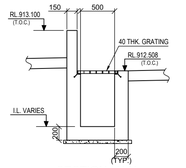


SECTION : H-H
SECTION : H1-H1 (OPP. HAND)
SCALE 1:30

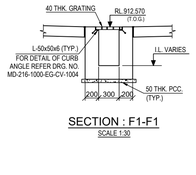

SECTION : F1-F1
SCALE 1:30

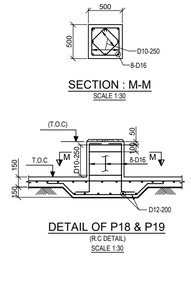

DETAIL OF P18 & P19
(R.C DETAIL)
SCALE 1:30

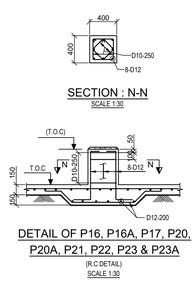

DETAIL OF P16, P16A, P17, P20, P20A, P21, P22, P23 & P23A
(R.C DETAIL)
SCALE 1:30

SECTION : B-B
SCALE 1:100

SECTION F-F
(R.C DETAIL)
SCALE 1:30

SECTION G-G
(R.C DETAIL)
SCALE 1:30


SECTION H-H
SECTION H1-H1
(R.C DETAIL)
SCALE 1:30

SECTION F1-F1
(R.C DETAIL)
SCALE 1:30


DETAIL OF PEDESTAL MKD. P1 TO P15
(PEDESTAL ORIENTATION TREATED AS PER LAYOUT PLAN)
(SCALE - 1:30)

SECTION : J-J
(SCALE - 1:30)


SECTION : J-J
(R.C DETAIL)
(SCALE - 1:30)

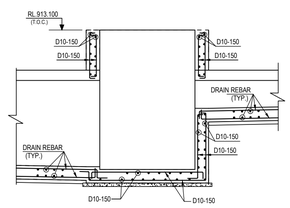


DETAIL-D1
(RC. DETAIL)
SCALE 1:30

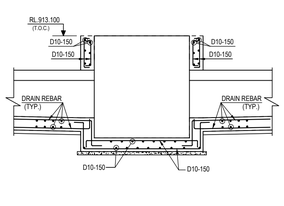


DETAIL-D2
(RC. DETAIL)
SCALE 1:30

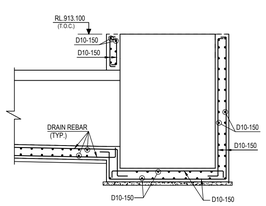


DETAIL-D3
(RC. DETAIL)
SCALE 1:30

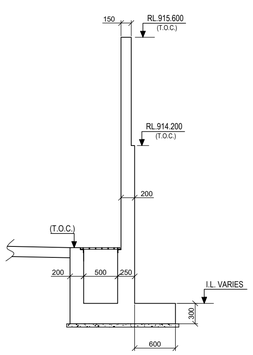


SECTION : F'-F'
SCALE 1:30

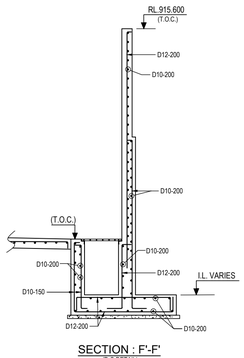

SECTION : F'-F'
(R.C DETAIL)
SCALE 1:30

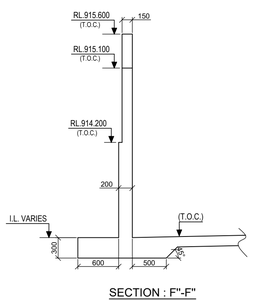

SECTION : F''-F''
SCALE 1:30

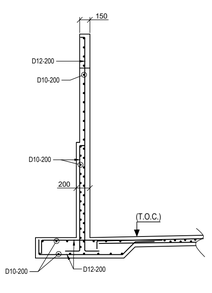

SECTION : F''-F''
(R.C DETAIL)
SCALE 1:30

LEGEND :-
R.L - REDUCED LEVEL
℄ - CENTRE LINE
T.O.C - TOP OF CONCRETE
F.G.L - FINISHED GROUND LEVEL
TYP - TYPICAL
R.C.C - REINFORCED CEMENT CONCRETE
P.C.C - PLAIN CEMENT CONCRETE
MKD. - MARKED
THK. - THICK
T.O.G - TOP OF GRATING
OPP. - OPPOSITE
T.O.I - TOP OF INSERT

NOTES:-
1. ALL DIMENSIONS ARE IN MILLIMETRES AND LEVELS AND CO-ORDINATES ARE IN METRES UNLESS OTHERWISE STATED.
2. GRADE OF CONCRETE SHALL BE C30 (30MPa) FOR GRADE SLAB & C15 (15MPa) FOR BLINDING CONCRETE
3. GRADE OF REINFORCEMENT SHALL BE DEFORMED BAR 420 MPa (GRADE 60) - ASTM A615/A615M.
4. CLEAR COVER TO REINFORCEMENT SHALL BE WALL - 40MM , SLAB - 25 MM , PEDESTAL - 40MM.
5. FOR DETAILS OF GRADE SLAB REFER DRG. NO. MD-216-1000-EG-CV-DED-1002.
6. THIS DRAWING SHOULD BE READ IN CONJUNCTION WITH DRAWING NO. MD-216-3610-EG-CV-GAD-1007.

DOCUMENT NUMBER	REFERENCE DOCUMENTS	REV	DATE	REVISION DESCRIPTION	DRN	CHK	ENG	APP	EMP
MD-216-3610-EG-CV-GAD-1007	LAYOUT & DETAILS OF GRADE SLAB								
MD-216-3610-EG-GV-GAD-1300	LAYOUT & DETAIL OF TANK FOUNDATIONS								
MD-216-3610-EG-ME-GAD-1920	POX CONDITIONING(LEACHING & ADSORPTION PLAN AT EL.+912.700								
MD-216-3610-EG-ME-PLN-1001	FOUNDATION AND LOAD PLAN POX CONDITIONING, LEACHING & ADSORPTION 3610-REA-001 TO 002 POX CONDITIONING REACTOR	D01	16/03/2023	AS-BUILT	ABS	SJM	AVG	AG	
		C01	11/12/2020	ISSUED FOR CONSTRUCTION & REVISED AS MKD. (2)	ABS	SJM	AVG	AG	
MD-216-1000-EG-ST-CRT-1001	CIVIL, STRUCTURAL & ARCHITECTURAL DESIGN CRITERIA	A01	20/10/2020	ISSUED FOR REFERENCE	ABS	SJM	AVG	AG	

RESERVED FOR VENDOR LOGO AND DRAWING NUMBER

LARSEN & TOUBRO

This drawing is the property of LARSEN & TOUBRO and must not be passed on to any person or body not authorized by us to receive it nor be copied or otherwise made use either in full or in part by such person or body without our prior permission in writing.

Outotec

The content of these documents are the sole property of Outotec Oyj. Any rights not expressly granted herein are reserved. Reproduction, transfer or distribution of part or all of the contents in any form without prior written permission of Outotec is prohibited.

MA'ADEN معادن Saudi Arabian Mining Company شركة معادن السعودية

This document and the information contained herein is Ma'aden proprietary know-how. This document or any part thereof should not be reproduced, stored in a retrieval system or transmitted by any means, electronic or otherwise, or divulged without prior written permission of Ma'aden.

LARSEN & TOUBRO DRAWING NUMBER	019045_450_C_D_24631_001		REVISION 2
OUTOTEC DRAWING NUMBER	900707__GAU01__HL12__CTB17__36103	DOCUMENT ID OU100680998	REVISION 2
DRAWN	ABS	18/10/2020	MANSOURAH - MASSARAH GOLD PROJECT
CHECKED	SJM	19/10/2020	DETAIL DRAWING
ENGINEER	AVG	18/10/2020	POX CONDITIONING, LEACHING AND ADSORPTION
APPROVED	AG	20/10/2020	DETAILS OF GRADE SLAB
EMPLOYER			
SCALE 1:100, 1:30	A0		DRAWING NUMBER MD-216-3610-EG-CV-DED-1001 REV D01