DRAWING NUMBER: MD - 216 - 3980 - EG - CV - GAD - V551-1474 | REV: D01

PREVAILING WIND DIRECTION
PLANT NORTH
GEODETIC NORTH
MECCA
32°
25°

P03 1 | P03 2 | P03 3 | TC1 A | TC1 B | TC1 2 | TC1 1 | TC2 1 | TC2 2 | TC2 A | TC2 B | CB B | CB A | CB 1 | CB 2 | ST B | ST A | ST 1 | ST 2

BP1 | BP2 | BP3 | BP4 | BP5 | BP6 | BP7 | BP8 | BP9 | BP10 | BP11 | BP12 | BP13 | BP14 | BP15 | BP16 | BP17 | BP18 | BP19 | BP20 | BP21 | BP22 | BP23 | BP24 | BP25 | BP26


PUMP CASING
TURBINE CASING–1
COLD BOX
TURBINE SKID
TURBINE CASING–2
STAIR TOWER

GROUT PAD 30 TH TYP
GROUT PAD 50 TH TYP
4 No M20 ANCHOR BOLTS ASTM F 1554 GRADE 36 TYP FOR BP15 TO BP18 SUPPLY BY AIR LIQUIDE
2 No M20 ANCHOR BOLTS ASTM F 1554 GRADE 36 TYP FOR BP9 TO BP14 SUPPLY BY AIR LIQUIDE
8 No M42 ANCHOR BOLTS ASTM F 1554 GRADE 36 TYP FOR BP1 TO BP4 SUPPLY BY AIR LIQUIDE
4 No M20 ANCHOR BOLTS ASTM F 1554 GRADE 36 TYP FOR BP19 TO BP22 SUPPLY BY AIR LIQUIDE
4 No M20 ANCHOR BOLTS ASTM F 1554 GRADE 36 TYP FOR BP23 TO BP26 SUPPLY BY AIR LIQUIDE
100 SQ 200 DEEP POCKET TO BE FILLED WITH NON SHRINK EPOXY GROUT TYP 6 NOS
1 No M12 ANCHOR BOLTS ASTM F 1554 GRADE 36 TYP 6 LOCATIONS SUPPLY BY AIR LIQUIDE
FLG FACE C30/C31
CL C30/E32

N = 2505844.043
E = 264263.676
N = 2505837.948
E = 264262.415


+X +Y +Z

FOUNDATION PLAN COLD BOX AREA
SCALE 1:30

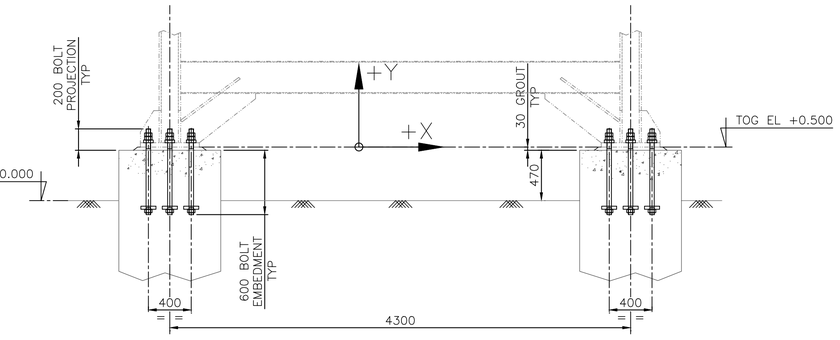


SECTION A
SCALE 1:30

FOR BP1 TO BP4

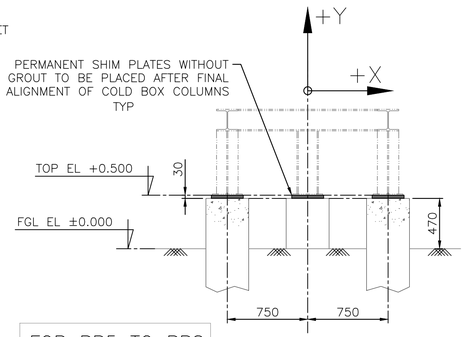

FOR BP5 TO BP8

SECTION B
SCALE 1:30

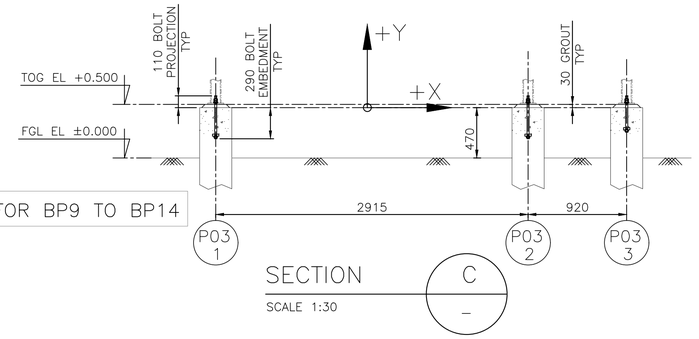

FOR BP9 TO BP14


SECTION C
SCALE 1:30

NOTES

1. ALL DIMENSIONS ARE IN MILLIMETER.
2. ALL LEVELS ARE IN METER.
3. FGL LEVEL ±0.0 CORRESPONDS TO RL 912.350.
4. SIZE OF FOUNDATION AND PEDESTAL SHALL BE DECIDED BY CIVIL DESIGN ENGINEER AS PER GIVEN LOADING.
5. ADDITIONAL REBAR REQUIREMENT AROUND ANCHOR BOLTS TO ENSURE NO FAILURE OF CONCRETE SHALL BE DECIDED BY CIVIL DESIGN ENGINEER AS PER GIVEN LOADING.
6. ALL GROUT SHALL BE NON SHRINK CEMENTITIOUS GROUT UNLESS NOTED OTHERWISE.
7. THIS DRAWING SHOULD READ IN CONJUNCTION WITH DRAWING NO MD–216–3980–EG–CV–GAD–V551–1475.

LEGEND :

CL – CENTER LINE
CG – CENTER OF GRAVITY
CONC – CONCRETE
EL – ELEVATION
EQP – EQUIPMENT
FGL – FINISHED GROUND LEVEL
Gr – GRADE
MPa – MEGA PASCAL
mm – MILLIMETER
No – NUMBER / NUMBERS
SQ – SQUARE
TH – THICKNESS
TOC – TOP OF CONCRETE
TOG – TOP OF GROUT
TOP – TOP OF SHIM PLATE
TYP – TYPICAL

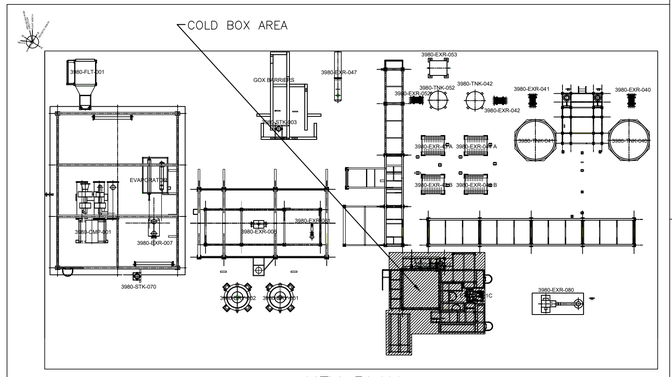

KEY PLAN

DOCUMENT NUMBER	REFERENCE DOCUMENTS	REV	DATE	REVISION DESCRIPTION	DRN	CHK	ENG	APP	EMP
		D01	22/02/2023	AS-BUILT	--	STY-SYC-SHH	--	BDA/PRI/JPD	
		C01	18/08/2020	ISSUED FOR CONSTRUCTION & REVISED AS PER EMPLOYER'S COMMENT ON 14/07/2020 AND REVISED AS MKD.	--	STY/SYC/SHH	--	BDA/PRI/JPD	
		A01	30/05/2020	ISSUED FOR INFORMATION	--	STY/SYC/SHH	--	BDA/PRI/JPD	

Air Liquide ENGINEERING & CONSTRUCTION

AIR LIQUIDE CONFIDENTIAL INFORMATION. THIS PRINT IS THE PROPERTY OF L'AIR LIQUIDE S.A. OR ITS (DIRECT AND INDIRECT) AFFILIATES OR SUBSIDIARIES AND CONTAINS VALUABLE CONFIDENTIAL INFORMATION. COPYRIGHT AND ALL OTHER RIGHTS IN THIS PRINT ARE EXPRESSLY RESERVED. NO PART OF THIS PRINT MAY BE DISCLOSED BY THE INTENDED RECIPIENT TO A THIRD PARTY, REPRODUCED, COPIED, LENT, OR DISPOSED OF, DIRECTLY OR INDIRECTLY, NOR USED FOR ANY PURPOSE OTHER THAN THAT FOR WHICH IT IS EXPRESSLY FURNISHED. THIS PRINT IS LENT SUBJECT TO RETURN ON DEMAND.

DRAWING NUMBER				REVISION	STATUS
12126-60-01-CS-131090				0	AFD
DATE	11/05/2020	DATE	12/05/2020	DATE	30/05/2020
DRAWN	SGH	CHECKED	ABM	APPROVED	DS

LARSEN & TOUBRO

This drawing is the property of *LARSEN & TOUBRO* and must not be passed on to any person or body not authorized by us to receive it nor be copied or otherwise made use either in full or in part by such person or body without our prior permission in writing.

Outotec

The content of these documents are the sole property of Outotec Oyj. Any rights not expressly granted herein are reserved. Reproduction, transfer or distribution of part or all of the contents in any form without prior written permission of Outotec is prohibited.

MA'ADEN معادن
Saudi Arabian Mining Company شركة التعدين العربية السعودية

This document and the information contained herein is Ma'aden proprietary know-how. This document or any part thereof should not be reproduced, stored in a retrieval system or transmitted by any means, electronic or otherwise, or divulged without prior written permission of Ma'aden.

LARSEN & TOUBRO DRAWING NUMBER			REVISION
019045_080_C_V_24225_001			2
OUTOTEC DRAWING NUMBER		DOCUMENT ID	REVISION
900707__GAU01__AG22__MTL01__39817		OU100680042	2

DRAWN	--	--
CHECKED	STY/ SYC/ SHH	28/05/2020
ENGINEER	--	--
APPROVED	BDA/ PRI/ JPD	30/05/2020
EMPLOYER		
SCALE	1:30	A1

MANSOURAH - MASSARAH GOLD PROJECT
GENERAL ARRANGEMENT DRAWING
OXYGEN PLANT
FOUNDATION LOAD DATA-COLD BOX AREA(1 OF 2)

DRAWING NUMBER: MD - 216 - 3980 - EG - CV - GAD - V551-1474 | REV: D01