



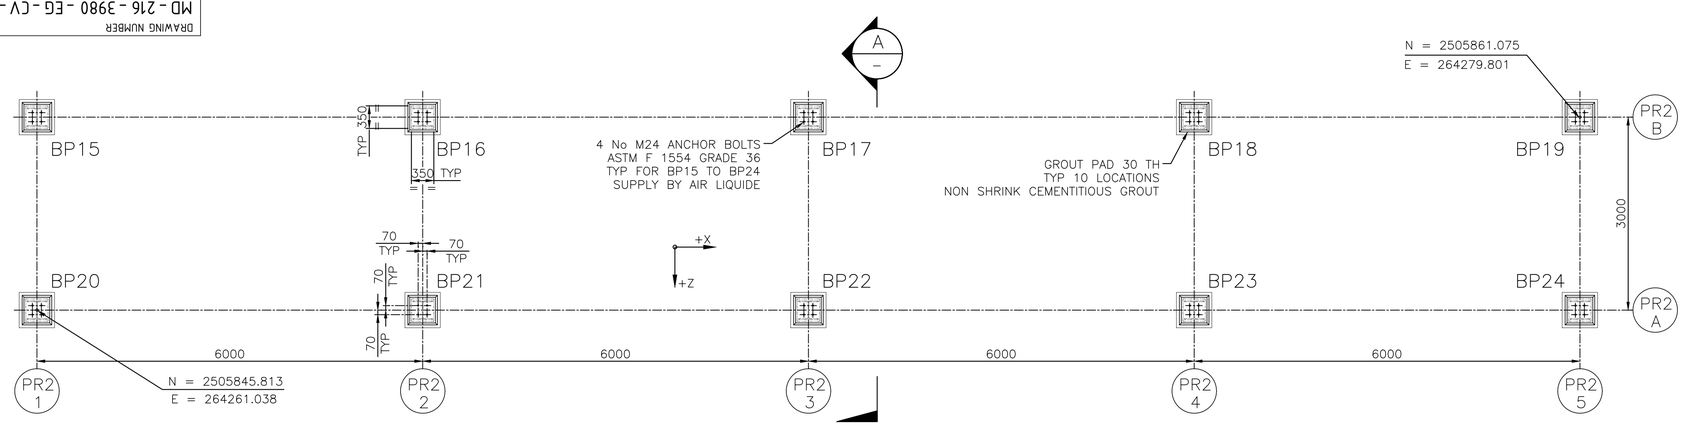

FOUNDATION PLAN PIPE RACK-2

SCALE 1:50

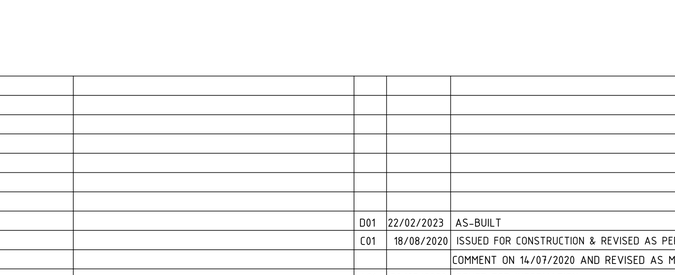

SECTION A–A

SCALE 1:30

FOUNDATION LOAD : PIPE RACK-2

SL No	Description	BP15			BP16			BP17			BP18			BP19			Remarks
		X (kN)	Y (kN)	Z (kN)	X (kN)	Y (kN)	Z (kN)	X (kN)	Y (kN)	Z (kN)	X (kN)	Y (kN)	Z (kN)	X (kN)	Y (kN)	Z (kN)	
1	DEAD LOAD	0.0	-22.3	0.0	0.0	-29.4	0.0	0.0	-29.3	0.0	-1.3	-31.5	0.0	1.3	-23.3	0.0	A. ALL LOADS FURNISHED IN THIS TABLE ARE UNFACTORED ACTING LOADS. B. PIPE LOAD SHALL BE CONSIDERED UNDER DEAD LOAD CATEGORY. C. FOR REVERSE DIRECTION OF LOAD CASE 5 TO 9, MULTIPLY ALL VALUES WITH -1.
2	PIPE EMPTY LOAD	0.0	-9.9	-0.3	0.0	-11.4	-0.3	0.0	-11.4	-0.3	0.0	-11.4	-0.3	0.0	-9.9	-0.3	
3	PIPE OPERATING LOAD	0.0	-16.5	-0.5	0.0	-18.9	-0.5	0.0	-18.9	-0.5	-0.2	-18.9	-0.5	0.2	-16.5	-0.5	
4	PIPE TEST LOAD	0.0	-16.5	-0.5	0.0	-18.9	-0.5	0.0	-18.9	-0.5	-0.2	-18.9	-0.5	0.2	-16.5	-0.5	
5	PIPE LOAD +X	0.2	0.0	0.0	0.2	0.0	0.0	0.2	0.0	0.0	4.3	6.3	0.0	4.3	-6.3	0.0	
6	WIND LOAD +X	1.6	0.9	0.2	1.6	-0.2	0.0	1.6	-0.2	0.0	20.1	31.0	-0.2	20.2	-31.6	-0.2	
7	WIND LOAD +Z	-0.3	85.2	22.8	-0.2	96.3	27.3	0.0	103.1	29.2	-4.0	92.4	31.4	-4.3	102.3	29.6	
8	SEISMIC LOAD +X	0.0	0.0	0.0	0.0	0.0	0.0	0.0	0.0	0.0	1.6	2.7	0.0	1.6	-2.7	0.0	
9	SEISMIC LOAD +Z	0.0	2.2	0.6	0.0	2.2	0.7	0.0	2.4	0.7	-0.2	2.0	0.7	-0.2	2.2	0.6	
10	TEMPERATURE LOAD +ve	-3.3	0.4	-0.8	-2.2	0.0	-0.9	-1.3	-0.4	-1.0	-3.7	0.7	-0.9	11.0	-0.7	-0.9	
11	TEMPERATURE LOAD -ve	1.8	-0.2	0.5	1.1	0.0	0.5	0.7	0.2	0.6	1.9	-0.4	0.5	-5.9	0.4	0.5	

SL No	Description	BP20			BP21			BP22			BP23			BP24			Remarks
		X (kN)	Y (kN)	Z (kN)	X (kN)	Y (kN)	Z (kN)	X (kN)	Y (kN)	Z (kN)	X (kN)	Y (kN)	Z (kN)	X (kN)	Y (kN)	Z (kN)	
1	DEAD LOAD	0.0	-24.5	0.0	0.0	-32.7	0.0	0.0	-32.5	0.0	-1.3	-34.8	0.0	1.4	-25.7	0.0	A. ALL LOADS FURNISHED IN THIS TABLE ARE UNFACTORED ACTING LOADS. B. PIPE LOAD SHALL BE CONSIDERED UNDER DEAD LOAD CATEGORY. C. FOR REVERSE DIRECTION OF LOAD CASE 5 TO 9, MULTIPLY ALL VALUES WITH -1.
2	PIPE EMPTY LOAD	0.0	-9.9	0.3	0.0	-11.4	0.3	0.0	-11.4	0.3	0.0	-11.4	0.3	0.0	-9.9	0.3	
3	PIPE OPERATING LOAD	0.0	-16.5	0.5	0.0	-18.9	0.5	0.0	-18.9	0.5	-0.2	-18.9	0.5	0.2	-16.5	0.5	
4	PIPE TEST LOAD	0.0	-16.5	0.5	0.0	-18.9	0.5	0.0	-18.9	0.5	-0.2	-18.9	0.5	0.2	-16.5	0.5	
5	PIPE LOAD +X	0.2	0.0	0.0	0.2	0.0	0.0	0.2	0.0	0.0	4.3	6.3	0.0	4.4	-6.3	0.0	
6	WIND LOAD +X	1.7	-0.3	0.2	1.6	-0.6	0.0	1.6	0.2	0.0	19.2	30.5	-0.2	19.3	-29.9	-0.2	
7	WIND LOAD +Z	0.0	-85.1	22.8	0.0	-96.4	27.3	0.0	-103.1	29.2	4.1	-92.6	31.4	4.4	-102.1	29.6	
8	SEISMIC LOAD +X	0.0	0.0	0.0	0.0	0.0	0.0	0.0	0.0	0.0	1.6	2.8	0.0	1.6	-2.8	0.0	
9	SEISMIC LOAD +Z	0.0	-2.2	0.6	0.0	-2.2	0.7	0.0	-2.4	0.7	0.2	-2.0	0.7	0.2	-2.2	0.6	
10	TEMPERATURE LOAD +ve	-3.3	-1.4	1.0	-2.5	1.0	0.8	-1.4	0.4	0.8	-4.1	0.4	0.9	10.6	-0.4	0.9	
11	TEMPERATURE LOAD -ve	1.8	0.7	-0.6	1.4	-0.6	-0.5	0.8	-0.2	-0.5	2.2	-0.2	-0.5	-5.5	0.2	-0.5	

NOTE: PIPE LOAD +X & PIPE LOAD+Z ARE THE HORIZONTAL LOADS GENERATED DUE TO PIPE STRESS.
THESE TWO LOADS SHALL BE CONSIDERED ACTING SIMULTANEOUSLY IN OPERATING CONDITION.

NOTES

1. ALL DIMENSIONS ARE IN MILLIMETER.
2. ALL LEVELS ARE IN METER.
3. THIS DRAWING SHOULD READ IN CONJUNCTION WITH DRAWING NO MD-216-3980-EG-CV-GAD-V551-1486
4. FOR ALL OTHER NOTES REFER DRAWING NO MD-216-3980-EG-CV-GAD-V551-1486.
5. WIND & SEISMIC LOADS ARE AS PER SBC 301.

DOCUMENT NUMBER	REFERENCE DOCUMENTS	REV	DATE	REVISION DESCRIPTION	DRN	CHK	ENG	APP	EMP
		D01	22/02/2023	AS-BUILT	--	STY/SYC/SHH	--	BDA/PRI/JPD	
		C01	18/08/2020	ISSUED FOR CONSTRUCTION & REVISED AS PER EMPLOYER'S COMMENT ON 14/07/2020 AND REVISED AS MKD.	--	STY/SYC/SHH	--	BDA/PRI/JPD	
		A01	30/05/2020	ISSUED FOR INFORMATION	--	STY/SYC/SHH	--	BDA/PRI/JPD	

Air Liquide ENGINEERING & CONSTRUCTION
AIR LIQUIDE CONFIDENTIAL INFORMATION: THIS PRINT IS THE PROPERTY OF L'AIR LIQUIDE S.A. OR ITS (DIRECT AND INDIRECT) AFFILIATES OR SUBSIDIARIES AND CONTAINS VALUABLE CONFIDENTIAL INFORMATION. COPYRIGHT AND ALL OTHER RIGHTS IN THIS PRINT ARE EXPRESSLY RESERVED. NO PART OF THIS PRINT MAY BE DISCLOSED BY THE INTENDED RECIPIENT TO A THIRD PARTY, REPRODUCED, COPIED, LENT, OR DISPOSED OF, DIRECTLY OR INDIRECTLY, NOR USED FOR ANY PURPOSE OTHER THAN THAT FOR WHICH IT IS EXPRESSLY FURNISHED. THIS PRINT IS LENT SUBJECT TO RETURN ON DEMAND.

DRAWING NUMBER				REVISION	STATUS
12126-60-01-CS-141241				0	AFD
DATE	11/05/2020	DATE	12/05/2020	DATE	30/05/2020
DRAWN	SGH	CHECKED	ABM	APPROVED	DS

LARSEN & TOUBRO DRAWING NUMBER			REVISION
019045_080_C_V_24225_003			2
OUTOTEC DRAWING NUMBER		DOCUMENT ID	REVISION
900707 __GAU01 __AG22__MTL01 __39840		OU100687718	2

LARSEN & TOUBRO
This drawing is the property of LARSEN & TOUBRO and must not be passed on to any person or body not authorized by us to receive it nor be copied or otherwise made use either in full or in part by such person or body without our prior permission in writing.

Outotec
The content of these documents are the sole property of Outotec Oyj. Any rights not expressly granted herein are reserved. Reproduction, transfer or distribution of part or all of the contents in any form without prior written permission of Outotec is prohibited.

MA'ADEN معادن Saudi Arabian Mining Company شركة التعدين العربية السعودية
This document and the information contained herein is Ma'aden proprietary know-how. This document or any part thereof should not be reproduced, stored in a retrieval system or transmitted by any means, electronic or otherwise, or divulged without prior written permission of Ma'aden.

DRAWN	--	--	MANSOURAH - MASSARAH GOLD PROJECT GENERAL ARRANGEMENT DRAWING OXYGEN PLANT FOUNDATION LOAD & ANCHORAGE - PIPE RACK-2
CHECKED	STY/ SYC/ SHH	28/05/2020	
ENGINEER	--	--	
APPROVED	BDA/ PRI/ JPD	30/05/2020	
EMPLOYER			
SCALE	1:30	A1	DRAWING NUMBER: MD-216-3980-EG-CV-GAD-V551-1476 REV: D01