



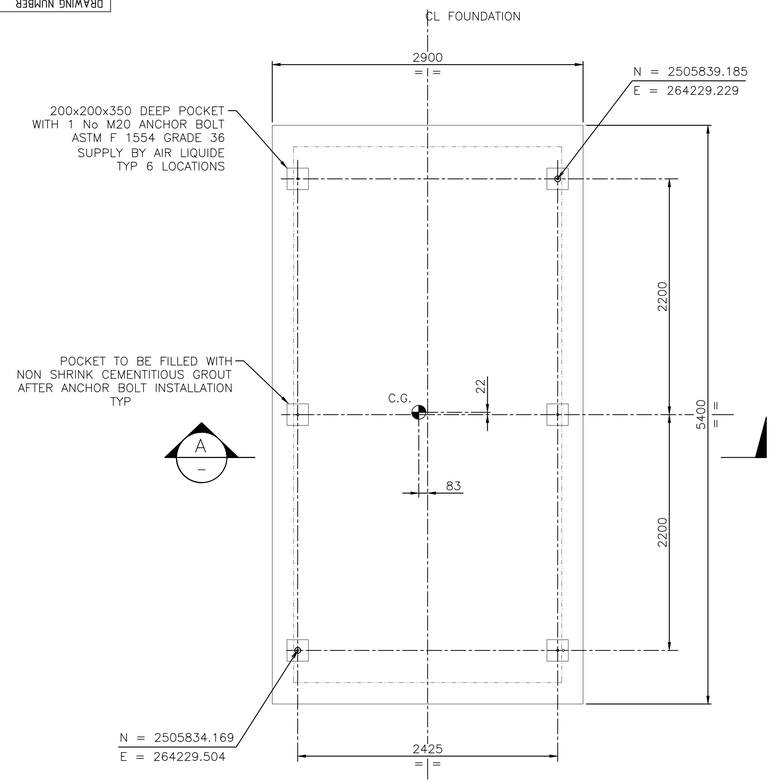

FOUNDATION PLAN REFRIGERATION UNIT

SCALE 1:30

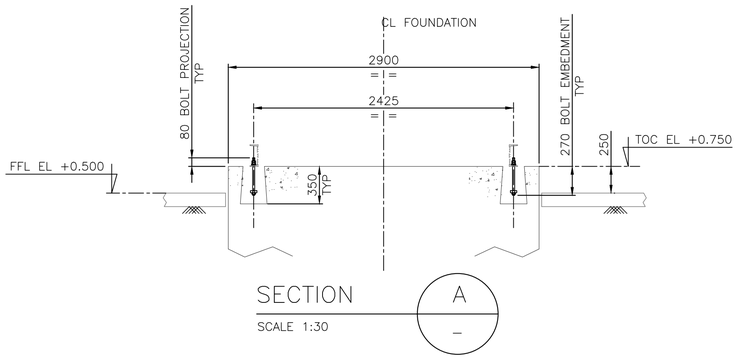

SECTION A–A

SCALE 1:30

LOAD DATA TABLE


REFRIGERATION UNIT (3980–PKG–060)		
SL No	Description	
1	EMPTY LOAD	90.0 kN
2	OPERATING LOAD	100.0 kN

EMPTY AND OPERATING LOADS ARE VERTICAL DOWNWARD LOAD.

C.G. HEIGHT FROM EQUIPMENT BASE (TOC EL +0.750) = 1.680M.

NOTES

1. ALL DIMENSIONS ARE IN MILLIMETER.
2. ALL LEVELS ARE IN METER.
3. FGL LEVEL ±0.0 CORRESPONDS TO RL 912.350.
4. THE LOADS INDICATED IN LOAD DATA TABLE ARE ACTUAL. FOUNDATION DESIGNER SHOULD CONSIDER NECESSARY MARGIN.
5. SIZE OF FOUNDATION AND PEDESTAL SHALL BE DECIDED BY CIVIL DESIGN ENGINEER AS PER GIVEN LOADING.
6. ADDITIONAL REBAR REQUIREMENT AROUND ANCHOR BOLTS TO ENSURE NO FAILURE OF CONCRETE SHALL BE DECIDED BY CIVIL DESIGN ENGINEER AS PER GIVEN LOADING.
7. LEGEND:
   - BCD – BOLT CIRCLE DIAMETER
   - C.G. – CENTER OF GRAVITY
   - CL – CENTER LINE
   - CONC – CONCRETE
   - EL – ELEVATION
   - EQP – EQUIPMENT
   - FFL – FINISHED FLOOR LEVEL
   - FGL – FINISHED GROUND LEVEL
   - Gr – GRADE
   - MIN – MINIMUM
   - MPa – MEGA PASCAL
   - mm – MILLIMETER
   - No – NUMBER / NUMBERS
   - TH – THICKNESS
   - TOC – TOP OF CONCRETE
   - TOG – TOP OF GROUT
   - TYP – TYPICAL

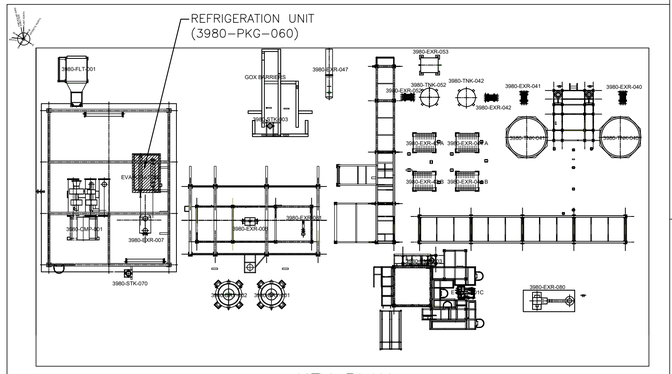

KEY PLAN

REV	DRAWING NUMBER	REVISION DESCRIPTION	DRN	CHK	ENG	APP	EMP
D01	22/02/2023	AS-BUILT	--	STY/SYC/SHH	--	BDA/PRI/JPD	
C01	14/08/2020	ISSUED FOR CONSTRUCTION	--	STY/SYC/SHH	--	BDA/PRI/JPD	
A01	10/07/2020	ISSUED FOR INFORMATION	--	STY/SYC/SHH	--	BDA/PRI/JPD	

DOCUMENT NUMBER | REFERENCE DOCUMENTS

Air Liquide ENGINEERING & CONSTRUCTION

AIR LIQUIDE CONFIDENTIAL INFORMATION. THIS PRINT IS THE PROPERTY OF L'AIR LIQUIDE S.A. OR ITS DIRECT AND INDIRECT AFFILIATES OR SUBSIDIARIES AND CONTAINS VALUABLE CONFIDENTIAL INFORMATION. COPYRIGHT AND ALL OTHER RIGHTS IN THIS PRINT ARE EXPRESSLY RESERVED. NO PART OF THIS PRINT MAY BE DISCLOSED BY THE INTENDED RECIPIENT TO A THIRD PARTY, REPRODUCED, COPIED, LENT, OR DISPOSED OF, DIRECTLY OR INDIRECTLY, NOR USED FOR ANY PURPOSE OTHER THAN THAT FOR WHICH IT IS EXPRESSLY FURNISHED. THIS PRINT IS LENT SUBJECT TO RETURN ON DEMAND.

DRAWING NUMBER				REVISION	STATUS
12126-60-01-CS-141060				0	AFD
DATE	06/07/2020	DATE	07/07/2020	DATE	08/07/2020
DRAWN	SGH	CHECKED	ABM	APPROVED	DS

LARSEN & TOUBRO DRAWING NUMBER: O19045_080_C_V_24225_008 — REVISION 2

OUTOTEC DRAWING NUMBER: 900707 __GAU01 __AG22__MTL01 __39821 — DOCUMENT ID: OU100680046 — REVISION 2

LARSEN & TOUBRO

This drawing is the property of *LARSEN & TOUBRO* and must not be passed on to any person or body not authorized by us to receive it nor be copied or otherwise made use either in full or in part by such person or body without our prior permission in writing.

Outotec

The content of these documents are the sole property of Outotec Oyj. Any rights not expressly granted herein are reserved. Reproduction, transfer or distribution of part or all of the contents in any form without prior written permission of Outotec is prohibited.

MA'ADEN معادن — Saudi Arabian Mining Company شركة التعدين العربية السعودية

This document and the information contained herein is Ma'aden proprietary know-how. This document or any part thereof should not be reproduced, stored in a retrieval system or transmitted by any means, electronic or otherwise, or divulged without prior written permission of Ma'aden.

DRAWN	--	--
CHECKED	STY/ SYC/ SHH	09/07/2020
ENGINEER	--	--
APPROVED	BDA/ PRI/ JPD	10/07/2020
EMPLOYER		
SCALE	1:30	A1

MANSOURAH - MASSARAH GOLD PROJECT
GENERAL ARRANGEMENT DRAWING
OXYGEN PLANT
FOUNDATION LOAD - REFRIGERATION UNIT

DRAWING NUMBER: MD - 216 - 3980 - EG - CV - GAD - V551-1481 — REV D01