


DRAWING NUMBER: MD - 216 - 3980 - EG - CV - GAD - V551-1483 | REV: D01

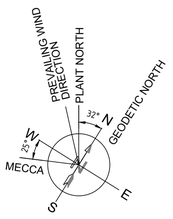



## FOUNDATION PLAN AIR FILTER
TOC EL +3.150
SCALE 1:30

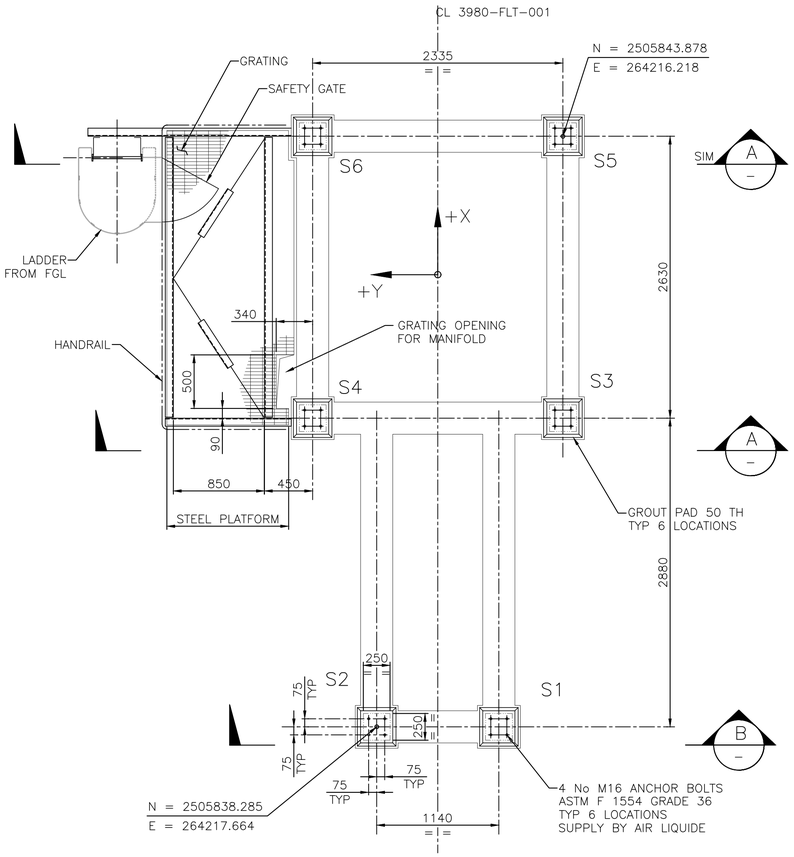


## SECTION A
SCALE 1:30

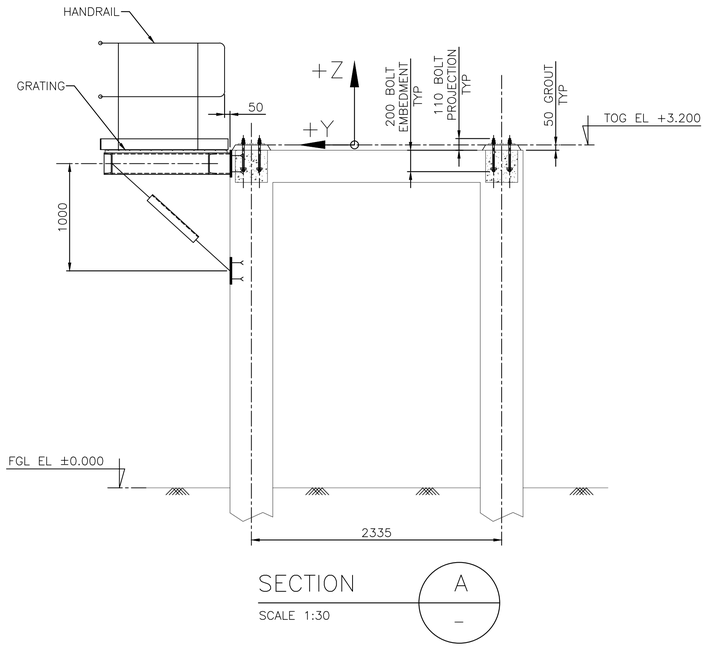

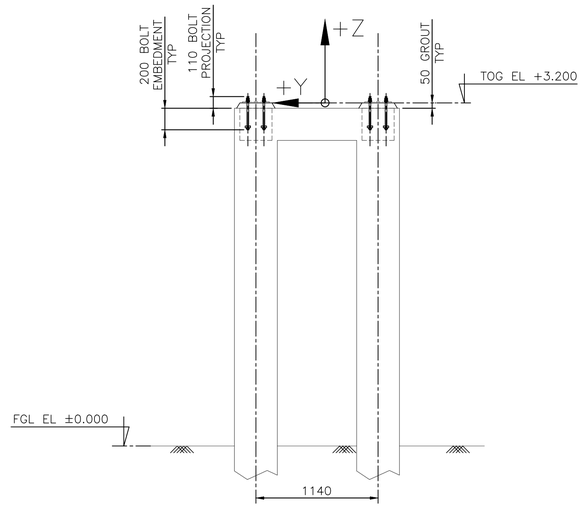
## SECTION B
SCALE 1:30

## FOUNDATION LOAD : AIR FILTER

| SL No | Load case | Support | Fx [kN] | Fy [kN] | Fz [kN] | Mx [kNm] | My [kNm] | Mz [kNm] |
|---|---|---|---|---|---|---|---|---|
| 1 | Dead Loads | S1 | 1.3 | 0.1 | 6.3 | 0.0 | 0.0 | 0.0 |
| | | S2 | 1.3 | -0.1 | 6.3 | 0.0 | 0.0 | 0.0 |
| | | S3 | 0.0 | -0.2 | 9.9 | -0.3 | -0.2 | 0.0 |
| | | S4 | 0.0 | 0.3 | 9.9 | 0.3 | -0.2 | 0.0 |
| | | S5 | -1.3 | -0.1 | 7.7 | -0.4 | 0.0 | 0.0 |
| | | S6 | -1.3 | 0.1 | 7.7 | 0.4 | 0.0 | 0.0 |
| 2 | Live Load | S1 | 0.2 | 0.0 | 0.1 | 0.0 | 0.0 | 0.0 |
| | | S2 | 0.2 | 0.0 | 0.1 | 0.0 | 0.0 | 0.0 |
| | | S3 | 0.5 | -0.1 | 0.1 | 0.2 | 0.1 | 0.0 |
| | | S4 | 0.5 | 0.1 | 0.1 | -0.2 | 0.1 | 0.0 |
| | | S5 | -0.6 | 0.2 | 1.3 | -0.8 | -0.1 | 0.0 |
| | | S6 | -0.6 | -0.2 | 1.3 | 0.8 | -0.1 | 0.0 |
| 3 | Roof Live Load | S1 | 0.2 | 0.0 | 1.2 | 0.0 | 0.0 | 0.0 |
| | | S2 | 0.2 | 0.0 | 1.2 | 0.0 | 0.0 | 0.0 |
| | | S3 | 0.0 | 0.0 | 1.9 | 0.0 | 0.0 | 0.0 |
| | | S4 | 0.0 | 0.0 | 1.9 | 0.0 | 0.0 | 0.0 |
| | | S5 | -0.3 | -0.1 | 2.1 | 0.1 | 0.0 | 0.0 |
| | | S6 | -0.3 | 0.1 | 2.1 | -0.1 | 0.0 | 0.0 |
| 4 | WIND LOAD +X direction | S1 | -2.5 | 0.0 | -0.7 | 0.0 | -0.2 | -0.1 |
| | | S2 | -2.5 | 0.0 | -0.7 | 0.0 | -0.2 | 0.1 |
| | | S3 | -2.0 | -0.3 | -0.6 | 0.1 | -0.3 | 0.0 |
| | | S4 | -2.0 | 0.3 | -0.6 | -0.1 | -0.3 | 0.0 |
| | | S5 | -2.7 | 0.0 | 1.3 | 0.0 | -0.3 | -0.3 |
| | | S6 | -2.7 | 0.0 | 1.3 | 0.0 | -0.3 | 0.3 |
| 5 | WIND LOAD -X direction | S1 | 2.5 | 0.0 | 0.9 | 0.0 | 0.2 | 0.1 |
| | | S2 | 2.5 | 0.0 | 0.9 | 0.0 | 0.2 | -0.1 |
| | | S3 | 2.6 | 0.3 | 1.1 | -0.1 | 0.4 | 0.0 |
| | | S4 | 2.6 | -0.3 | 1.1 | 0.1 | 0.4 | 0.0 |
| | | S5 | 3.7 | 0.0 | -2.0 | 0.0 | 0.5 | 0.3 |
| | | S6 | 3.7 | 0.0 | -2.0 | 0.0 | 0.5 | -0.3 |
| 6 | WIND LOAD +Y direction | S1 | 15.2 | -3.3 | 15.9 | 0.4 | 6.9 | -0.1 |
| | | S2 | -14.2 | -3.4 | -15.1 | 0.5 | -6.8 | -0.1 |
| | | S3 | -9.4 | -14.9 | 14.9 | 4.2 | -3.3 | -0.6 |
| | | S4 | 9.8 | -15.6 | -16.5 | 4.4 | 3.4 | -0.6 |
| | | S5 | 1.8 | -5.7 | -5.2 | 2.0 | 0.5 | 0.5 |
| | | S6 | -3.2 | -6.7 | 5.9 | 2.6 | -0.7 | 0.5 |
| 7 | WIND LOAD -Y direction | S1 | -14.3 | 3.4 | -15.2 | -0.5 | -6.8 | 0.1 |
| | | S2 | 15.1 | 3.3 | 15.8 | -0.4 | 6.9 | 0.1 |
| | | S3 | 9.9 | 15.6 | -16.3 | -4.4 | 3.4 | 0.6 |
| | | S4 | -9.4 | 14.8 | 15.1 | -4.2 | -3.3 | 0.6 |
| | | S5 | -3.2 | 6.7 | 5.9 | -2.6 | -0.7 | -0.5 |
| | | S6 | 1.9 | 5.7 | -5.3 | -2.0 | 0.5 | -0.5 |
| 8 | SEISMIC LOAD X direction | S1 | -0.3 | 0.0 | -0.1 | 0.0 | 0.0 | 0.0 |
| | | S2 | -0.3 | 0.0 | -0.1 | 0.0 | 0.0 | 0.0 |
| | | S3 | -0.3 | 0.0 | -0.1 | 0.0 | 0.0 | 0.0 |
| | | S4 | -0.3 | 0.0 | -0.1 | 0.0 | 0.0 | 0.0 |
| | | S5 | -0.2 | 0.0 | 0.2 | 0.0 | 0.0 | 0.0 |
| | | S6 | -0.2 | 0.0 | 0.2 | 0.0 | 0.0 | 0.0 |
| 9 | SEISMIC LOAD Y direction | S1 | 0.5 | -0.1 | 0.5 | 0.0 | 0.2 | 0.0 |
| | | S2 | -0.5 | -0.1 | -0.5 | 0.0 | -0.2 | 0.0 |
| | | S3 | -0.3 | -0.5 | 0.5 | 0.1 | -0.1 | 0.0 |
| | | S4 | 0.3 | -0.5 | -0.5 | 0.1 | 0.1 | 0.0 |
| | | S5 | 0.0 | -0.2 | -0.2 | 0.1 | 0.0 | 0.0 |
| | | S6 | 0.0 | -0.2 | 0.2 | 0.1 | 0.0 | 0.0 |
| 10 | SEISMIC LOAD Z direction | S1 | 0.0 | 0.0 | -0.2 | 0.0 | 0.0 | 0.0 |
| | | S2 | 0.0 | 0.0 | -0.2 | 0.0 | 0.0 | 0.0 |
| | | S3 | 0.0 | 0.0 | -0.3 | 0.0 | 0.0 | 0.0 |
| | | S4 | 0.0 | 0.0 | -0.3 | 0.0 | 0.0 | 0.0 |
| | | S5 | 0.0 | 0.0 | -0.3 | 0.0 | 0.0 | 0.0 |
| | | S6 | 0.0 | 0.0 | -0.3 | 0.0 | 0.0 | 0.0 |

A. ALL LOADS FURNISHED IN THIS TABLE ARE UNFACTORED ACTING LOADS.


B. FOR REVERSE DIRECTION OF LOAD CASE 8 TO 10, MULTIPLY ALL VALUES WITH -1.

## NOTES

1. ALL DIMENSIONS ARE IN MILLIMETER.
2. ALL LEVELS ARE IN METER.
3. FGL LEVEL ±0.0 CORRESPONDS TO RL 912.350.
4. THE LOADS INDICATED IN LOAD DATA TABLE ARE ACTUAL. FOUNDATION DESIGNER SHOULD CONSIDER NECESSARY MARGIN.
5. SIZE OF FOUNDATION AND PEDESTAL SHALL BE DECIDED BY CIVIL DESIGN ENGINEER AS PER GIVEN LOADING.
6. ADDITIONAL REBAR REQUIREMENT AROUND ANCHOR BOLTS TO ENSURE NO FAILURE OF CONCRETE SHALL BE DECIDED BY CIVIL DESIGN ENGINEER AS PER GIVEN LOADING.
7. ALL GROUT SHALL BE NON SHRINK CEMENTITIOUS GROUT UNLESS NOTED OTHERWISE.

## LEGEND :

CL – CENTER LINE
CONC – CONCRETE
EL – ELEVATION
EQP – EQUIPMENT
FGL – FINISHED GROUND LEVEL
Gr – GRADE
MPa – MEGA PASCAL
mm – MILLIMETER
No – NUMBER / NUMBERS
TH – THICKNESS
TOC – TOP OF CONCRETE
TOG – TOP OF GROUT
TYP – TYPICAL

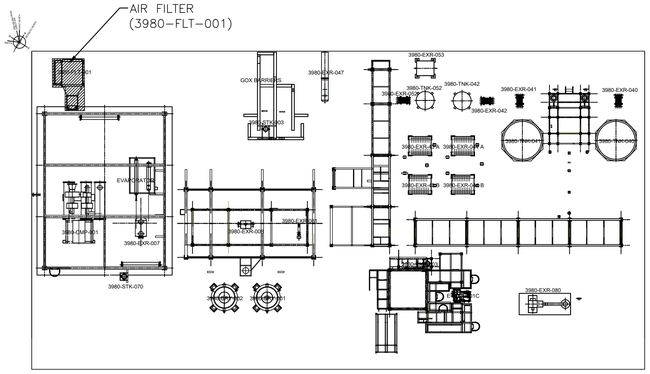


KEY PLAN

| REV | DATE | REVISION DESCRIPTION | DRN | CHK | ENG | APP | EMP |
|---|---|---|---|---|---|---|---|
| D01 | 22/02/2023 | AS-BUILT | -- | STY/SYC/SHH | -- | BDA/PRI/JPD | |
| C01 | 10/08/2020 | ISSUED FOR CONSTRUCTION | -- | STY/SYC/SHH | -- | BDA/PRI/JPD | |
| A01 | 29/06/2020 | ISSUED FOR INFORMATION | -- | STY/SYC/SHH | -- | BDA/PRI/JPD | |

DOCUMENT NUMBER | REFERENCE DOCUMENTS

Air Liquide ENGINEERING & CONSTRUCTION

AIR LIQUIDE CONFIDENTIAL INFORMATION: THIS PRINT IS THE PROPERTY OF L'AIR LIQUIDE S.A. OR ITS DIRECT AND INDIRECT AFFILIATES OR SUBSIDIARIES AND CONTAINS VALUABLE CONFIDENTIAL INFORMATION. COPYRIGHT AND ALL OTHER RIGHTS IN THIS PRINT ARE EXPRESSLY RESERVED. NO PART OF THIS PRINT MAY BE DISCLOSED BY THE INTENDED RECIPIENT TO A THIRD PARTY, REPRODUCED, COPIED, LENT, OR DISPOSED OF, DIRECTLY OR INDIRECTLY, NOR USED FOR ANY PURPOSE OTHER THAN THAT FOR WHICH IT IS EXPRESSLY FURNISHED. THIS PRINT IS LENT SUBJECT TO RETURN ON DEMAND.

| DRAWING NUMBER | | | | REVISION | STATUS |
|---|---|---|---|---|---|
| 12126-60-01-CS-141080 | | | | 0 | AFD |
| DATE | 10/06/2020 | DATE | 11/06/2020 | DATE | 25/06/2020 |
| DRAWN | SGH | CHECKED | ABM | APPROVED | DS |

LARSEN & TOUBRO

This drawing is the property of *LARSEN & TOUBRO* and must not be passed on to any person or body not authorized by us to receive it nor be copied or otherwise made use either in full or in part by such person or body without our prior permission in writing.

Outotec

The content of these documents are the sole property of Outotec Oyj. Any rights not expressly granted herein are reserved. Reproduction, transfer or distribution of part or all of the contents in any form without prior written permission of Outotec is prohibited.

MA'ADEN معادن Saudi Arabian Mining Company شركة التعدين العربية السعودية

This document and the information contained herein is Ma'aden proprietary know-how. This document or any part thereof should not be reproduced, stored in a retrieval system or transmitted by any means, electronic or otherwise, or divulged without prior written permission of Ma'aden.

| LARSEN & TOUBRO DRAWING NUMBER | | | REVISION |
|---|---|---|---|
| O19045_080_C_V_24225_010 | | | 2 |
| OUTOTEC DRAWING NUMBER | | DOCUMENT ID | REVISION |
| 900707 _GAU01 _AG22_MTL01 _39823 | | OU100680048 | 2 |

| | | |
|---|---|---|
| DRAWN | -- | -- |
| CHECKED | STY/ SYC/ SHH | 26/06/2020 |
| ENGINEER | -- | -- |
| APPROVED | BDA/ PRI/ JPD | 29/06/2020 |
| EMPLOYER | | |
| SCALE | 1:30 | A1 |

MANSOURAH - MASSARAH GOLD PROJECT
GENERAL ARRANGEMENT DRAWING
OXYGEN PLANT
FOUNDATION LOAD & ANCHORAGE - AIR FILTER

DRAWING NUMBER: MD - 216 - 3980 - EG - CV - GAD - V551-1483 | REV: D01