


DRAWING NUMBER
MD - 216 - 3980 - EG - CV - GAD - V551-1484
REV D01

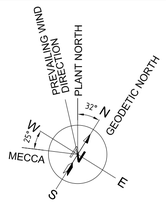

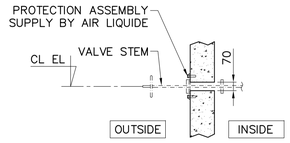


DETAIL 1
SCALE 1:25

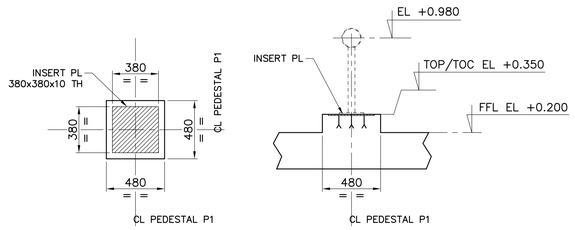


DETAIL PEDESTAL P1
SCALE 1:25


FOR OTHER PEDESTALS
SEE SHT 2 OF 2

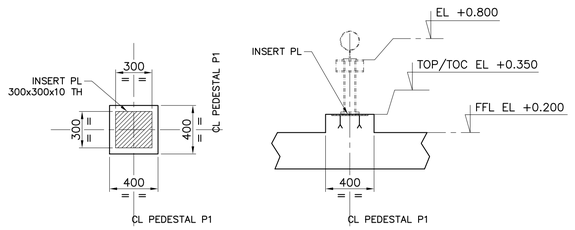


DETAIL PEDESTAL P2
SCALE 1:25

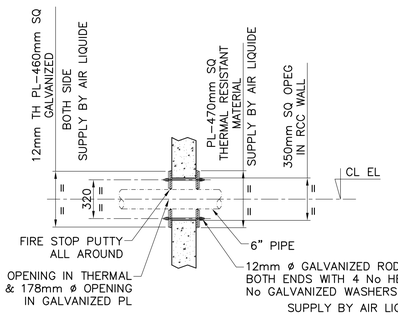


DETAIL 2
SCALE 1:25

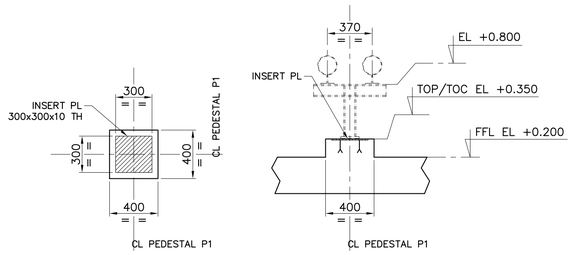


DETAIL PEDESTAL P2A
SCALE 1:25

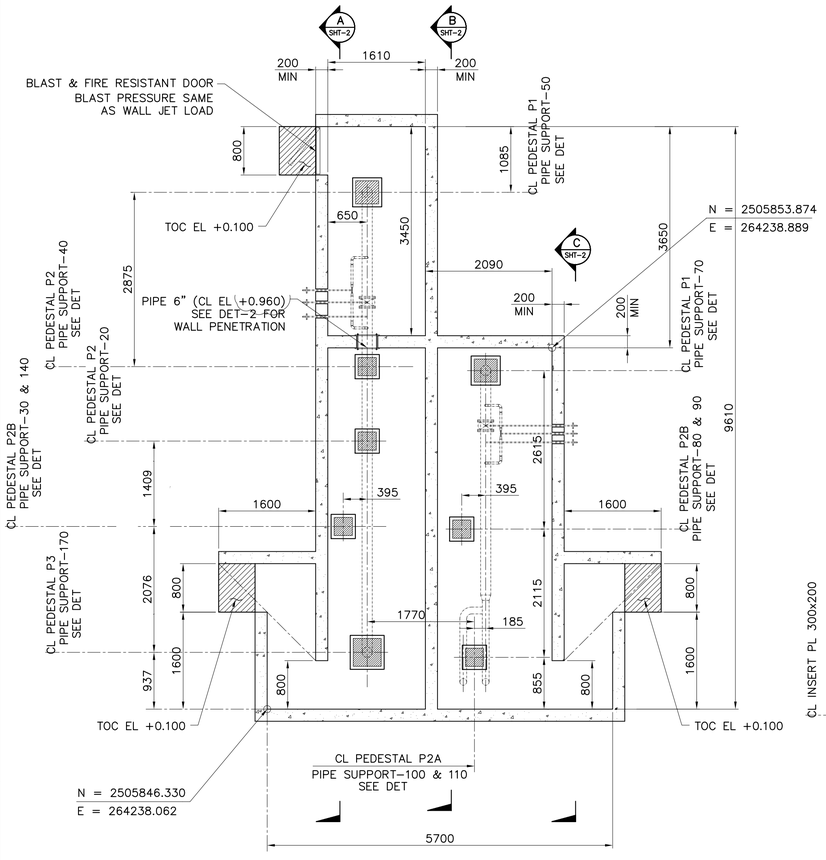

PLAN GOX BARRIER-WALL BASE LEVEL
ALL WALL THICKNESS 200 MIN
SCALE 1:50

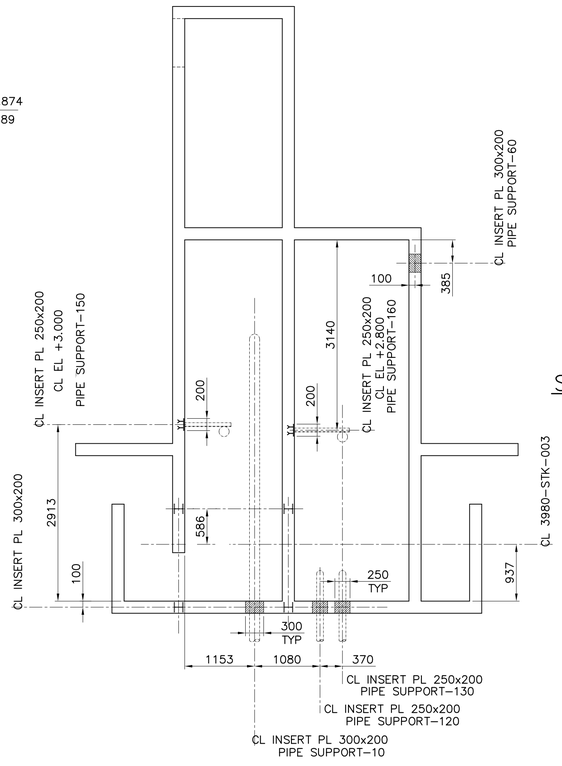

PLAN GOX BARRIER-WALL TOP LEVEL
ALL WALL THICKNESS 200 MIN
TOP EL +3.200
SCALE 1:50

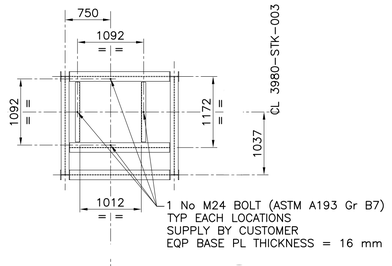

SUPPORT PLAN 3980-STK-003
TOS EL +4.555
SCALE 1:50

EQUIPMENT LOAD DATA

3980-STK-003

EMPTY LOAD - 10.2 KN
OPERATING LOAD - 10.2 KN

WIND LOAD :
HOZ LOAD - 1.35 KN
MOMENT - 1.0 KN-m


SEISMIC LOAD :
HOZ LOAD - 1.35 KN
MOMENT - 1.80 KN-m

NOTES

1. ALL DIMENSIONS ARE IN MILLIMETER.
2. ALL LEVELS ARE IN METER.
3. FGL LEVEL ±0.0 CORRESPONDS TO RL 912.350.

LEGEND :

B PL - BASE PLATE
CAP - CAPACITY
CL - CENTER LINE
CONC - CONCRETE
DET - DETAIL
EL - ELEVATION
EQP - EQUIPMENT
FFL - FINISHED FLOOR LEVEL
FGL - FINISHED GROUND LEVEL
Gr - GRADE
HPP - HIGHEST PAVING/GRADE POINT
HOZ - HORIZONTAL
INTR - INTERMEDIATE
MPa - MEGA PASCAL
mm - MILLIMETER
No - NUMBER / NUMBERS
OPNG - OPENING
PL - PLATE
SHT - SHEET
TOC - TOP OF CONCRETE
TOG - TOP OF GROUT
TOP - TOP OF PLATE
TOS - TOP OF STEEL
TYP - TYPICAL
UDL - UNIFORMLY DISTRIBUTED LOAD
U/S - UNDER SIDE
TH - THICK
ø - DIAMETER
MIN - MINIMUM

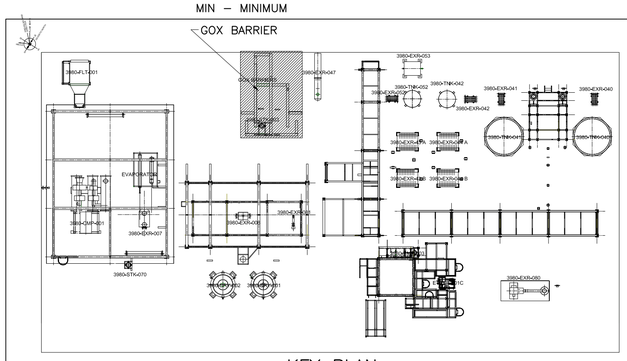

KEY PLAN

Air Liquide ENGINEERING & CONSTRUCTION
AIR LIQUIDE CONFIDENTIAL INFORMATION: THIS PRINT IS THE PROPERTY OF L'AIR LIQUIDE S.A. OR ITS (DIRECT AND INDIRECT) AFFILIATES OR SUBSIDIARIES AND CONTAINS VALUABLE CONFIDENTIAL INFORMATION. COPYRIGHT AND ALL OTHER RIGHTS IN THIS PRINT ARE EXPRESSLY RESERVED. NO PART OF THIS PRINT MAY BE DISCLOSED BY THE INTENDED RECIPIENT TO A THIRD PARTY, REPRODUCED, COPIED, LENT, OR DISPOSED OF, DIRECTLY OR INDIRECTLY, NOR USED FOR ANY PURPOSE OTHER THAN THAT FOR WHICH IT IS EXPRESSLY FURNISHED. THIS PRINT IS LENT SUBJECT TO RETURN ON DEMAND.

DRAWING NUMBER		REVISION	STATUS
12126-60-01-CS-141220		1	AFD
DATE 10/06/2020	DATE 11/06/2020	DATE 25/06/2020	
DRAWN SGH	CHECKED ABM	APPROVED DS	

LARSEN & TOUBRO DRAWING NUMBER: 019045_080_C_V_24225_011 — REVISION 3
OUTOTEC DRAWING NUMBER: 900707__GAU01__AG22__MTL01__39824 — DOCUMENT ID OU100680049 — REVISION 3

REV	DATE	REVISION DESCRIPTION	DRN	CHK	ENG	APP	EMP
D01	22/02/2023	AS-BUILT	--	STY/SYC/SHH	--	BDA/PRI/JPD	
C02	23/10/2020	ISSUED FOR CONSTRUCTION	--	STY/SYC/SHH	--	BDA/PRI/JPD	
C01	10/08/2020	ISSUED FOR CONSTRUCTION	--	STY/SYC/SHH	--	BDA/PRI/JPD	
A01	29/06/2020	ISSUED FOR INFORMATION	--	STY/SYC/SHH	--	BDA/PRI/JPD	

DOCUMENT NUMBER | REFERENCE DOCUMENTS

LARSEN & TOUBRO
This drawing is the property of LARSEN & TOUBRO and must not be passed on to any person or body not authorized by us to receive it nor be copied or otherwise made use either in full or in part by such person or body without our prior permission in writing.

Outotec
The content of these documents are the sole property of Outotec Oyj. Any rights not expressly granted herein are reserved. Reproduction, transfer or distribution of part or all of the contents in any form without prior written permission of Outotec is prohibited.

MA'ADEN معادن
Saudi Arabian Mining Company شركة التعدين العربية السعودية
This document and the information contained herein is Ma'aden proprietary know-how. This document or any part thereof should not be reproduced, stored in a retrieval system or transmitted by any means, electronic or otherwise, or divulged without prior written permission of Ma'aden.

DRAWN	--	--
CHECKED	STY/ SYC/ SHH	26/06/2020
ENGINEER	--	--
APPROVED	BDA/ PRI/ JPD	29/06/2020
EMPLOYER		
SCALE	1:50, 25	A1

MANSOURAH - MASSARAH GOLD PROJECT
GENERAL ARRANGEMENT DRAWING
OXYGEN PLANT
GUIDE DRAWING-GOX BARRIER (1 OF 2)

DRAWING NUMBER: MD - 216 - 3980 - EG - CV - GAD - V551-1484 — REV D01